
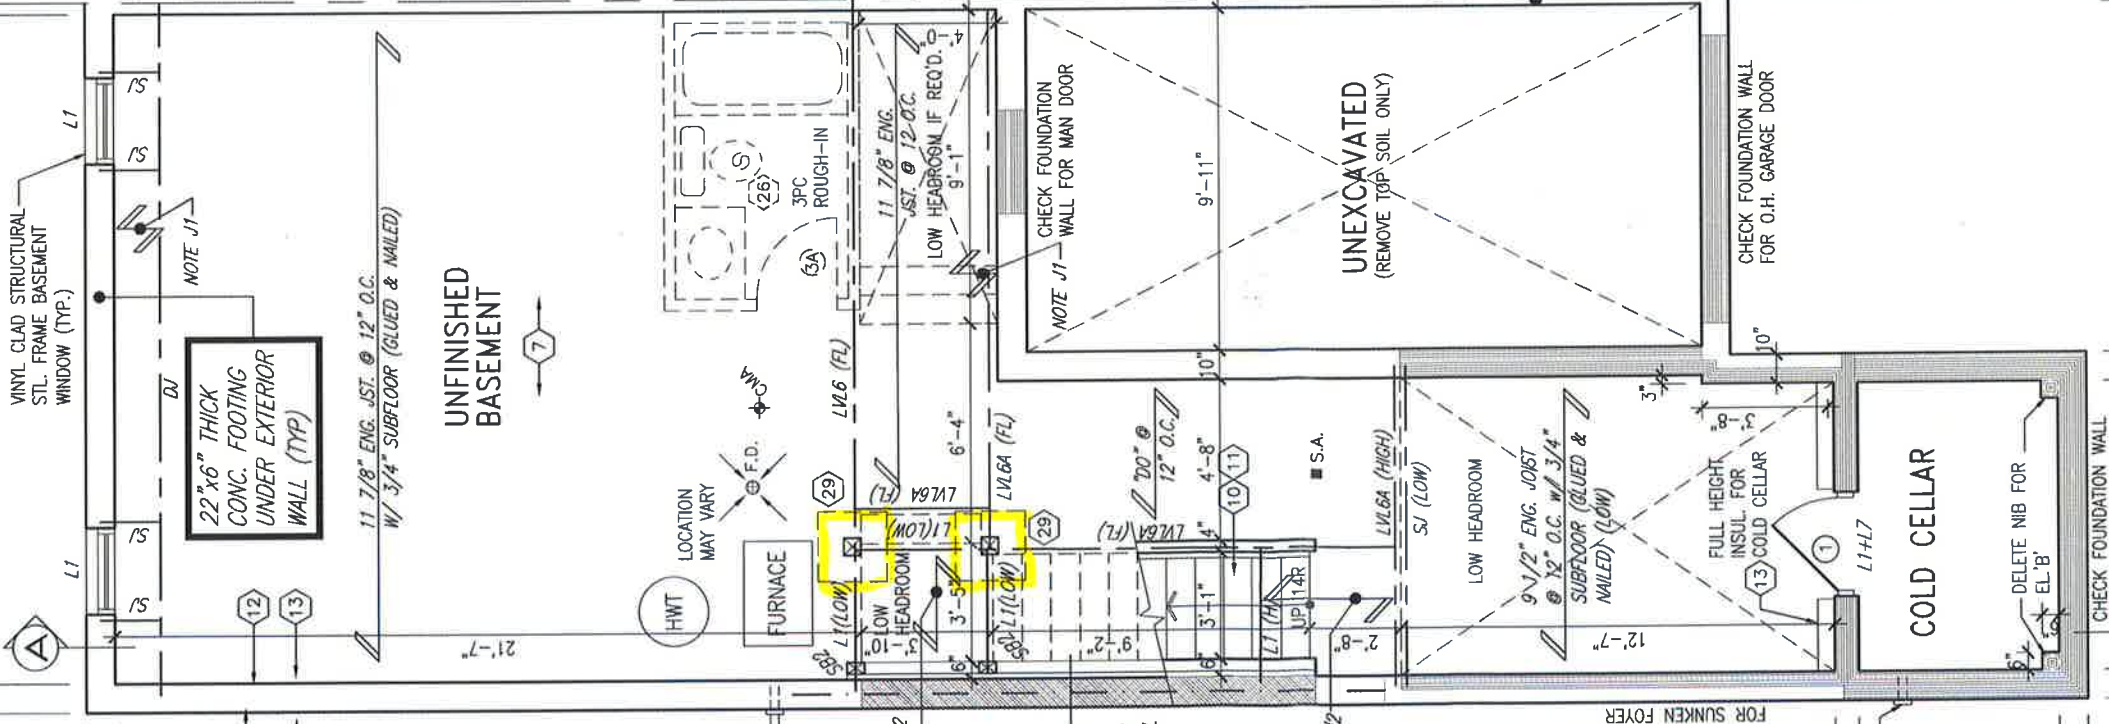
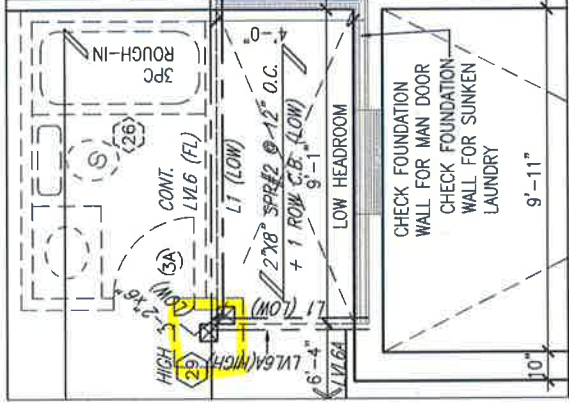


10/24/2018 8:12:15 AM kbayley

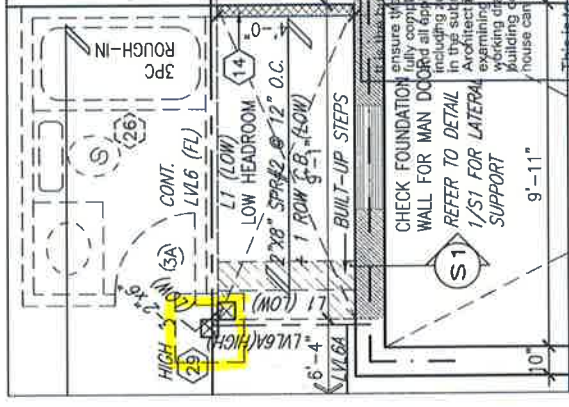

BASEMENT PLAN ELEV. 'A'/'B'

PARTIAL SUNKEN
MUD -1R

Guideline
INIISFIL
PARTIAL SUNKEN
MUD -2R TO +3R

24" x 8" THICK
CONC. FOOTING
UNDER PARTWALL
32" x 12" THICK
CONC. FOOTING
UNDER FIREWALL
SOIL TO HAVE MIN.
ALLOWABLE
BEARING CAPACITY
OF 150 KPa

3R
 JOHN G. WILLIAMS LTD., ARCHITECT
 ARCHITECTURAL CONTROL REVIEW
 AND APPROVAL
 APPROVED BY: _____
 DATE: JUN. 28, 2018
 This stamp certifies compliance with the applicable
 Design Guidelines only and bears no further
 professional responsibility.



<u>AREA CALCULATIONS</u>	<u>ELEV. A</u>	<u>ELEV. B</u>
GROUND FLOOR AREA	801 SF	801 SF
SECOND FLOOR AREA	1020 SF	1014 SF
SUBTOTAL	1821 SF	1815 SF
DEDUCT ALL OPEN AREAS	19 SF	19 SF
TOTAL NET AREA	1802 SF (167.41 m ²)	1796 SF (167.85 m ²)
FINISHED BSMT AREA	XX SF	XX SF
COVERAGE	1014 SF	1014 SF
W/OUT PORCH	(94.20 m ²)	(94.20 m ²)
COVERAGE	1087 SF	1081 SF
W/ PORCH	(100.99 m ²)	(100.43 m ²)

NOTE J1: PROVIDE SOLID BLOCKING @ 24" O.C. WHERE FLOOR JOISTS ARE PARALLEL TO FOUNDATION WALL (TYP.)

NOTE: FLOOR FRAMING INFO REFER TO ENG SHOP DRAWINGS FOR ALL TRUSS-JOIST INFORMATION AND DETAILS, UNLESS OTHERWISE NOTED.

[illegible]

- A minimum 200 amp Panelboard.
- Conduit that is not less than 1 1/16" (27mm) trade size.
- A square 4 11/16" (119mm) trade size electrical outlet box.
- Fumeproofed Electrical outlet box to be installed in the Garage or carport or adjacent to driveway.


Town of Innisfil Building Dept Notes:

All smoke alarms and CO detectors shall comply with O.B.C 9.10.19 and 9.33.4

Main bathroom shall be designed as per 9.5.2

All construction subject to review by Town Building Inspectors

See comments on permit

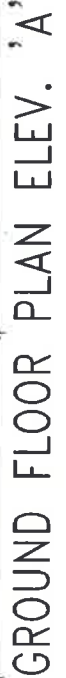

NOTE:
ALL LVL'S SUPPORTING FLOOR LOADS ARE TO
BE SPECIFIED BY THE FLOOR TRUSS
MANUFACTURER.

NOTE: FLOOR FRAMING INFO REFER TO ENG SHOP DRAWINGS FOR ALL TRUSS-JOIST INFORMATION AND DETAILS, UNLESS OTHERWISE NOTED.

INDICATES FIRE RATED WALL ASSEMBLY

no.	description	date	by
1	ISSUED FOR CLIENT REVIEW	JAN 15-18	WT
2	REVISED AS PER ROOF TRUSS COMMENTS.	MAY 18/18	WT
3	REVISED AS PER FLOOR TRUSS COMMENTS.	MAY 22/18	WT
4	REVISED AS PER ENG'S COMMENTS	JUN 22-18	SB
5			
6			
7			
8			
9			

The undersigned has reviewed and takes responsibility for this design and has the qualifications and meets the requirements set out in the Ontario Building Code to be a Designer.

qualification information

Wallington Jno-Baptiste *Jno-Baptiste* 25591

name registration information BCN

VAS design Inc. 42658

Contractor must verify all dimensions on the plan and report any discrepancy to the Designer before construction. All drawings, drawings and specifications are instruments of service and the property of the Designer which must be returned at the completion of the work. Drawings are not to be scaled.

VA3
DESIGN
155 Consumers Rd Suite 1
Toronto ON M2J 1R4
416.630.2255 f 416.630.4163
va3design.com

BAYVIEW WELLINGTON

project name ALCONA	municipality INNISFIL, ON.	project no. 13049
date DECEMBER 2017		drawing no. 2
drawn by WT	checked by RC	scale 3/16" = 1'-0"
file name 13049-TH-6E		
RICHARD - HT ARCHIVE (W0000002) 2017-12-21 14:54:56 (GMT-05:00) 13049-TH-6E.dwg - Mon - Jun 25, 2018 - 3:43 PM RICHARD - HT ARCHIVE (W0000002) 2017-12-21 14:54:56 (GMT-05:00) 13049-TH-6E.dwg - Mon - Jun 25, 2018 - 3:43 PM		

All drawings specifications, related documents and design are the copyright property of VA3 DESIGN. Reproduction of this property in whole or in part is strictly prohibited without VA3 DESIGN's written permission.


It is the builder's complete responsibility to ensure that all plans submitted for approval fully comply with the Architectural Guidelines and all applicable regulations and requirements including zoning provisions and any provisions for future agreement. The Control Authority is hereby approving the plans for exhibiting or approving site (lotting) plans or working drawings with respect to any zoning or building code or permit matter or that any house can be properly built or located on its lot.

This is to certify that these plans comply with the applicable Architectural Design Guidelines approved by the Town of INNISFIL.

JOHN G. WILLIAMS LTD., ARCHITECT
ARCHITECTURAL CONTROL REVIEW
AND APPROVAL

APPROVED BY: _____
DATE: JUN. 28, 2018

This stamp certifies compliance with the applicable Design Guidelines only and bears no further professional responsibility.

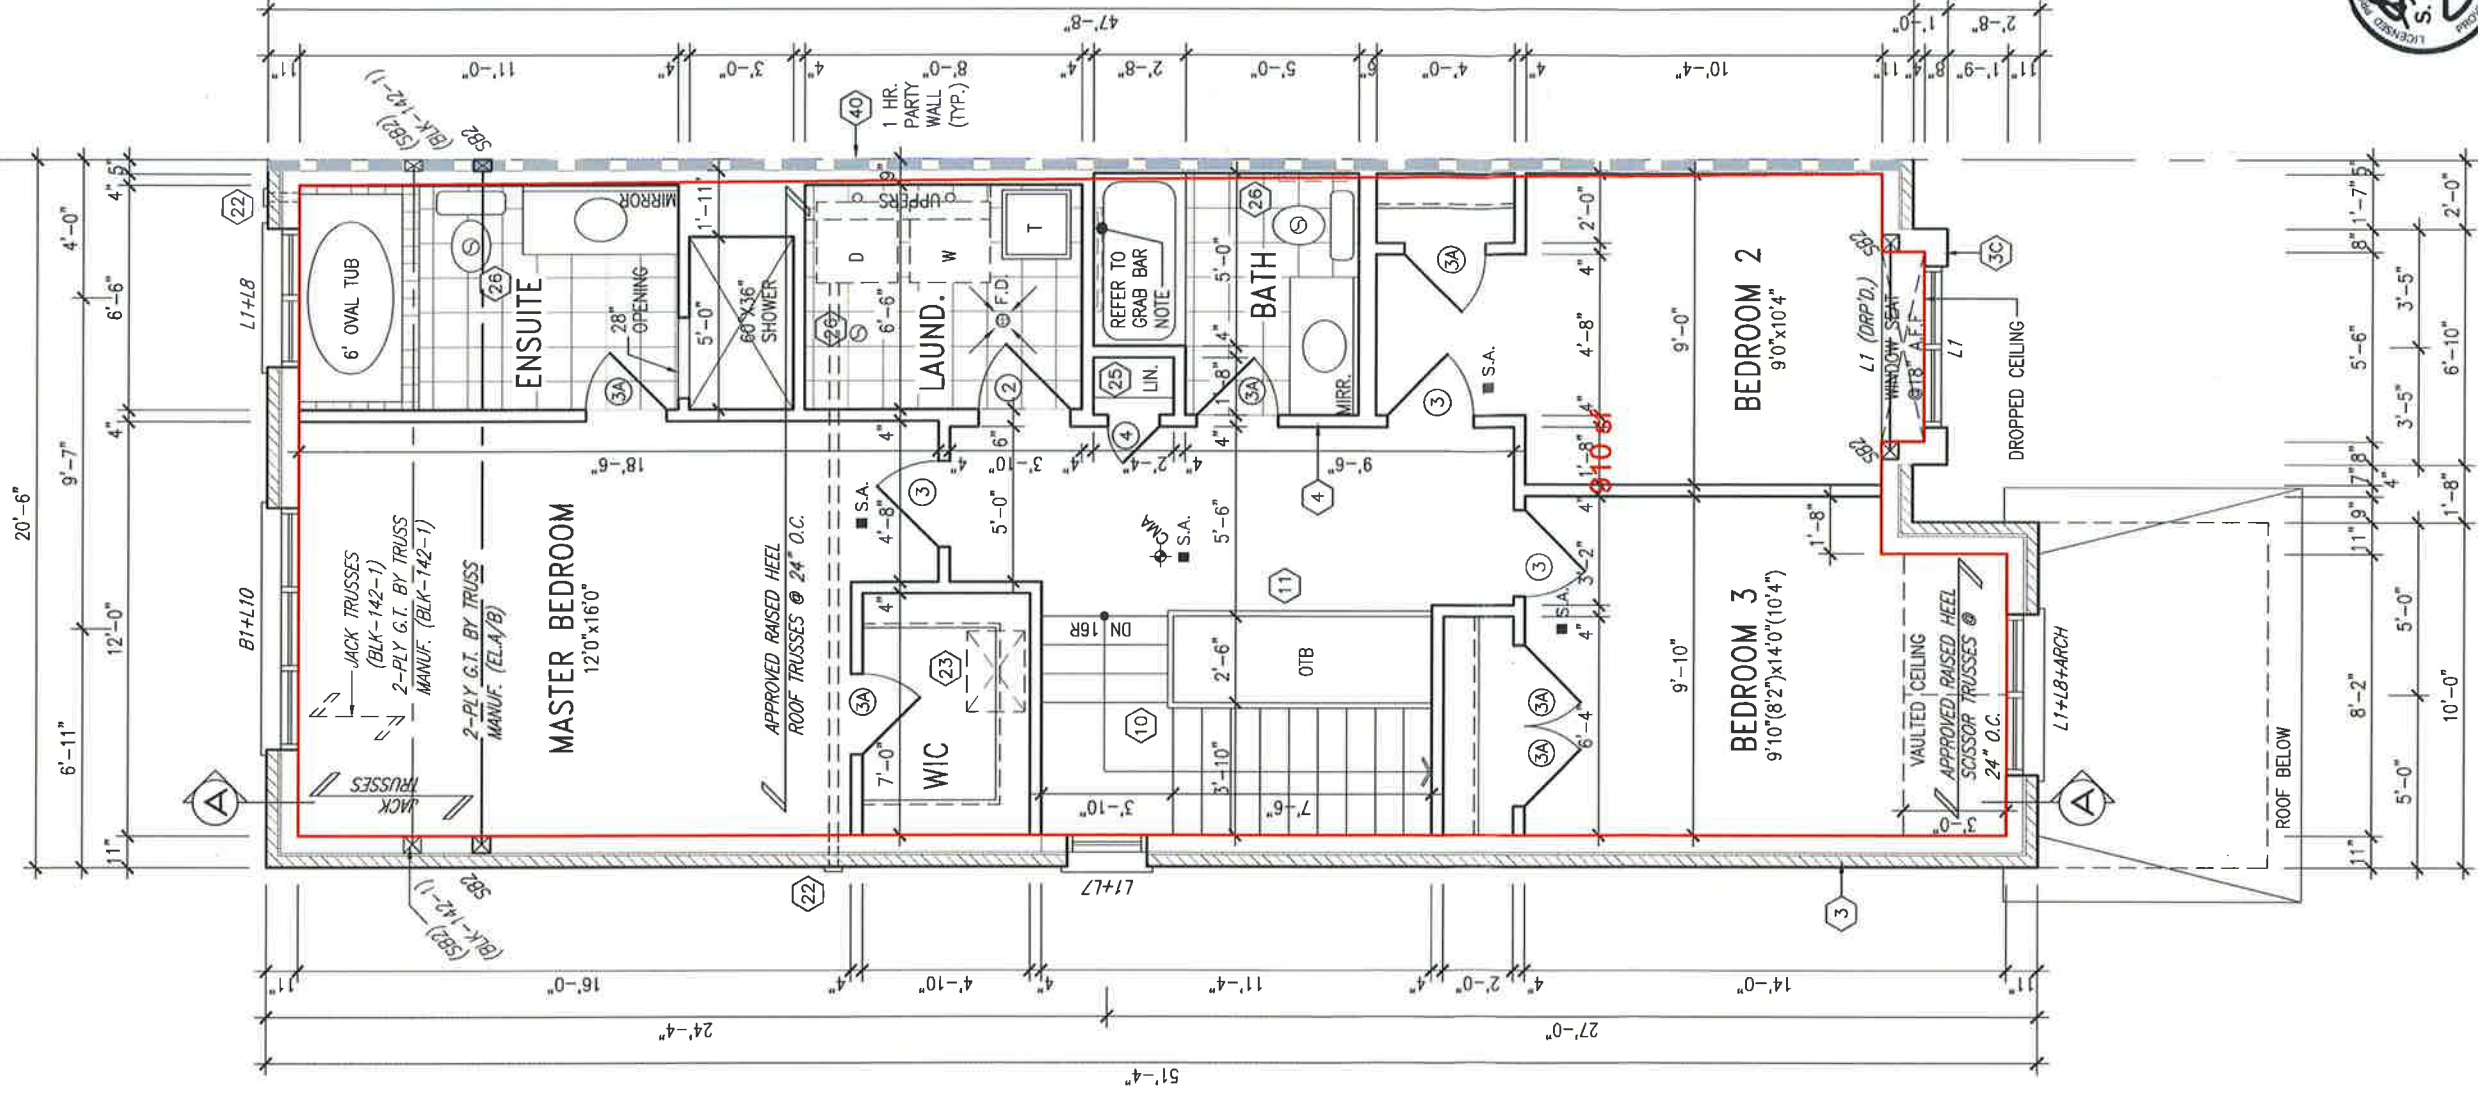

SECOND FLOOR PLAN ELEV. 'A'




It is the builder's complete responsibility to ensure that all plans submitted for approval fully comply with the Architectural Guidelines and all applicable regulations and requirements including zoning provisions and any provisions in the subdivision agreement. The Control Architect is not responsible in any way for construction details, materials, or working drawings with respect to any zoning or building code or permit matter or that any house can be properly built or located on its lot.

This is to certify that these plans comply with the applicable Architectural Design Guidelines approved by the Town of INNISFIL.

JOHN G. WILLIAMS LTD., ARCHITECT
ARCHITECTURAL CONTROL REVIEW
AND APPROVAL

APPROVED BY: [Signature]
DATE: JUN 28, 2018
This stamp certifies compliance with the applicable Design Guidelines only and bears no further professional responsibility.

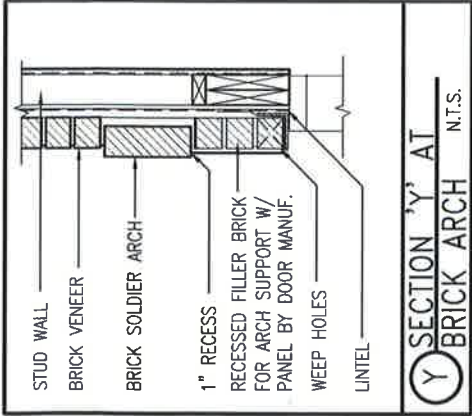

NOTE: ROOF STRUCTURE MAY VARY REFER TO ROOF TRUSS MANUFACTURERS' BUILDING BLOCK TRUSS LAYOUT FOR ACTUAL ROOF STRUCTURE

NOTE: ROOF FRAMING ROOF TRUSS INFORMATION REFER TO ROOF TRUSS SHOP DRAWINGS FOR ALL ROOF FRAMING INFORMATION UNLESS OTHERWISE NOTED.

STUD WALL REINFORCEMENT FOR FUTURE GRAB BARS IN MAIN BATHROOM REINFORCEMENT OF STUD WALLS SHALL BE INSTALLED ADJACENT TO WATER CLOSETS AND SHOWER OR BATHTUB IN MAIN BATHROOM AS PER O.B.C. 9.5.2.3, 3.8.3.8(1)(d), & 3.8.3.13(1)(f) AND DETAILS PROVIDED

no.	description	date	by
9	REVISED AS PER ENG'S COMMENTS	JUN 22-18	SB
8	REVISED AS PER FLOOR TRUSS COMMENTS	MAY 22/18	WT
7	REVISED AS PER ROOF TRUSS COMMENTS	MAY 18/18	WT
6	ISSUED FOR CLIENT REVIEW	JAN 15-18	WT


The undersigned has reviewed and takes responsibility for this design and its construction and meets the requirements set out in the Ontario Building Code, to be a Design Professional.
qualification information
name: Wellington Jno-Baptiste
registration information: 25591
BCN
VA3 Design Inc.
42658
Contractor must verify all dimensions on the job and report any discrepancies to the Designer. The Designer is not responsible for construction details, materials, or working drawings and specifications are intended to be used in the property of the Designer which must be returned at the completion of the work. Drawings are not to be scaled.

VA3 DESIGN
255 Consumers Rd Suite 120
Toronto ON M2J 1R4
t 416.630.2255 f 416.630.4782
va3design.com

BAYVIEW WELLINGTON

TH-6E
CRANE 6

project name: ALCONA
municipality: INNISFIL, ON.
project no.: 13049
drawing no.: 3
date: DECEMBER 2017
checked by: RC
scale: 3/16" = 1'-0"
file name: 13049-TH-6E
drawn by: WT
RICHARD - RE-ARCHIVE WORKING 231.31.1349.BVA UNIVERSITY 13049-TH-6E.dwg - Mon - Jun 25, 2018 - 3:49 PM

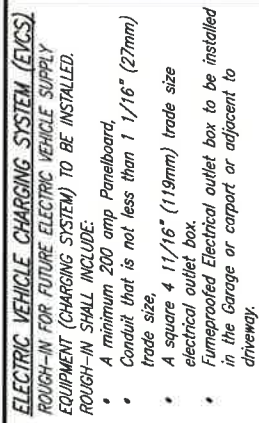

NOTE: ROOF FRAMING
ROOF TRUSS INFORMATION REFER TO ROOF
TRUSS SHOP DRAWINGS FOR ALL ROOF FRAMING
INFORMATION UNLESS OTHERWISE NOTED.

It is the builder's complete responsibility to ensure that all plans submitted for approval fully comply with the Architectural Guidelines and all applicable regulations and requirements in the subdivision agreement. The Control Architect is not responsible in any way for examining or approving site (lotting) plans or working drawings with respect to any zoning or building code or permit matter or that any house can be properly built or located on its lot.

This is to certify that these plans comply with the applicable Architectural Design Guidelines approved by the Town of INNISFIL:

JOHN G. WILLIAMS LTD., ARCHITECT
ARCHITECTURAL CONTROL REVIEW
AND APPROVAL

APPROVED BY: _____
DATE: Jun. 28, 2018

This stamp certifies compliance with the applicable Design Guidelines and plans are of proper professional responsibility.


NOTE: REFER TO STANDARD FLOOR PLANS FOR ADDITIONAL INFORMATION.	NOTE: ALL LVL'S SUPPORTING FLOOR LOADS ARE TO BE SPECIFIED BY THE FLOOR TRUSS MANUFACTURER.	NOTE: FLOOR FRAMING INFO REFER TO ENR SHOP DRAWINGS FOR ALL TRUSS-JOIST INFORMATION AND DETAILS. UNLESS OTHERWISE NOTED.
--	--	--

[illegible]


V3
DESIGN
55 Consumers Rd Suite 120
Toronto ON M2J 1R4
416.630.2255 f 416.630.4782
vo3design.com

project name ALCONA	municipality INNISFIL, ON.	project no. 13049
date DECEMBER 2017	checked by RC	drawing no. 4
drawn by WT	scales 3/16" = 1'-0"	file name 13049-TH-6E
BAYVIEW WELLINGTON		
TH-6E CRANE 6		
PART. PLANS ELEV. 'B'		
RICHARD - R: ARCHIVE WORKING: 2013.1.13049.BW.UINISFIL\A-13049-1TH-6E.dwg - Mon - Jun 25 2018 - 3:54:15PM		

All drawings specifications, related documents and design are the copyright property of VA3 DESIGN. Reproduction of this property in whole or in part is strictly prohibited without VA3 DESIGN's written permission.

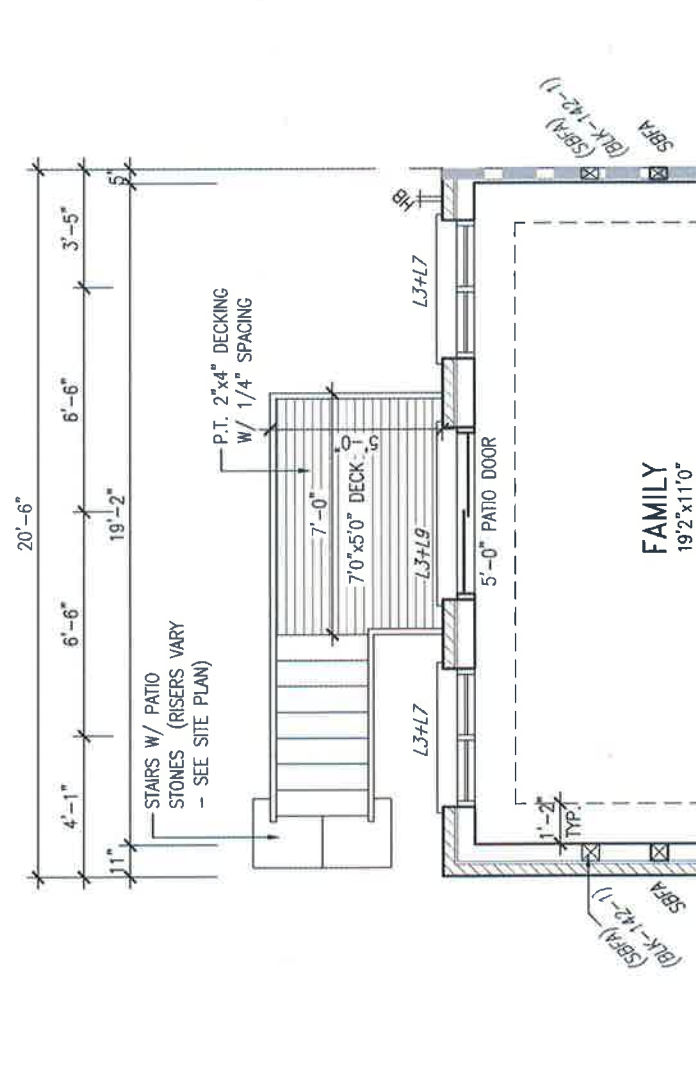

PARTIAL GROUND FLOOR
PLAN WOD 9R COND.
ELEV. 'A'/'B'

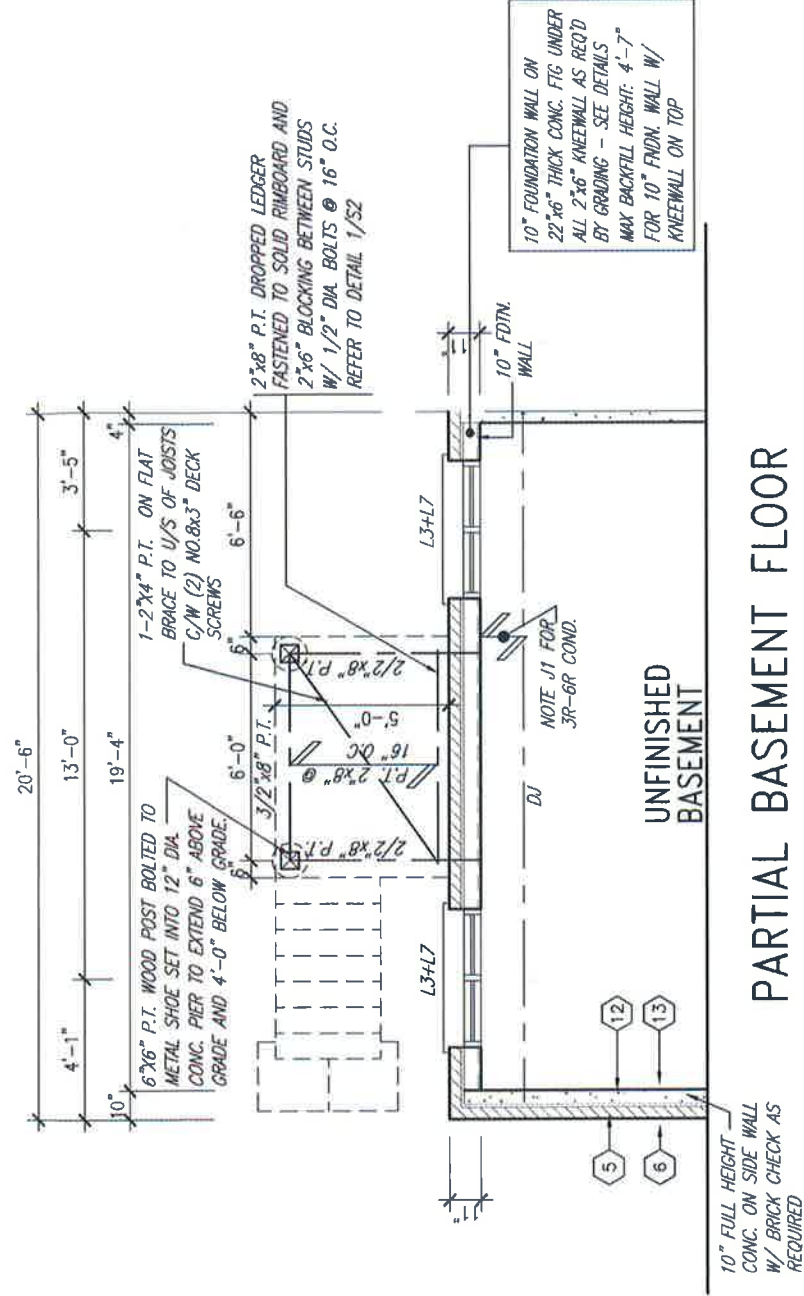

It is the builder's complete responsibility to ensure that all plans submitted for approval fully comply with the Architectural Guidelines and all applicable regulations and requirements including zoning provisions and any provisions in the subdivision agreement. The Contractor is not responsible in any way for examining or approving site (lotting) plans or working drawings with respect to any zoning or building code or permit matter or that any house can be properly built or located on its lot.

This is to certify that these plans comply with the applicable Architectural Design Guidelines approved by the Town of INNISFIL.

JOHN G. WILLIAMS LTD., ARCHITECT
ARCHITECTURAL CONTROL REVIEW

CTURAL CONTROL REVIEW
AND APPROVAL

APPROVED BY:

DATE: Jun. 28, 2018

This stamp certifies compliance with the applicable Design Guidelines only and bears no further professional responsibility.




JUNE 26, 2018

9	-	-	The undersigned has reviewed and takes responsibility for this design and has approved and meets the requirements set out in the Ontario Building Code to be a Designer.
8	-	-	qualification information
7	-	-	Wellington Jno-Baptiste
6	-	-	25591
5	-	-	name registration information BCIN
4	REMOVED AS PER ENG'S COMMENTS	JUN 22-18 SB	42658
3	REMOVED AS PER FLOOR TRUSS COMMENTS.	MAY 22/18 WT	
2	REMOVED AS PER ROOF TRUSS COMMENTS.	MAY 18/18 WT	
1	ISSUED FOR CLIENT REVIEW	JAN 15-18 WT	
no. description	date	by	

VAD3
DESIGN
255 Consumers Rd Suite 120
Toronto, ON M2J 1R4
t 416.630.2255 f 416.630.4782
vad3design.com

BAYVIEW WELLINGTON	TH-6E CRANE 6
project name ALCONA	project no. 13049
municipality INNISFIL, ON.	
date DECEMBER 2017	drawing no. 10
drawn by WT	checked by RC
scale 3"/16" = 1'-0"	file name 13049-TH-6E
WOD CONDITION PARTIAL PLANS	
RICHARD - 88 ARCADE WILSON RD., JAMES HAMILTON, ONT. L9B 4G9 - Mon - Jun 25 23:18 - 35°-49°	

All drawings, specifications, related documents and design are the copyright property of VAI DESIGN. Reproduction of this property in whole or in part is strictly prohibited without VAI DESIGN's written permission.

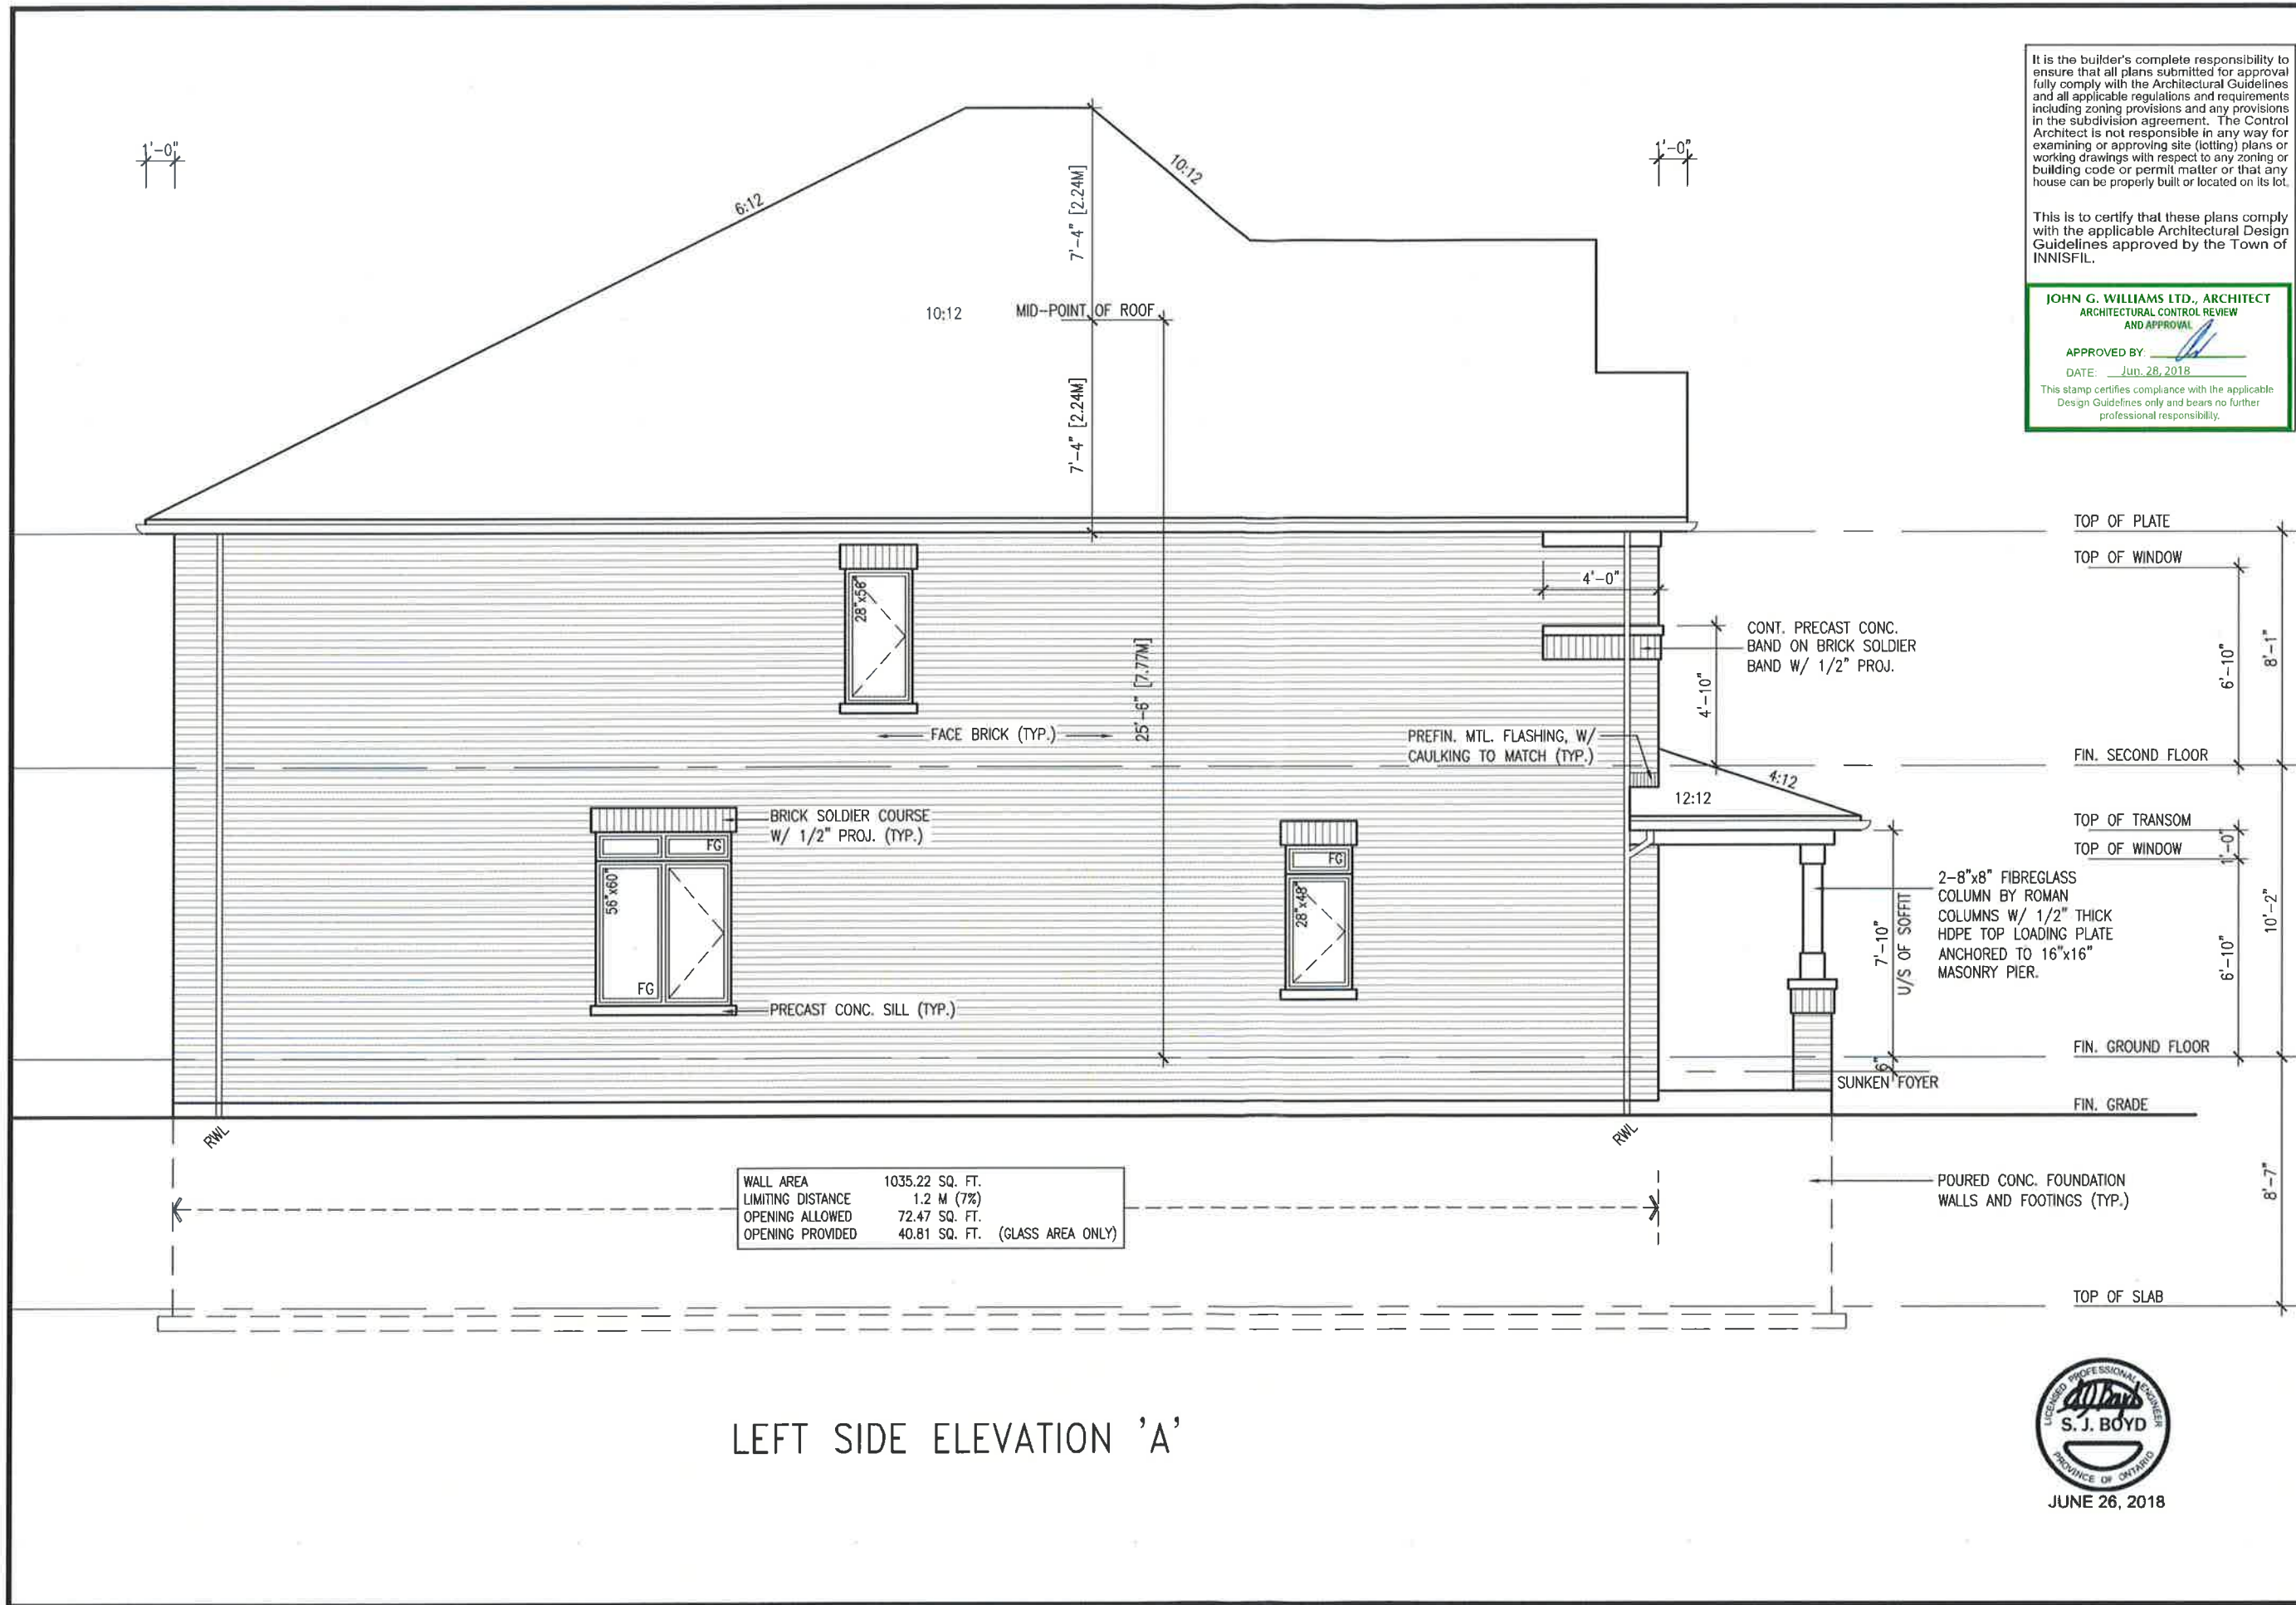

It is the builder's complete responsibility to ensure that all plans submitted for approval fully comply with the Architectural Guidelines and all applicable regulations and requirements including zoning provisions and any provisions in the subdivision agreement. The Control Architect is not responsible in any way for examining or approving site (lotting) plans or working drawings with respect to any zoning or building code or permit matter or that any house can be properly built or located on its lot.

This is to certify that these plans comply with the applicable Architectural Design Guidelines approved by the Town of INNISFIL.

JOHN G. WILLIAMS LTD., ARCHITECT
ARCHITECTURAL CONTROL REVIEW AND APPROVAL

APPROVED BY: _____
DATE: Jun. 28, 2018

This stamp certifies compliance with the applicable Design Guidelines only and bears no further professional responsibility.

BAYVIEW WELLINGTON		TH-6E CRANE 6
project name	ALCONIA	project no. 13049
date	DECEMBER 2017	drawing no. 6
checked by	RC	scale
drawn by	WT	3/16" = 1'-0"
LEFT SIDE ELEVATION 'A'		title name
INNISFIL, ON.		13049-TH-6E
project no. 13049		date
drawing no. 6		Mon - Jun 25 2018 - 3:49 PM

The undersigned has reviewed and takes responsibility for this design and has the qualifications and meets the requirements set out in the Ontario Building Code to be a Designer.

qualification information

Wellington Inno-Bioscience

signature

25591


BCIN

42558

VA3 Design Inc.

Contractor must verify all dimensions on the job and report any discrepancy to the Designer before proceeding with the work. All drawings and specifications are instruments of service and the property of the Designer which must be returned at the completion of the work. Drawings are not to be scaled.

no.	description	date	by
9.			
8.			
7.			
6.			
5.			
4.	REVISED AS PER ENG'S COMMENTS	JUN 22-18 SB	
3.	REVISED AS PER FLOOR TRUSS COMMENTS	MAY 22/18 WT	
2.	REVISED AS PER ROOF TRUSS COMMENTS	MAY 18/18 WT	
1.	ISSUED FOR CLIENT REVIEW	JAN 15-18 WT	

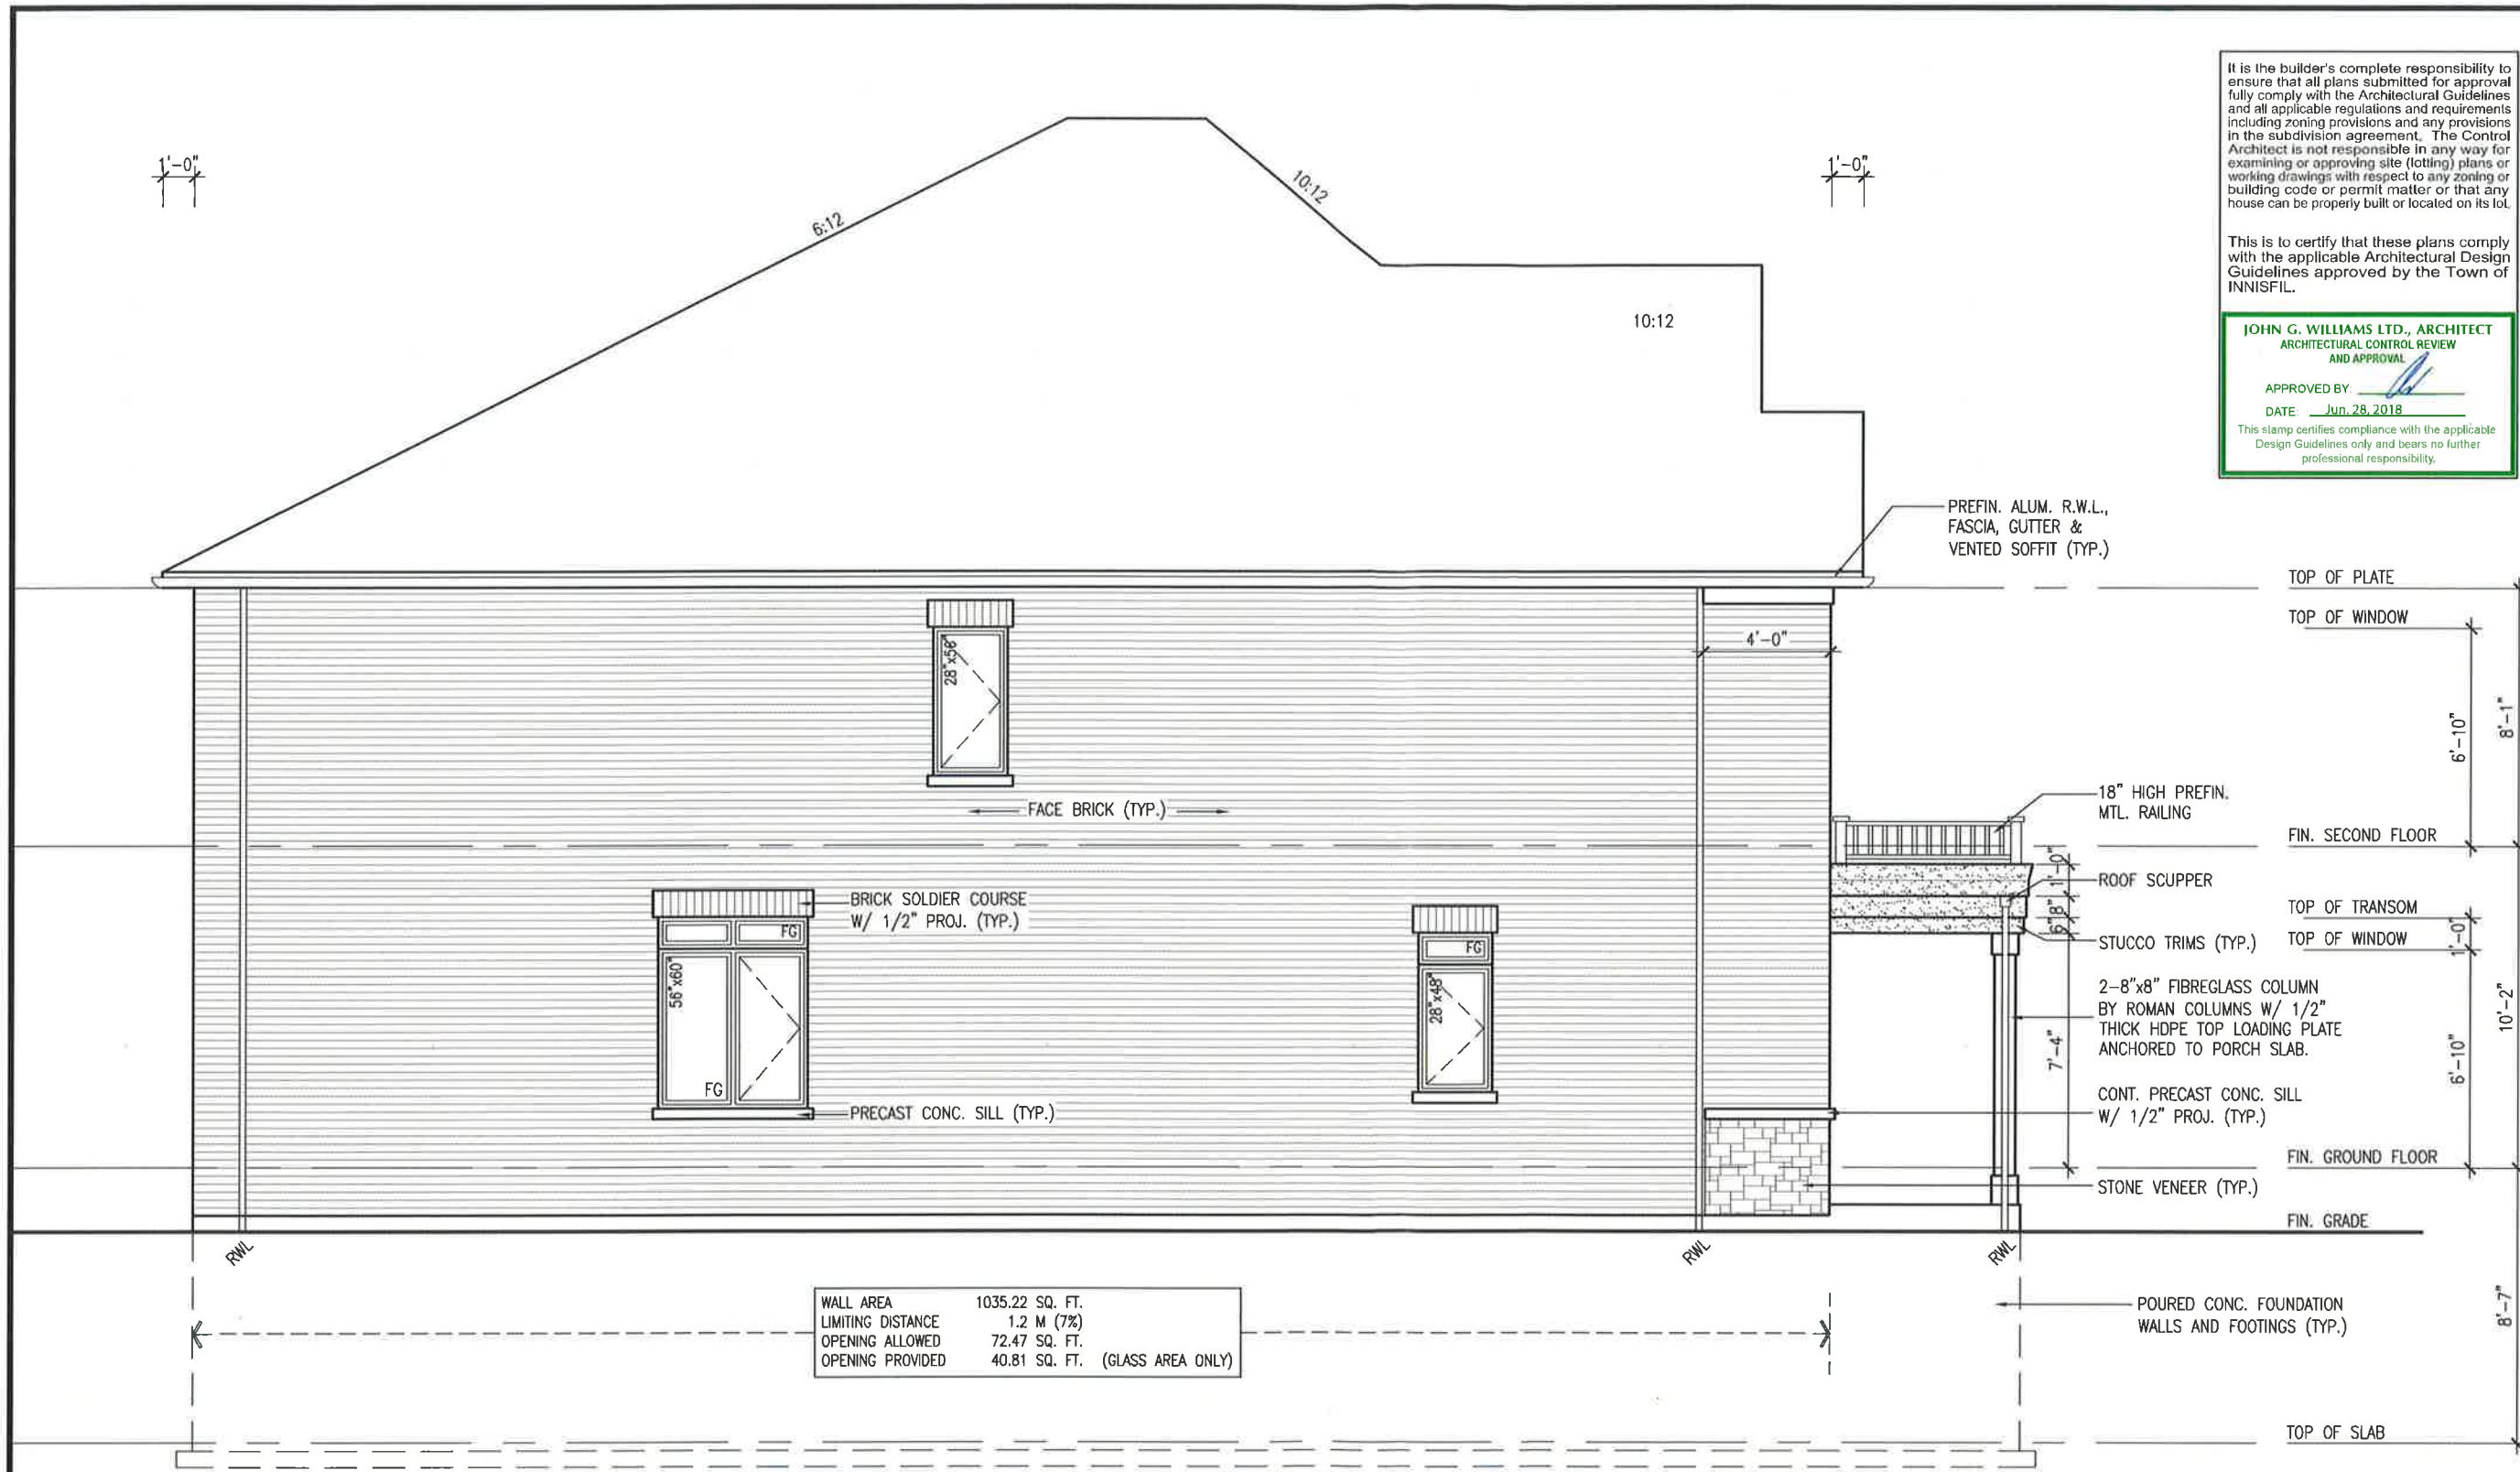

LEFT SIDE ELEVATION 'B'

It is the builder's complete responsibility to ensure that all plans submitted for approval fully comply with the Architectural Guidelines and all applicable regulations and requirements including zoning provisions and any provisions in the subdivision agreement. The Control Architect is not responsible in any way for examining or approving site (lotting) plans or working drawings with respect to any zoning or building code or permit matter or that any house can be properly built or located on its lot.

This is to certify that these plans comply with the applicable Architectural Design Guidelines approved by the Town of INNISFIL.

JOHN G. WILLIAMS LTD., ARCHITECT
ARCHITECTURAL CONTROL REVIEW
AND APPROVAL

APPROVED BY:

DATE: Jun. 28, 2018

This stamp certifies compliance with the applicable Design Guidelines only and bears no further professional responsibility.

BAYVIEW WELLINGTON		TH-6E CRANE 6	
project name	ALCONA	municipality	INNISFIL, ON.
project no.	13049	drawing no.	7
date	DECEMBER 2017	checked by	RC
drawn by	WT	scale	3/16" = 1'-0"
drawn by	WT	file name	13049-TH-6E
drawn by	WT	date	13049-TH-6E.dwg - Mon - Jun 25 2018 - 3:49 PM
RICHARD - H:\ARCHIVE\WORKING\2013\13049 BAYVIEW\TH\13049-TH-6E.dwg - Mon - Jun 25 2018 - 3:49 PM			
All drawings specifications, related documents and design are the copyright property of VAS DESIGN. Reproduction of this property in whole or in part is strictly prohibited without VAS DESIGN's written permission.			

The undersigned has reviewed and takes responsibility for this design and has the qualifications and meets the requirements set out in the Ontario Building Code to be a Designer.		25591	
qualification information		BCN	
Wellington Jno-Baptiste		42658	
registration information		BCN	
Wellington Jno-Baptiste		42658	
Contractor must verify all dimensions on the job and report any discrepancy to the Designer before proceeding with the work. All drawings and specifications are instruments of service and the property of the Designer which must be returned at the completion of the work.		Drawings are not to be scaled.	

4	REVISED AS PER ENG'S COMMENTS	JUN 22-18	SB
3	REVISED AS PER FLOOR TRUSS COMMENTS.	MAY 22/18	WT
2	REVISED AS PER ROOF TRUSS COMMENTS.	MAY 18/18	WT
1	ISSUED FOR CLIENT REVIEW	JAN 15-18	WT
no.	description	date	by



 JUNE 26, 2018


JOHN G. WILLIAMS LTD., ARCHITECT
ARCHITECTURAL CONTROL REVIEW
AND APPROVAL

APPROVED BY: 
DATE: Jun. 28, 2018

This stamp certifies compliance with the applicable Design Guidelines only and bears no further professional responsibility.

no.	description	date	by	The undersigned has reviewed and takes responsibility for this design and has the qualifications and meets the requirements set out in the Ontario Building Code to be a Designer. qualification information Wellington Jno-Baptiste <i>Jno-Baptiste</i> 25591 BCIN name registration information VA3 Design Inc. 42658 signature Contractor must verify all dimensions on the job and report any discrepancy to the Designer before starting the work. All drawings and specifications and instruments of service and the property of the Designer which must be returned at the completion of the work. Drawings are not to be scaled.	VA3 DESIGN 255 Consumers Rd Suite 120 Toronto ON M2J 1R4 t 416.630.2235 f 416.630.4792 vo3design.com	project name ALCONA project no. 13049	municipality INNISFIL, ON.	TH-6E CRANE 6
4	REVISED AS PER ENG'S COMMENTS	JUN 22-18	SB					
3	REVISED AS PER FLOOR TRUSS COMMENTS.	MAY 22/18	WT					
2	REVISED AS PER ROOF TRUSS COMMENTS.	MAY 18/18	WT					
1	ISSUED FOR CLIENT REVIEW	JAN 15-18	WT					
				date drawn by DECEMBER 2017 WT	checked by RC	scale 3/16" = 1'-0"	REAR ELEVATION 'A/B' file name 13049-TH-6E	drawing no. 8
TH-6E CRANE 6 BAYVIEW WELLINGTON project name ALCONA project no. 13049 municipality INNISFIL, ON.								

<u>UNINSULATED OPENINGS</u> (PER OBC. SB-12,3.1.1(7))			
TH-6E ELEVATION 'A'	ENERGY EFFICIENCY - OBC SB12		
ELEVATION	WALL AREA S.F.	OPENING S.F.	PERCENTAGE
FRONT	418.97 S.F.	96.694 S.F.	23.08 %
LEFT SIDE	1035.22 S.F.	50.556 S.F.	4.88 %
RIGHT SIDE	1035.22 S.F.	0 S.F.	0.00 %
REAR	413.42 S.F.	139.833 S.F.	33.82 %
* OPENINGS OMITTED AS PER SB-12 3.1.1.9(4) MAX 19.9 S.F. REFER TO ELEVATION FOR LOCATION		0 S.F.	
TOTAL SQ. FT.	2902.83 S.F.	287.08 S.F.	9.89 %
TOTAL SQ. M.	269.68 S.M.	26.67 S.M.	9.89 %
<u>UNINSULATED OPENINGS</u> (PER OBC. SB-12,3.1.1(7))			
TH-6E ELEVATION 'B'	ENERGY EFFICIENCY - OBC SB12		
ELEVATION	WALL AREA S.F.	OPENING S.F.	PERCENTAGE
FRONT	413.42 S.F.	96.694 S.F.	23.39 %
LEFT SIDE	1035.22 S.F.	50.556 S.F.	4.88 %
RIGHT SIDE	1035.22 S.F.	0 S.F.	0.00 %
REAR	413.42 S.F.	139.833 S.F.	33.82 %
* OPENINGS OMITTED AS PER SB-12 3.1.1.9(4) MAX 19.9 S.F. REFER TO ELEVATION FOR LOCATION		0 S.F.	
TOTAL SQ. FT.	2897.28 S.F.	287.08 S.F.	9.91 %
TOTAL SQ. M.	269.16 S.M.	26.67 S.M.	9.91 %
<u>UNINSULATED OPENINGS</u> (PER OBC. SB-12,3.1.1(7))			
TH-6E ELEVATION 'A' WOD	ENERGY EFFICIENCY - OBC SB12		
ELEVATION	WALL AREA S.F.	OPENING S.F.	PERCENTAGE
FRONT	418.97 S.F.	96.694 S.F.	23.08 %
LEFT SIDE	1035.22 S.F.	50.556 S.F.	4.88 %
RIGHT SIDE	1035.22 S.F.	0 S.F.	0.00 %
REAR	495.42 S.F.	159.833 S.F.	32.26 %
* OPENINGS OMITTED AS PER SB-12 3.1.1.9(4) MAX 19.9 S.F. REFER TO ELEVATION FOR LOCATION		0 S.F.	
TOTAL SQ. FT.	2984.83 S.F.	307.08 S.F.	10.29 %
TOTAL SQ. M.	277.30 S.M.	28.53 S.M.	10.29 %
<u>UNINSULATED OPENINGS</u> (PER OBC. SB-12,3.1.1(7))			
TH-6E ELEVATION 'B' WOD	ENERGY EFFICIENCY - OBC SB12		
ELEVATION	WALL AREA S.F.	OPENING S.F.	PERCENTAGE
FRONT	413.42 S.F.	96.694 S.F.	23.39 %
LEFT SIDE	1035.22 S.F.	50.556 S.F.	4.88 %
RIGHT SIDE	1035.22 S.F.	0 S.F.	0.00 %
REAR	495.42 S.F.	159.833 S.F.	32.26 %
* OPENINGS OMITTED AS PER SB-12 3.1.1.9(4) MAX 19.9 S.F. REFER TO ELEVATION FOR LOCATION		0 S.F.	
TOTAL SQ. FT.	2979.28 S.F.	307.08 S.F.	10.31 %
TOTAL SQ. M.	276.78 S.M.	28.53 S.M.	10.31 %

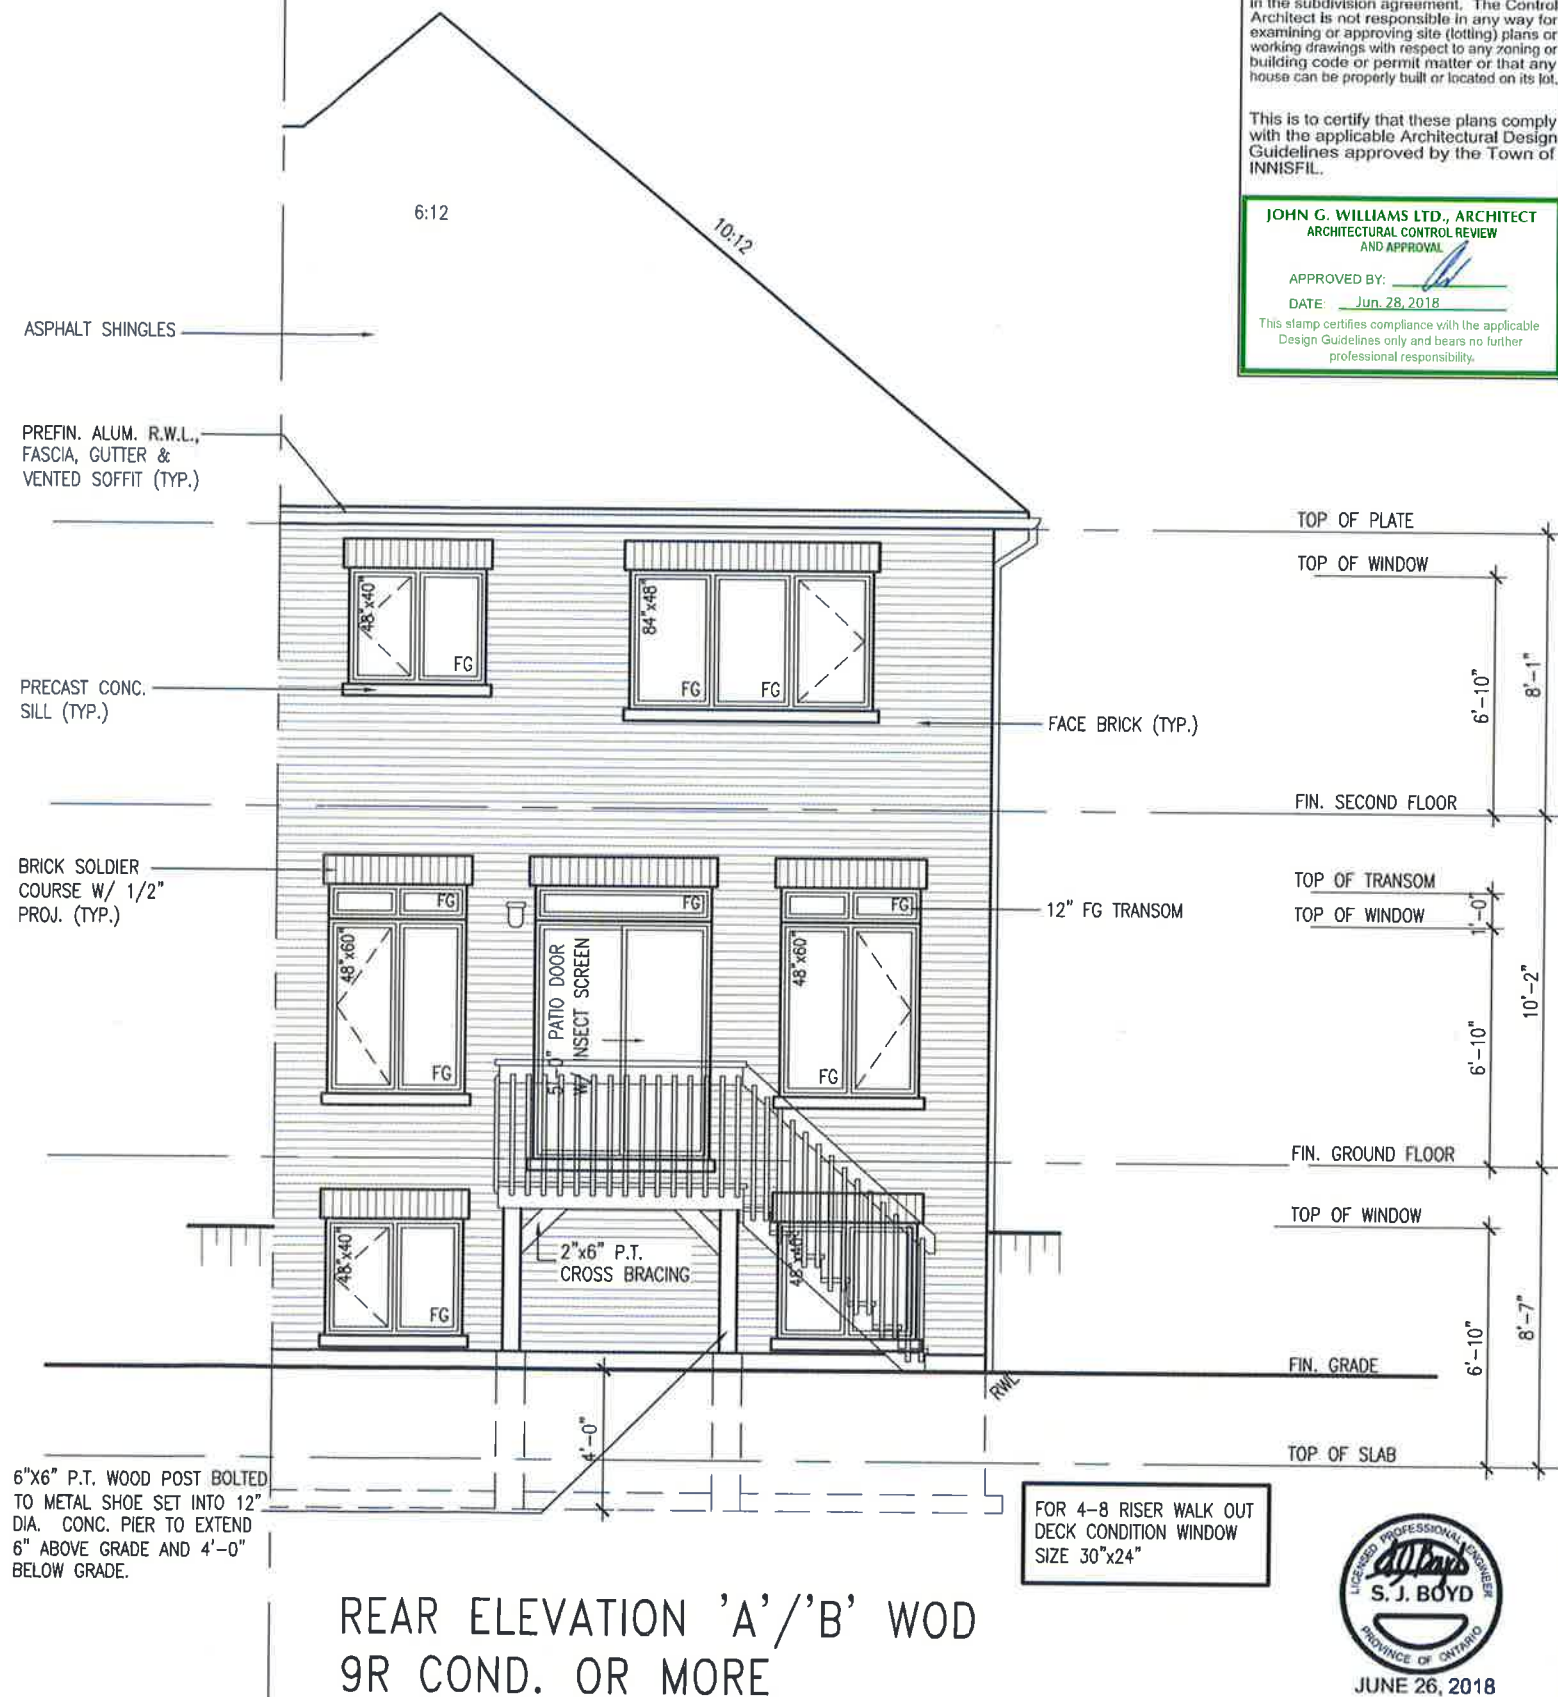

It is the builder's complete responsibility to ensure that all plans submitted for approval fully comply with the Architectural Guidelines and all applicable regulations and requirements including zoning provisions and any provisions in the subdivision agreement. The Control Architect is not responsible in any way for examining or approving site (lotting) plans or working drawings with respect to any zoning or building code or permit matter or that any house can be properly built or located on its lot.

JOHN G. WILLIAMS LTD., ARCHITECT
ARCHITECTURAL CONTROL REVIEW
AND APPROVAL

APPROVED BY: [Signature]
 DATE: Jun. 28, 2018

This stamp certifies compliance with the applicable Design Guidelines only and bears no further professional responsibility.

no.	description	date	by
1	ISSUED FOR CLIENT REVIEW	MAY 15-18	WT
2	REVISED AS PER FLOOR TRUSS COMMENTS.	MAY 22/18	WT
3	REVISED AS PER ROOF TRUSS COMMENTS.	MAY 22/18	WT
4	REVISED AS PER ENG'S COMMENTS	JUN 22-18	SB
5			
6			
7			
8			
9			
10			

the undersigned has reviewed and takes responsibility for this design and has the qualifications and meets the requirements set out in the Ontario Building Code to be a Designer.

qualification information

Wellington Jno-Baptista 25591 BCIN

signature

name and registration information

VAS Design Inc. 42658

Contractor must verify all dimensions on the job and report any discrepancy to the Designer before proceeding with the work. All drawings and specifications are instruments of service and the property of the Designer which must be returned at the completion of the work. Drawings are not to be copied.

255 Consumers Rd Suite 120
Scarborough ON M2J 1R4
t 416.630.2235 f 416.630.4782
yo@v3design.com

project name ALCONA	municipality INNISFIL, ON.	project no 13049
date DECEMBER 2017	drawn by WT	drawing no. 11
rear elevation 'A/B' scale 3/16" = 1'-0" WOD CONDITION file name 13049-TH-6E		

BAYVIEW WELLINGTON


TH-6E

CRANE 6

project name
ALCONA

municipality
INNISFIL, ON.

project no
13049

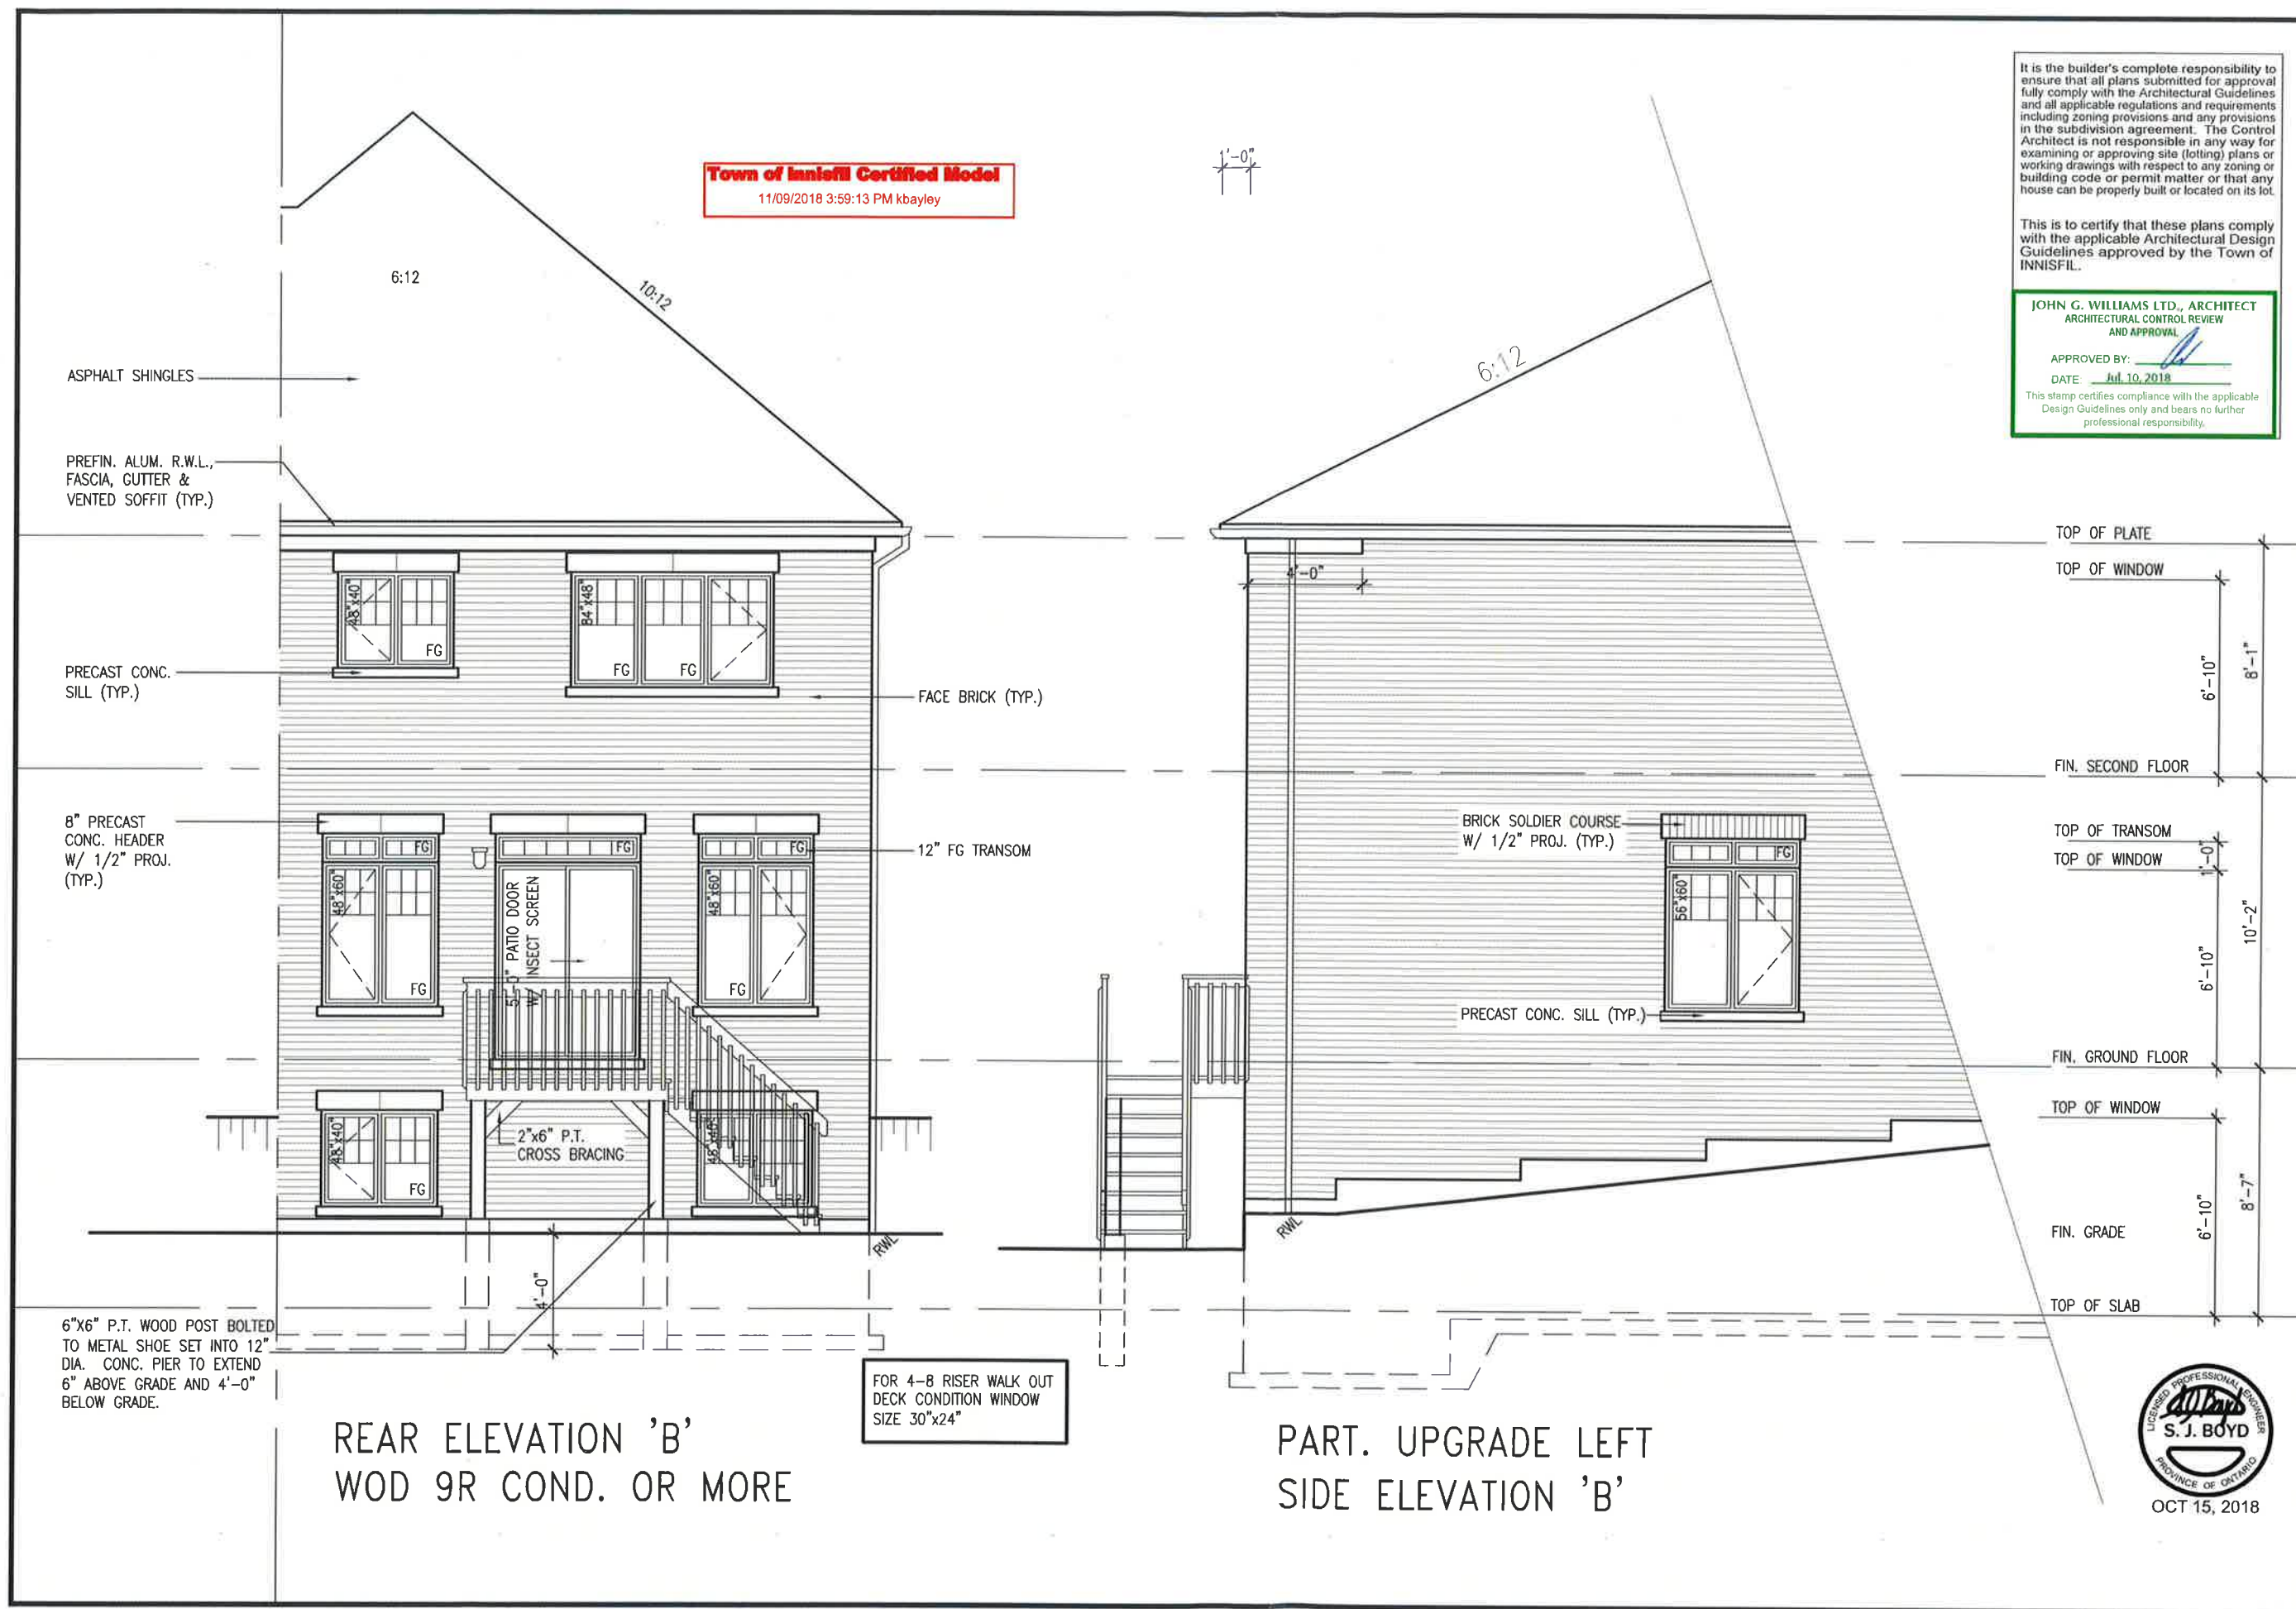

It is the builder's complete responsibility to ensure that all plans submitted for approval fully comply with the Architectural Guidelines and all applicable regulations and requirements including zoning provisions and any provisions in the subdivision agreement. The Control Architect is not responsible in any way for examining or approving site (lotting) plans or working drawings with respect to any zoning or building code or permit matter or that any house can be properly built or located on its lot.

This is to certify that these plans comply with the applicable Architectural Design Guidelines approved by the Town of INNISFIL.

JOHN G. WILLIAMS LTD., ARCHITECT
ARCHITECTURAL CONTROL REVIEW
AND APPROVAL

APPROVED BY:
DATE: Jul. 10, 2018

This stamp certifies compliance with the applicable Design Guidelines only and bears no further professional responsibility.

BAYVIEW WELLINGTON		TH-6E CRANE 6	
project name ALCONA	municipality INNISFIL, ON.	project no. 13049	drawing no. 1
date DECEMBER 2017	drawn by RC	scale 3/16" = 1'-0"	file name 13049-TH-6E
description REAR ELEVATION UPGRADE			
drawing no. 1			
drawing date 13049-TH-6E			
drawing time 1:51 PM			
drawing user RC			
drawing path \\H:\ARCHITECT\WORKING\2017\13049 BAYVIEW\TH-6E.dwg			
drawing created Tue - Jul 10 2018 - 1:51 PM			

VAS DESIGN
255 Consumers Rd. Suite 120
Toronto, ON M2J 1R4
t 416.630.2255 f 416.630.4782
vasdesign.com

The undersigned has reviewed and takes responsibility for this design and has the qualifications and meets the requirements set out in the Ontario Building Code to be a Designer.

qualification information
Wellington Jno-Baptiste 25591 BCIN

name
Wellington Jno-Baptiste 42658 BCIN


registration information
VAS Design Inc.

Contractor must verify all dimensions on the job and report any discrepancy to the Designer before proceeding with the work. All drawings and specifications are instruments of service and the property of the Designer which must be returned at the completion of the work. Drawings are not to be scaled.


no.	description	date	by
5	ADD UPGRADE REAR ELEVATION	JUL 05/18	PE
4	REVISED AS PER ENG'S COMMENTS	JUN 22/18	SB
3	REVISED AS PER FLOOR TRUSS COMMENTS	MAY 22/18	WT
2	REVISED AS PER ROOF TRUSS COMMENTS	MAY 18/18	WT
1	ISSUED FOR CLIENT REVIEW	JAN 15/18	WT



All drawings, specifications, related documents and design are the copyright property of VAS DESIGN. Reproduction of this property in whole or in part is strictly prohibited without VAS DESIGN's written permission.

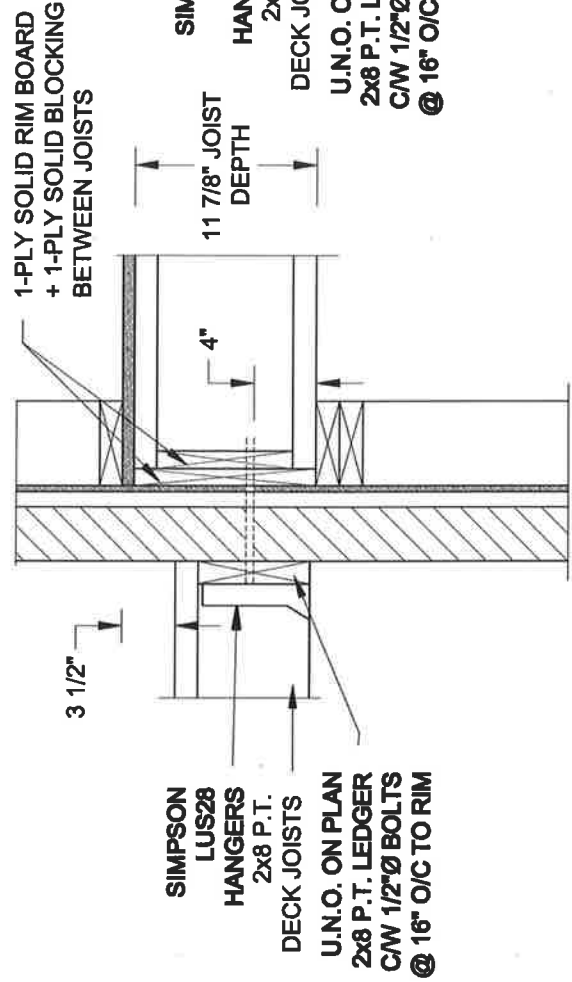


1A DECK FASTENING DETAIL
S2 SCALE: 1" = 1'-0"

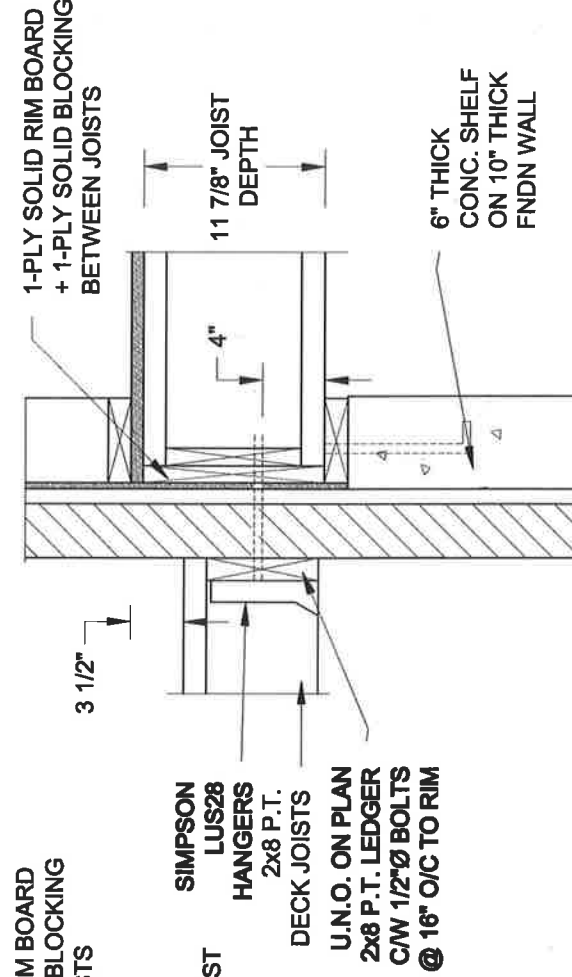


1B DECK FASTENING DETAIL
S2 SCALE: 1" = 1'-0"

- NOTE: 1. WHERE BACKFILL HEIGHT < 4'-7", PROVIDE 2x6 @ 16" o/c KNEEWALL ON 10" THICK CONC FNDN WALL
2. WHERE BACKFILL HEIGHT > 4'-7", PROVIDE 6" CONC SHELF FOR BRICK VENEER ON 10" THICK CONC FNDN WALL
3. FOOTING TO BE 22"x6" THICK UNLESS NOTED OTHERWISE ON PLAN.

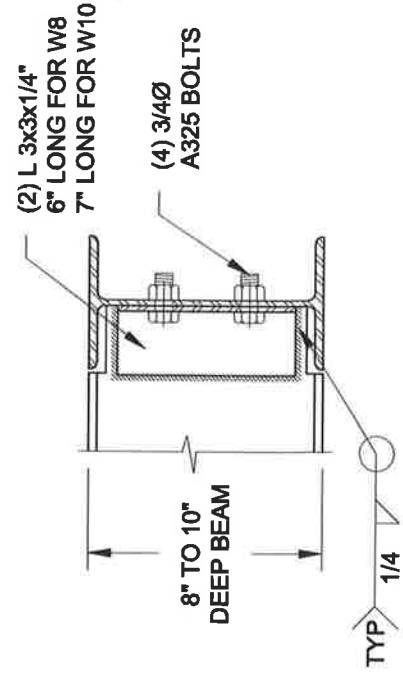


NOTE: DETAIL IS APPLICABLE TO W8x40 (W200x59) BEAM MAX
AND W10x39 (W250x58) BEAM MAX.

2
S2 SCALE: 1-1/2" = 1'-0"

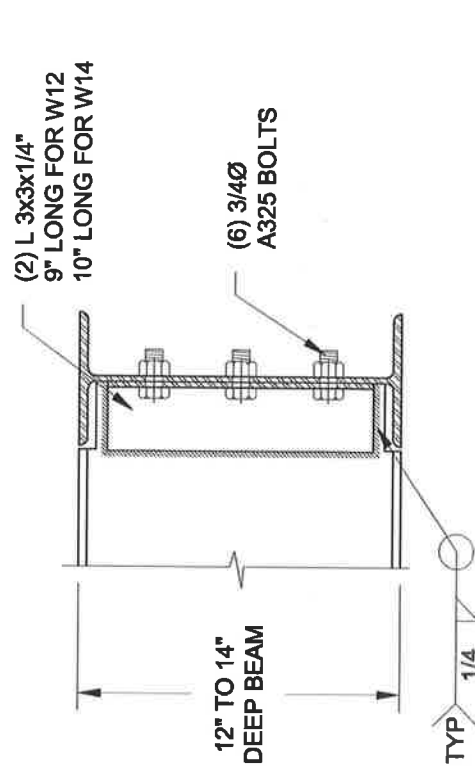

NOTE: DETAIL IS APPLICABLE TO W12x58 (W310x86) BEAM MAX
AND W14x48 (W360x72) BEAM MAX.

2
S2 SCALE: 1-1/2" = 1'-0"

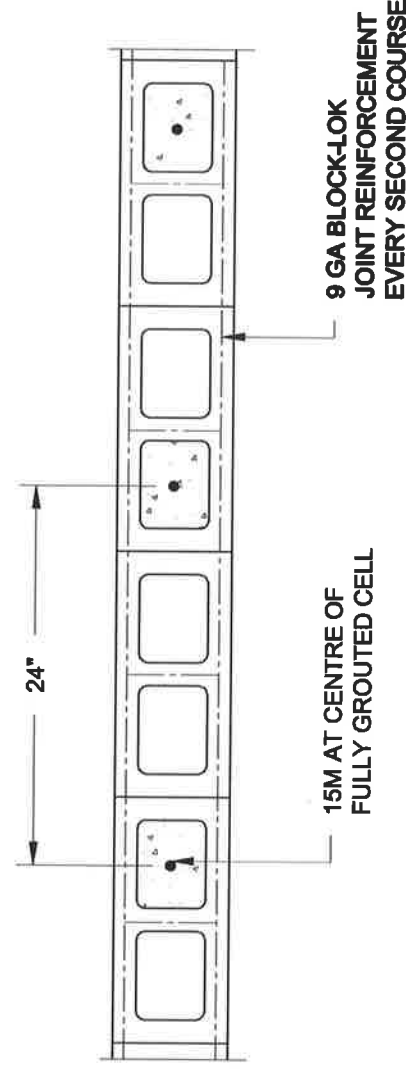


3
S2 SCALE: 1" = 1'-0"


NOTES:

1. REINFORCING STEEL TO CONFORM TO CSA G30.18, GRADE 400.
2. GROUT TO HAVE A COMPRESSIVE STRENGTH OF 20 MPa AT 28 DAYS WITH 10" SLUMP.
MAXIMUM AGGREGATE SIZE = 3/8".
3. LAP VERTICAL BARS 30" AT ANY SPLICES.

Scale: AS NOTED	QUAILE ENGINEERING LTD.  38 Parkside Drive, UNIT 7 Newmarket, ON L3Y 8J9 T: 905-853-8547 E: quaille.eng@rogers.com			Engineer's Seal  JUNE 22, 2018	Project: BAYVIEW WELLINGTON HOMES - ALCONA TOWNS MISSISSAUGA, ONTARIO
Drawn: SC	Checked: SJB	Project No.: 18-104	Drawing No.: S2		

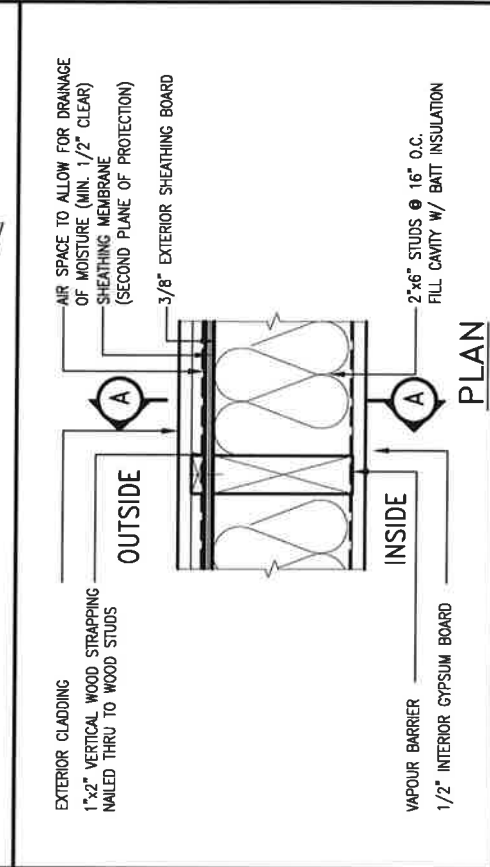

STUD WALL REINFORCEMENT FOR FUTURE GRAB BARS IN MAIN BATHROOM
REINFORCEMENT OF WOOD STUD WALLS SHALL BE INSTALLED ADJACENT TO WATER CLOSETS AND SHOWER OR BATHTUB IN MAIN BATHROOM PER OBC. DIV. B-9.5.2.3.
FUTURE GRAB BARS TO BE MOUNTED TO RESIST HORIZ. AND VERT. LOADS OF 1.3 KN (300 lb)
REFER TO OBC. DIV. B- WATER CLOSET 3.8.3.8.(3)(c) & 3.8.3.8.(3)(c). SHOWER 3.8.3.13.(2)(g). & BATHTUB 3.8.3.13.(4)(c). AND DETAILS PROVIDED BELOW.

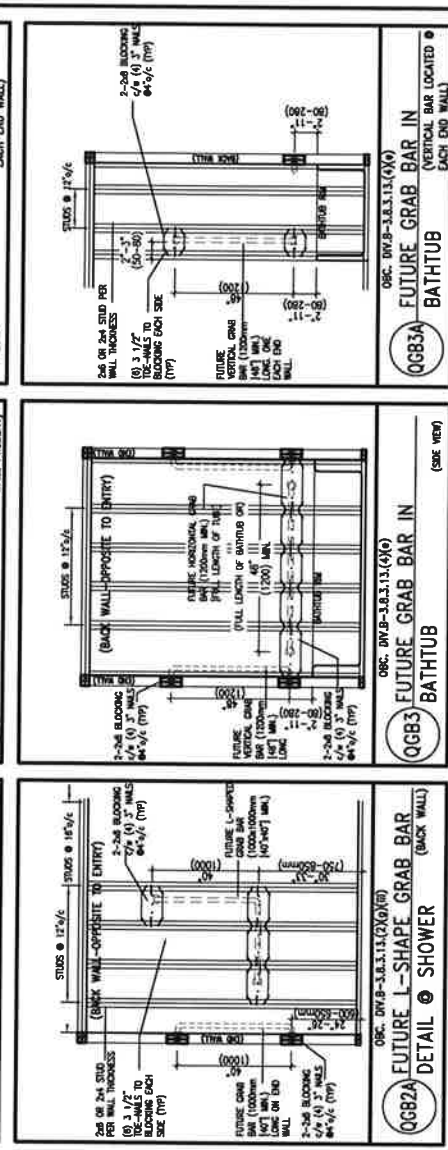

MAX. HEIGHT FOR 2"x8" EXTERIOR WALL IS AS FOLLOWS:

2"x8" @ 16" O.C. - 16'-0"
2"x8" @ 12" O.C. - 17'-9"
2"x8" @ 10" O.C. - 19'-0"
2'-2"x8" @ 16" O.C. - 20'-4"
2'-2"x8" @ 12" O.C. - 22'-4"


NOTES:

1. FOR ROOF DESIGN SNOW LOAD OF UP TO 2.5 kPa
2. SUPPORTED ROOF TRUSS LENGTH OF 6.0m ONLY.
3. PROVIDE HORIZONTAL SOLID BLOCKING @ 1200 C.C. (4' O.C.)
4. PROVIDE A MINIMUM OF 9.5mm (3/8") PLYWOOD OR 0.1875" EXTERIOR SHEATHING ON THE EXTERIOR FACE AND 12.5mm (1/2") GYPSUM BOARD ON THE INTERIOR FACE.
5. WALL FRAMING SHALL CONFORM TO CBC 9.23.10.1.(2)
6. FOR A 1/50 YEAR REFERENCE WIND PRESSURE OF 0.25
7. STUDS GREATER THAN 9'-10" HIGH TO BE NO. 2 SPF.
8. STUD SPECIFICATION IS SUITABLE FOR BRICK VENEER C SIDING.


** STUD INFORMATION TAKEN FROM OBC TABLE A-30

[illegible]

All drawings specifications, related documents and design are the copyright property of VA3 DESIGN. Reproduction of this property in whole or in part is strictly prohibited without VA3 DESIGN's written permission.

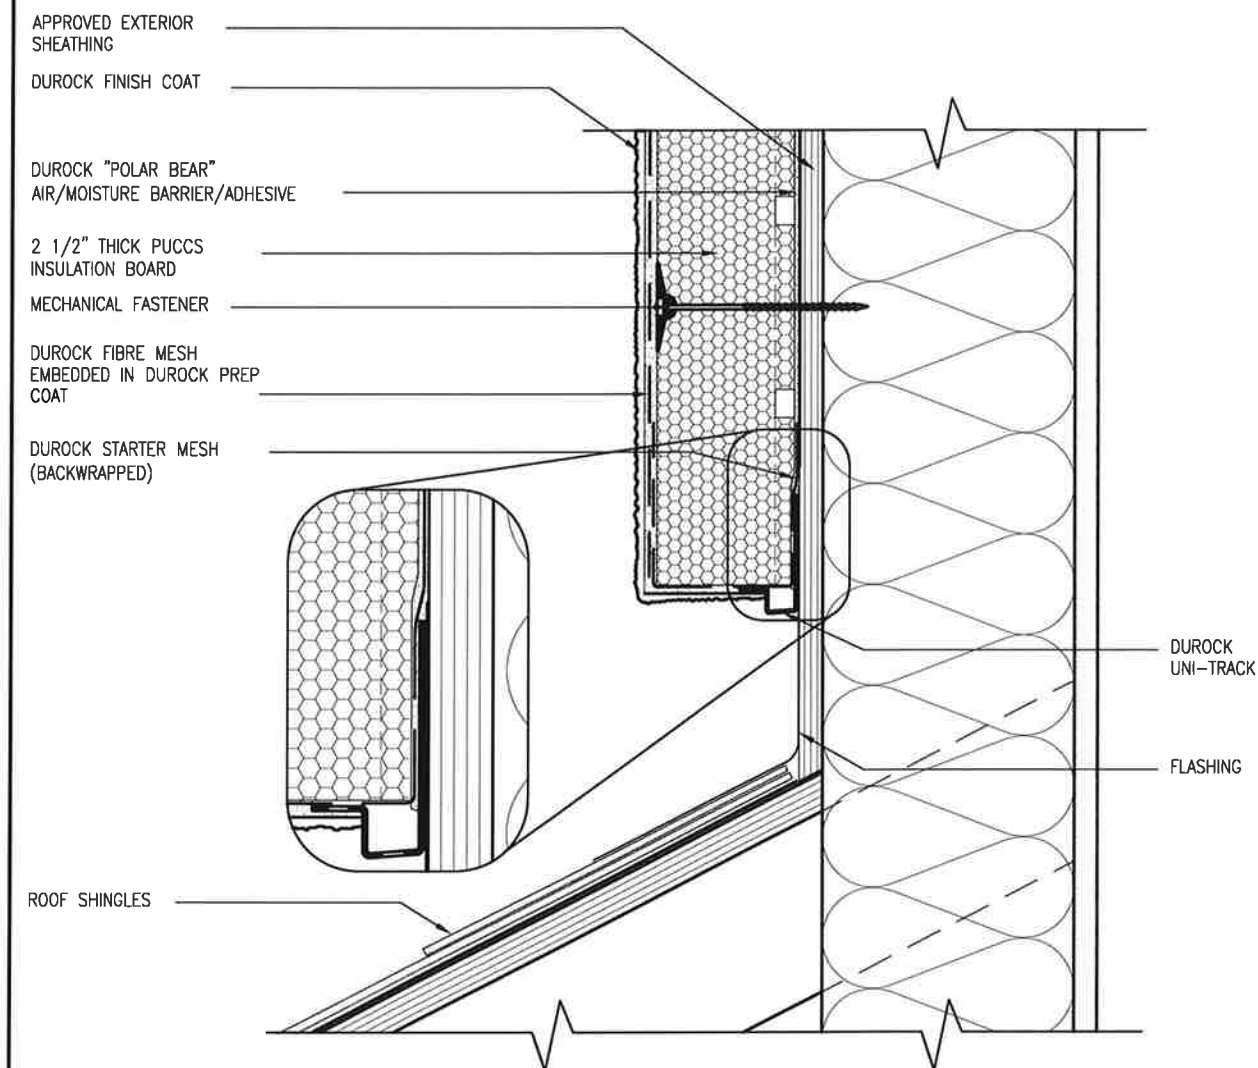

3 STUCCO TERMINATION @ ROOF
CN4 SCALE: 3"=1'-0"

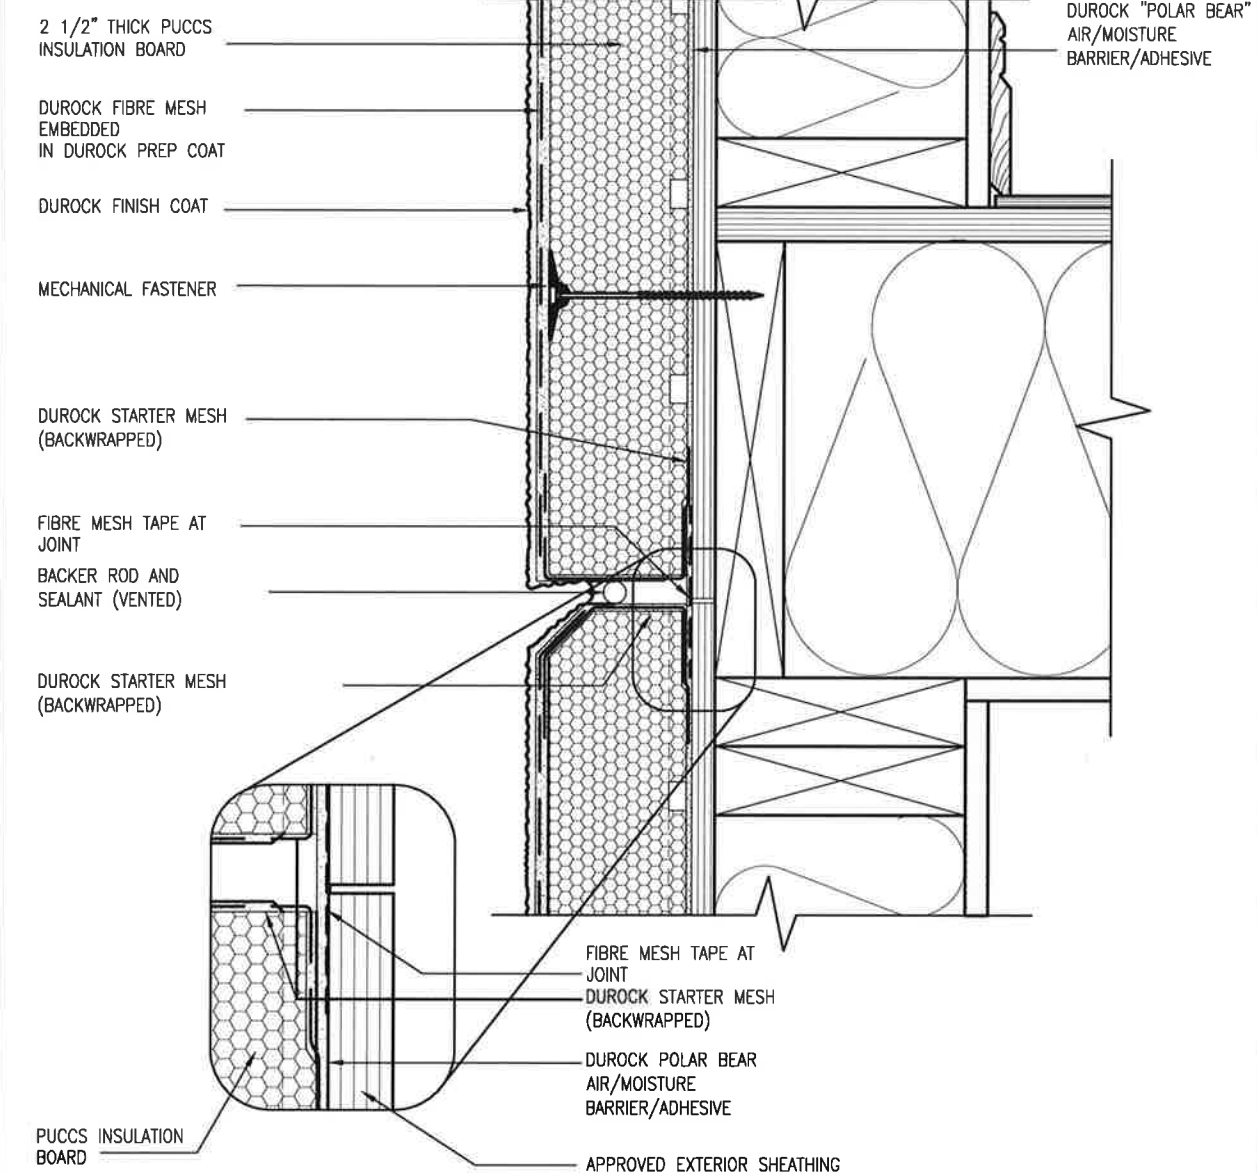

4 HORIZONTAL EXPANSION JOINT
CN4 SCALE: 3"=1'-0"

ALL STUCCO WALLS TO HAVE A MINIMUM 10mm AIR SPACE BEHIND THE CLADDING WITH POSITIVE DRAINAGE TO THE EXTERIOR. THE EXTERIOR SHEATHING MUST NOT BE GYPSUM BASED. ALL STUCCO TO BE INSTALLED AS PER MANUFACTURERS SPECIFICATIONS. DETAILS ARE BASED ON DuROCK PUCCS SYSTEM

CONST NOTE BAYVIEW WELLINGTON		project no. 13049 drawing no. CN4	
project name ALCONA municipality INNISFIL, ON.		construction notes 13049-CN-A1 VER 2020 date MAY 2016 checked by RC scale 3/16" = 1'-0"	
VA3 DESIGN 255 Consumers Rd Suite 120 Toronto, ON M2J 1R4 t 416.630.2255 f 416.630.4782 v3design.com		The undersigned has reviewed and takes responsibility for this design and has the qualifications and meets the requirements set out in the Ontario Building Code to be a Designer. qualification information name Wellington Jno-Baptiste registration number 25591 BCN 42658 VAS Design Inc. Contractor must verify all dimensions on the job and report any discrepancy to the Designer before proceeding with the work. All drawings and specifications are instruments of service and the property of the Designer which must be returned at the completion of the work. Drawings are not to be scaled.	
no.	description	date	by
2	UPDATE TO OBC VER 2020	FEB 09-21 RC	
1	ISSUE FOR CLIENT REVIEW	AUG 04-17 RC	



APPROVED EXTERIOR SHEATHING

DuROCK "POLAR BEAR" AIR/MOISTURE BARRIER

PURCC INSULATION BOARD

MECHANICAL FASTENER

DuROCK FINISH COAT

DuROCK FIBER MESH EMBEDDED IN DuROCK PREP COAT

DuROCK STARTER MESH (BACKWRAPPED)

BACKER ROD AND SEALANT (VENTED)

FLASHING

PRECAST SILL ON GROUT

WEPPHOLES @ 32"(800) O.C.

TRANSITION MEMBRANE. EXTEND MEMBRANE 6" ABOVE AND BELOW SILL. ENSURE TRANSITION MEMBRANE IS OVER BUILDING PAPER

BUILDING PAPER

6 STUCCO / MASONRY PLINTH CONNECTION
CN5 SCALE: 3"=1'-0"

9	-	-	-	The undersigned has reviewed and takes responsibility for the design and has the qualifications and meets the requirements set out in the Ontario Building Code to be a Designer.	
8	-	-	-	qualification information	
7	-	-	-	Wellsington Jno-Baptiste	25591
6	-	-	-	name	BCN
5	-	-	-	registration information	42658
4	-	-	-	VAS Design Inc.	
3	-	-	-	Contractor must verify all dimensions on the job and report any discrepancy to the Designer before proceeding with the work. All drawings and specifications are instruments of service and the property of the Designer which must be returned at the completion of the work. Drawings are not to be scaled.	
2	UPDATE TO OBC VER 2020	FEB 09-21	RC		
1	ISSUE FOR CLIENT REVIEW	AUG 04-17	RC		
no. description	date	by			



**VAS3
DESIGN**

255 Consumers Rd Suite 120
Toronto ON M2J 1R4
t 416.630.2255 f 416.630.4782
vas3design.com


BAYVIEW WELLINGTON

CONST NOTE

project name ALCONA	municipality INNISFIL ON.	project no. 13049
date MAY 2016	checked by RC	drawing no. CN5
drawn by RC	scale 3/16" = 1'-0"	file name 13049-CN-A1 VER 2020

RICHARD - 11 VARDING WAY, WOODBINE, ONTARIO L4B 3N5 (BAYVIEW/STEELES) VER 2020 Aug - 10 - Feb 9 2021 - 1117 AM

THE MINIMAL THERMAL PERFORMANCE OF BUILDING ENVELOPE AND EQUIPMENT SHALL CONFORM TO THE FOLLOWING SB-12 COMPLIANCE PACKAGE AS PER OBC SUPPLEMENTARY STANDARD SB-12, SECTION 3.1.1.1.

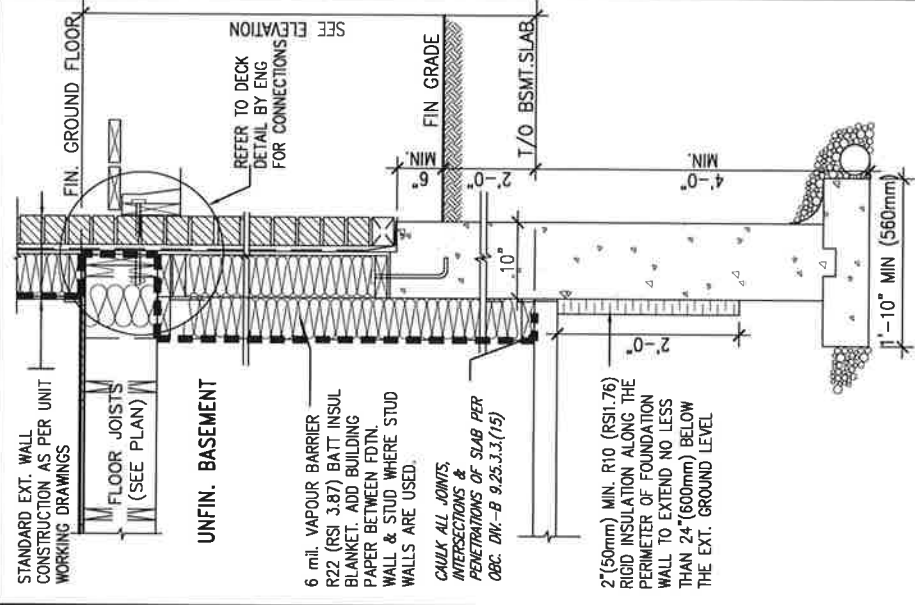

SECTION AT W.O.D/W.O.B.

AIR BARRIER SYSTEMS
AIR BARRIER TO BE INSTALLED IN
CONFORMANCE WITH OBC. DIV. B-9.25.3


SECTION w/ BRICK VENEER (PACKAGE A1)

SCALE: N.T.S.

BAYVIEW WELLINGTON		CONST NOTE	
project name ALCONA	municipality INNISSILLON.	project no. 13049	CN6
date MAY 2016		drawing no.	
drawn by checked by scale date RC - 3/16" = 1'-0" MAY 2016		CONSTRUCTION NOTES file name 13049-CN-A1 VER 2020	

All drawings specifications, related documents and design are the copyright property of VA3 DESIGN. Reproduction of this property in whole or in part is strictly prohibited without VA3 DESIGN's written permission.

SB12-COMPLIANCE PACKAGE 'A1'

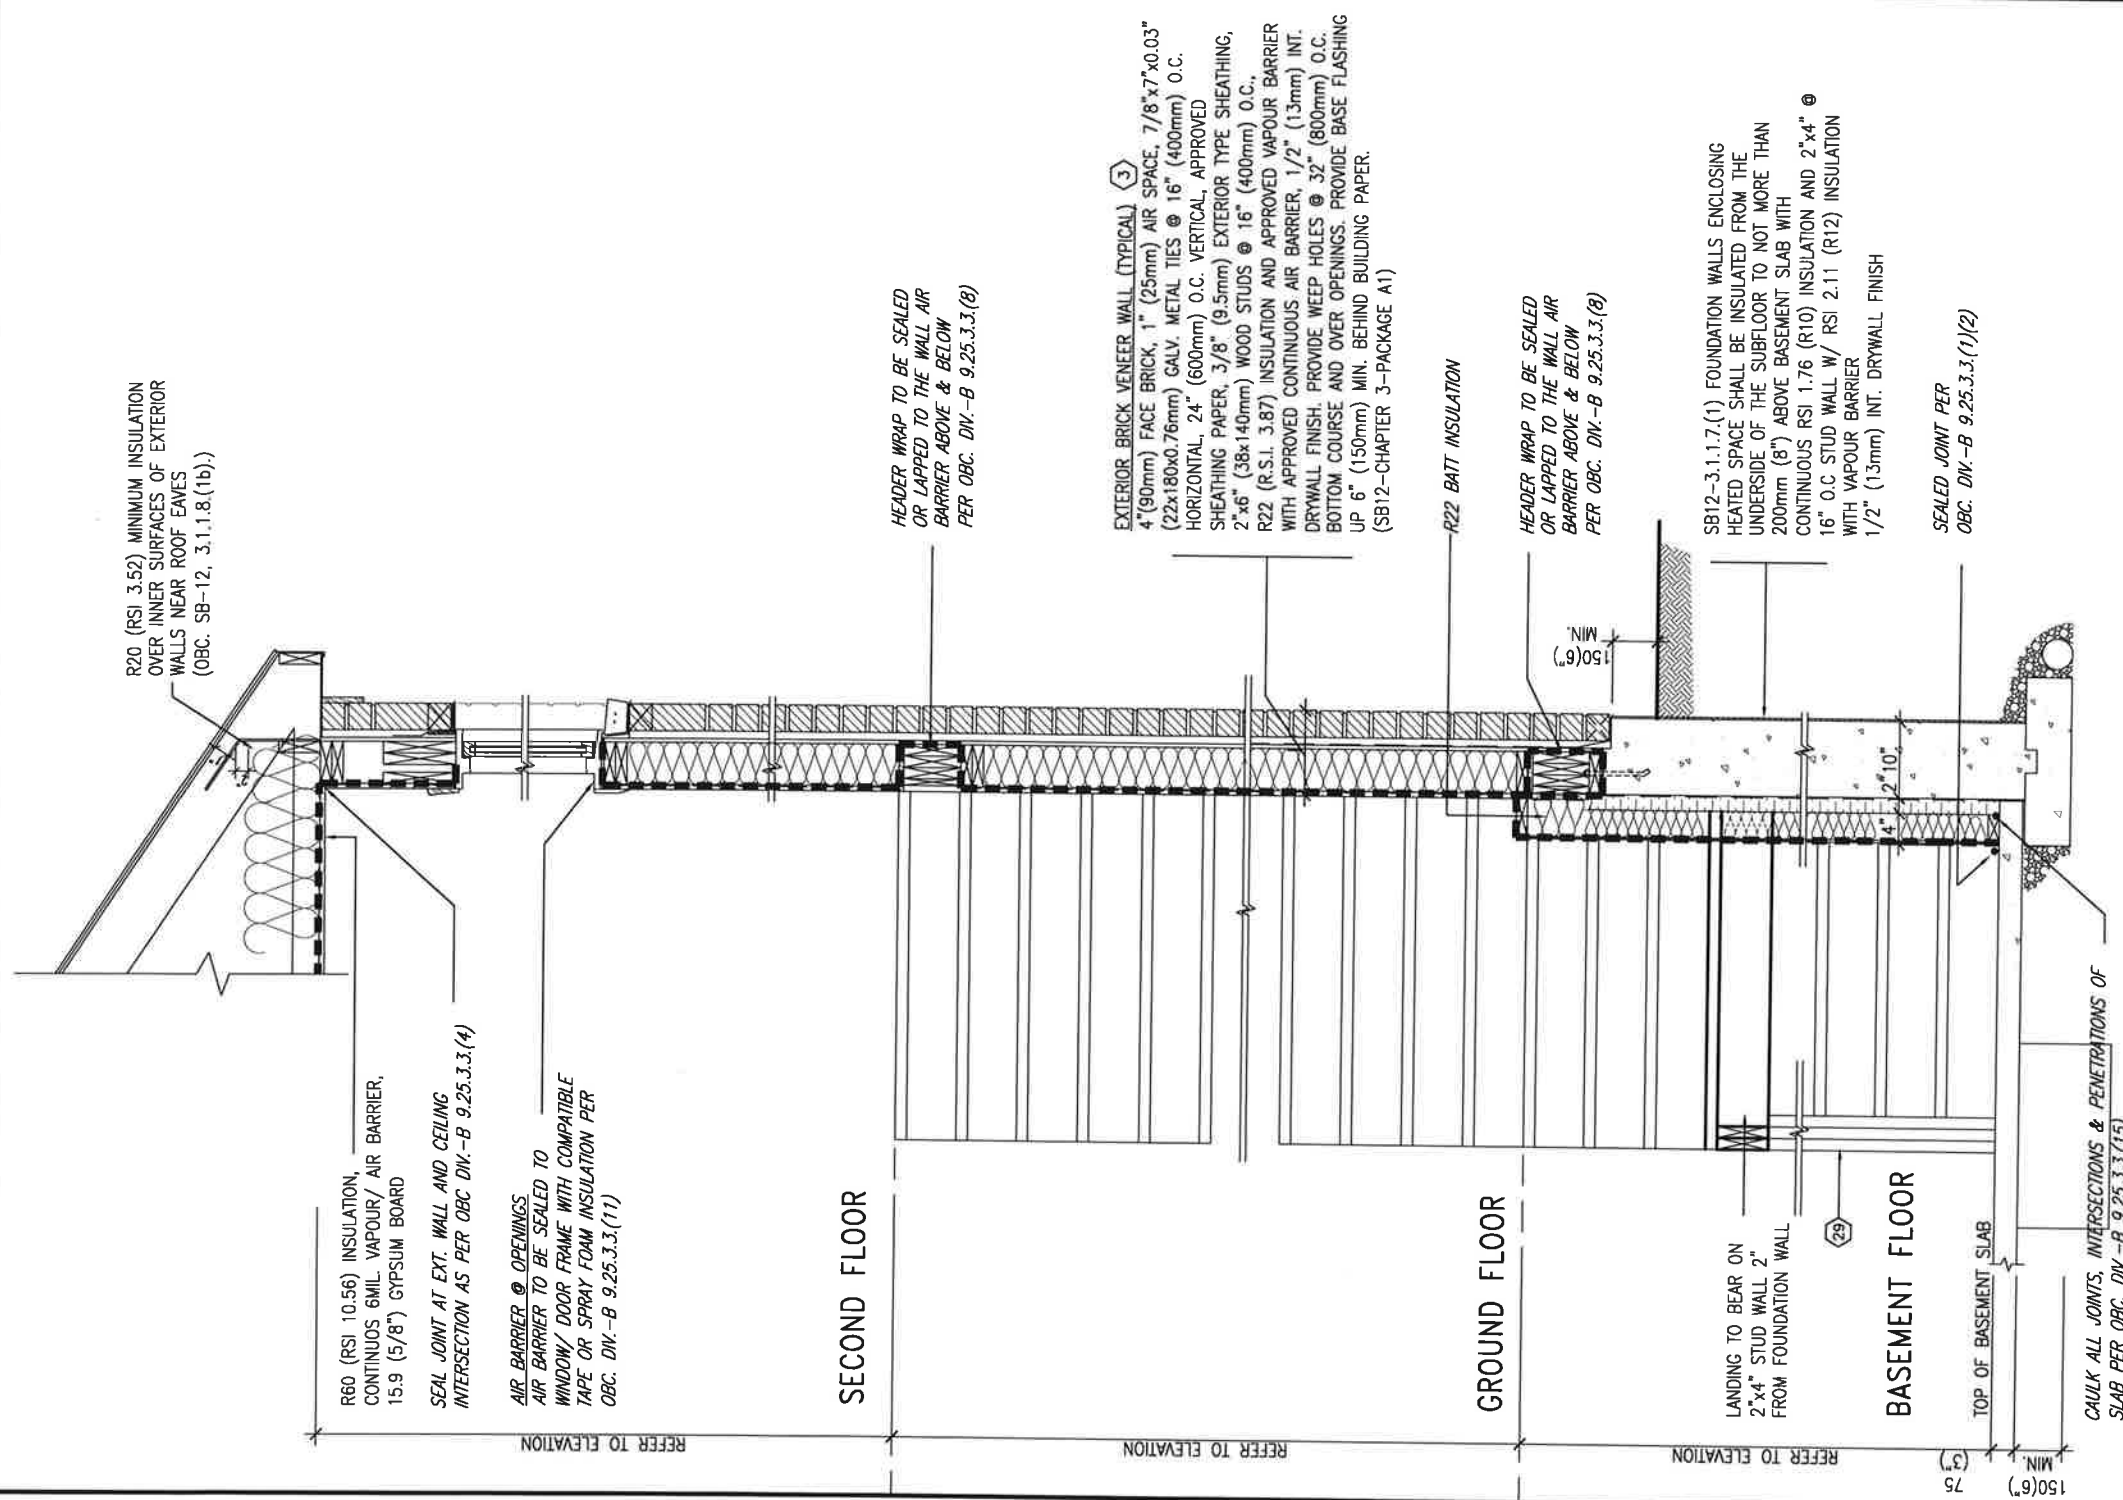


INSULATION REQUIREMENTS
REFER TO OBC SB-12, CHAPTER 3.
ZONE 1- COMPLIANCE PACKAGE A1.

REFER TO ADDITIONAL
DETAILS FOR STRUCTURAL
COMPONENTS

EW STR TYPICAL EXT. WALL AIR BARRIER CONTINUITY SECTION W/
BRICK VENEER AT STAIR AND SUNKEN COND (PACKAGE A1)
10" FOUNDATION WALL SCALE: N.T.S.


9	*	*	The undersigned has reviewed and takes responsibility for this design and lists the qualifications and meets the requirements set out in the Ontario Building Code to be a Designer
8	*	*	
7	*	*	qualification information
6	*	*	Wellington Jno-Baptiste
5	*	*	25591
4	*	*	signature
3	*	*	EDN
			VA3 Design Inc.
2	UPD/ATE TO OBC	FEB 09-21	RC
1	ISSUE FOR CLIENT REVIEW	AUG 04-17	RC
	description	date	by

		BAYVIEW WELLINGTON		CONST NOTE	
project name	ALCONA	municipality	INNISFIL ON.		
date	MAY 2016	checked by	—		
drawn by	RC	scale	3/16" = 1'-0"		
255 Consumers Rd Suite 120 Toronto ON M2J 1P4 416.630.7255 f 416.630.4782 va3design.com		CONSTRUCTION NOTES		drawing no.	project no.
				CN7	13049

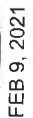


no.	description	date	by
3	1		
8	2		
7	3		
6	4		
5	5		
4	6		
3	7		
2	8		
1	9		

All drawings specifications, related documents and design are the copyright property of VA3 DESIGN. Reproduction of this property in whole or in part is strictly prohibited without VA3 DESIGN's written permission.

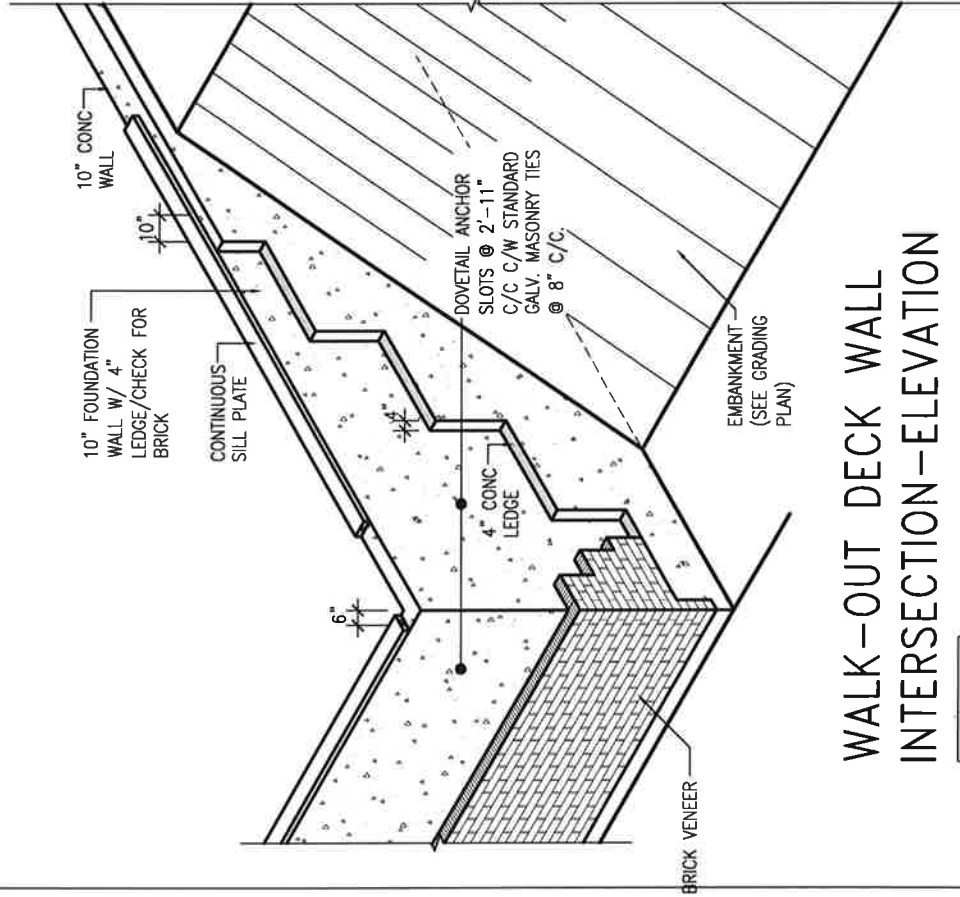

WALK-OUT DECK WALL
INTERSECTION-ELEVATION


NOT TO SCALE

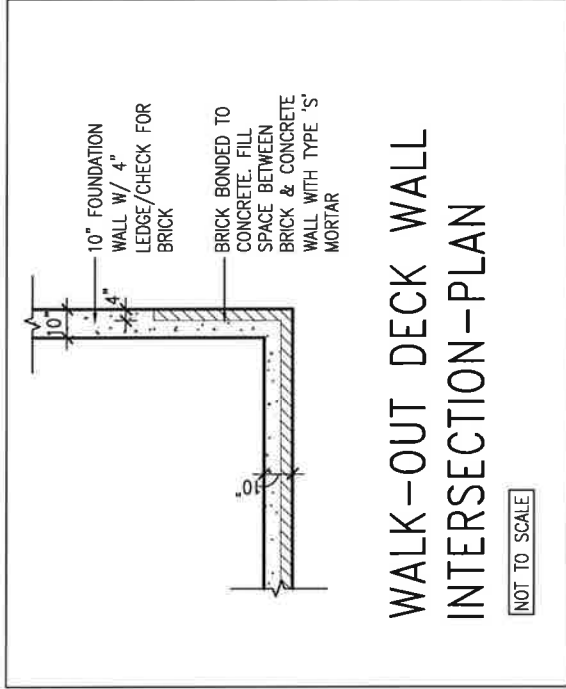

WALK-OUT DECK WALL
INTERSECTION-PLAN


NOT TO SCALE

(10" FOUNDATION WALL)

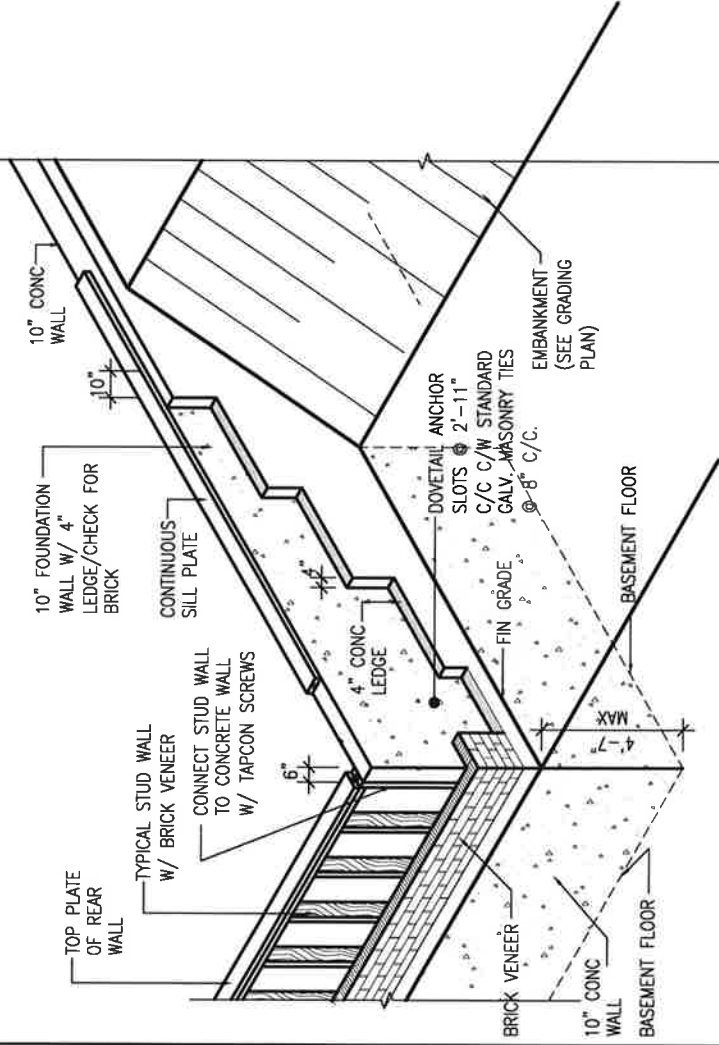

WALK-OUT DECK WALL
INTERSECTION-ELEVATION MAX
4'-7" BACKFILL

NOT TO SCALE

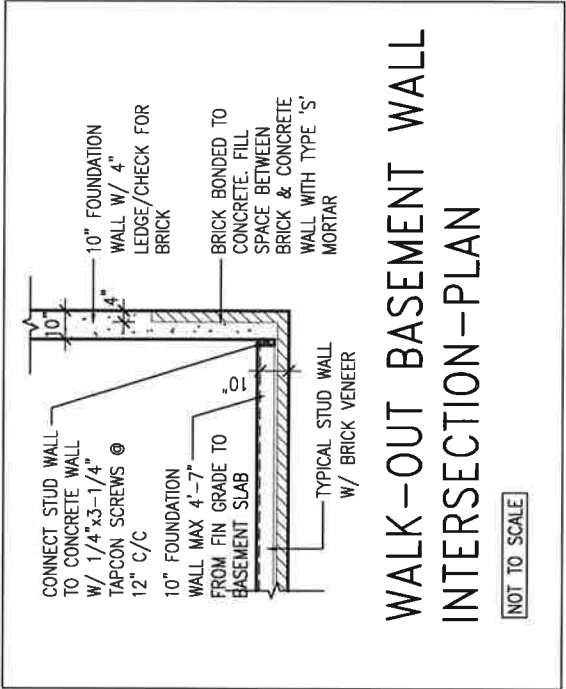

WALK-OUT BASEMENT WALL
INTERSECTION-PLAN

NOT TO SCALE

(10" FOUNDATION WALL)







FEB 9, 2021

no.	description	date	by
1	ISSUE FOR CLIENT REVIEW	AUG 04-17	RC
2	UPDATE TO OBC VER 2020	FEB 09-21	RC
3			
4			
5			
6			
7			
8			
9			

The undersigned has reviewed and takes responsibility for this design and has the qualifications and experience to perform the work in the Ontario Building Code to be a Designer. qualification information Wellington Jno-Baptiste 25591 name registration information VA3 Design Inc. BCN 42658	Contractor must verify all dimensions on the job and report any discrepancy to the Designer before payments of services and the property drawings and specifications are instruments of service and the property of the Designer which must be returned at the completion of the work. Drawings are not to be scaled.
--	--

VA3 DESIGN
255 Consumers Rd Suite 120
Toronto ON M2J 1R4
t 416.630.2255 f 416.630.4782
va3design.com

project name	ALCONA	municipality	INNISFIL, ON.	CONST NOTE
date	MAY 2016	checked by		
drawn by	RC	scale	3/16" = 1'-0"	
project no.	13049	drawing no.	CN10	
file name	13049-CN-A1 VER 2020			

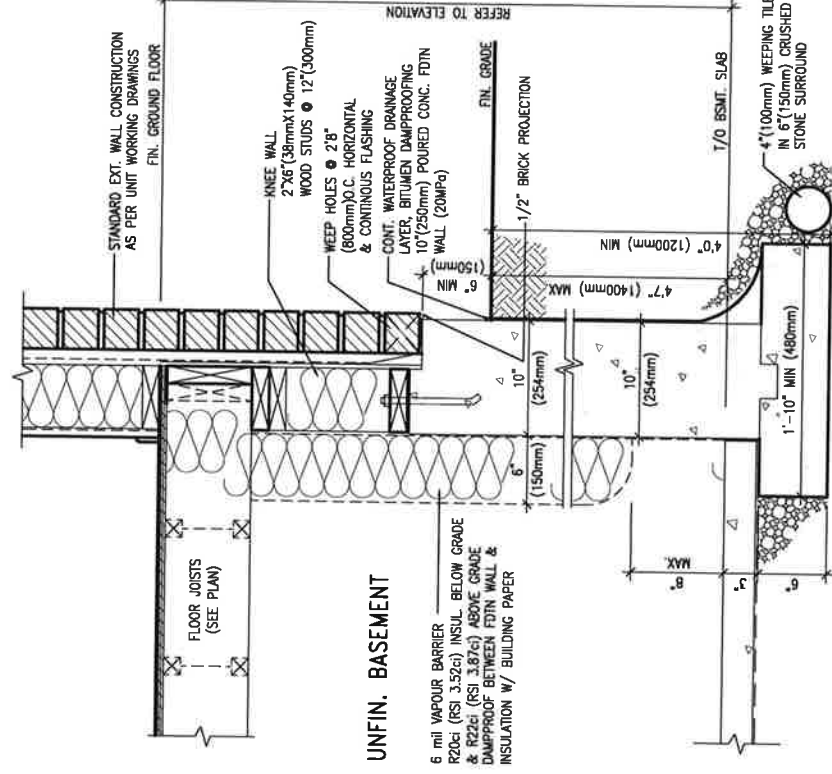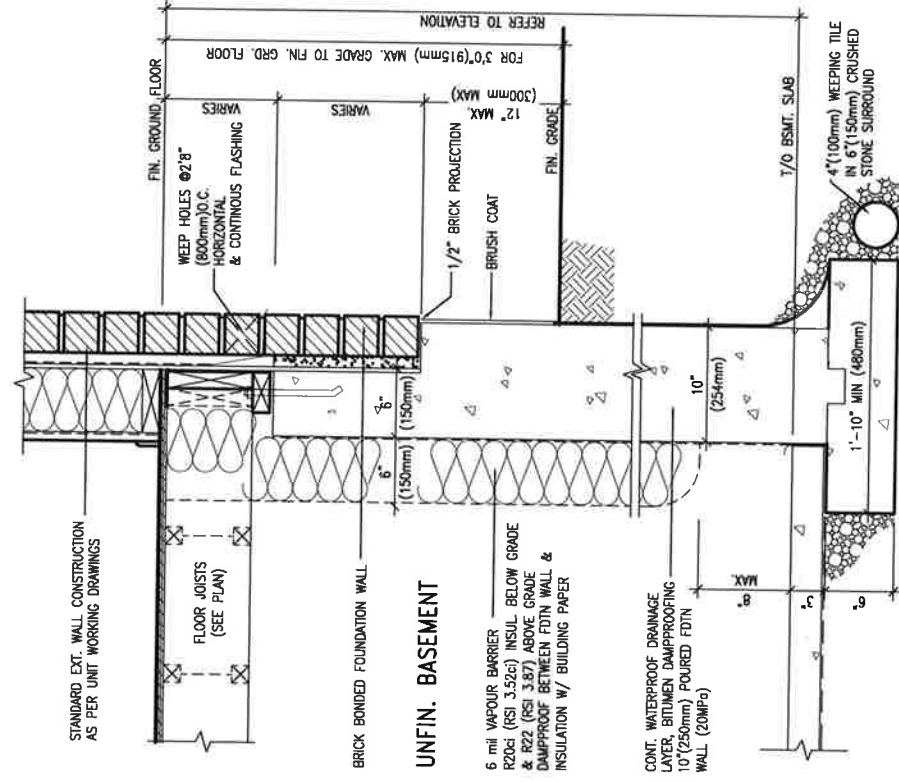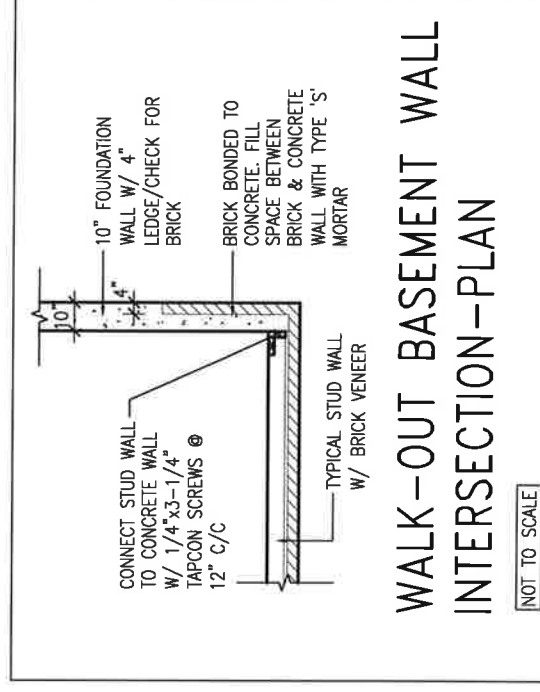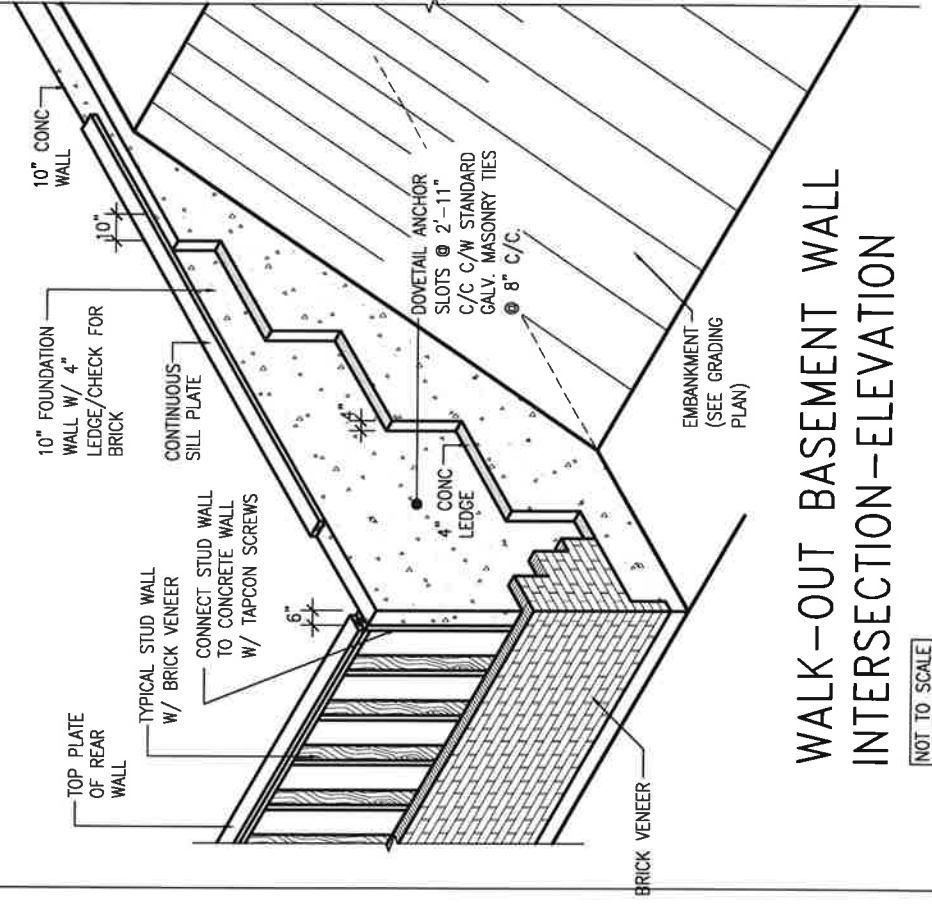

EW3.06x
PKG A1

WALL SECTION FOR GRADE TO FIN.
FLOOR MORE THAN 4'7" (1400mm)
HEIGHT DIFFERENCE

SCALE: N.T.S.

EW3.07x
PKG A1

WALL SECTION FOR GRADE TO BASEMENT
SLAB 4'7" (1400mm)
MAX. HEIGHT DIFFERENCE

SCALE: N.T.S.

[illegible]

BAYVIEW WELLINGTON	CONST NOTE
project name ALCONA	municipality INNISFIL, ON.
date MAY 2016	project no. 13049
drawn by RC	drawing no. CN11
checked by -	CONSTRUCTION NOTES
scale 3/16" = 1'-0"	file name 13049-CN-A1 VER 2020

All drawings specifications, related documents and design are the copyright property of VA3 DESIGN. Reproduction of this property in whole or in part is strictly prohibited without VA3 DESIGN's written permission.