


It is the builder's complete responsibility to ensure that all plans submitted for approval fully comply with the Architectural Guidelines and all applicable regulations and requirements including zoning provisions and any provisions in the subdivision agreement. The Control Architect is not responsible in any way for examining or approving site (lotting) plans or working drawings with respect to any zoning or building code or permit matter or that any house can be properly built or located on its lot.

This is to certify that these plans comply with the applicable Architectural Design Guidelines approved by the City of VAUGHAN.

JOHN G. WILLIAMS LTD., ARCHITECT
ARCHITECTURAL CONTROL REVIEW
AND APPROVAL

APPROVED BY: _____
DATE: MAR 18, 2022

This stamp certifies compliance with the applicable Design Guidelines only and bears no further professional responsibility.

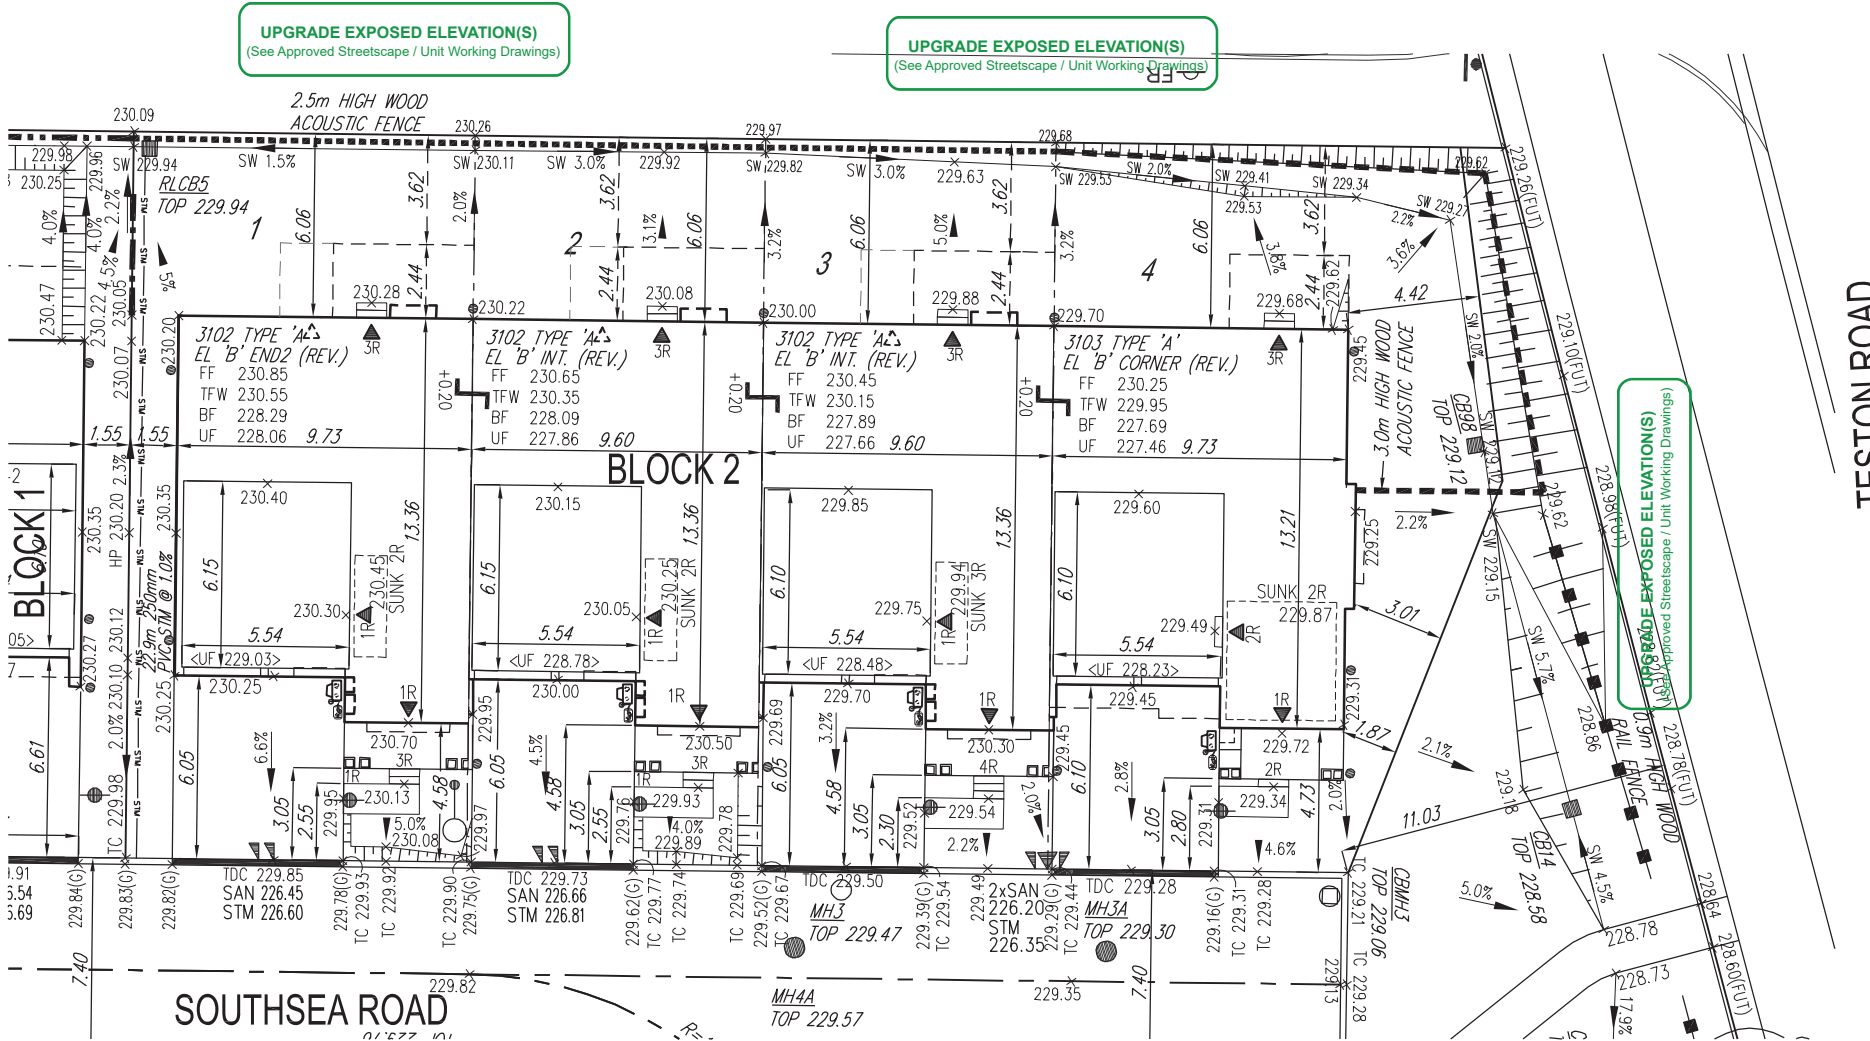

BUILDING HEIGHT		COVERAGE CALCULATION		COVERAGE CALCULATION		COVERAGE CALCULATION		COVERAGE CALCULATION	
MAX BUILDING HEIGHT:	12.00 m	LOT NO. :	BLK 2-1	LOT NO. :	BLK 2-2	LOT NO. :	BLK 2-3	LOT NO. :	BLK 2-4
FROM AVERAGE FIN. GRADE TO MEAN		LOT AREA :	270.75 m ²	LOT AREA :	230.43 m ²	LOT AREA :	230.43 m ²	LOT AREA :	434.08 m ²
ESTABLISHED GRADE:	229.72	BLDG. AREA :	139.82 m ²	BLDG. AREA :	138.24 m ²	BLDG. AREA :	138.24 m ²	BLDG. AREA :	140.00 m ²
F.F. TO TOP OF ROOF:	10.06 m	LOT COVERAGE (%):	51.64 %	LOT COVERAGE (%):	59.99 %	LOT COVERAGE (%):	59.99 %	LOT COVERAGE (%):	32.25 %
F.F. TO MEAN OF ROOF:	7.65 m	FRONTAGE @ 6.4M		FRONTAGE @ 6.4M		FRONTAGE @ 6.4M		FRONTAGE @ 6.4M	
PROPOSED BLDG. HGT:	8.78 m	FRONTAGE:	11.28 m	FRONTAGE:	9.60 m	FRONTAGE:	9.60 m	FRONTAGE:	12.21 m
FRONT LANDSCAPE STATS		FRONT LANDSCAPE STATS		FRONT LANDSCAPE STATS		FRONT LANDSCAPE STATS		FRONT LANDSCAPE STATS	
FRONT YARD AREA :		FRONT YARD AREA :		FRONT YARD AREA :		FRONT YARD AREA :		FRONT YARD AREA :	
LANDSCAPE AREA :		LANDSCAPE AREA :		LANDSCAPE AREA :		LANDSCAPE AREA :		LANDSCAPE AREA :	
COVERAGE (%):		COVERAGE (%):		COVERAGE (%):		COVERAGE (%):		COVERAGE (%): (50% MIN)	
SOFT LANDSCAPE AREA:		SOFT LANDSCAPE AREA:		SOFT LANDSCAPE AREA:		SOFT LANDSCAPE AREA:		SOFT LANDSCAPE AREA:	
COVERAGE (%):		COVERAGE (%):		COVERAGE (%):		COVERAGE (%):		COVERAGE (%): (60% MIN)	

NOTE:
SANITARY LATERAL INFORMATION IS BASED ON
AS-BUILT SHEET PROVIDED ON OCTOBER 19, 2020

City of Vaughan
GRADING APPROVED BY
Matt Pascoe
BLOCK 2 TH 4
April 25 2022

LOT 2

REVIEWED FOR:


1. GRADING AS BEING IN CONFORMANCE WITH THE DRAINAGE CONCEPTS SHOWN ON THE APPROVED LOT GRADING PLANS PREPARED BY SCS CONSULTING GROUP LTD.

Date: MAR 02/22 Reviewed By: VP

SCS CONSULTING GROUP LTD.

- GENERAL NOTES:
- BUILDER TO VERIFY LOCATION OF UTILITIES AND OTHER SERVICES. IF MIN. DIMENSIONS ARE NOT MAINTAINED, BUILDER IS TO RELOCATE AT BUILDER'S EXPENSE.
 - BUILDER TO VERIFY ELEV. OF STM. AND SAN. LATERALS IN RELATION TO BASEMENT U/S OF FOOTING ELEVATIONS FOR COMPLIANCE WITH MUNICIPAL STANDARDS PRIOR TO EXCAVATION.
 - APPROVED PERMIT DRAWINGS & CONSTRUCTION NOTES MUST BE REVIEWED AND FOLLOWED IN CONJUNCTION WITH THE SITING AND GRADING PLAN. BUILDER TO VERIFY BUILDING ENVELOPE ON SITE PLAN MATCHES APPROVED PERMIT DRAWINGS & CONSTRUCTION NOTES PRIOR TO POURING CONCRETE. IF THERE ARE ANY DISCREPANCIES, THEY ARE TO BE BROUGHT TO THE ATTENTION OF HUNT DESIGN ASSOCIATES INC.
 - UNLESS NOTED ON BUILDING ENVELOPE OR APPROVED PERMIT DRAWINGS & CONSTRUCTION NOTES, ALL TOP OF FOUNDATION WALLS INCLUDING GARAGE WALLS TO BE CONSISTENT WITH THE ELEVATION PROVIDED FOR TFW ON SITING AND GRADING PLAN. THE EXTERIOR OF THE FOUNDATION WALL TO BE PROVIDED WITH A REDUCTION OF THICKNESS FOR MASONRY VENEER AS REQUIRED.

ISSUED FOR PERMIT	AW	2022.02.22
ISSUED FOR ENG. GRADING REVIEW	AW	2021/11/03
ISSUED FOR SITE PLAN APPROVAL	OF	2019/11/26
REVISED TO MATCH NEW GRADING AND FENCE DETAILS	OF	2019/09/18
REVISED AS PER CITY COMMENTS	OF	2019/08/07
ISSUED FOR SITE PLAN APPROVAL	OF	2019/01/29
ISSUED FOR SITE PLAN APPROVAL	OF	2018/03/16

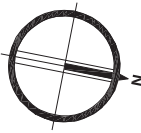

	ENGINEERED FILL LOTS		SANITARY MANHOLE		WATER SERVICE		BELL PEDESTAL		HYDRO TRANSFORMER		SAN - SANITARY LINE		DOWNSPOUTS
	STREET TREE		STORM MANHOLE		HYDRO SERVICE		CABLE PEDESTAL		PADMOUNTED MOTOR		STM - STORM WATER LINE		WINDOWS PERMITTED
	RETAINING WALL		VALVE & CHAMBER		SHEET DRAINAGE		HYDRO POLE		HYDRO POLE GUY		GAS LINE		45 MINUTE FIRE RATED WALL
	CATCH BASIN		VALVE & BOX		STREET LIGHT PEDESTAL		STREET SIGN		CABLE LINE		BELL		EXTERIOR DOOR LOCATION
	DOUBLE / SINGLE STM & SAN CONNECTION		HYDRANT		TRAFFIC SIGNAL POWER PEDESTAL		COMMUNITY MAILBOX		EMBANKMENT / BERM		HYDRO, GAS, BELL, CABLE LINE		EXTERIOR DOOR LOCATION IF GRADE PERMITS
	SUMP PUMP AND SURFACE DISCHARGE LOCATION		UPGRADE ELEVATION		CHAIN LINK FENCE		PRIVACY FENCE		ACOUSTIC FENCE		FF - FINISHED FLOOR		TFW - TOP OF FOUNDATION WALL
	BASEMENT FLOOR		WOD - WALKOUT DECK		MOD - MODIFIED		REV - REVERSED		NO - NO DOOR		HIGHLIGHTED GRADE		HIGHLIGHTED GRADE

SITING AND GRADING PLAN

THE UNDERSIGNED HAS REVIEWED AND TAKES RESPONSIBILITY FOR THIS DESIGN AND HAS THE QUALIFICATIONS AND MEETS THE REQUIREMENTS SET OUT IN THE ONTARIO BUILDING CODE TO BE A DESIGNER.

QUALIFICATION INFORMATION

NAME: Allan Whiting
SIGNATURE: [Signature]
BCIN: 23177

REGISTRATION INFORMATION

HUNT DESIGN ASSOCIATES INC. 19695

HUNT
DESIGN ASSOCIATES INC.

www.huntdesign.ca

GOLDPARK HOMES - 217014
PINE VALLEY DRIVE, VAUGHAN, ONTARIO

Drawn By: [Blank] OF: [Blank] Scale: 1:250 File Number: 217014-SPA3

Lot / Page Number

BLOCK 2

8966 Woodbine Ave, Markham, ON L3R 0J7 T 905.737.5133 F 905.737.7326