



TEL:

CONSTRUCTION

01Jun18 Note:

01Jun18 Note: MASTER ENSUITE BATHROOM - INSTALLED ABOVE TUB

01Jun18 Note:

01Jun18 Note:

01Jun18 Note:

18Apr18 Note:

01Jun18 Note: MASTER ENSUITE BATHROOM - CHROME KNOB AND HINGES

01Jun18 Note:

01Jun18 Note:

18Apr18 Note: NEW PROMO BALANCE \$9135.00

The Vendor agrees that notwithstanding any other term or provision in this Agreement included in the Purchase Price and in addition to those items detailed in Schedule GP to the Agreement of Purchase and Sale, the Purchaser is entitled to a credit of Ten

Worksheet Note:


... ABOVE AS PER VENDORS STANDARD SAMPLES

Worksheet Note:


Worksheet Note:

Page 1 of 1

enpark
GROUP

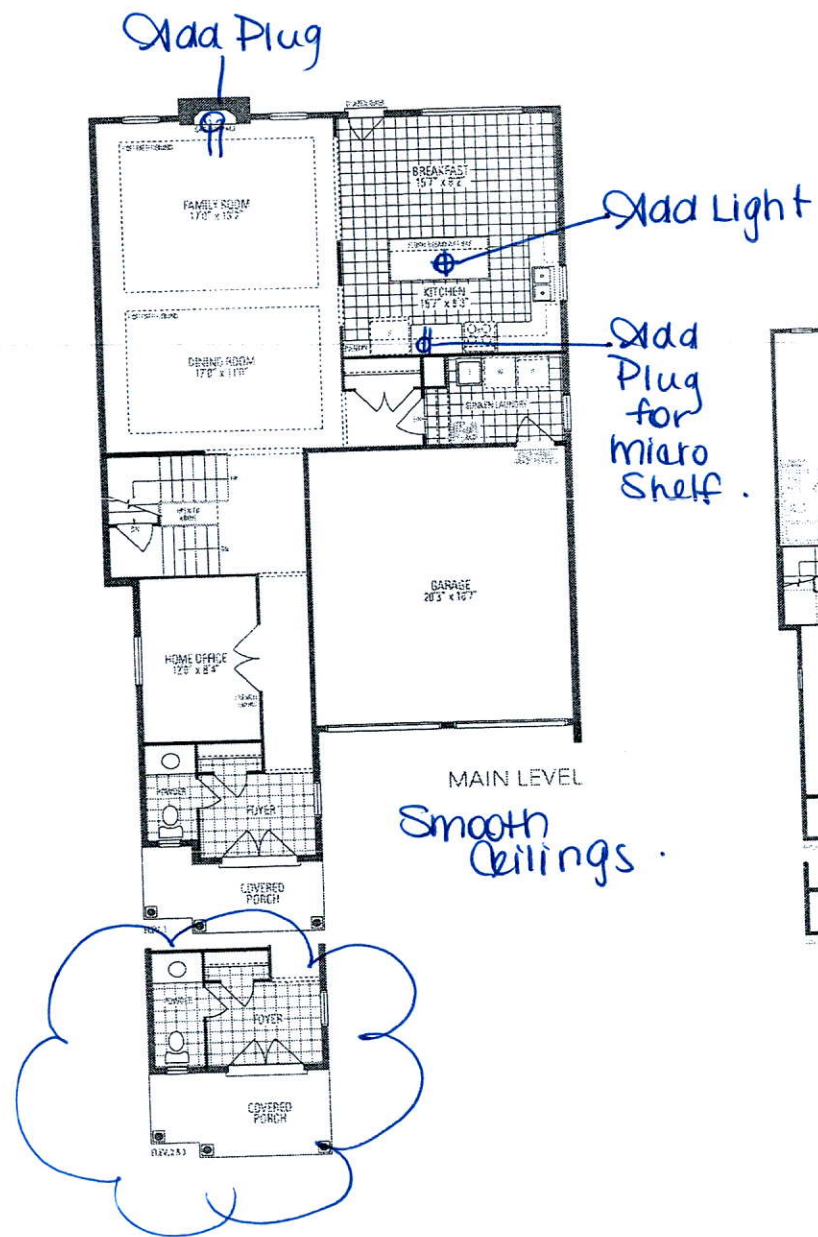

ROSEWOOD 5
3,002 sq.ft.

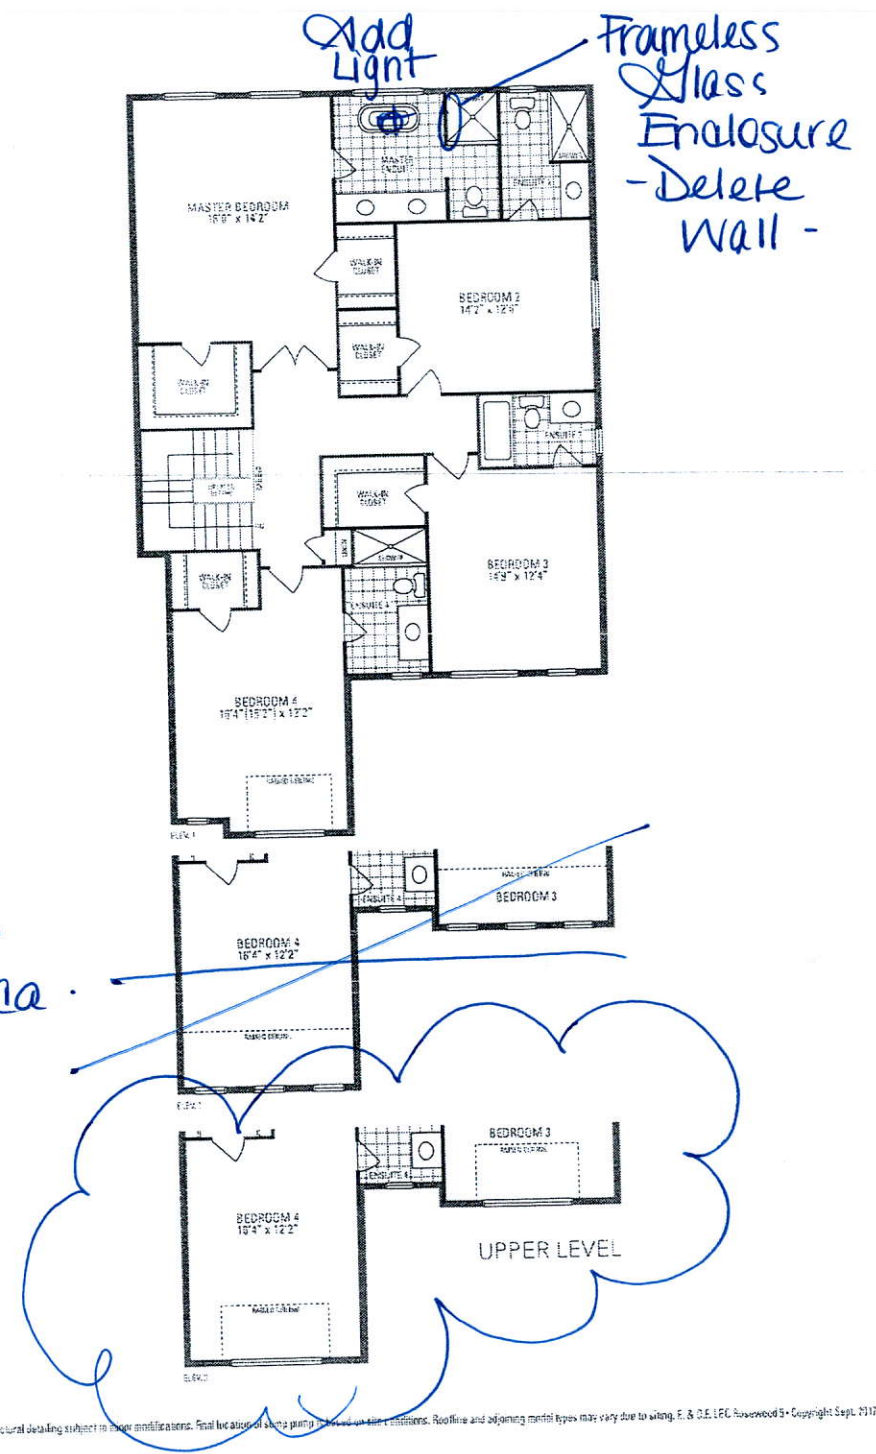

Orientation of home may be reversed and purchaser agrees to accept the same. Steps and porches may vary at any exterior entrance ways due to grading variance. Actual usable floor space may vary from the stated floor area. All renderings are artist's concept. Dimensions, specifications and architectural detailing subject to change without notice. Final location of some items may vary due to site conditions. Roofline and adjoining model types may vary due to wiring, E & C.E. L.P.C. Rosewood 5 • Copyright Sept. 2017