

CONSTRUCTION SUMMARY

Mountainview Heights (G) - Russell Gardens Building Ltd.

RECEIVED JUN 14 2018



PURCHASER: MIRZA M KAMALUDEEN

TEL:

LOT / PHASE 116 / 2	REG. PLAN # 62M-1238	HOUSE TYPE Rosewood 3 Elev 3		
------------------------	-------------------------	---------------------------------	--	--

ELECTRICAL

1 - RELOCATE STANDARD KITCHEN LIGHT TO BE CENTERED OVER ISLAND 14Jun18 Note:	
2 - LIGHT AND SWITCH - NO FIXTURE INCLUDED 14Jun18 Note: LIVING/DINING ROOM - INSTALLED ON WALL FOR FUTURE SCONCES INSTALLED 68" FROM FLOOR & 72" APART - SEE SKETCH	

MIRRORS AND GLASS

1 - FRAMELESS GLASS SHOWER ENCLOSURE 14Jun18 Note: MASTER ENUSUITE BATHROOM - CHROME KNOB AND HINGES	
---	--

PROMOTIONAL

1 - PARTIAL REDEMPTION OF PROMOTIONAL PACKAGE \$6,600.00 BALANCE FORWARD TO BE USED AT A LATER DATE. ORIGINAL PROMOTIONAL PACKAGE OF \$10,000.00 AS PER SCHEDULE PE 14Jun18 Note:	
--	--


EXTRAS AS PER OFFER

The Vendor agrees that notwithstanding any other term or provision in this Agreement included in the Purchase Price and in addition to those items detailed in Schedule GP to the Agreement of Purchase and Sale, the Purchaser is entitled to a credit of Ten Worksheet Note:	
The Purchaser acknowledges that the Purchase Price is inclusive of all credits and promotional packages available at the time of purchase. Worksheet Note:	

This Document is Extremely Time Sensitive - Printed 14 Jun 18 at 11:50





enpark  
GROUP

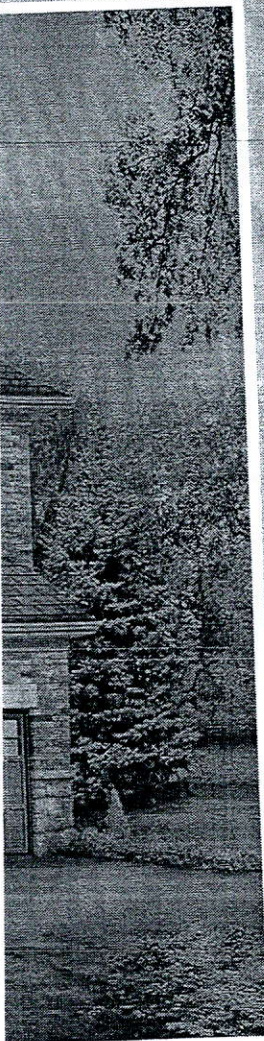


Relocate Std  
Light Above  
Island

Install 2  
Lights for  
Future  
Scones  
60" from  
floor  
72" apart

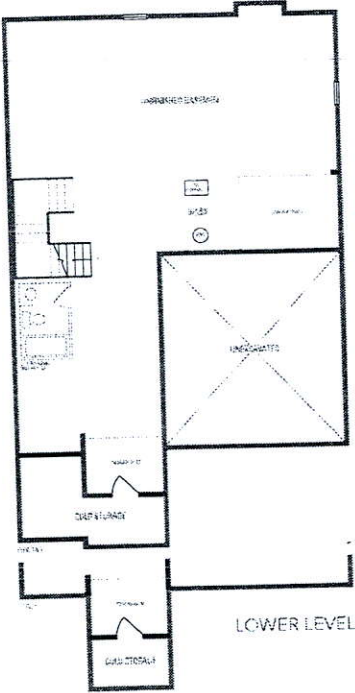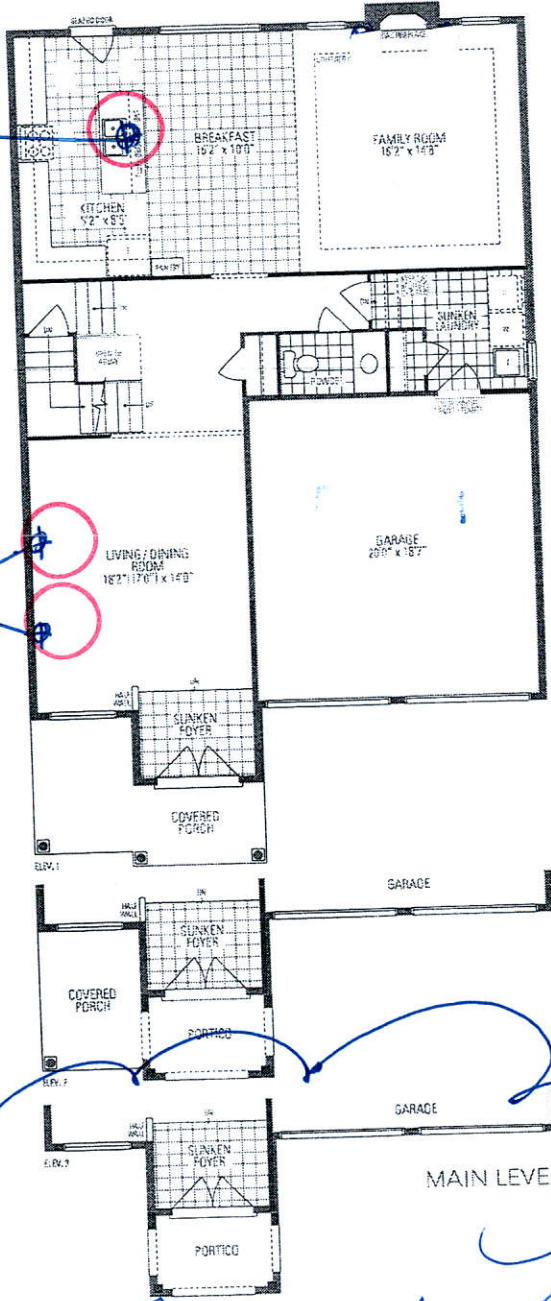

Frameless Glass Shower  
Enclosure - Delete Wall -

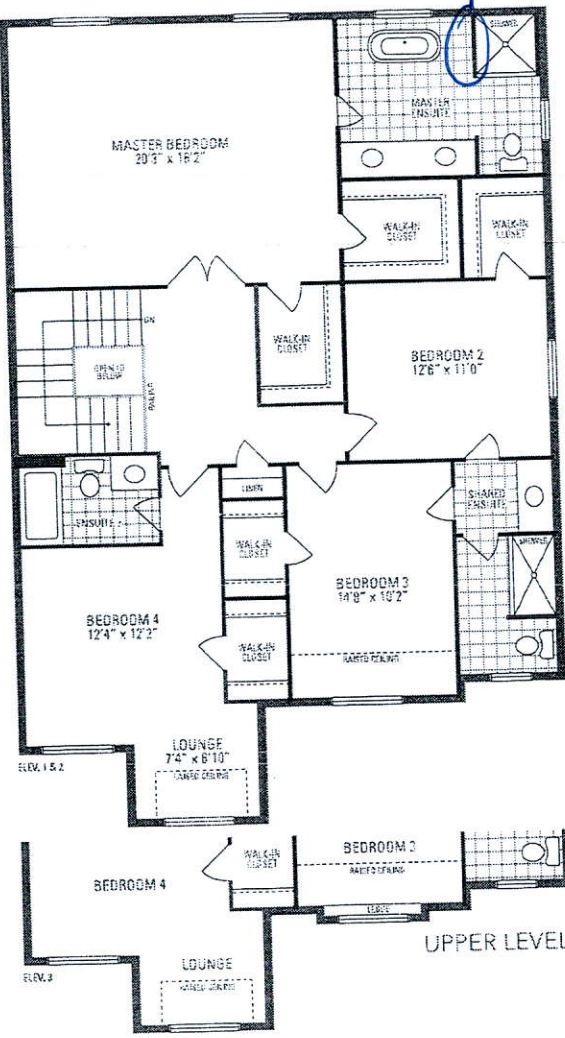

ROSEWOOD 3  
2,870 sq.ft. includes 12 sq.ft. of open area

Orientation of home may be reversed and purchaser agrees to accept the same. Views and pictures may vary at any exterior entrance ways due to grading variance. Actual usable floor space may vary from the stated floor area. All renderings are artist's concept. Dimensions, specifications and architectural detailing subject to minor modifications. Final location of sump pump is based on site conditions. Roofline and adjoining material types may vary due to pricing. E. & G.E. L&L Rosewood 3 • Copyright Sept. 2017