



CONSTRUCTION SUMMARY

Mountainview Heights (G) - Russell Gardens Building Ltd.

PURCHASERS: JOHN K O'SHAUGHNESSY and VIRGINIA LAYOG

TEL: RES.: 289-681-0085

LOT / PHASE	REG. PLAN #	HOUSE TYPE		
103 / 2	62M-1238	Rosewood 1A Elev 1		

CABINETRY

1 - CABINETRY - KITCHEN - CM11 CROWN MOULDING 19Jun18 Note:	
----------------------------------------------------------------	--

CABINETRY ACCESSORIES

1 - PANTRY UNIT UPGRADE - TO GO FROM 300MM TO 600MM DEEP - PRICE IS PER FOOT - STANDARD 19Jun18 Note:	
1 - KITCHEN CABINETRY UPPER - FULL DEPTH ABOVE FRIDGE - WITH GABLES - 600MM - PRICE IS EACH - STANDARD 19Jun18 Note:	
2 - KITCHEN CABINETRY UPPER - GLASS DOOR - CORD GLK340 - FINISHED INTERIOR - FITS TALL UPPER CABINETS - PRICE IS PER DOOR - STANDARD 19Jun18 Note:	

CERAMIC TILE

1 - DELETE ALL CERAMIC BATHROOM ACCESSORIES - DELETE TOWEL BAR, PAPER HOLDER & SOAP DISH THROUGHOUT 19Jun18 Note:	
----------------------------------------------------------------------------------------------------------------------	--

CONSTRUCTION

1 - DELETE BULK HEADS IN KITCHEN IF CONSTRUCTION PERMITS 19Jun18 Note:	
---------------------------------------------------------------------------	--

ELECTRICAL

1 - POT LIGHT - LED - FIRST FLOOR INSTALLATION 05Jun18 Note: LIVING/DINING ROOM - INSTALLED ON SEPERATE SWITCH FROM STANDARD LIGHT - SEE SKETCH	
1 - POT LIGHT - LED - FIRST FLOOR INSTALLATION 05Jun18 Note: KITCHEN - INSTALLED ON SEPERATE SWITCH FROM STANDARD LIGHT - SEE SKETCH	
3 - LIGHT AND SWITCH - NO FIXTURE INCLUDED 05Jun18 Note: ALL ENSUITE BATHROOMS - INSTALLED ON CEILING	
1 - PLUG - ELECTRICAL PLUG - TO BE INSTALLED OVER FIREPLACE 05Jun18 Note:	
2 - ABOVE KITCHEN ISLAND - ADD LIGHT AND SWITCH - NO FIXTURE INCLUDED 05Jun18 Note:	

HARDWOOD FLOORING

1 - HARDWOOD - PROMO SERIES 4 7/16 INCH - IN LIEU OF 2 1/4 INCH NATURAL RED OAK - - MAIN HALL 19Jun18 Note:	
1 - HARDWOOD - PROMO SERIES 4 7/16 INCH - IN LIEU OF 2 1/4 INCH NATURAL RED OAK - - LIVING AND DINING ROOM 19Jun18 Note:	
1 - HARDWOOD - PROMO SERIES 4 7/16 INCH - IN LIEU OF 2 1/4 INCH NATURAL RED OAK - - FAMILY ROOM 19Jun18 Note:	

PLUMBING

4 - MOEN BATHROOM ACCESSORIES - MASON CHROME - TOWEL BAR 24" #YB8094/YB8000 - PRICE IS EACH 19Jun18 Note: ALL BATHROOMS	
4 - MOEN BATHROOM ACCESSORIES - MASON CHROME - PAPER HOLDER #YB8099/YB8000 - PRICE IS EACH 19Jun18 Note: ALL BATHROOMS	

PROMOTIONAL

RECEIVED JUN 19 2018

RECEIVED JUN 19 2018

CONSTRUCTION SUMMARY

Mountainview Heights (G) - Russell Gardens Building Ltd.

PURCHASERS: JOHN K O'SHAUGHNESSY and VIRGINIA LAYOG

TEL: RES.: 289-681-0085

LOT / PHASE	REG. PLAN #	HOUSE TYPE		
103 / 2	62M-1238	Rosewood 1A Elev 1		
1 - LESS BALANCE OF CREDIT FROM PURCHASER EXTRA SHEET IN OFFER 19Jun18 Note:				
1 - PARTIAL REDEMPTION OF PROMOTIONAL PACKAGE \$10,365.00 BALANCE FORWARD TO BE USED AT A LATER DATE. ORIGINAL PROMOTIONAL PACKAGE OF \$12,000.00 AS PER SCHEDULE PE 05Jun18 Note:				

STAIRS AND RAILINGS

1 - STAINED HANDRAIL, TREADS, RISERS AND STRINGER EXCLUDING PICKETS (FOR IRON PICKETS) - STANDARD STAIRCASE - PRICE IS PER SET 19Jun18 Note: STAIN FOR STAIRCASE WITH IRON PICKETS	
1 - V GROOVE HANDRAIL 19Jun18 Note: STAIRCASE - LARGER POST AND HANDRAIL	
1 - EUROLINE 1 19Jun18 Note: STAIRCASE - IRON PICKETS -BLACK	

EXTRAS AS PER OFFER

The Vendor agrees that notwithstanding any other term or provision in this Agreement included in the Purchase Price and in addition to those items detailed in Schedule GP to the Agreement of Purchase and Sale, the Purchaser is entitled to a credit of Ten Worksheet Note:	
The Purchaser acknowledges that the Purchase Price is inclusive of all credits and promotional packages available at the time of purchase. Worksheet Note:	

This Document is Extremely Time Sensitive - Printed 19 Jun 18 at 11:22



Purchasers:

JOHN K O'SHAUGHNESSY & VIRGINIA LAYOCH

Telephone Res. / Bus:

(289) 681-0085 /

Decor Advisor:

Candace Forza

Lock Date:

19-Jun-18

Property:

103

Project:

Russell Gardens Building Ltd.

Model and Elevation:

Rosewood 1A Elev 1

Plan #:

62M-1238

Layout Changes:

☐ Yes ☒ No

Sketch Attached:

☒ Yes ☐ No

Exterior Colour Scheme:

1. Cabinetry

	Style and Colour	Hardware
Kitchen / Breakfast	EVEREST WHITE	1001
Laundry Room	ELISSE	Standard
Powder Room	HASTING CHOCOLATE	2002
Master Ensuite Bathroom	MONACO W350XZ4	2002
Ensuite Bath - Bedroom 2	HASTING CHOCOLATE	2002
Ensuite Bath - Bedroom 3/4	EVEREST WHITE	2002
	N/A	N/A
	N/A	N/A
	N/A	N/A

Appliances:

Built In Appliances

☐ Yes ☒ No

Slide In Stove

☐ Yes ☒ No

Dishwasher Cabinet

☐ Closed ☒ Open

41" Upper Cabinets

☒ Yes ☐ No

Please NOTE:

Standard Cabinet Height is 30"

Stove Opening

NOTE: If not specified, opening will be set to builder's standard opening of approximately 30" width

Fridge Opening

NOTE: If not specified, opening will be set to builder's standard opening of approximately 37" width x 74" height

\*\* Refer to Construction Summary

2. Counters

	Counter	Edge
Kitchen / Breakfast	LAMINATE-CALCUTTA MARBLE 4925K-07	
Laundry Room	N/A	
Powder Room	LAMINATE-WHITE CARRARA 4924-38	
Master Ensuite Bathroom	LAMINATE-CALCUTTA MARBLE 4925K-07	
Ensuite Bath - Bedroom 2	LAMINATE-WHITE CARRARA 4924-38	
Ensuite Bath - Bedroom 3/4	LAMINATE-CARRARA BIANCO 6696-46	
	N/A	
	N/A	
	N/A	

\*\* Refer to Construction Summary

Purchasers:JOHN K O'SHAUGHNESSY & VIRGINIA LAYO

Telephone Res. / Bus: (289) 681-0085 /

Decor Advisor: Candace Forza

Lock Date: 19-Jun-18

Property: 103

Project: Russell Gardens Building Ltd.

Model and Elevation: Rosewood 1A Elev 1

Plan #: 62M-1238

3. Ceramic Flooring

Entrance Vestibule	TILE-S.N. PASTELLO BIANCO-13X13	At a 45 Threshold-If App.
Main Hall	STRIP	<input type="checkbox"/> METAL STRIP
Kitchen / Breakfast	TILE-S.N. PASTELLO BIANCO-13X13	<input type="checkbox"/>
Laundry Room	TILE-S.N. PASTELLO BIANCO-13X13	<input type="checkbox"/> METAL STRIP
Powder Room	TILE-S.N. PASTELLO BIANCO-13X13	<input type="checkbox"/>
Master Ensuite Bathroom	TILE-S.N. PASTELLO BIANCO-13X13	<input type="checkbox"/> METAL STRIP
Ensuite Bath - Bedroom 2	TILE-BEACH IVORY-13X13	<input type="checkbox"/> METAL STRIP
Ensuite Bath - Bedroom 3/4	TILE-RAINBOW WHITE-13X13	<input type="checkbox"/> METAL STRIP
LOWER LANDING	TILE-S.N. PASTELLO BIANCO-13X13	<input type="checkbox"/>
	N/A	<input type="checkbox"/>
	N/A	<input type="checkbox"/>

\*\* Refer to Construction Summary

4. Ceramic Wall Tile

Master Ensuite Bathroom	Selection	Describe
Tub Deck Wall	N/A	
Tub Deck	N/A	
Tub Deck Skirt	N/A	
Shower Stall	TILE-LUC CONCEPT FERRO-8X16	
Bathtub Enclosure Walls	N/A	
Ensuite Bath - Bedroom 2	TILE-6516 BIANCO MATTE-8X16	
Ensuite Bath - Bedroom 3/4	TILE-LUC CONCEPT NEVE-8X16	
	N/A	
	N/A	
	N/A	
Kitchen Backsplash	N/A	

\*\* Refer to Construction Summary - STANDARD GROUT THROUGHOUT UNLESS SPECIFIED

5. Plumbing Fixtures

All Bathrooms

White

N/A

N/A

Whirlpool

N/A

☐ Yes

☒ No

Dishwasher Rough-In

☒ Yes

☐ No

Waterline for Fridge

☐ Yes

☒ No

\*\* Refer to Construction Summary

6. Trim Carpentry

Interior Doors	CLERMONT
Interior Trim	3" BB CASING WITH 5 1/4" BASEBOARD - COLONIAL
Door Handles	As Per Construction Specifications
Exterior Front Door Handle	As Per Construction Specifications

\*\* Refer to Construction Summary

Initials: DL VDL



Purchasers:

JOHN K O'SHAUGHNESSY & VIRGINIA LAYOCH

Telephone Res. / Bus:

(289) 681-0085 /

Decor Advisor:

Candace Forza

Lock Date:

19-Jun-18

Property:

103

Project:

Russell Gardens Building Ltd.

Model and Elevation:

Rosewood 1A Elev 1

Plan #:

62M-1238

7. Outer Flooring

Main Hall	STRIP-MIRAGE-ADMIRATION-RED OAK-SEMI-GLOSS-CHARCOAL-4 7/16"
Living Room	STRIP-MIRAGE-ADMIRATION-RED OAK-SEMI-GLOSS-CHARCOAL-4 7/16"
Dining Room	STRIP-MIRAGE-ADMIRATION-RED OAK-SEMI-GLOSS-CHARCOAL-4 7/16"
Family Room	STRIP-MIRAGE-ADMIRATION-RED OAK-SEMI-GLOSS-CHARCOAL-4 7/16"
Den / Library / Study	N/A
Basement Landing(If Applies)	N/A
Lower Landing (If Applies)	TILE
Upper Landing	STRIP-MIRAGE-ADMIRATION-RED OAK-SEMI-GLOSS-CHARCOAL-4 7/16"
Upper Hall	LAMINATE-MANHATTAN - EARL GREY OAK TL-15012
Master Bedroom	LAMINATE-MANHATTAN - EARL GREY OAK TL-15012
Bedroom #2	LAMINATE-MANHATTAN - EARL GREY OAK TL-15012
Bedroom #3	LAMINATE-MANHATTAN - EARL GREY OAK TL-15012
Bedroom #4	LAMINATE-MANHATTAN - EARL GREY OAK TL-15012
Bedroom #5	N/A
	N/A
	N/A
	N/A
Underpad	TypeArea
	N/AN/A

\*\* Refer to Construction Summary

8. Railings and Pickets

Railing Type	V-GROOVE	Colour	MIRAGE CHARCOAL
Picket Type	EUROLINE 1	Colour	BLACK
Stringer / Riser	As Per Construction Specifications	Colour	MIRAGE CHARCOAL
Treads	As Per Construction Specifications	Colour	MIRAGE CHARCOAL
Red Oak Stairs with Semi Gloss Finish		<input checked="" type="radio"/> Yes <input type="radio"/> No	

\*\* Refer to Construction Summary

9. Wall Paint Flat Finish

Main & Upper Hall	43 BIRCH WHITE	Master Bedroom	48 CAMEO WHITE
Living Room	43 BIRCH WHITE	Bedroom #2	48 CAMEO WHITE
Dining Room	43 BIRCH WHITE	Bedroom #3	48 CAMEO WHITE
Kitchen / Breakfast	43 BIRCH WHITE	Bedroom #4	48 CAMEO WHITE
Family Room	43 BIRCH WHITE	Bedroom #5	N/A
Powder Room	43 BIRCH WHITE	Master Ensuite	43 BIRCH WHITE
Laundry Room	43 BIRCH WHITE	Ensuite Bath - Bedroom 2	48 CAMEO WHITE
Den/Library	N/A	Ensuite Bath - Bedroom 3/4	43 BIRCH WHITE
Trim Paint-Semi Gloss	BIRCH WHITE		N/A
	N/A		N/A
	N/A		N/A

Smooth Ceilings First Floor ☐ Yes ☒ No

\*\* Refer to Construction Summary

Initials:   *Jo*     *VDL*



Purchasers:JOHN K O'SHAUGHNESSY & VIRGINIA LAYO

Telephone Res. / Bus: (289) 681-0085 /

Decor Advisor: Candace Forza

Lock Date: 19-Jun-18

Property: 103

Project: Russell Gardens Building Ltd.

Model and Elevation: Rosewood 1A Elev 1

Plan #: 62M-1238

10. Plaster Mouldings and Medallions

Entrance Vestibule	N/A	N/A	Kitchen/Breakfast	N/A	N/A
Main Hall	N/A	N/A	Den/Library	N/A	N/A
Living Room	N/A	N/A	Lower Landing	N/A	N/A
Dining Room	N/A	N/A		N/A	N/A
Family Room	N/A	N/A		N/A	N/A

\*\* Refer to Construction Summary

11. Fireplace

	Living Room			Family Room			Other Room - Specify		
	Purchased	As Per Plan	N/A	Purchased	As Per Plan	N/A	Purchased	As Per Plan	N/A
Fireplace Type	<input type="radio"/>	<input type="radio"/>	<input checked="" type="radio"/>	<input type="radio"/>	<input checked="" type="radio"/>	<input type="radio"/>	<input type="radio"/>	<input type="radio"/>	<input checked="" type="radio"/>
Mantle Type	N/A			FLAT ON WALL			N/A		
Colour / Stain	N/A			MANTLE M2-STANDARD			N/A		
Surround	N/A			AS PER CONSTRUCTION SPECIFICATIONS			N/A		
Hearth	N/A			BIANCO			N/A		
				NO			N/A		

\*\* Refer to Construction Summary

12. Heating and Air Conditioning

Air Conditioning	NO	Gas Provisions Stove	NO
Gas Provisions Dryer	NO	Gas Provisions Barbecue	NO

Comment

\*\* Refer to Construction Summary

13. Electrical

Plugs and Switches	<input checked="" type="radio"/> White	DECOR	Above Kitchen Cabinet Light	<input type="radio"/> Yes	<input checked="" type="radio"/> No
Hood Fan	STANDARD WHITE		Below Kitchen Cabinet Light	<input type="radio"/> Yes	<input checked="" type="radio"/> No
Appliances	Built in Cooktop	Built in Oven	Gas Stove	Microwave	
	<input type="radio"/> Yes <input checked="" type="radio"/> No	<input type="radio"/> Yes <input checked="" type="radio"/> No	<input type="radio"/> Yes <input checked="" type="radio"/> No	<input type="radio"/> Yes <input checked="" type="radio"/> No	
Dishwasher Rough-in	Yes				

\*\* Refer to Construction Summary

14. General Comments

\*\* Refer to Construction Summary


Disclaimers and Notes

- 1) Colours of all materials are as close as possible to builder's selection, but not necessarily identical due to variances in manufacturing.
- 2) Any extras listed above are null and void unless accompanied by a separate invoice/amendment. Said invoice must be paid in full.
- 3) The Purchaser agrees that this colour selection is final and that no changes will be permitted, unless required by the Vendor.
- 4) The Purchaser acknowledges reading and accepting document which contains other miscellaneous disclaimers.

Signature:  Date: 6/19/18

Signature:  Date: 06-19-18





W W D T H	W H G H T	W C N T	FL H G H T	D W Y H	ST C E N T	2 X 4	V E N T	BOX COVER
STANDARD FEATURES:						JOB NUMBER:		
1040MM HIGH UPPERS (9' Ceiling-No D/C Box) DUMMY DOORS D/W SPACE LAMINATE KITCHEN & VANITY COUNTERTOPS						BUILDER: GREENPARK SITE NAME: RUSSEL GARDENS MODEL: ROSEWOOD 1AX ELEV 1,2,3 LOT #: DESIGNER: KS DATE: AUG 29 47		
<i>This drawing is the intellectual property of SELBA INDUSTRIES INC. and is an original design which must not be released or copied unless applicable fee has been paid or job order placed.</i>								



103 Russell Gardens  
Rosewood LA  
Elev 1

1. Add Plug Above  
Fireplace.

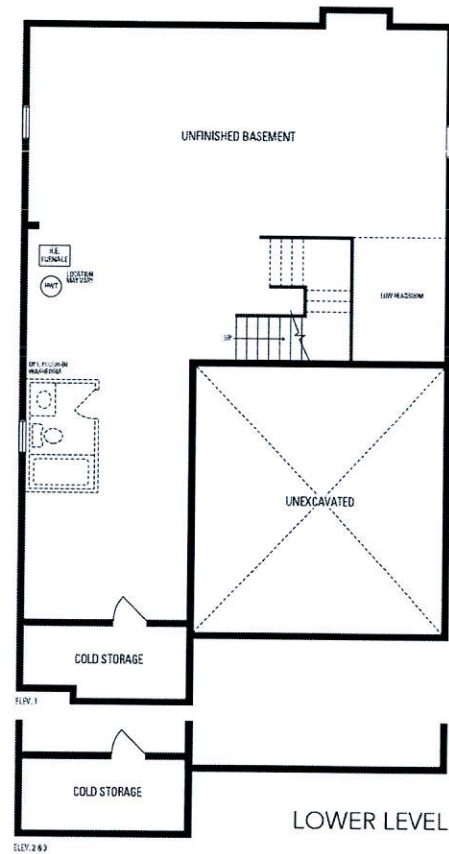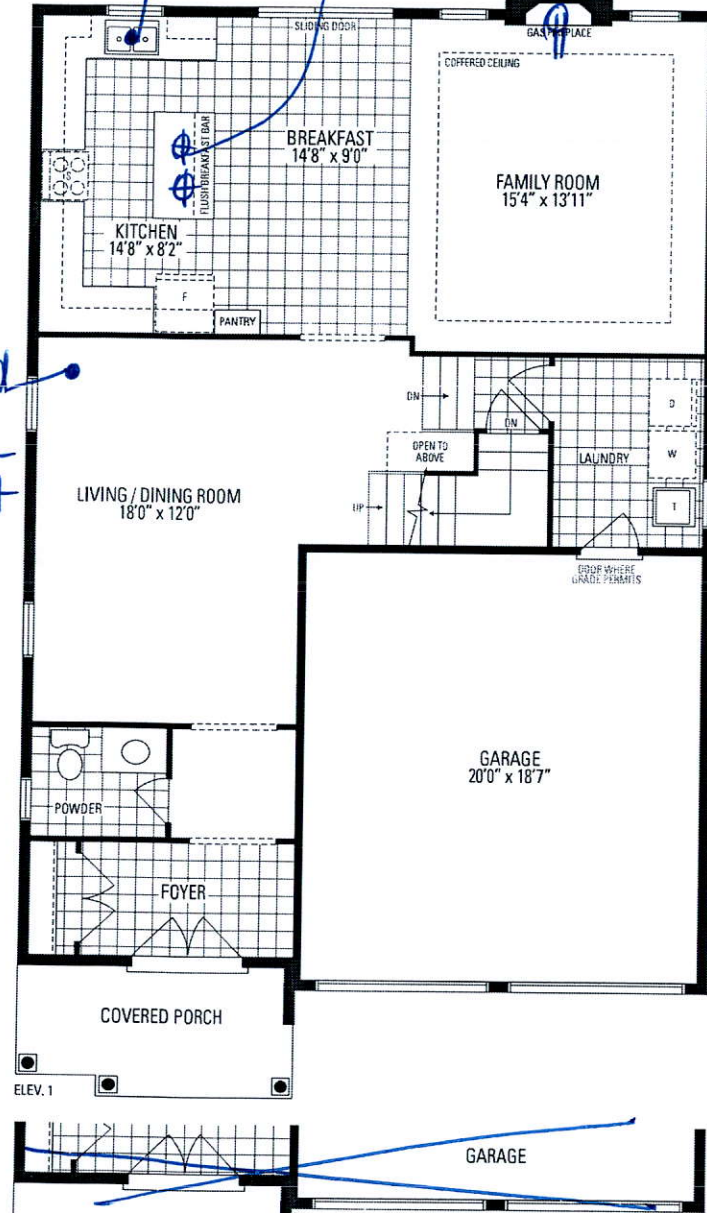

20

VDL

Add Light

