



CONSTRUCTION SUMMARY

Mountainview Heights (G) - Russell Gardens Building Ltd.

PURCHASERS: Qiong QI and Kai Qi WU

TEL:

| LOT / PHASE | REG. PLAN # | HOUSE TYPE        |  |  |
|-------------|-------------|-------------------|--|--|
| 178 / 2     | 62M-1238    | Rosewood 7 Elev 3 |  |  |

CABINETRY

|                                                                                |  |
|--------------------------------------------------------------------------------|--|
| 1 - CABINETRY - KITCHEN - LIGHT VALENCE<br>13Jun18 Note:                       |  |
| 1 - VANITY - ENSUITE BATHROOM - UPGRADE 3<br>13Jun18 Note:                     |  |
| 1 - VANITY - POWDER ROOM - UPGRADE 3<br>13Jun18 Note:                          |  |
| 1 - CABINETRY - KITCHEN - UPGRADE 3<br>13Jun18 Note:                           |  |
| 1 - CABINETRY - KITCHEN - HARDWARE UPGRADE 2<br>13Jun18 Note:                  |  |
| 1 - VANITY - BEDROOM 4 ENSUITE BATHROOM - UPGRADE 2 CABINETRY<br>13Jun18 Note: |  |
| 1 - VANITY - BEDROOM 3 ENSUITE BATHROOM - UPGRADE 2 CABINETRY<br>13Jun18 Note: |  |
| 1 - VANITY - BEDROOM 2 ENSUITE BATHROOM - UPGRADE 2 CABINETRY<br>13Jun18 Note: |  |

CABINETRY ACCESSORIES

|                                                                                                                                                        |  |
|--------------------------------------------------------------------------------------------------------------------------------------------------------|--|
| 1 - KITCHEN CABINETRY UPPER - FULL DEPTH ABOVE FRIDGE - WITH GABLES - 600MM - PRICE IS EACH - UPGRADE 3<br>13Jun18 Note:                               |  |
| 1 - KITCHEN CABINETRY UPPER - GLASS DOOR - CORD GLK340 - FINISHED INTERIOR - FITS TALL UPPER CABINETS - PRICE IS PER DOOR - UPGRADE 3<br>13Jun18 Note: |  |
| 1 - KITCHEN CABINETRY UPPER - ANGLED CORNER CABINET - FITS TALL UPPER CABINETS - PER UNIT - UPGRADE 3<br>13Jun18 Note:                                 |  |
| 1 - KITCHEN CABINETRY UPPER - MICROWAVE SHELF STANDARD - 700MM WIDE - UPGRADE 3<br>13Jun18 Note:                                                       |  |
| 1 - KITCHEN CABINETRY BASE - PIE CUT CORNER CABINET - BASE CABINETRY - UPGRADE 3<br>13Jun18 Note:                                                      |  |
| 1 - KITCHEN CABINETRY BASE - POT/PAN DRAWERS (CABINET) - UPGRADE 3<br>13Jun18 Note:                                                                    |  |
| 1 - KITCHEN - SLOW CLOSING CABINETRY<br>13Jun18 Note:                                                                                                  |  |
| 1 - KITCHEN - BLU MOTION DRAWERS<br>13Jun18 Note:                                                                                                      |  |
| 1 - KITCHEN CABINETRY BASE - SPICE WIRE PULLOUT - PRICE IS EACH<br>13Jun18 Note:                                                                       |  |

CERAMIC TILE

|                                                                                |  |
|--------------------------------------------------------------------------------|--|
| 1 - TILE - UPGRADE 5 WALL TILE - - ENSUITE WALL TILE - SHOWER<br>13Jun18 Note: |  |
| 1 - TILE - UPGRADE 5 FLOOR TILE - - ENSUITE BATHROOM - FLOOR<br>13Jun18 Note:  |  |

RECEIVED JUN 2 1 2018

CONSTRUCTION SUMMARY

Mountainview Heights (G) - Russell Gardens Building Ltd.

PURCHASERS: Qiong QI and Kai Qi WU

TEL:

| LOT / PHASE                                                                                                          | REG. PLAN # | HOUSE TYPE        |  |  |
|----------------------------------------------------------------------------------------------------------------------|-------------|-------------------|--|--|
| 178 / 2                                                                                                              | 62M-1238    | Rosewood 7 Elev 3 |  |  |
| 1 - TILE - UPGRADE 6 FLOOR TILE - - POWDER ROOM<br>13Jun18 Note:                                                     |             |                   |  |  |
| 1 - TILE - UPGRADE 6 FLOOR TILE - - KITCHEN<br>13Jun18 Note:                                                         |             |                   |  |  |
| 1 - TILE - UPGRADE 6 FLOOR TILE - - FOYER<br>13Jun18 Note:                                                           |             |                   |  |  |
| 1 - DELETE ALL CERAMIC BATHROOM ACCESSORIES - DELETE TOWEL BAR, PAPER HOLDER & SOAP DISH THROUGHOUT<br>13Jun18 Note: |             |                   |  |  |

CONSTRUCTION

|                                                          |  |
|----------------------------------------------------------|--|
| 1 - SMOOTH CEILINGS ON FIRST FLOOR ONLY<br>04Jun18 Note: |  |
|----------------------------------------------------------|--|

COUNTER TOP

|                                                            |  |
|------------------------------------------------------------|--|
| 1 - HARD SURFACE COUNTERTOP - ENSUITE<br>13Jun18 Note:     |  |
| 1 - HARD SURFACE COUNTERTOP - ENSUITE 4<br>13Jun18 Note:   |  |
| 1 - HARD SURFACE COUNTERTOP - ENSUITE 3<br>13Jun18 Note:   |  |
| 1 - HARD SURFACE COUNTERTOP - ENSUITE 2<br>13Jun18 Note:   |  |
| 1 - HARD SURFACE COUNTERTOP - POWDER ROOM<br>13Jun18 Note: |  |
| 1 - HARD SURFACE COUNTERTOP - KITCHEN<br>13Jun18 Note:     |  |

ELECTRICAL

|                                                                                 |  |
|---------------------------------------------------------------------------------|--|
| 1 - KITCHEN - VALANCE LIGHTING - FLORESCENT LIGHTING<br>13Jun18 Note:           |  |
| 1 - PLUG - ELECTRICAL PLUG - FOR MICROWAVE SHELF<br>13Jun18 Note:               |  |
| 1 - PLUG - ELECTRICAL PLUG - TO BE INSTALLED OVER FIREPLACE<br>04Jun18 Note:    |  |
| 1 - RELOCATE STANDARD KITCHEN LIGHT TO BE CENTERED OVER ISLAND<br>04Jun18 Note: |  |

FIREPLACE AND ACCESSORIES

|                                                                         |  |
|-------------------------------------------------------------------------|--|
| 1 - MANTEL - PAINTED - M6 - IN LIEU OF STANDARD MANTEL<br>13Jun18 Note: |  |
|-------------------------------------------------------------------------|--|

HARDWOOD FLOORING

|                                                                                                                          |  |
|--------------------------------------------------------------------------------------------------------------------------|--|
| 1 - HARDWOOD – GROUP C SERIES 7 INCH - IN LIEU OF 2 1/4 INCH NATURAL RED OAK - - MAIN HALL<br>13Jun18 Note:              |  |
| 1 - HARDWOOD – GROUP C SERIES 7 INCH - IN LIEU OF 2 1/4 INCH NATURAL RED OAK - - LIVING AND DINING ROOM<br>13Jun18 Note: |  |



CONSTRUCTION SUMMARY

Mountainview Heights (G) - Russell Gardens Building Ltd.

PURCHASERS: Qiong QI and Kai Qi WU

TEL:

| LOT / PHASE                                                                                                   | REG. PLAN # | HOUSE TYPE        |  |  |
|---------------------------------------------------------------------------------------------------------------|-------------|-------------------|--|--|
| 178 / 2                                                                                                       | 62M-1238    | Rosewood 7 Elev 3 |  |  |
| 1 - HARDWOOD – GROUP C SERIES 7 INCH - IN LIEU OF 2 1/4 INCH NATURAL RED OAK - - LIBRARY/DEN<br>13Jun18 Note: |             |                   |  |  |
| 1 - HARDWOOD – GROUP C SERIES 7 INCH - IN LIEU OF 2 1/4 INCH NATURAL RED OAK - - FAMILY ROOM<br>13Jun18 Note: |             |                   |  |  |
| 1 - LAMINATE -UPGRADE TO CLASSIC PLUS SERIES IN LIEU OF STANDARD LAMINATE<br>13Jun18 Note:                    |             |                   |  |  |

MIRRORS AND GLASS

|                                                                                                        |  |
|--------------------------------------------------------------------------------------------------------|--|
| 1 - FRAMELESS GLASS SHOWER DOOR FOR 5 FOOT PAN<br>04Jun18 Note: ENSUITE 3 BATHROOM                     |  |
| 1 - FRAMELESS GLASS SHOWER ENCLOSURE<br>04Jun18 Note: MASTER ENSUITE BATHROOM - CHROME KNOB AND HINGES |  |

MISCELLANEOUS

|                                                     |  |
|-----------------------------------------------------|--|
| 1 - FURTHER DISCOUNT AS PER VENDOR<br>13Jun18 Note: |  |
|-----------------------------------------------------|--|

PLUMBING

|                                                                                                                                                                          |  |
|--------------------------------------------------------------------------------------------------------------------------------------------------------------------------|--|
|                                                                                                                                                                          |  |
| 2 - VIEIRA 2 PC TOILET #4792BOV/4791BOVU (UNLINED TANK) WITH SMOOTH CLOSE TOILET SEAT<br>15Jun18 Note: POWDER ROOM & MASTER ENSUITE BATHROOMS                            |  |
| 3 - ENSUITE 2, 3 & 4 BATHROOMS - MOEN MAGNETIX HAND SHOWER - ENAGAGE ECO-PERFORMANCE 6 FUNCTION HAND SHOWER WITH MAGNETIX DOCKING - CHROME - #26100EP-C<br>13Jun18 Note: |  |
| 5 - MOEN BATHROOM ACCESSORIES - MASON CHROME - TOWEL BAR 24" #YB8094/YB8000 - PRICE IS EACH<br>13Jun18 Note: ALL BATHROOMS                                               |  |
| 5 - MOEN BATHROOM ACCESSORIES - MASON CHROME - PAPER HOLDER #YB8099/YB8000 - PRICE IS EACH<br>13Jun18 Note: ALL BATHROOMS                                                |  |
|                                                                                                                                                                          |  |
| 1 - SINK - UNDERMOUNT SINK - BLANCO QUATRUS R15 U2 #401519<br>13Jun18 Note: KITCHEN                                                                                      |  |
| 6 - SINK - UNDERMOUNT SINK - CONTRAC COLLETTE #4220CIY<br>13Jun18 Note: ALL BATHROOMS                                                                                    |  |
| 1 - WATER LINE FOR FRIDGE - ROUGH-IN ONLY<br>04Jun18 Note:                                                                                                               |  |
| 4 - 5 FOOT SHOWER WITH SLIDING GLASS CHROME DOORS IN LIEU OF TUB<br>19Apr18 Note: IN BEDROOM 2 ENSUITE                                                                   |  |
| 5 FT SHOWER WITH SLDING GLASS CHROME DOORS IN LIEU OF TUB IN BED 3 ENS.                                                                                                  |  |

PROMOTIONAL

|                                                                                                                                                                                                                                  |  |
|----------------------------------------------------------------------------------------------------------------------------------------------------------------------------------------------------------------------------------|--|
| 1 - LESS BALANCE OF CREDIT FROM PURCHASER EXTRA SHEET IN OFFER<br>04Jun18 Note:                                                                                                                                                  |  |
| 1 - PARTIAL REDEMPTION OF PROMOTIONAL PACKAGE \$\$\$\$\$\$ BALANCE FORWARD TO BE USED AT A LATER DATE. ORIGINAL PROMOTIONAL PACKAGE OF \$\$\$\$ AS PER SCHEDULE PE DATED MMMDDYYYY.<br>19Apr18 Note: NEW PROMO BALANCE \$8200.00 |  |

STAIRS AND RAILINGS

CONSTRUCTION SUMMARY

Mountainview Heights (G) - Russell Gardens Building Ltd.

PURCHASERS: Qiong QI and Kai Qi WU

TEL:

| LOT / PHASE                                                                                                 | REG. PLAN # | HOUSE TYPE        |  |  |
|-------------------------------------------------------------------------------------------------------------|-------------|-------------------|--|--|
| 178 / 2                                                                                                     | 62M-1238    | Rosewood 7 Elev 3 |  |  |
| 1 - STAINED HANDRAIL, TREADS, RISERS AND STRINGER EXCLUDING PICKETS (FOR IRON PICKETS) - STANDARD STAIRCASE |             |                   |  |  |
| - PRICE IS PER SET                                                                                          |             |                   |  |  |
| 13Jun18 Note:                                                                                               |             |                   |  |  |
| 1 - V GROOVE HANDRAIL                                                                                       |             |                   |  |  |
| 13Jun18 Note: STAIRCASE - LARGER POST AND HANDRAIL                                                          |             |                   |  |  |
| 1 - EUROLINE I                                                                                              |             |                   |  |  |
| 13Jun18 Note: STAIRCASE - IRON PICKETS - BLACK                                                              |             |                   |  |  |

EXTRAS AS PER OFFER

|                                                                                                                                                                                                                                                                |  |
|----------------------------------------------------------------------------------------------------------------------------------------------------------------------------------------------------------------------------------------------------------------|--|
| The Vendor agrees that notwithstanding any other term or provision in this Agreement included in the Purchase Price and in addition to those items detailed in Schedule GP to the Agreement of Purchase and Sale, the Purchaser is entitled to a credit of Ten |  |
| Worksheet Note:                                                                                                                                                                                                                                                |  |
| The Purchaser acknowledges that the Purchase Price is inclusive of all credits and promotional packages available at the time of purchase.                                                                                                                     |  |
| Worksheet Note:                                                                                                                                                                                                                                                |  |

This Document is Extremely Time Sensitive - Printed 15 Jun 18 at 11:44



Purchasers: Qiong Qi & Kai Qi WU  
Telephone Res. / Bus: /  
Decor Advisor: Candace Forza  
Lock Date: 13-Jun-18

Property: 178  
Project: Russell Gardens Building Ltd.  
Model and Elevation: Rosewood 7 Elev 3  
Plan #: 62M-1238

Layout Changes: ☐ Yes ☒ No      Sketch Attached: ☒ Yes ☐ No      Exterior Colour Scheme:

1. Cabinetry

|                          | Style and Colour | Hardware  |
|--------------------------|------------------|-----------|
| Kitchen / Breakfast      | LEGACY L614XZ4   | See Below |
| Laundry Room             | ELISSE           | Standard  |
| Powder Room              | LEGACY L689XZ4   | 1001      |
| Master Ensuite Bathroom  | LEGACY L614XZ4   | 1001      |
| Ensuite Bath - Bedroom 2 | HAMPTON W823XZ4  | 1001      |
| Ensuite Bath - Bedroom 3 | HAMPTON W823XZ4  | 1001      |
| Ensuite Bath - Bedroom 4 | HAMPTON W823XZ4  | 1001      |
|                          | N/A              | N/A       |
|                          | N/A              | N/A       |

Appliances:      Built In Appliances ☐ Yes ☒ No      Slide In Stove ☐ Yes ☒ No  
Dishwasher Cabinet ☐ Closed ☒ Open      41" Upper Cabinets ☒ Yes ☐ No      Please NOTE: Standard Cabinet Height is 30"  
Stove Opening       NOTE: If not specified, opening will be set to builder's standard opening of approximately 30" width  
Fridge Opening       NOTE: If not specified, opening will be set to builder's standard opening of approximately 37" width x 74" height

KITCHEN - HARDWARE - CABINETRY - 722SC \*\*\* DRAWERS - 167SB  
\*\* Refer to Construction Summary

2. Counters

|                          | Counter                | Edge              |
|--------------------------|------------------------|-------------------|
| Kitchen / Breakfast      | QUARTZ-MOUNTAIN GREY   | #320 PENCIL ROUND |
| Laundry Room             | N/A                    | N/A               |
| Powder Room              | MARBLE-BIANCO ASSOLUTO | #320 PENCIL ROUND |
| Master Ensuite Bathroom  | MARBLE-BIANCO ASSOLUTO | #320 PENCIL ROUND |
| Ensuite Bath - Bedroom 2 | MARBLE-BIANCO ASSOLUTO | #320 PENCIL ROUND |
| Ensuite Bath - Bedroom 3 | MARBLE-BIANCO ASSOLUTO | #320 PENCIL ROUND |
| Ensuite Bath - Bedroom 4 | MARBLE-BIANCO ASSOLUTO | #320 PENCIL ROUND |
|                          | N/A                    | N/A               |
|                          | N/A                    | N/A               |

\*\* Refer to Construction Summary



Purchasers: Qiong QI & Kai Qi WU  
Telephone Res. / Bus: /  
Decor Advisor: Candace Forza  
Lock Date: 13-Jun-18

Property: 178  
Project: Russell Gardens Building Ltd.  
Model and Elevation: Rosewood 7 Elev 3  
Plan #: 62M-1238

3. Ceramic Flooring

|                          |                               | At a 45                  | Threshold-If App. |
|--------------------------|-------------------------------|--------------------------|-------------------|
| Entrance Vestibule       | TILE-SMOT WHITE LAPP-24X24    | <input type="checkbox"/> | METAL STRIP       |
| Main Hall                | STRIP                         | <input type="checkbox"/> |                   |
| Kitchen / Breakfast      | TILE-SMOT WHITE LAPP-24X24    | <input type="checkbox"/> | METAL STRIP       |
| Laundry Room             | TILE-RAINBOW LIGHT GREY-13X13 | <input type="checkbox"/> |                   |
| Powder Room              | TILE-SMOT WHITE LAPP-24X24    | <input type="checkbox"/> | METAL STRIP       |
| Master Ensuite Bathroom  | TILE-GOTHA DIAMOND LUX-24X24  | <input type="checkbox"/> | METAL STRIP       |
| Ensuite Bath - Bedroom 2 | TILE-RAINBOW WHITE-13X13      | <input type="checkbox"/> | METAL STRIP       |
| Ensuite Bath - Bedroom 3 | TILE-RAINBOW WHITE-13X13      | <input type="checkbox"/> | METAL STRIP       |
| Ensuite Bath - Bedroom 4 | TILE-RAINBOW WHITE-13X13      | <input type="checkbox"/> | METAL STRIP       |
|                          | N/A                           | <input type="checkbox"/> |                   |
|                          | N/A                           | <input type="checkbox"/> |                   |

\*\* Refer to Construction Summary

4. Ceramic Wall Tile

| Master Ensuite Bathroom  | Selection                    | Describe |
|--------------------------|------------------------------|----------|
| Tub Deck Wall            | N/A                          |          |
| Tub Deck                 | N/A                          |          |
| Tub Deck Skirt           | N/A                          |          |
| Shower Stall             | TILE-GOTHA DIAMOND LUX-12X24 |          |
| Bathtub Enclosure Walls  | N/A                          |          |
| Ensuite Bath - Bedroom 2 | TILE-LUC CONCEPT NEVE-8X16   |          |
| Ensuite Bath - Bedroom 3 | TILE-LUC CONCEPT NEVE-8X16   |          |
| Ensuite Bath - Bedroom 4 | TILE-LUC CONCEPT NEVE-8X16   |          |
|                          | N/A                          |          |
|                          | N/A                          |          |
| Kitchen Backsplash       | N/A                          |          |

\*\* Refer to Construction Summary - STANDARD GROUT THROUGHOUT UNLESS SPECIFIED

5. Plumbing Fixtures

|               |       |                                                                                    |
|---------------|-------|------------------------------------------------------------------------------------|
| All Bathrooms | White | Whirlpool                                                                          |
|               | N/A   | N/A <input type="radio"/> Yes <input checked="" type="radio"/> No                  |
|               | N/A   |                                                                                    |
|               | N/A   |                                                                                    |
|               | N/A   | Dishwasher Rough-In <input checked="" type="radio"/> Yes <input type="radio"/> No  |
|               | N/A   | Waterline for Fridge <input checked="" type="radio"/> Yes <input type="radio"/> No |
|               | N/A   |                                                                                    |

\*\* Refer to Construction Summary

6. Trim Carpentry

|                            |                                               |
|----------------------------|-----------------------------------------------|
| Interior Doors             | CLERMONT                                      |
| Interior Trim              | 3" BB CASING WITH 5 1/4" BASEBOARD - COLONIAL |
| Door Handles               | As Per Construction Specifications            |
| Exterior Front Door Handle | As Per Construction Specifications            |

\*\* Refer to Construction Summary

Initials:



Purchasers: Qiong QI & Kai Qi WU

Property: 178

Telephone Res. / Bus: /

Project: Russell Gardens Building Ltd.

Decor Advisor: Candace Forza

Model and Elevation: Rosewood 7 Elev 3

Lock Date: 13-Jun-18

13-Jun-18

Plan #: 62M-1238

7. Other Flooring

|                              |                                                                          |
|------------------------------|--------------------------------------------------------------------------|
| Main Hall                    | STRIP-VINTAGE-SOLID SAWN-HANDSCRAPED-CHARACTER-PEARL-HICKORY-MESQUITE-7" |
| Living Room                  | STRIP-VINTAGE-SOLID SAWN-HANDSCRAPED-CHARACTER-PEARL-HICKORY-MESQUITE-7" |
| Dining Room                  | STRIP-VINTAGE-SOLID SAWN-HANDSCRAPED-CHARACTER-PEARL-HICKORY-MESQUITE-7" |
| Family Room                  | STRIP-VINTAGE-SOLID SAWN-HANDSCRAPED-CHARACTER-PEARL-HICKORY-MESQUITE-7" |
| Den / Library / Study        | STRIP-VINTAGE-SOLID SAWN-HANDSCRAPED-CHARACTER-PEARL-HICKORY-MESQUITE-7" |
| Basement Landing(If Applies) | N/A                                                                      |
| Lower Landing (If Applies)   | STRIP-VINTAGE-SOLID SAWN-HANDSCRAPED-CHARACTER-PEARL-HICKORY-MESQUITE-7" |
| Upper Landing                | STRIP-VINTAGE-SOLID SAWN-HANDSCRAPED-CHARACTER-PEARL-HICKORY-MESQUITE-7" |
| Upper Hall                   | LAMINATE-CLASSIC PLUS - OLD OAK DARK QS-UM1383                           |
| Master Bedroom               | LAMINATE-CLASSIC PLUS - OLD OAK DARK QS-UM1383                           |
| Bedroom #2                   | LAMINATE-CLASSIC PLUS - OLD OAK DARK QS-UM1383                           |
| Bedroom #3                   | LAMINATE-CLASSIC PLUS - OLD OAK DARK QS-UM1383                           |
| Bedroom #4                   | LAMINATE-CLASSIC PLUS - OLD OAK DARK QS-UM1383                           |
| Bedroom #5                   | N/A                                                                      |
|                              | N/A                                                                      |
|                              | N/A                                                                      |
|                              | N/A                                                                      |
| Underpad                     | TypeArea                                                                 |
|                              | N/A                                                                      |

\*\* Refer to Construction Summary

8. Railings and Pickets

|                                       |                                    |                                                               |                  |
|---------------------------------------|------------------------------------|---------------------------------------------------------------|------------------|
| Railing Type                          | V-GROOVE                           | Colour                                                        | VINTAGE MESQUITE |
| Picket Type                           | EUROLINE 1                         | Colour                                                        | BLACK            |
| Stringer / Riser                      | As Per Construction Specifications | Colour                                                        | VINTAGE MESQUITE |
| Treads                                | As Per Construction Specifications | Colour                                                        | VINTAGE MESQUITE |
| Red Oak Stairs with Semi Gloss Finish |                                    | <input checked="" type="radio"/> Yes <input type="radio"/> No |                  |

\*\* Refer to Construction Summary

9. Wall Paint Flat Finish

|                       |              |                          |              |
|-----------------------|--------------|--------------------------|--------------|
| Main & Upper Hall     | 22 WARM GREY | Master Bedroom           | 22 WARM GREY |
| Living Room           | 22 WARM GREY | Bedroom #2               | 22 WARM GREY |
| Dining Room           | 22 WARM GREY | Bedroom #3               | 22 WARM GREY |
| Kitchen / Breakfast   | 22 WARM GREY | Bedroom #4               | 22 WARM GREY |
| Family Room           | 22 WARM GREY | Bedroom #5               | N/A          |
| Powder Room           | 22 WARM GREY | Master Ensuite           | 22 WARM GREY |
| Laundry Room          | 22 WARM GREY | Ensuite Bath - Bedroom 2 | 22 WARM GREY |
| Den/Library           | 22 WARM GREY | Ensuite Bath - Bedroom 3 | 22 WARM GREY |
| Trim Paint-Semi Gloss | BIRCH WHITE  | Ensuite Bath - Bedroom 4 | 22 WARM GREY |
|                       | N/A          |                          | N/A          |
|                       | N/A          |                          | N/A          |

Smooth Ceilings First Floor ☒ Yes ☐ No

\*\* Refer to Construction Summary

Initials:

QI WU



Purchasers: Qiong QI &amp; Kai Qi WU

Property: 178

Telephone Res. / Bus: /

Project: Russell Gardens Building Ltd.

Decor Advisor: Candace Forza

Model and Elevation: Rosewood 7 Elev 3

Lock Date: 13-Jun-18

13-Jun-18

Plan #: 62M-1238

## 10. Plaster Mouldings and Medallions

|                    |     |     |                   |     |     |
|--------------------|-----|-----|-------------------|-----|-----|
| Entrance Vestibule | N/A | N/A | Kitchen/Breakfast | N/A | N/A |
| Main Hall          | N/A | N/A | Den/Library       | N/A | N/A |
| Living Room        | N/A | N/A | Lower Landing     | N/A | N/A |
| Dining Room        | N/A | N/A |                   | N/A | N/A |
| Family Room        | N/A | N/A |                   | N/A | N/A |

\*\* Refer to Construction Summary

## 11. Fireplace

|                | Living Room           |                       |                                  | Family Room                        |                                  |                       | Other Room - Specify  |                       |                                  |
|----------------|-----------------------|-----------------------|----------------------------------|------------------------------------|----------------------------------|-----------------------|-----------------------|-----------------------|----------------------------------|
|                | Purchased             | As Per Plan           | N/A                              | Purchased                          | As Per Plan                      | N/A                   | Purchased             | As Per Plan           | N/A                              |
|                | <input type="radio"/> | <input type="radio"/> | <input checked="" type="radio"/> | <input type="radio"/>              | <input checked="" type="radio"/> | <input type="radio"/> | <input type="radio"/> | <input type="radio"/> | <input checked="" type="radio"/> |
| Fireplace Type | N/A                   |                       |                                  | FLAT ON WALL                       |                                  |                       | N/A                   |                       |                                  |
| Mantle Type    | N/A                   |                       |                                  | MANTLE M6                          |                                  |                       | N/A                   |                       |                                  |
| Colour / Stain | N/A                   |                       |                                  | AS PER CONSTRUCTION SPECIFICATIONS |                                  |                       | N/A                   |                       |                                  |
| Surround       | N/A                   |                       |                                  | GRIGIO CARNICO                     |                                  |                       | N/A                   |                       |                                  |
| Hearth         | N/A                   |                       |                                  | NO                                 |                                  |                       | N/A                   |                       |                                  |

\*\* Refer to Construction Summary

## 12. Heating and Air Conditioning

Air Conditioning

Gas Provisions Dryer

Gas Provisions Stove

Gas Provisions Barbecue

Comment

\*\* Refer to Construction Summary

## 13. Electrical

Plugs and Switches ☒ White

Hood Fan

Appliances ☐ Built in Cooktop ☐ Built in Oven ☐ Gas Stove ☐ Microwave

☐ Yes ☒ No ☐ Yes ☒ No ☐ Yes ☒ No ☐ Yes ☐ No

Dishwasher Rough-in

\*\* Refer to Construction Summary

## 14. General Comments

\*\* Refer to Construction Summary

## Disclaimers and Notes

- Colours of all materials are as close as possible to builder's selection, but not necessarily identical due to variances in manufacturing.
- Any extras listed above are null and void unless accompanied by a separate invoice/amendment. Said invoice must be paid in full.
- The Purchaser agrees that this colour selection is final and that no changes will be permitted, unless required by the Vendor.
- The Purchaser acknowledges reading and accepting document which contains other miscellaneous disclaimers.

Signature: Date: June 13/18Signature: Date: Jun 13<sup>th</sup>, 2018



178 Russell  
Gardens.

Ensuite 2, 3 & 4

**NEW!** **Magnetix™ Hand Showers**  
Traditional | Transitional | Modern



**Engage™ Eco-Performance  
6 Function Hand Shower  
with Magnetix™ Docking**

Model 26100EP

chrome

**FINISH OPTIONS:**




To order, combine the model number with one of these finish letter(s):  
**Spot Resist Brushed Nickel (SRN).**  
To order Chrome (C) model, use model number only.








**enpark**  
GROUP

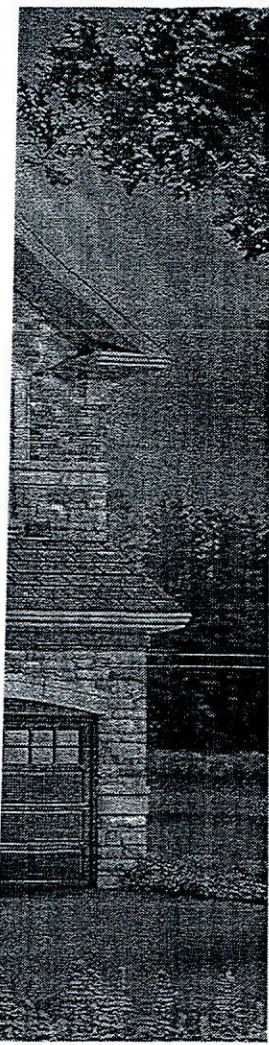


Add Plug  
Above Fireplace

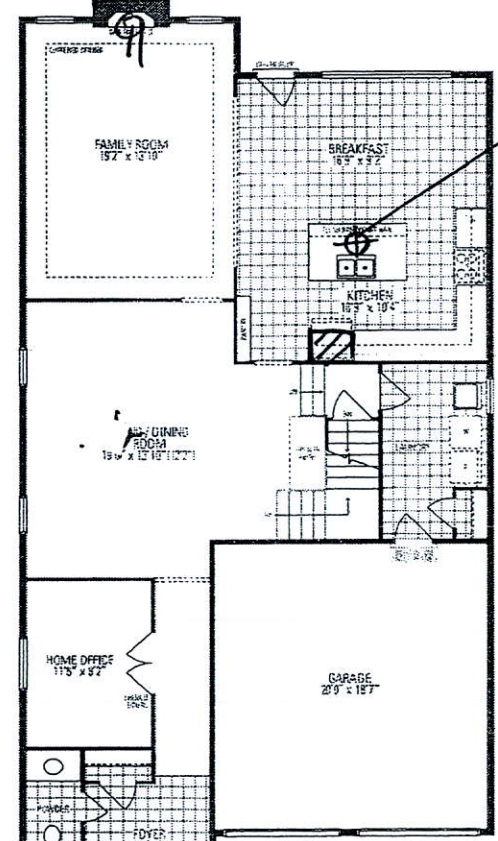

Relocate  
Std. Light  
Above  
Island


MAIN LEVEL

- Smooth Ceilings

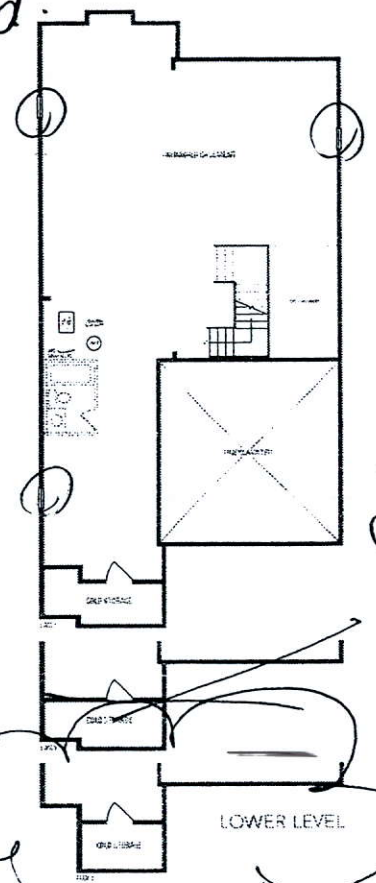


LOWER LEVEL

frameless  
Glass  
Enclosure  
- Delete  
Wall -

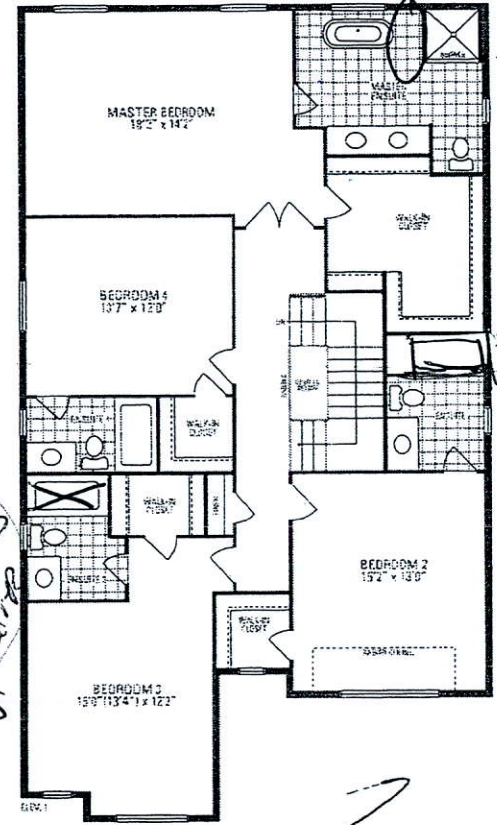

Tub ★

★  
Tub  
to  
Shower  
Frameless  
Glass

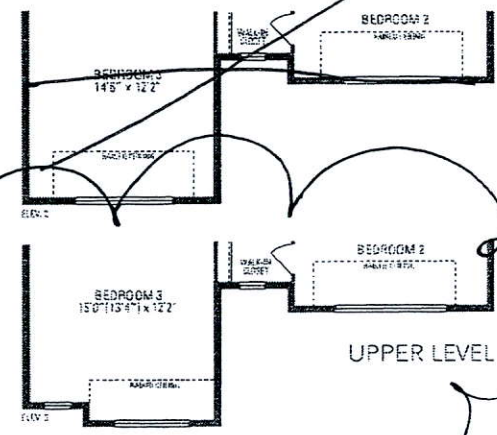

UPPER LEVEL

**ROSEWOOD 7**

3,205 sq.ft. includes 12 sq.ft. of open area

W/K  
000

Orientation of home may be reversed and purchaser agrees to accept the same. Steps and gardens may vary at exterior entrance ways due to grading variances. Actual usable floor space may vary from the stated floor area. All renderings are artist's concept. Dimensions, specifications and architectural detailing subject to minor modifications. Final location of pump is based on site conditions. Roofline and shipping model types may vary due to siding, E & D.E. L.P.U. Rosewood 7 - Copyright Sept. 2017