

CONSTRUCTION SUMMARY

Mountainview Heights (G) - Russell Gardens Building Ltd.

PURCHASERS: AHMED MOHAMED HAFEZ IBRAHIM and RIHAM MOHAMED M HAGGAG

TEL: RES.: 647-295-9774

LOT / PHASE 164 / 2	REG. PLAN # 62M-1238	HOUSE TYPE Rosewood 7 Elev 2		
------------------------	-------------------------	---------------------------------	--	--

PLUMBING

2 - 5 FOOT SHOWER WITH SLIDING GLASS CHROME DOORS IN LIEU OF TUB- IN ENSUITE 3 AND ENSUITE 4 25Jun18 Note:	
---	--

PROMOTIONAL

1 - PARTIAL REDEMPTION OF PROMOTIONAL PACKAGE \$10,000 BALANCE FORWARD \$6,400 TO BE USED AT A LATER DATE. ORIGINAL PROMOTIONAL PACKAGE OF \$10,000 AS PER SCHEDULE PE 25Jun18 Note:	
--	--




EXTRAS AS PER OFFER

The Purchaser acknowledges that the Purchase Price is inclusive of all credits and promotional packages available at the time of purchase. Worksheet Note:	
The Vendor agrees that notwithstanding any other term or provision in this Agreement included in the Purchase Price and in addition to those items detailed in Schedule GP to the Agreement of Purchase and Sale, the Purchaser is entitled to a credit of Ten Worksheet Note:	

This Document is Extremely Time Sensitive - Printed 25 Jun 18 at 11:02

plumbing & Construction

RECEIVED JUN 25 2018

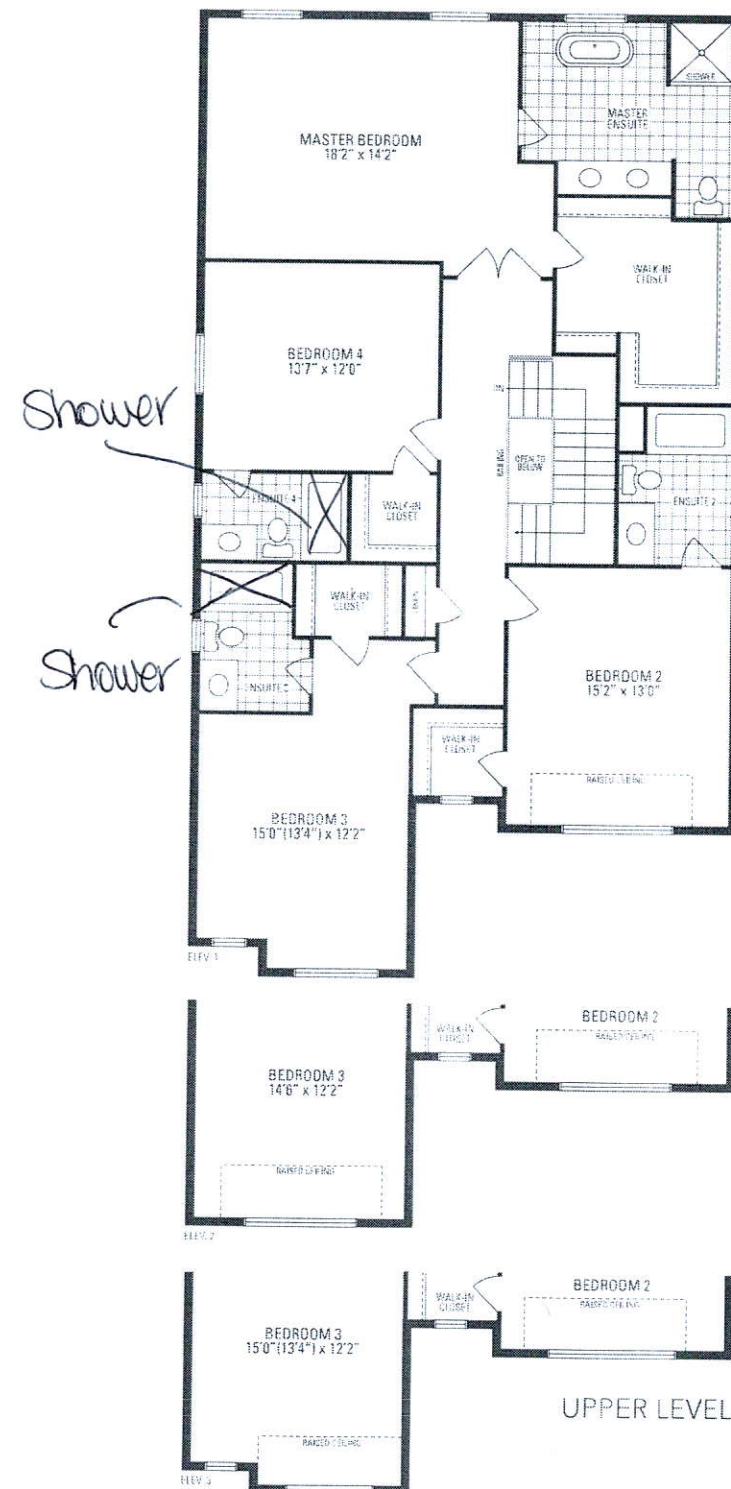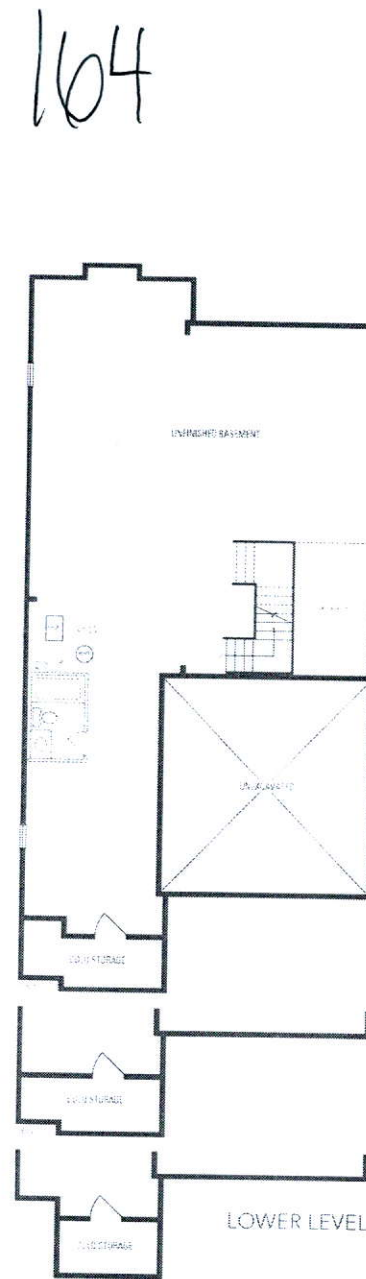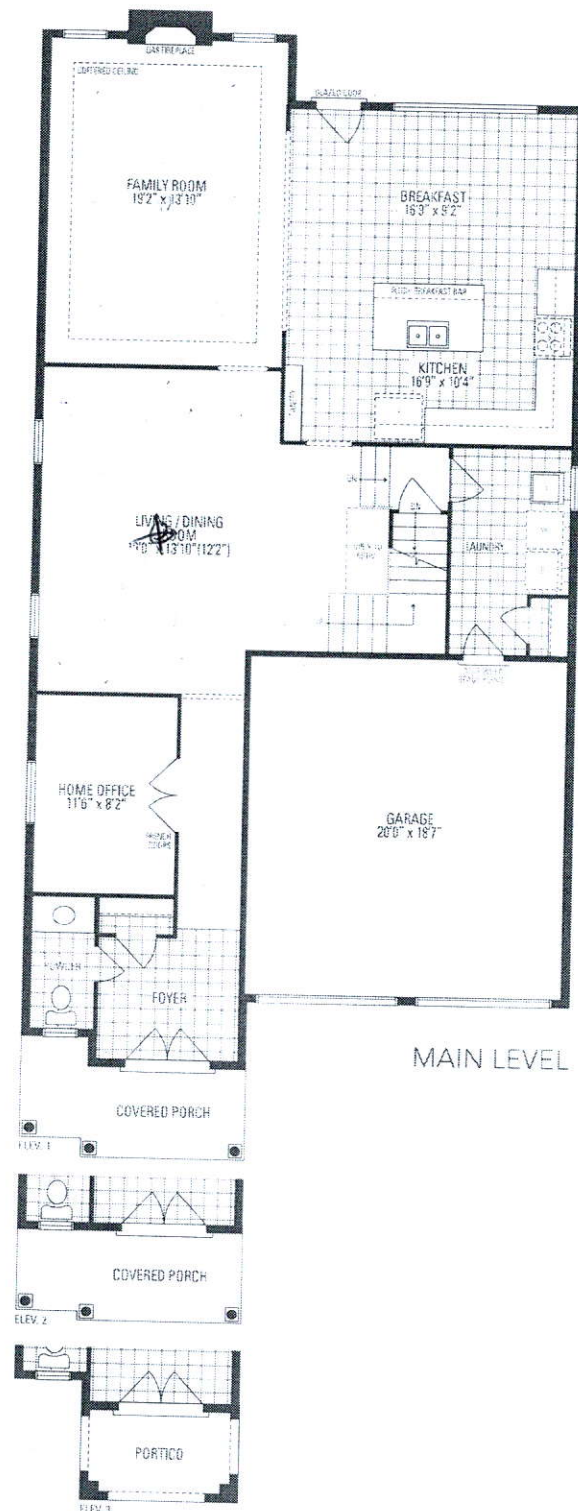

ROSEWOOD 7
3,205 sq.ft. includes 12 sq.ft. of open area