



CONSTRUCTION SUMMARY

Sharon Village 2 - Secondo Vales Estates Inc.

PURCHASER: KAYHAN ISIK

TEL:

LOT / PHASE	REG. PLAN #	HOUSE TYPE		
33 / 2	65M-4626	Newberry 6A Elev 2		

CERAMIC TILE

1 - DELETE ALL CERAMIC BATHROOM ACCESSORIES - DELETE TOWEL BAR, PAPER HOLDER & SOAP DISH THROUGHOUT 16Nov18 Note:	
--	--

CONSTRUCTION

1 - SMOOTH CEILINGS ON FIRST FLOOR ONLY 16Nov18 Note:	
--	--

ELECTRICAL

5 - POT LIGHT - EXTERIOR - SOFFIT MOUNT - REGULAR VOLTAGE 16Nov18 Note:	
1 - PLUG - ELECTRICAL PLUG - TO BE INSTALLED OVER FIREPLACE 16Nov18 Note:	
1 - ABOVE KITCHEN ISLAND - ADD LIGHT AND SWITCH - NO FIXTURE INCLUDED 16Nov18 Note:	
1 - STANDARD DINING ROOM LIGHT TO BE CENTERED BETWEEN LIVING AND DINING ROOM 16Nov18 Note:	
6 - POT LIGHT - LED - FIRST FLOOR INSTALLATION 16Nov18 Note: LIVING/DINING ROOM - WIRED TO SEPERATE SWICTH - SEE SKETCH	
4 - POT LIGHT - LED - FIRST FLOOR INSTALLATION 16Nov18 Note: FAMILY ROOM - WIRED TO SEPERATE SWICTH - SEE SKETCH	

FIREPLACE AND ACCESSORIES

1 - MANTEL - PAINTED - M 3 - IN LIEU OF STANDARD MANTEL 16Nov18 Note:	
--	--

HARDWOOD FLOORING

1 - HARDWOOD - STAINED PROMO SERIES - 4 7/16" - FIRST FLOOR (STANDARD NON-TILED AREAS) 16Nov18 Note:	
---	--

PLUMBING

1 - WATER LINE FOR FRIDGE - ROUGH-IN ONLY 16Nov18 Note:	
5 - MOEN BATHROOM ACCESSORIES - MASON CHROME - TOWEL BAR 24" #YB8094/YB8000 - PRICE IS EACH 16Nov18 Note: ALL BATHROOMS	
5 - MOEN BATHROOM ACCESSORIES - MASON CHROME - PAPER HOLDER #YB8099/YB8000 - PRICE IS EACH 16Nov18 Note: ALL BATHROOMS	
3 - TOE TESTER - ADD TOE TESTER TO SHOWER 16Nov18 Note: MASTER ENSUITE, ENSUITE 2 & 4 BATHROOMS	

PROMOTIONAL

1 - LESS CREDIT FROM PURCHASER EXTRA SHEET IN OFFER 16Nov18 Note:	
--	--

STAIRS AND RAILINGS

1 - STAINED STAIRS, RAILING AND PICKETS - STANDARD STAIRCASE - PRICE IS PER SET 16Nov18 Note:	
--	--

RECEIVED NOV 21 2018

CONSTRUCTION SUMMARY

Sharon Village 2 - Secondo Vales Estates Inc.

PURCHASER: KAYHAN ISIK

TEL:

LOT / PHASE 33 / 2	REG. PLAN # 65M-4626	HOUSE TYPE Newberry 6A Elev 2		
-----------------------	-------------------------	----------------------------------	--	--

This Document is Extremely Time Sensitive - Printed 16 Nov 18 at 11:44

Purchaser: KAYHAN ISIK

Property: 33

Telephone Res. / Bus: /

Project: Secondo Vales Estates Inc.

Decor Advisor: Candace Forza

Model and Elevation: Newberry 6A Elev 2

Lock Date: 16-Nov-18

16-Nov-18

Plan #: 65M-4626

Layout Changes: ☐ Yes ☒ No

Sketch Attached: ☒ Yes ☐ No

Exterior Colour Scheme:

1. Cabinetry

	Style and Colour	Hardware
Kitchen / Breakfast	CONTINENTAL W814XZ4	2002
Laundry Room	ELISSE	Standard
Powder Room	CONTINENTAL W814XZ4	2002
Master Ensuite Bathroom	EVEREST WHITE	2002
Ensuite Bath - Bedroom 2	CONTINENTAL W814XZ4	2002
Ensuite Bath - Bedroom 3	CONTINENTAL W814XZ4	2002
Ensuite Bath - Bedroom 4	CONTINENTAL W814XZ4	2002
	N/A	N/A
	N/A	N/A

Appliances:

Built In Appliances ☐ Yes ☒ No

Slide In Stove ☐ Yes ☒ No

Dishwasher Cabinet

☐ Closed ☒ Open

41" Upper Cabinets ☒ Yes ☐ No

Please NOTE: Standard Cabinet Height is 30"

Stove Opening

NOTE: If not specified, opening will be set to builder's standard opening of approximately 30" width

Fridge Opening

NOTE: If not specified, opening will be set to builder's standard opening of approximately 37" width x 74" height

** Refer to Construction Summary

2. Counters

	Counter	Edge
Kitchen / Breakfast	LAMINATE-CALCUTTA MARBLE 4925K-07	
Laundry Room	N/A	
Powder Room	LAMINATE-ARGENTO ROMANO 6697-46	
Master Ensuite Bathroom	LAMINATE-PALOMA DARK GREY 6366-46	
Ensuite Bath - Bedroom 2	LAMINATE-ARGENTO ROMANO 6697-46	
Ensuite Bath - Bedroom 3	LAMINATE-ARGENTO ROMANO 6697-46	
Ensuite Bath - Bedroom 4	LAMINATE-ARGENTO ROMANO 6697-46	
	N/A	
	N/A	

** Refer to Construction Summary

Initial:

EL

Purchaser: KAYHAN ISIK

Property: 33

Telephone Res. / Bus: /

Project: Secondo Vales Estates Inc.

Decor Advisor: Candace Forza

Model and Elevation: Newberry 6A Elev 2

Lock Date: 16-Nov-18

16-Nov-18

Plan #: 65M-4626

3. Ceramic Flooring

		At a 45	Threshold-If App.
Entrance Vestibule	TILE-RAINBOW WHITE-13X13	☐	
Main Hall	STRIP	☐	METAL STRIP
Kitchen / Breakfast	TILE-RAINBOW WHITE-13X13	☐	METAL STRIP
Laundry Room	TILE-RAINBOW DARK GREY-13X13	☐	METAL STRIP
Powder Room	TILE-RAINBOW WHITE-13X13	☐	
Master Ensuite Bathroom	TILE-RAINBOW DARK GREY-13X13	☐	METAL STRIP
Ensuite Bath - Bedroom 2	TILE-RAINBOW DARK GREY-13X13	☐	METAL STRIP
Ensuite Bath - Bedroom 3	TILE-RAINBOW DARK GREY-13X13	☐	METAL STRIP
Ensuite Bath - Bedroom 4	TILE-RAINBOW DARK GREY-13X13	☐	METAL STRIP
GARAGE ENTRY	TILE-RAINBOW WHITE-13X13	☐	
	N/A	☐	

** Refer to Construction Summary

4. Ceramic Wall Tile

Master Ensuite Bathroom	Selection	Describe
Tub Deck Wall	N/A	
Tub Deck	N/A	
Tub Deck Skirt	N/A	
Shower Stall	TILE-LUC BLANC GROENLANDIA-8X16	
Bathtub Enclosure Walls	N/A	
Ensuite Bath - Bedroom 2	TILE-LUC BLANC GROENLANDIA-8X16	
Ensuite Bath - Bedroom 3	TILE-LUC BLANC GROENLANDIA-8X16	
Ensuite Bath - Bedroom 4	TILE-LUC BLANC GROENLANDIA-8X16	
GARAGE ENTRY	N/A	
	N/A	
Kitchen Backsplash	N/A	

** Refer to Construction Summary - STANDARD GROUT THROUGHOUT UNLESS SPECIFIED

5. Plumbing Fixtures

All Bathrooms

White

N/A

N/A

Whirlpool

N/A

☐ Yes ☒ No

Dishwasher Rough-In

☒ Yes ☐ No

Waterline for Fridge

☒ Yes ☐ No

** Refer to Construction Summary

6. Trim Carpentry

Interior Doors	CARRARA-SMOOTH
Interior Trim	As Per Construction Specifications
Door Handles	As Per Construction Specifications
Exterior Front Door Handle	As Per Construction Specifications

** Refer to Construction Summary

Initial: 

Purchaser: KAYHAN ISIK

Property: 33

Telephone Res. / Bus: /

Project: Secondo Vales Estates Inc.

Decor Advisor: Candace Forza

Model and Elevation: Newberry 6A Elev 2

Lock Date: 16-Nov-18

16-Nov-18

Plan #: 65M-4626

7. Other Flooring

Main Hall	STRIP-MIRAGE-RED OAK-CASHMERE-CHARCOAL-4 7/16"
Living Room	STRIP-MIRAGE-RED OAK-CASHMERE-CHARCOAL-4 7/16"
Dining Room	STRIP-MIRAGE-RED OAK-CASHMERE-CHARCOAL-4 7/16"
Family Room	STRIP-MIRAGE-RED OAK-CASHMERE-CHARCOAL-4 7/16"
Den / Library / Study	N/A
Basement Landing(If Applies)	N/A
Lower Landing (If Applies)	N/A
Upper Landing	STRIP-MIRAGE-RED OAK-CASHMERE-CHARCOAL-4 7/16"
Upper Hall	LAMINATE-MANHATTAN - EARL GREY OAK TL-15012
Master Bedroom	LAMINATE-MANHATTAN - EARL GREY OAK TL-15012
Bedroom #2	LAMINATE-MANHATTAN - EARL GREY OAK TL-15012
Bedroom #3	LAMINATE-MANHATTAN - EARL GREY OAK TL-15012
Bedroom #4	LAMINATE-MANHATTAN - EARL GREY OAK TL-15012
Bedroom #5	N/A
	N/A
	N/A
	N/A
Underpad	TypeArea
	N/AN/A

** Refer to Construction Summary

8. Railings and Pickets

Railing Type	AS PER CONSTRUCTION SPECIFICATIONS	Colour	MIRAGE CHARCOAL
Picket Type	AS PER CONSTRUCTION SPECIFICATIONS	Colour	MIRAGE CHARCOAL
Stringer / Riser	AS PER CONSTRUCTION SPECIFICATIO	Colour	MIRAGE CHARCOAL
Treads	AS PER CONSTRUCTION SPECIFICATIO	Colour	MIRAGE CHARCOAL
Red Oak Stairs with Semi Gloss Finish		☒ Yes ☐ No	

** Refer to Construction Summary

9. Wall Paint Flat Finish

Main & Upper Hall	22 WARM GREY	Master Bedroom	22 WARM GREY
Living Room	22 WARM GREY	Bedroom #2	22 WARM GREY
Dining Room	22 WARM GREY	Bedroom #3	22 WARM GREY
Kitchen / Breakfast	22 WARM GREY	Bedroom #4	22 WARM GREY
Family Room	22 WARM GREY	Bedroom #5	N/A
Powder Room	22 WARM GREY	Master Ensuite	22 WARM GREY
Laundry Room	22 WARM GREY	Ensuite Bath - Bedroom 2	22 WARM GREY
Den/Library	N/A	Ensuite Bath - Bedroom 3	22 WARM GREY
Trim Paint-Semi Gloss	BIRCH WHITE	Ensuite Bath - Bedroom 4	22 WARM GREY
	N/A		N/A
	N/A		N/A

Smooth Ceilings First Floor ☒ Yes ☐ No

** Refer to Construction Summary

Initial: *ki*

Purchaser: KAYHAN ISIK

Telephone Res. / Bus: /

Decor Advisor: Candace Forza

Lock Date: 16-Nov-18

Property: 33

Project: Secondo Vales Estates Inc.

Model and Elevation: Newberry 6A Elev 2

16-Nov-18

Plan #: 65M-4626

10. Plaster Mouldings and Medallions

Entrance Vestibule	N/A	N/A	Kitchen/Breakfast	N/A	N/A
Main Hall	N/A	N/A	Den/Library	N/A	N/A
Living Room	N/A	N/A	Lower Landing	N/A	N/A
Dining Room	N/A	N/A		N/A	N/A
Family Room	N/A	N/A		N/A	N/A

** Refer to Construction Summary

11. Fireplace

	Living Room			Family Room			Other Room - Specify		
	Purchased	As Per Plan	N/A	Purchased	As Per Plan	N/A	Purchased	As Per Plan	N/A
Fireplace Type	☐	☐	☒	☐	☒	☐	☐	☐	☒
Mantle Type	N/A			FLAT ON WALL			N/A		
Colour / Stain	N/A			MANTLE M3			N/A		
Surround	N/A			AS PER CONSTRUCTION SPECIFICATIONS			N/A		
Hearth	N/A			NERO			N/A		
				NO			N/A		

** Refer to Construction Summary

12. Heating and Air Conditioning

Air Conditioning	NO	Gas Provisions Stove	NO
Gas Provisions Dryer	NO	Gas Provisions Barbecue	NO

Comment

** Refer to Construction Summary

13. Electrical

Plugs and Switches	☒ White	DECOR	Above Kitchen Cabinet Light	☐ Yes	☒ No
Hood Fan	STANDARD WHITE		Below Kitchen Cabinet Light	☐ Yes	☒ No
Appliances	Built in Cooktop	Built in Oven	Gas Stove	Microwave	
	☐ Yes ☒ No	☐ Yes ☒ No	☐ Yes ☒ No	☐ Yes ☒ No	
Dishwasher Rough-in	Yes				

** Refer to Construction Summary


14. General Comments

** Refer to Construction Summary

Disclaimers and Notes

- Colours of all materials are as close as possible to builder's selection, but not necessarily identical due to variances in manufacturing.
- Any extras listed above are null and void unless accompanied by a separate invoice/amendment. Said invoice must be paid in full.
- The Purchaser agrees that this colour selection is final and that no changes will be permitted, unless required by the Vendor.
- The Purchaser acknowledges reading and accepting document which contains other miscellaneous disclaimers.

Signature:  Date: NOV. 16/18

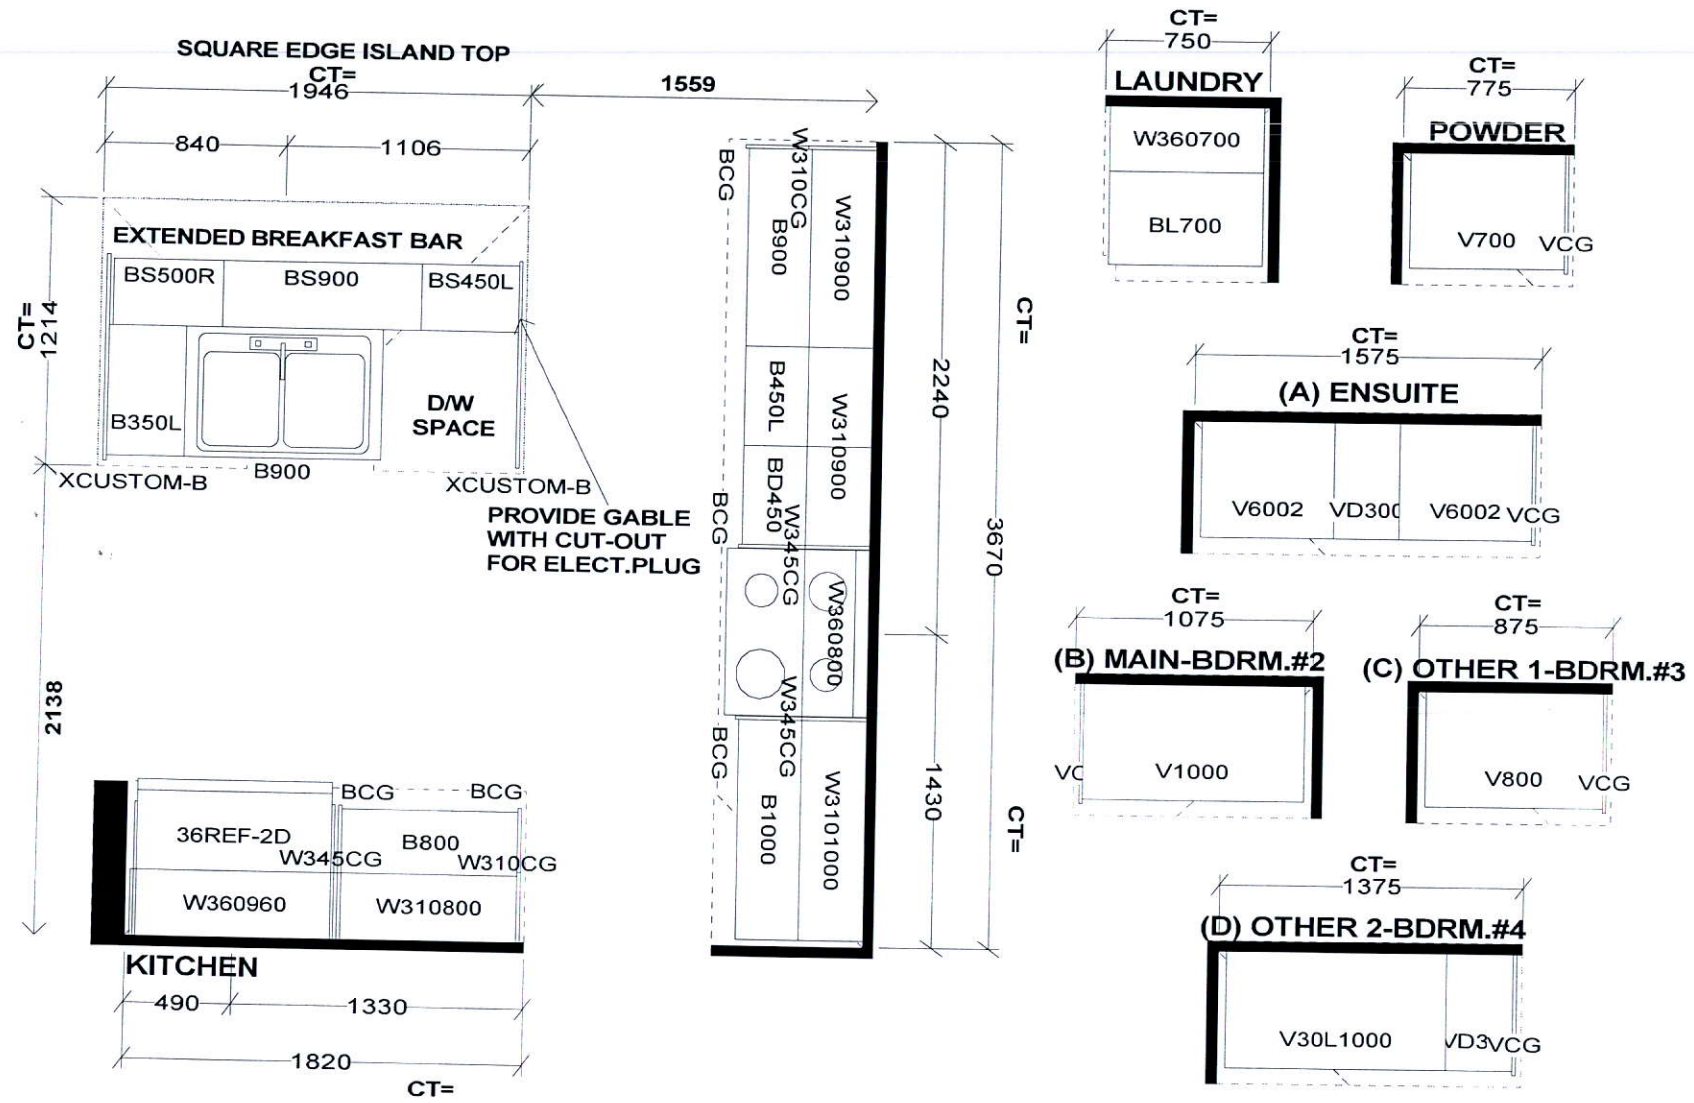

Selba Industries

W	WDTH	W	HGHT	W	CNT	FL	HGHT	DWY	H	ST	CENT	2X4	VENT BOX COVER
STANDARD FEATURES:													
1040MM HIGH UPPER CABINETS LAMINATE KITCHEN & VANITY TOPS DISHWASHER SPACE DUMMY DOORS ON EXPOSED BACKS								This drawing is the intellectual property of SELBA INDUSTRIES INC. and is an original design which must not be released or copied unless applicable fee has been paid or job order placed.				JOB NUMBER: BUILDER: GREENPARK SITE NAME: SECONDO VALES MODEL: NEWBERRY 6AX ELEV 1,2,3 LOT #: DESIGNER: KS DATE: MAR 22 18	

Add Plug Above Fireplace



4 Potlights

6 Potlights


Center Std. Light

Add Light Above Island

NEWBERRY 6A | 2,984 SQ.FT. 19 SQ.FT. OF OPEN AREA

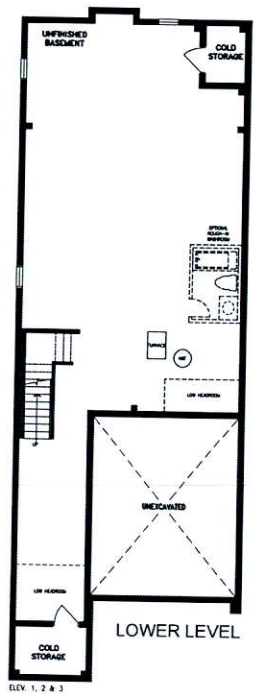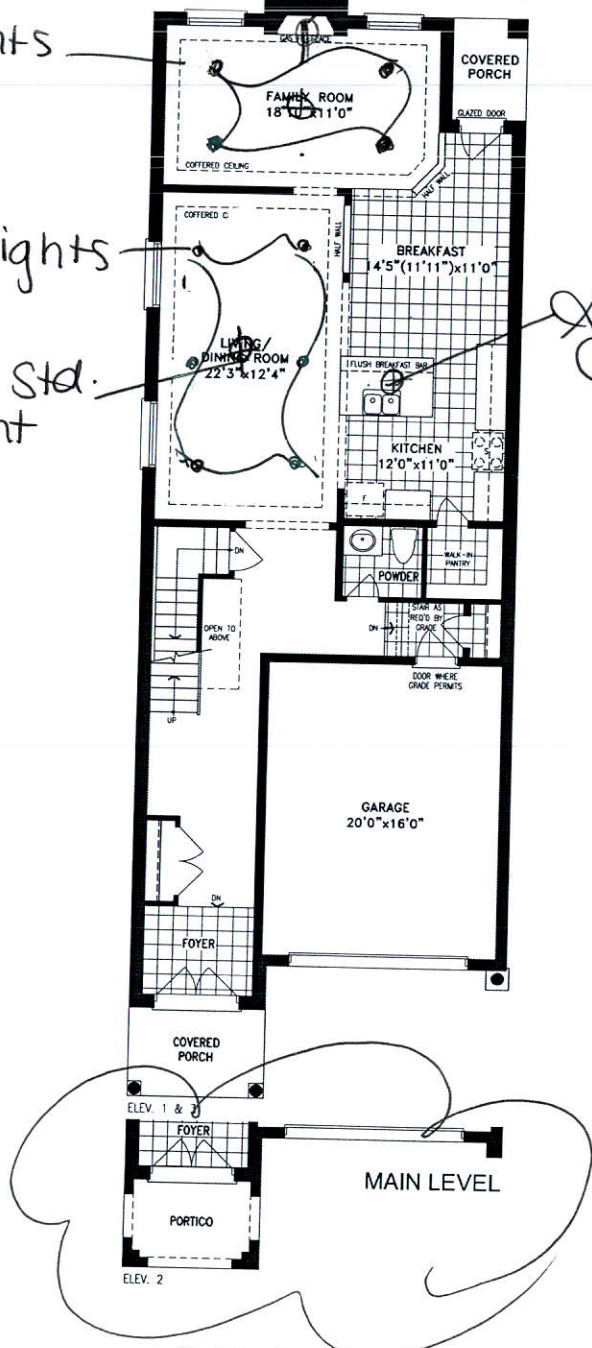

21

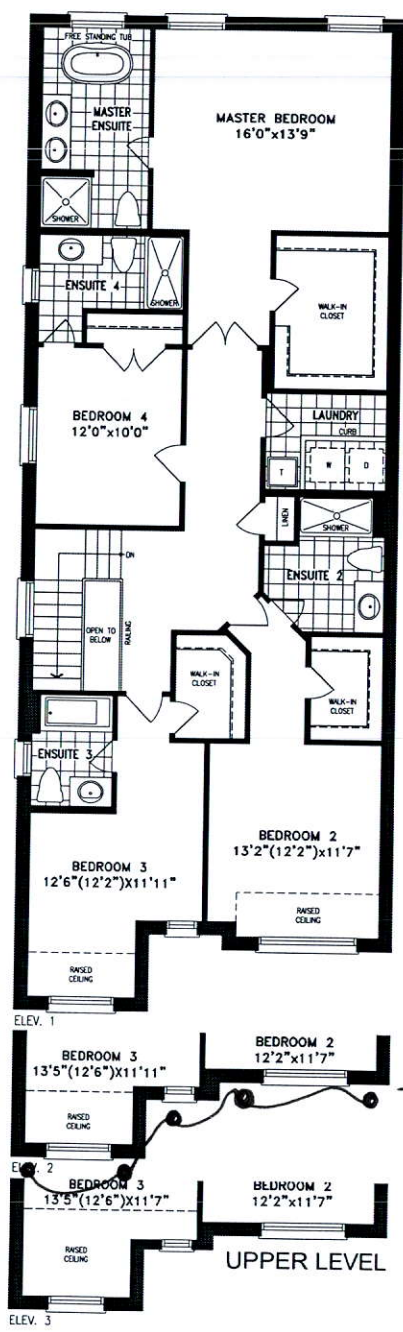

5 Exterior Potlights

Orientation of home may be reversed and purchaser agrees to accept the same. Steps and porches may vary at any exterior entrance ways due to grading variance. Actual usable floor space may vary from the stated floor areas. All renderings are artist's concept. Dimensions, specifications and architectural detailing subject to modifications. Roofline and adjoining model types may vary due to siting. E. & O. E. May 2018