Greenpark.

CONSTRUCTION SUMMARY Sharon Village 2 - Secondo Vales Estates Inc. PURCHASERS: GAGANDEEP SINGH and SONIA PARDAL TEL: LOT / PHASE REG. PLAN# HOUSE TYPE 35/2 65M-4626 Newberry 6A Elev 1 CABINETRY - KITCHEN - DELETE CABINETS ABOVE STOVE - VENDOR WILL SUPPLY 6 INCH VENT AS PER CONSTRUCTION SPECIFICATIONS 04Jan19 Note: 1 - POWDER ROOM - UPGRADE 2 HARDWARE 04Jan19 Note: 1 - POWDER ROOM - UPGRADE 2 CABINETRY 04Jan19 Note: 1 - KITCHEN - LIGHT VALANCE - NO ELECTRICAL 04Jan19 Note: 1 - KITCHEN - UPGRADE 2 HARDWARE 04Jan19 Note: 1 - KITCHEN - UPGRADE 2 CABINETRY 04Jan19 Note: CABINETRY ACCESSORIES 1 - KITCHEN CABINETRY UPPER - FULL DEPTH ABOVE FRIDGE - WITH GABLES - 600MM - PRICE IS EACH - UPGRADE 2 04Jan19 Note: 1 - KITCHEN CABINETRY BASE - POT/PAN DRAWERS (CABINET) - UPGRADE 2 04.Jan19 Note: CERAMIC TILE 1 - DELETE ALL CERAMIC BATHROOM ACCESSORIES - DELETE TOWEL BAR, PAPER HOLDER & SOAP DISH THROUGHOUT 04Jan19 Note: 1 - FOYER, POWDER ROOM, KITCHEN & GARAGE ENTRY - UPGRADE 4 FLOOR TILES 04Jan19 Note: CONSTRUCTION 1 - SMOOTH CEILINGS ON FIRST FLOOR ONLY 04Jan19 Note: COUNTER TOP 1 - POWDER ROOM - HIGH-END QUARTZ COUNTERTOP 1 - KITCHEN - HIGH END QUARTZ COUNTERTOP 04Jan19 Note: **ELECTRICAL** 1 - KITCHEN - CANOPY HOOD FAN - 30" CYCLONE 550 CFM #SC51330 04Jan19 Note: 1 - PLUG - ELECTRICAL PLUG - TO BE INSTALLED OVER FIREPLACE I - STANDARD DINING ROOM LIGHT TO BE CENTERED BETWEEN LIVING AND DINING ROOM 04Jan19 Note: 1 - RELOCATE STANDARD KITCHEN LIGHT TO BE CENTERED OVER ISLAND

04Jan19 Note:



		CON	NSTRUCTION SUMMARY		
		Sharon	Village 2 - Secondo Vales Estates Inc.		
PURCHA	SERS: GAGANI	DEEP SINGH and SONIA PA	RDAL		TEL:
LC	OT / PHASE 35 / 2	REG. PLAN # 65M-4626	HOUSE TYPE Newberry 6A Elev 1		
1 - GAS LI	INE ROUGH-IN	FOR STOVE (INCLUDES EI	LECTRICAL OUTLET) - FIRST FLOOR		1
04Jan19	Note:				
1 - MANT	EL - PAINTED -	M6 - IN LIEU OF STANDAF	RD MANTEL		
04Jan19	Note:				
HARDWO	OOD FLOORI	NG			
1 - LAMIN	ATE -UPGRAD	E TO LEXINGTON SERIES	IN LIEU OF STANDARD LAMINATE		
04Jan19					
	FLOOR - STANI	DARD NON-TILED AREAS -	- GROUP B - 5" HARDWOOD FLOORING IN LIEU	OF STANDARD AS PE	R
OFFER 04Jan19	Note:				
04041117	1,010.				
PLUMBI	NG				
		K - UNDERMOUNT SINK -	CONTRAC EMERY #4220CGY		
04Jan19		K - ONDERWOOM SINK -	CONTINAC LINEAU #4220COT		
1 - KITCH	EN - SINK - LIN	DERMOUNT SINK - BLANC	CO QUATRUS R15 U2 #401519		
04Jan19		DERINGOINI SINK BEHING	20 Q0/11R03 R13 02 #401317		
		DGE - ROUGH-IN ONLY			
04Jan19	Note:				
1 - POWD	ER ROOM - VIE	IRA 2 PC TOILET #4792BO	V/4791BOVU (UNLINED TANK) WITH SMOOTH (CLOSE TOILET SEAT	
04Jan19	Note:				
		THROOM - SINK - DROP-II	N SINK - CONTRAC LOLAND #4480BST		
04Jan19	Note:				
PROMOT	FIONAL				
		PURCHASER EXTRA SHEET	T IN OFFER		
04Jan19	Note:				
STAIRS A	AND RAILING	S			
TOTAL SECTION OF THE PARTY OF T		NE 1 IRON PICKETS - BLAC	CK		
04Jan19	Note:				
	S PER SET	TREADS, RISERS AND STI	RINGER EXCLUDING PICKETS (FOR IRON PICKI	ETS) - STANDARD STA	IRCASE
		EX	KTRAS AS PER OFFER		
(10) The V	Vendor agrees t	nat notwithstanding any oth	ner term or provision in this Agreement included in	n the Purchase Drice on	d in
	o those items de		e Agreement of Purchase and Sale, the Purchaser		u m
The Purch purchase. Worksheet		ges that the Purchase Price	is inclusive of all credits and promotional packag	ges available at the time	of

This Document is Extremely Time Sensitive - Printed $\underline{4 \text{ Jan } 19}$ at $\underline{15:22}$

Greenpark.

INTERIOR COLOUR SCHEME Purchasers: GAGANDEEP SINGH & SONIA PARDAL Property: 35 Telephone Res. / Bus: / Project: Secondo Vales Estates Inc. Decor Advisor: Candace Forza Model and Elevation: Newberry 6A Elev 1 Lock Date: 4-Jan-19 4-Jan-19 Plan #: 65M-4626

Layout Changes: Ye	es No Sketch	Attached: Yes No	Exterior Coloui	Scheme:
1. Cabinetry				
120 1 1 2	Style and Colour			Hardware
Kitchen / Breakfast	SONATA SATIN SNOW			722SC
Laundry Room	ELISSE			Standard
Powder Room	SONATA SATIN SNOW			167SB
Master Ensuite Bathroom	MODENA WHITE			2004
Ensuite Bath - Bedroom 2	MONACO W821XZ4			2004
Ensuite Bath - Bedroom 3	MONACO W350XZ4			2004
Ensuite Bath - Bedroom 4	MONACO W814XZ4		A sec	2004
	N/A			N/A
	N/A			N/A
Appliances: Dishwasher Cabinet Stove Opening Fridge Opening ** Refer to Construction	Built In Appliances Closed Ope	NOTE: If not specified, opening wil	ets Yes No	ide In Stove Yes No Please NOTE: Standard Cabinet Height is 30" ening of approximately 30" width ening of approximately 37" width x 74" height
2. Counters				
	Counter		Edge	
Kitchen / Broakfact	OLIADTZ ODIOLO MUDI			

QUARTZ-GRIGIO NUBE #360 EDGE Laundry Room N/A **Powder Room** QUARTZ-MOUNTAIN GREY #360 EDGE Master Ensuite Bathroom LAMINATE-CARRARA BIANCO 6696-46 Ensuite Bath - Bedroom 2 LAMINATE-INUK SHUK GREY P-344 LM Ensuite Bath - Bedroom 3 LAMINATE-WHITE CARRARA 4924-38 Ensuite Bath - Bedroom 4 LAMINATE-CALCUTTA MARBLE 4925K-07 N/A N/A

** Refer to Construction Summary





Greenpar	'k	INTERIOR COLOUR SCHEME						
- I - I	GAGANDEEP SINGH	H & SONIA PARDAL	Property:	35				
Telephone Res. / Bus:	/				ondo Vales Estates Inc.			
-	Candace Forza	Model a	85		berry 6A Elev 1			
	4-Jan-19	4-Jan-19	na Liovation.	Plar	To the second se			
LOCK Date.	4-Jan-19	4-3411-15		гіаі	1 #. 03IVI-4020			
3. Ceramic Flooring			-	At a 45	Threshold-If App.			
Entrance Vestibule	TILE-CALCATTA (CA	A6082P) POL-24X24			metal strip where applicable			
Main Hall	STRIP							
Kitchen / Breakfast	TILE-CALCATTA (CA	A6082P) POL-24X24						
_aundry Room	TILE-RAINBOW WH	HITE-13X13						
Powder Room	TILE-CALCATTA (CA	A6082P) POL-24X24						
Master Ensuite Bathroom	TILE-RAINBOW DA	RK GREY-13X13						
Ensuite Bath - Bedroom 2	TILE-BEACH LIGHT	GREY-13X13						
Ensuite Bath - Bedroom 3	TILE-ESSENZE GR	IGIO-13X13						
Ensuite Bath - Bedroom 4	TILE-RAINBOW LIG	GHT GREY-13X13						
GARAGE ENTRY		A6082P) POL-24X24						
** Refer to Construction S	N/A							
4. Ceramic Wall Tile								
Master Ensuite Bathroom	Selection		Des	scribe				
Tub Deck	Wall N/A							
Tub	Deck N/A							
Tub Deck	Skirt N/A							
Shower	Stall TILE-LUC BLANC	GROENLANDIA-8X16						
Bathtub Enclosure \	W alls N/A							
Ensuite Bath - Bedroom 2	TILE-BIANCO MAT	TE-8X16						
Ensuite Bath - Bedroom 3	TILE-SAT BLANC	GROENLANDIA-8X16						
Ensuite Bath - Bedroom 4	TILE-LUC CONCER	PT NEVE-8X16						
GARAGE ENTRY	N/A							
	N/A							
Kitchen Backsplash	N/A	ARD GROUT THROUG	HOUT UNLES	S SP	ECIFIED			
Kitchen Backsplash ** Refer to Construction	N/A Summary - STANDA	ARD GROUT THROUG	HOUT UNLES	S SP	ECIFIED			
Kitchen Backsplash * Refer to Construction 5. Plumbing Fixture	N/A Summary - STANDA	ARD GROUT THROUG	HOUT UNLES	S SP				
Kitchen Backsplash * Refer to Construction 5. Plumbing Fixture	N/A Summary - STANDA	ARD GROUT THROUG		S SP	ECIFIED N/A ○ Yes ● No			
Kitchen Backsplash * Refer to Construction 5. Plumbing Fixture	N/A Summary - STANDA s White	ARD GROUT THROUG		S SP				
Kitchen Backsplash * Refer to Construction 5. Plumbing Fixture	N/A Summary - STANDA S White N/A	ARD GROUT THROUG			N/A ○ Yes ● No			
Kitchen Backsplash * Refer to Construction 5. Plumbing Fixture	N/A Summary - STANDA S White N/A N/A	ARD GROUT THROUG		Dish	N/A Yes No			
Kitchen Backsplash * Refer to Construction 5. Plumbing Fixture	N/A Summary - STANDA S White N/A N/A N/A	ARD GROUT THROUG		Dish	N/A ○ Yes ● No			
Kitchen Backsplash * Refer to Construction 5. Plumbing Fixture	N/A Summary - STANDA S White N/A N/A N/A N/A N/A	ARD GROUT THROUG		Dish	N/A Yes No			
Kitchen Backsplash * Refer to Construction 5. Plumbing Fixture All Bathrooms	N/A Summary - STANDA S White N/A N/A N/A N/A N/A N/A	ARD GROUT THROUG		Dish	N/A Yes No			
Kitchen Backsplash * Refer to Construction 5. Plumbing Fixture All Bathrooms * Refer to Construction	N/A Summary - STANDA S White N/A N/A N/A N/A N/A N/A	ARD GROUT THROUG		Dish	N/A Yes No			
Kitchen Backsplash * Refer to Construction 5. Plumbing Fixture All Bathrooms * Refer to Construction 6. Trim Carpentry	N/A Summary - STANDA S White N/A N/A N/A N/A N/A N/A N/A Summary			Dish	N/A Yes No			
Kitchen Backsplash * Refer to Construction 5. Plumbing Fixture All Bathrooms * Refer to Construction 6. Trim Carpentry nterior Doors	N/A Summary - STANDA S White N/A N/A N/A N/A N/A N/A Summary CARRARA-SMOO	ТН		Dish	N/A Yes No			
Kitchen Backsplash ** Refer to Construction 5. Plumbing Fixture All Bathrooms * Refer to Construction 6. Trim Carpentry nterior Doors nterior Trim Door Handles	N/A Summary - STANDA S White N/A N/A N/A N/A N/A N/A Summary CARRARA-SMOO As Per Construction	TH on Specifications		Dish	N/A Yes No			
Kitchen Backsplash ** Refer to Construction 5. Plumbing Fixture All Bathrooms * Refer to Construction 6. Trim Carpentry nterior Doors nterior Trim Door Handles	N/A Summary - STANDA S White N/A N/A N/A N/A N/A N/A Summary CARRARA-SMOO As Per Construction As Per Construction	TH on Specifications on Specifications		Dish	N/A Yes No			
Kitchen Backsplash ** Refer to Construction 5. Plumbing Fixture All Bathrooms * Refer to Construction 6. Trim Carpentry nterior Doors nterior Trim	N/A Summary - STANDA S White N/A N/A N/A N/A N/A N/A Summary CARRARA-SMOO As Per Construction As Per Construction As Per Construction As Per Construction	TH on Specifications on Specifications		Dish	N/A Yes No			




Greenpark.

INTERIOR COLOUR SCHEME

Purchasers:	GAGANDEEP SINGH	& SONIA PARDAL Prop	erty: 3	35					
Telephone Res. / Bus:	1	Pro	oject: S	Secondo	Vales Estates Inc.				
Decor Advisor:	Candace Forza	Model and Eleva	tion: N	Newberry	6A Elev 1				
Lock Date:	4-Jan-19	4-Jan-19		Plan #:	65M-4626				
7. Other Flooring	1 0011 10								
Main Hall	STRIP-MIRAGE-SWEE	ET MEMORIES-RED OAK-CHARACTE	R-CASH	IMERE-HO	PSCOTCH-5"				
Living Room	STRIP-MIRAGE-SWEET MEMORIES-RED OAK-CHARACTER-CASHMERE-HOPSCOTCH-5"								
Dining Room	STRIP-MIRAGE-SWEET MEMORIES-RED OAK-CHARACTER-CASHMERE-HOPS								
Family Room	STRIP-MIRAGE-SWEI	STRIP-MIRAGE-SWEET MEMORIES-RED OAK-CHARACTER-CASHMERE-HOPSCOTCH-5"							
Den / Library / Study	N/A	N/A							
Basement Landing(If Applie	es) N/A	N/A							
Lower Landing (If Applies)	N/A	N/A							
Upper Landing	STRIP-MIRAGE-SWEI	ET MEMORIES-RED OAK-CHARACTE	R-CASH	MERE-HO	PSCOTCH-5"				
Upper Hall	LAMINATE-LEXINGTO	N - HAZELWOOD OAK TL-21016-M							
Master Bedroom	LAMINATE-LEXINGTO	LAMINATE-LEXINGTON - HAZELWOOD OAK TL-21016-M							
Bedroom #2	LAMINATE-LEXINGTO	N - HAZELWOOD OAK TL-21016-M							
Bedroom #3	LAMINATE-LEXINGTO	N - HAZELWOOD OAK TL-21016-M							
Bedroom #4	LAMINATE-LEXINGTO	N - HAZELWOOD OAK TL-21016-M							
Bedroom #5	N/A								
	N/A	N/A							
	N/A								
	N/A								
Underpad	Туре	Area							
	N/A	N/A							
Picket Type EUI Stringer / Riser AS Treads AS	PER CONSTRUCTION SP ROLINE 1 PER CONSTRUCTION PER CONSTRUCTION d Oak Stairs with Semi tion Summary	SPECIFICATIO Colour SPECIFICATIO Colour	BLACK MIRAG	E HOPSO	сотсн				
−9. Wall Paint Flat F	-inish								
Main & Upper Hall	22 WARM GREY	Master Bedroom		22 W	ARM GREY				
Living Room	22 WARM GREY	Bedroom #2			ARM GREY				
Dining Room	22 WARM GREY	Bedroom #3		22 W	ARM GREY				
Kitchen / Breakfast	22 WARM GREY	Bedroom #4	Bedroom #4		ARM GREY				
Family Room	22 WARM GREY	Bedroom #5	Bedroom #5						
Powder Room	22 WARM GREY	Master Ensuite	Master Ensuite		ARM GREY				
Laundry Room	22 WARM GREY	Ensuite Bath - Bed	Ensuite Bath - Bedroom 2		22 WARM GREY				
Den/Library	N/A	Ensuite Bath - Bed	Ensuite Bath - Bedroom 3		ARM GREY				
Trim Paint-Semi Gloss	BIRCH WHITE	Ensuite Bath - Bed	Ensuite Bath - Bedroom 4		ARM GREY				
	N/A				ARM GREY				
	N/A			N/A					
Smooth Ceilings First	Floor Yes	○ No							
** Refer to Construction	n Summary								




Gree	npa	rk.		IN	NTERIOR CO	DLOUR S	CHEME		
Purchasers:		GAGANDEEP SI	NGH & S	SONIA PAI	RDAL	Property:	35		
Telephone R	es. / Bus:	1				2002 27	Secondo Vales Estates Inc.		
Decor Advisor:		Candace Forza			Model and F		Newberry 6A Ele		
Lock Date:		4-Jan-19		4-Jan-1		icvation.	Plan #: 65M-		
10. Plaste	r Mouldir	ngs and Medalli	one-	T OUIT 1			riali #: Obivi-	4020	
Entrance Ve		N/A	UIIS		Vitalian (Du		F		
Main Hall		N/A			Kitchen/Bre		N/A		
Living Room		N/A			Den/Library		N/A		
Dining Room		10.00.00.00		-	Lower Land	ling	N/A		
		N/A					N/A		
Family Room		N/A							
Keler to	Construct	ion Summary							
11. Firepla	ice								
	Living Roo	m		Family Roo	om		Other Room -	Specify	
	Purchased	As Per Plan N/A		Purchase	d As Per Plan	N/A		As Per Plan N/A	1
		\circ			•				ì
Fireplace Type	N/A			FLAT ON V	VALL		N/A		
Mantle Type	N/A			MANTLE M6		N/A			
Colour / Stain	N/A			AS PER CO	ONSTRUCTION S	SPECIFICAT	IONS N/A		
Surround	N/A			GRIGIO CA	ARNICO		N/A		
Hearth ** Refer to Co	N/A	NO					N/A		
Gas Provis Comment * Refer to Co					G	as Provis	ions Barbecue	NO	
13. Electric	al								
Plugs and Swi		White	DE	COP		A I			_
lood Fan		White DECOR CYCLONE CHIMNEY 30" #SCS			7.501011		Kitchen Cabinet Light ○ Yes ● No		
Appliances		Built in Cooktop				Kitchen Cabinet Light Yes No			
		Yes No		O V 5		_	Gas Stove Microwave		
Dishwasher Ro	ouah-in	Yes) 163	• NO	Yes	○ No	○ Yes	No
* Refer to Con	-	Summary							
14. General									
* Refer to Cons	struction Su	ummary							
Disclaimers	and Note	s ———							
1) Colours o variances	f all mater in manufa	ials are as close a	as possi	ble to bui	ilder's selecti	ion, but no	ot necessarily id	lentical due	to
	s listed ab	ove are null and v	oid unle	ess accor	npanied by a	separate	invoice/amendr	nent. Said in	voice
	aser agree	es that this colou	r selecti	on is fina	l and that no	changes	will be permitted	d, unless rec	uired
l) The Purch disclaimer	aser ackn	owledges reading	g and ac	cepting d	ocument whi	ich contai	ns other/miscel	laneous	
Signature:	Trage) in/	Date: JA	1404/2019	Signature:	SPO	MU	_ Date: Ū⊄Ր	1.4 2019

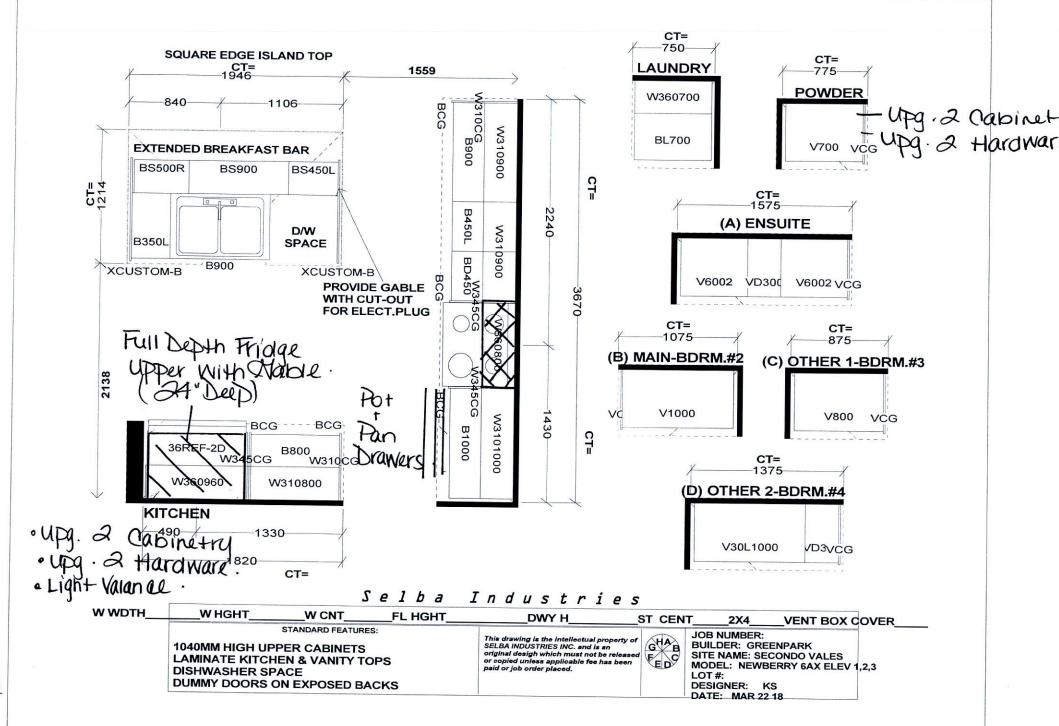





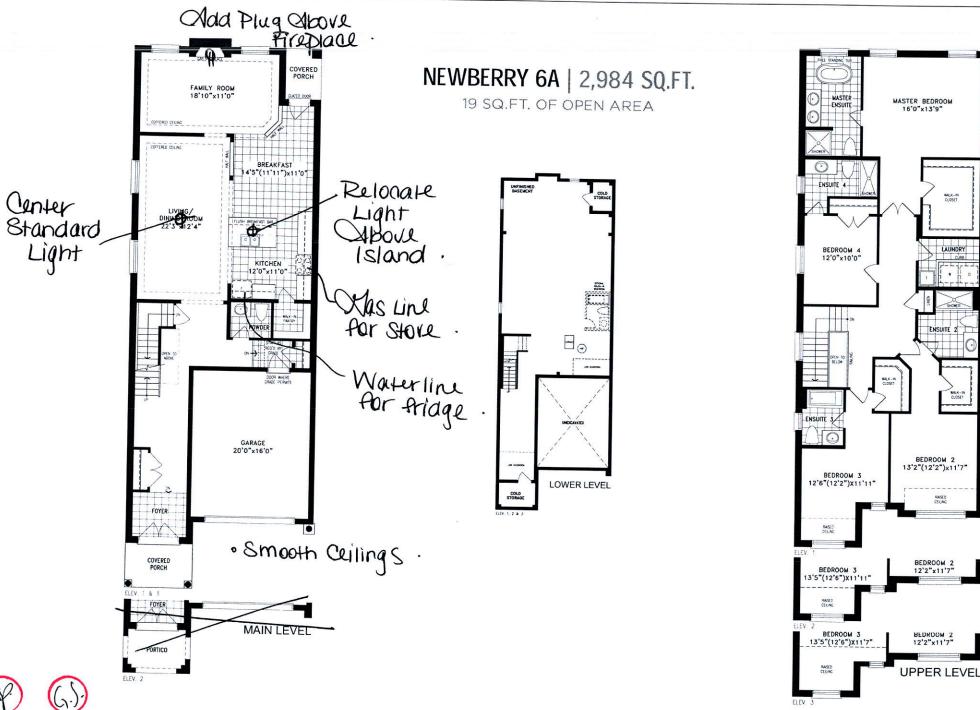





Orientation of home may be reversed and purchaser agrees to accept the same. Steps and porches may vary at any exterior entrance ways due to grading variance. Actual usable floor space may vary from the stated floor areas. All renderings are artist's concept. Dimensions, specifications and architectural detailing subject to modifications. Roofline and adjoining model types may vary due to siting. E. & O. E. May 2018