


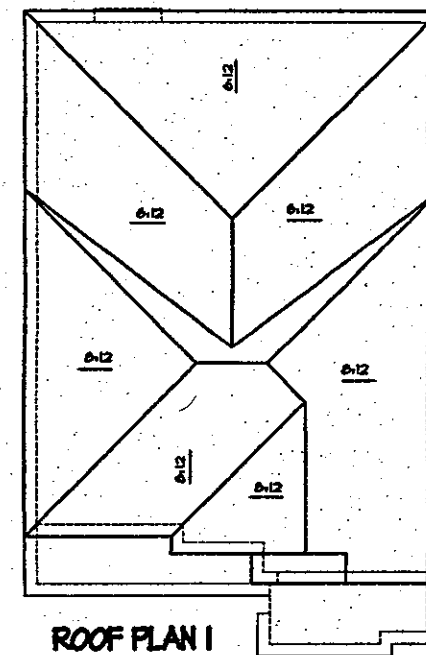

CITY OF HAMILTON  
BUILDING DIVISION  
Planning & Development Department  
OCT 26 2018  
REC. BY \_\_\_\_\_ DATE \_\_\_\_\_  
REF'D TO \_\_\_\_\_ DATE \_\_\_\_\_

CITY OF HAMILTON  
Building Division

Permit No. 18-141520-00-R9

THESE STAMPED DRAWINGS SHALL BE AVAILABLE ON SITE.  
THE OWNER AND/OR CONTRACTOR SHALL COMPLY WITH  
THE ONTARIO BUILDING CODE AND ALL OTHER APPLICABLE LAW

These drawings and/or specifications have been reviewed by  
*[Signature]* NOV. 9/18  
FOR CHIEF BUILDING OFFICIAL DATE

It is the builder's complete responsibility to ensure that all plans submitted for approval fully comply with the Architectural Guidelines and all applicable regulations and requirements including zoning provisions and any provisions in the subdivision agreement. The Control Architect is not responsible in any way for examining or approving site (lotting) plans or working drawings with respect to any zoning or building code or permit matter or that any house can be properly built or located on its lot.

This is to certify that these plans comply with the applicable Architectural Design Guidelines approved by the City of HAMILTON.


ARCHITECT: J. G. WILSON & ASSOCIATES

OCT 19 2018

ROSEWOOD 1A  
COMPLIANCE PACKAGE "A1"

**Greenpark.**

PROJECT NAME  
RUSSEL GARDENS II

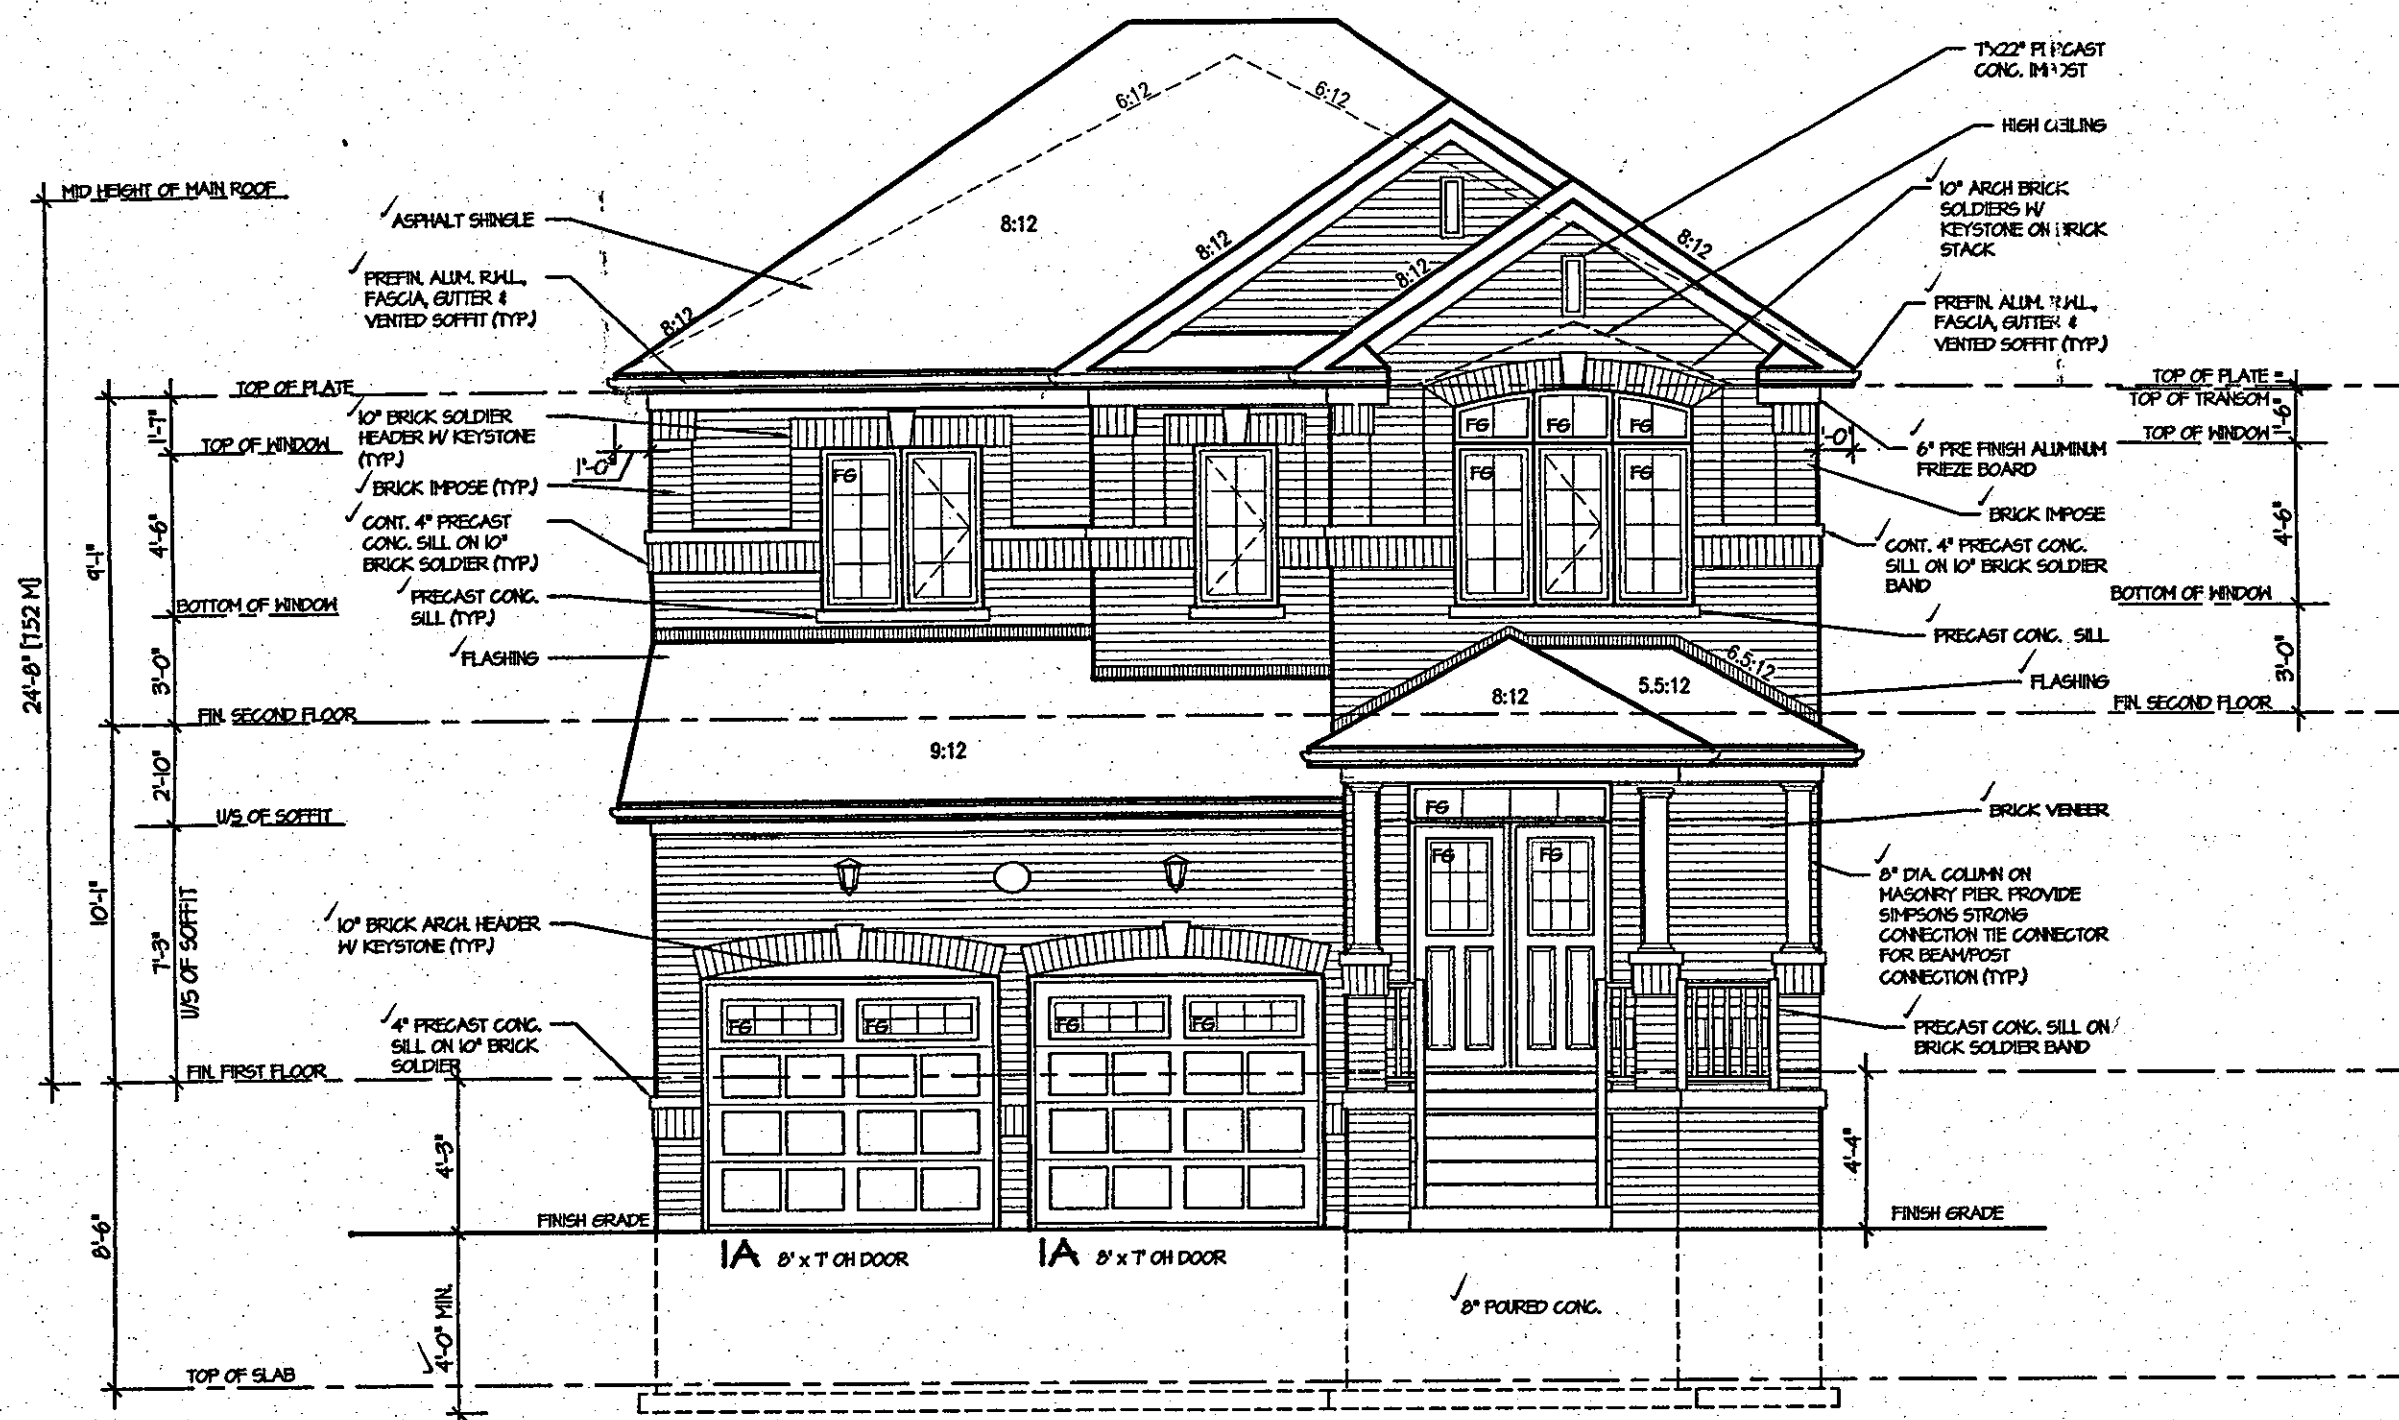

FRONT ELEVATION I  
FOR LOT 93

DROPPED FRONT GRADE CONDITION CHANGES  
- GARAGE ROOF DROPPED 1" II  
- GARAGE ROOF SLOPE INCREASED TO 9:12

OCT 16 2018

|           |                    |          |
|-----------|--------------------|----------|
| 5.        |                    |          |
| 4.        |                    |          |
| 3.        |                    |          |
| 2.        | REVISED FOR LOT 93 | OCT 2018 |
| 1.        | ISSUED FOR REVIEW  | FEB 2017 |
| REVISIONS |                    |          |

The undersigned has reviewed and takes responsibility for this design, and has the qualifications and meets the requirements set out in the Ontario Building Code to be a designer.  
QUALIFICATION INFORMATION  
Required unless design is exempt under Division C, Subsection 3.2.5 of the building code  
VIKAS GAJJAR 28770  
NAME SIGNATURE BCIN

REGION DESIGN INC.  
8700 DUFFERIN ST.  
CONCORD, ONTARIO  
L4K 4S6  
P (416) 738-4096  
F (905) 660-0746

**REGION  
DESIGN  
INC.**

SHEET TITLE  
FRONT ELEVATION 1  
FOR LOT 93  
SCALE 3/16"=1'-0"  
DATE OCT 2018  
BY ZMP  
TYPE

CONTRACTOR SHALL CHECK ALL DIMENSIONS AND ELEVATIONS BEFORE COMMENCING WITH WORK AND REPORT ANY DISCREPANCIES TO THE DESIGNER. PRINTS ARE NOT TO BE SCALED.  
AREA 2670  
PAGE No. 4B  
PROJECT 03-13-03