

PLAN OF SURVEY OF BLOCK 200 PLAN 62M-1238 CITY OF HAMILTON

SCALE 1:300
10m 5m 0 10m 20metres
RADY-PENTEK & EDWARD SURVEYING LTD., O.L.S.

METRIC
DISTANCES AND COORDINATES SHOWN ON THIS PLAN ARE IN
METRES AND CAN BE CONVERTED TO FEET BY DIVIDING BY 0.3048.

SURVEYOR'S CERTIFICATE

I CERTIFY THAT:

1. THIS SURVEY AND PLAN ARE CORRECT AND IN ACCORDANCE WITH THE
SURVEYS ACT, THE SURVEYORS ACT AND THE LAND TITLES ACT AND
THE REGULATIONS MADE UNDER THEM.

2. THE SURVEY WAS COMPLETED ON THE 11th DAY OF SEPTEMBER, 2018.

DATE Oct. 9, 2018.

T. Singh
T. SINGH
ONTARIO LAND SURVEYOR

I REQUIRE THIS PLAN TO BE DEPOSITED
UNDER THE LAND TITLES ACT.

DATE Oct. 9, 2018

T. Singh
T. SINGH, O.L.S.

PLAN 62R-20995

RECEIVED AND DEPOSITED

DATE October 12, 2018

"C. LANGKAMER"

REPRESENTATIVE FOR LAND REGISTRAR FOR THE LAND
TITLES DIVISION OF WENTWORTH (No.62)

SCHEDULE

PART	PART OF BLOCK	PLAN	PART OF P.I.N.
1	200	62M-1238	17501-0722
2	200		17501-0722
3	200		17501-0722
4	200		17501-0722
5	200		17501-0722
6	200		17501-0722
7	200		17501-0722

PARTS 1 TO 7 (INCLUSIVE) COMPRISE ALL
OF P.I.N. 17501-0722

PARTS 1 TO 7 (INCLUSIVE) ARE SUBJECT TO AN
EASEMENT IN GROSS AS SET OUT IN WE1193623

PARTS 1 TO 7 (INCLUSIVE) ARE SUBJECT TO AN
EASEMENT FOR ENTRY AS IN WE1245517

NOTES

- DENOTES MONUMENT SET
- DENOTES MONUMENT FOUND
- SSIB DENOTES SHORT STANDARD IRON BAR
- P.I.N. DENOTES PROPERTY IDENTIFIER NUMBER
- D.U.C. DENOTES DWELLING UNDER CONSTRUCTION
- P DENOTES PORCH
- PL DENOTES PLAN 62M-1238
- ℄ DENOTES CENTRELINE OF WALL
- (WT) DENOTES WITNESS
- f DENOTES FACE OF WALL
- SCP DENOTES SPECIFIED CONTROL POINT
- (RPE) DENOTES RADY-PENTEK & EDWARD SURVEYING LTD., O.L.S.



ALL FOUND MONUMENTS BY J. D. BARNES LIMITED, O.L.S.
UNLESS NOTED OTHERWISE.

ALL SET MONUMENTS ARE IRON BARS UNLESS NOTED OTHERWISE.
ALL TIES TO CONCRETE FOUNDATION


BEARING ARE GRID, UTM, ZONE 17, NAD83 (ORIGINAL), DERIVED FROM
SCP 01019910057 NORTH 4800689.658 EAST 590595.250
SCP 04319890309 NORTH 4800253.608 EAST 591432.827

COORDINATES ARE UTM ZONE 17, NAD83 (ORIGINAL), TO URBAN ACCURACY PER
SEC. 14 (2) OF O.REG. 216/10, AND CANNOT, IN THEMSELVES, BE USED TO
RE-ESTABLISH CORNERS OR BOUNDARIES SHOWN ON THIS PLAN.

DISTANCES ARE GROUND AND CAN BE CONVERTED TO GRID BY MULTIPLYING BY
THE COMBINED SCALE FACTOR OF 0.9996677.

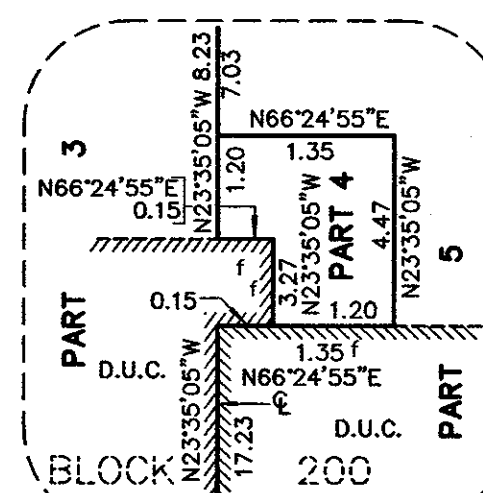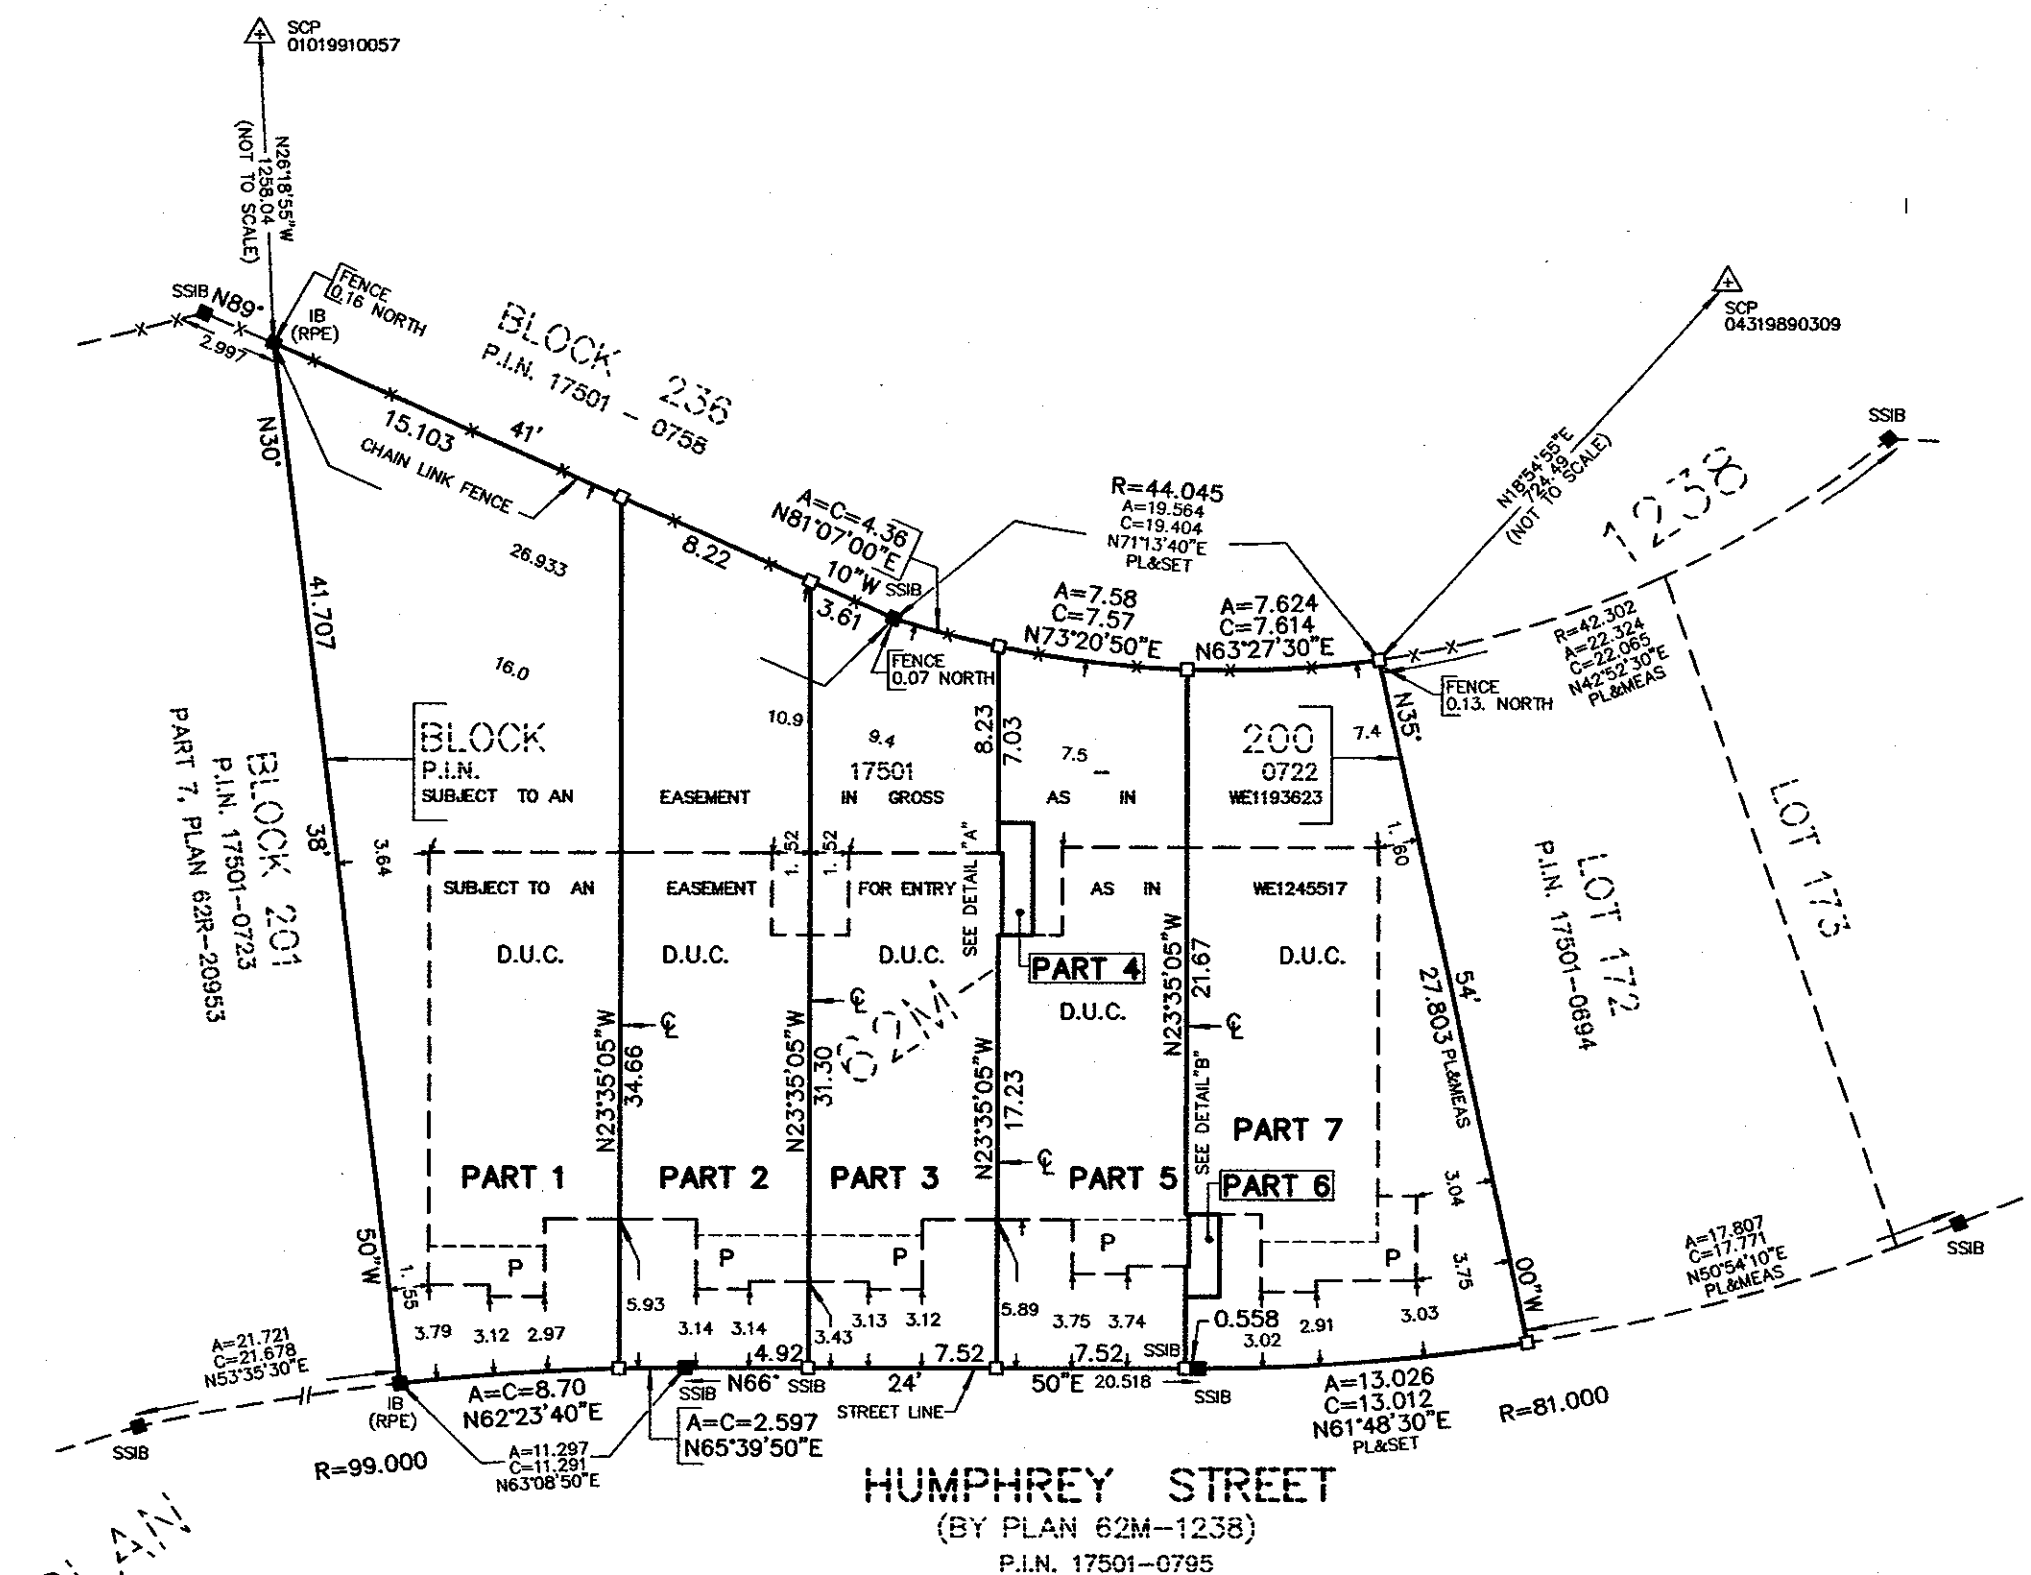

DETAIL "A"
(NOT TO SCALE)

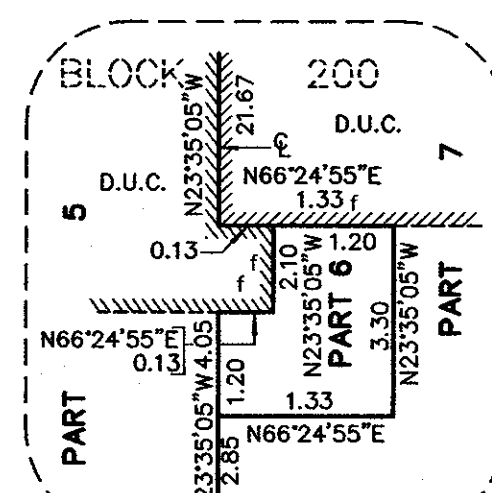

DETAIL "B"
(NOT TO SCALE)

RPE

RADY-PENTEK & EDWARD SURVEYING LTD.
ONTARIO LAND SURVEYORS
643 Chrislea Road, Suite 7
Woodbridge, Ontario L4L 8A3
Tel. (416) 635-5000 Fax (416) 635-5001
Tel. (905) 264-0881 Fax (905) 264-2099
Website: www.r-pe.ca
DRAWN: V.H. CHECKED: G.Y./T.S.
JOB No. 18-067 CAD FILE No. 18-067R014

Return to O.L.S.

Sept 26, 2018 - 11:47:07