

Greenpark™ Preliminary Upgrades

CONSTRUCTION SUMMARY		RECEIVED FEB 28 2019	
Mountainview Heights (G) - Russell Gardens Building Ltd.		TEL:	
PURCHASERS: MASSOUD M YOUSOF and HAMED HOSHMAND			
LOT / PHASE	REG. PLAN #	HOUSE TYPE	
Block 204 TH 1 / 2	62M-1238	Highgrove 7E Elev 2	

ELECTRICAL

1 - PLUG - ELECTRICAL PLUG 26Feb19 Note: FAMILY ROOM - INSTALLED 5' FROM FLOOR FOR FUTURE TV	
1 - RELOCATE STANDARD KITCHEN LIGHT TO BE CENTERED OVER ISLAND 26Feb19 Note:	
1 - LIGHT AND SWITCH - NO FIXTURE INCLUDED - LIVING ROOM 26Feb19 Note:	

PLUMBING

1 - WATER LINE FOR FRIDGE - ROUGH-IN ONLY 26Feb19 Note:	
------------------------------------------------------------	--

PROMOTIONAL

1 - PARTIAL REDEMPTION OF PROMOTIONAL PACKAGE \$9330.00 BALANCE FORWARD TO BE USED AT A LATER DATE. ORIGINAL PROMOTIONAL PACKAGE OF \$10,000.00 AS PER SCHEDULE PE 26Feb19 Note:	
----------------------------------------------------------------------------------------------------------------------------------------------------------------------------------------	--


EXTRAS AS PER OFFER

The Vendor agrees that notwithstanding any other term or provision in this Agreement included in the Purchase Price and in addition to those items detailed in Schedule GP to the Agreement of Purchase and Sale, the Purchaser is entitled to a credit of Ten Worksheet Note:	
Five (5) White Appliances as per PE Appliances Worksheet Note:	
The Purchaser acknowledges that the Purchase Price is inclusive of all credits and promotional packages available at the time of purchase. Worksheet Note:	

This Document is Extremely Time Sensitive - Printed 26 Feb 19 at 17:21

HIGHGROVE 7E

2,484 SQ.FT.
AVAILABLE IN BLOCK: 204

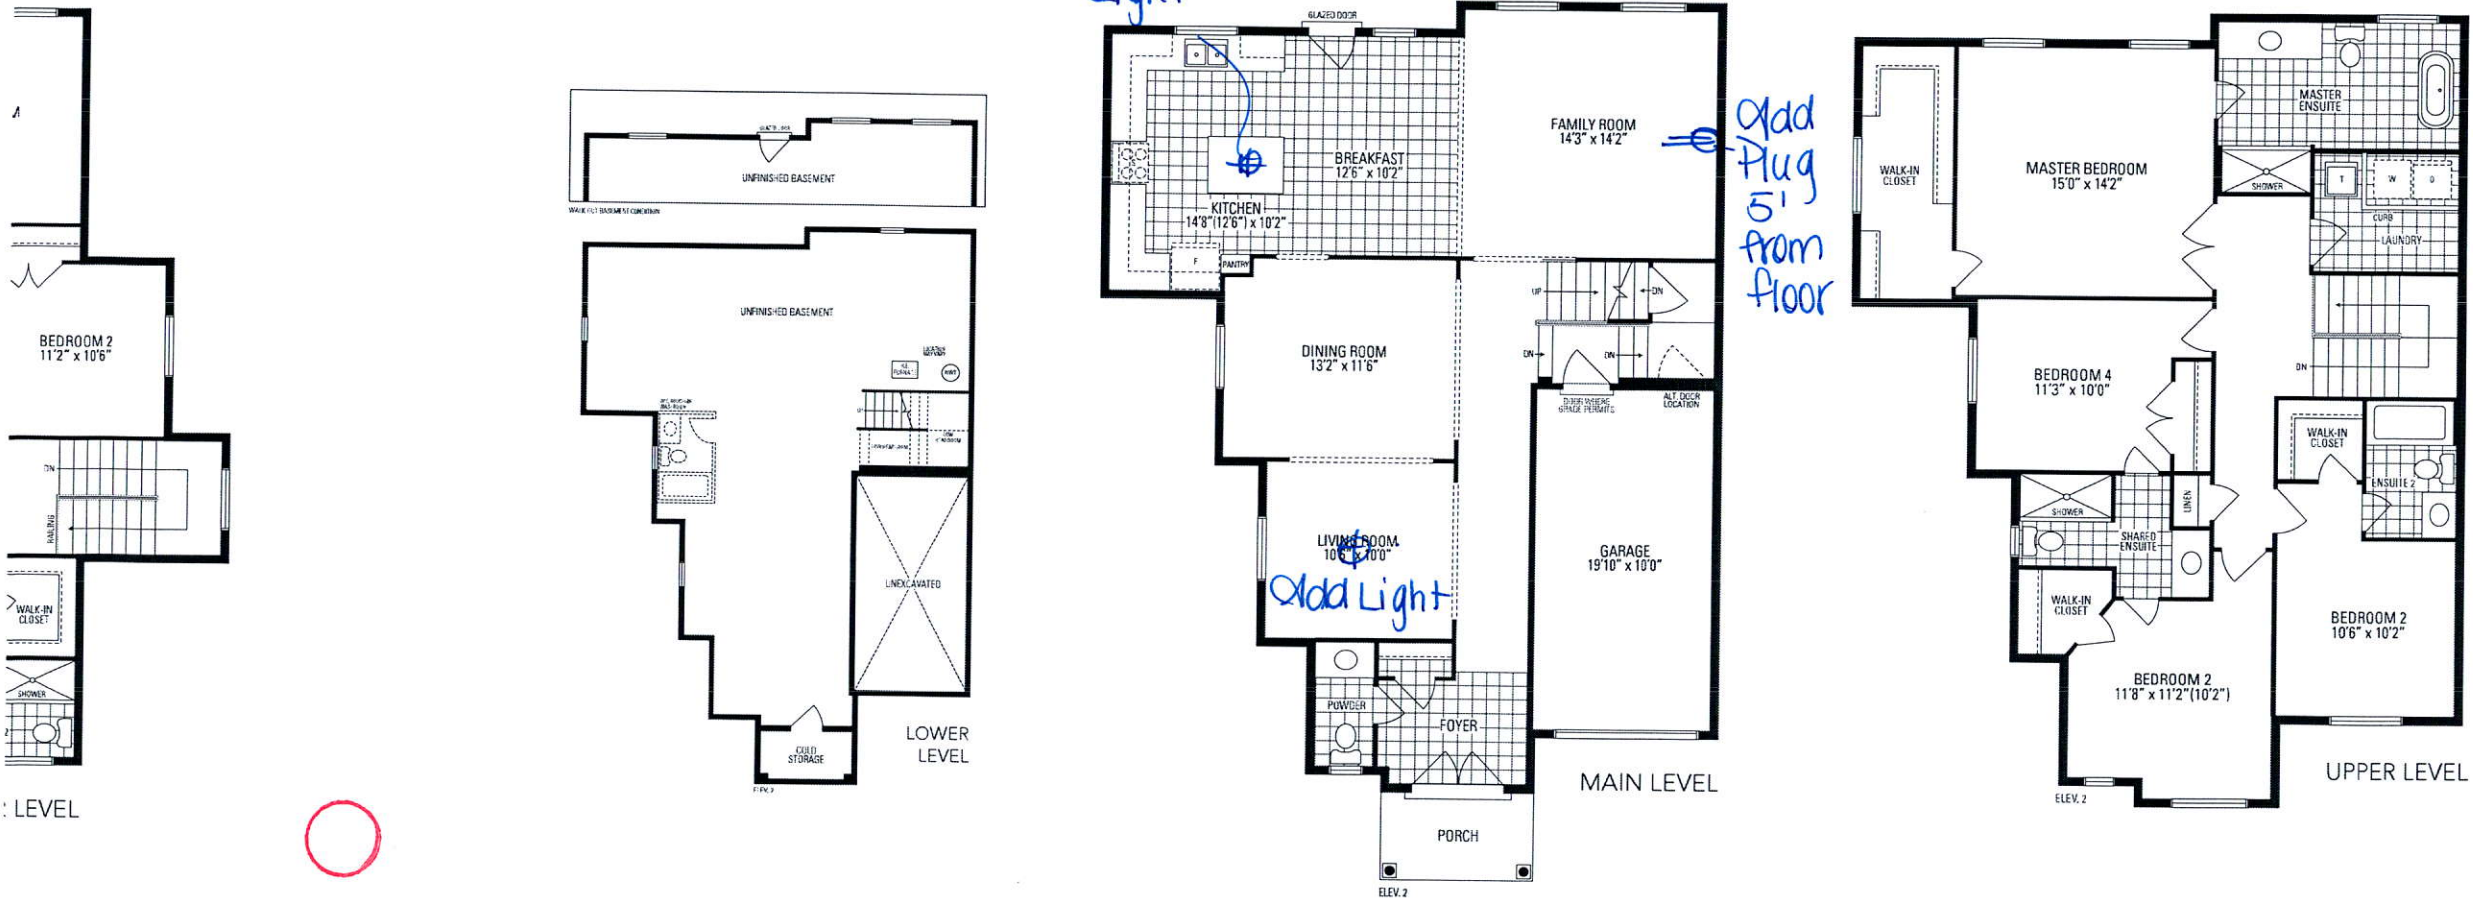

Does may vary due to siting. E. & O.E. LEC Highgrove 7E • Copyright Sept. 2017

Orientation of home may be reversed and purchaser agrees to accept the same. Steps and porches may vary at any exterior entrance ways due to grading variance. Actual usable floor space may vary from the stated floor area. All renderings are artist's concept. Dimensions, specifications and architectural detailing subject to minor modifications. Final location of sump pump is based on site conditions. Roofline and adjoining model types may vary due to siting. E. & O.E. LEC Highgrove 7E • Copyright Sept. 2017