HADING PLAN HAS SEEN REVIEWED BY METROPOLITAN

96 INC. FOR CONFORMANCE WITH THE APPROVED SUDDIVISION

DESIGN. THE PROPOSED GEACHS ON THIS PLAN ARE IN GENERAL

ENY WITH THE APPROVED GRADING PLAN AS IT REATES TO THE

ADMENT LOTS. MATERY THE BEASEMENT FLOOS BY OTHER

TON ELEVATIONS ARE PROPOSED AT A DIFFERENT ELEVATION

THE WITH THE APPROVED SUDDIVISION PLANS THE SEVERY

HAVE BEEN REPLEMED AND HE ARE ARRISED PAST THE

CRADES FOR THESE LATERALS CAN BE MAINTAINED IN

NOTE. THIS CHITHECATION DUE ARE ARRISED THAT THE

CRADES FOR THESE SAVER LATERALS AND CRIMERIA

NOTE. THIS CHITHECATION DUE AND CRIMERIA

NOTE. THIS CHITHECATION DUES NOT HELP ACT THE MUDDIT'S

BRITY TO EMPOSE THE SEWER LATERALS AND CRIMERIA

NO PRIOD TO CECHANING FOR THE FORMAL CONSULTING ANY

ARE THE BUILDER ARRESS THAT THEY SHALL BE TESSOONSHILE FOR

THE PROPOSITION OF THE SOURCE OF THE THEY SHALL BE TESSOONSHILE FOR

THE PROPOSITION OF THE CONDITIONS FOUND IN THE

AON

8M2 0 3

ectural Design the City of


145811 LABLE ON

hese drawings and in specifications have been ten. Peb 12/19.

TERRACE

×239.410



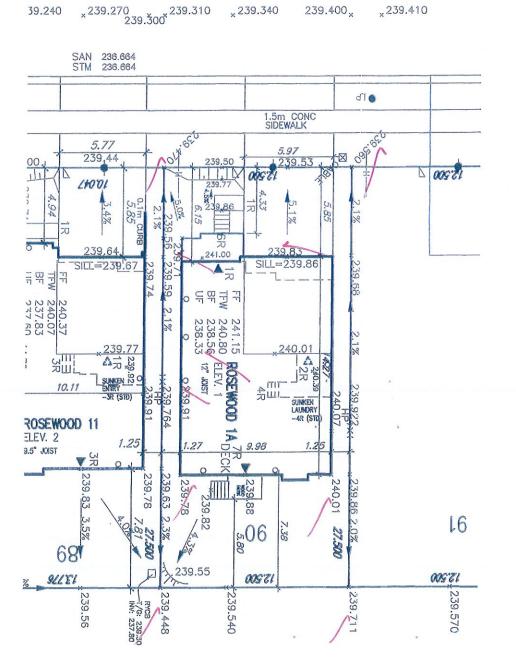

STONE

×239.340

39.240

NOTE: REFER TO LANDSCAPE DRAWINGS FOR ALL FENCING TYPES, HEIGHTS AND LOCATIONS CONTRACTOR TO VERIFY PRIOR TO INSTALLATION.

101

90

3

WA3 Design Inc. is to be notified promptly of any discrepanci-building can be re-sited. Failure to observe these conditions cost to WA3 Design Inc. Foundation wall shall be poured to o

of the builder to have the placement of storm

lines as indi

PRESED FLORE ELEMBNI
NUBERSIDE FOOTING ELEMBION
FIN, SHESTENT FLORE SLIG.
TOP OF FOUNDATIONS WILL
UNCERSIDE FOOTING AT TREAS
UNCERSION AT TREAS
UNCE

THIS LOT CONTINUS ENGIN

ACT AIR COMMINGER REQUIRED

AND COME WHO WITH COMMINGER REQUIRED

AND COMMINGER CONTROL

ACT AIR COMMINGER REQUIRED

AND COMMINGER CONTROL

ACT AIR COMMINGER CONTROL

ACT AIR COMMINGER

ACT AIR COM

AIR COMBIDNES \*\*\*

PARE WATER DOWNSPOUT LOCATION

(DESCHARE ONTO SELASIPAD)

SIDE WHOOM LOCATION

EXTERIOR DOOR LOCATION

REDUCE SIDE "VAID

STONE IN THIS AREA

LOT SITING/GRADING
THE NAME OF THE PARTY OF

Consumers Rd Suite

RUSSELL GARDENS PHASE 2