

CONSTRUCTION SUMMARY

Mayfield Village 2 (G) - Minnisale Homes Corp.

PURCHASERS: Swarnjit Kaur GREWAL and Ravandeep Singh GREWAL

TEL:

LOT / PHASE	REG. PLAN #	HOUSE TYPE		
20 / 2	43M-2060	Sandstone 2A Elev 2 (5 Bedroom Plan)		

CABINETRY

1 - KITCHEN REVISED LAYOUT - SINK AND DISHWASHER MOVED TO EXTENDED CABINETRY ON STOVE WALL PANTRY ALSO MOVED TO NEW LOCATION AS PER SKETCH  
25Jan19 Note:

1 - KITCHEN - DELETE CABINETS ABOVE STOVE - VENDOR WILL SUPPLY 6 INCH VENT AS PER CONSTRUCTION SPECIFICATIONS AND VENT MAY NOT BE IN THE APPROPRIATE LOCATION FOR INSTALLATION OF PURCHASER SUPPLIED VENT - PURCHASER TO SUPPLY OWN FAN AFTER CLOSING (TEMP. FAN MA  
25Jan19 Note:

1 - CABINETRY - KITCHEN - LIGHT VALENCE  
25Jan19 Note:

CABINETRY ACCESSORIES

1 - KITCHEN CABINETRY BASE - RECYCLE PULLOUT 2 BIN - PRICE IS EACH  
25Jan19 Note:

5 - KITCHEN CABINETRY BASE - BASE AND STANDARD COUNTER - PRICE IS PER FOOT - STANDARD- EXTEND CABINETS ON STOVE WALL APPROX 5FT TO ACCOMODATE NEW SINK LOCATION  
25Jan19 Note:

5 - KITCHEN CABINETRY UPPER - UPPER CABINETS - FITS TALL UPPER CABINETS - PRICE IS PER FOOT - STANDARD- EXTEND CABINETS ON STOVE WALL APPROX 5FT  
25Jan19 Note:

1 - KITCHEN CABINETRY UPPER - GLASS DOOR - GLK340 CORD GLASS - FINISHED INTERIOR - FITS TALL UPPER CABINETS ONLY - PRICE IS PER DOOR - STANDARD  
25Jan19 Note:

1 - KITCHEN CABINETRY UPPER - ANGLED CORNER CABINET - FITS TALL UPPER CABINETS - PER UNIT - STANDARD  
25Jan19 Note:

1 - KITCHEN CABINETRY BASE - COOKTOP CABINET WITH POT DRAWERS (2 DRAWERS) - STANDARD - 36"  
25Jan19 Note: Specs. Attached

1 - KITCHEN CABINETRY - BUILT-IN MICROWAVE/OVEN COMBO - STANDARD  
25Jan19 Note: Specs. Attached

1 - KITCHEN CABINETRY UPPER - FULL DEPTH ABOVE FRIDGE - WITH GABLES - 600MM - PRICE IS EACH - STANDARD  
25Jan19 Note:

CERAMIC TILE

1 - TILE - UPGRADE 2 FLOOR TILE - - SIDE ENTRANCE  
25Jan19 Note:

1 - TILE - UPGRADE 2 FLOOR TILE - - POWDER ROOM  
25Jan19 Note:

1 - TILE - UPGRADE 2 FLOOR TILE - - KITCHEN  
25Jan19 Note:

1 - TILE - UPGRADE 2 FLOOR TILE - - FOYER  
25Jan19 Note:

CONSTRUCTION

1 - MASTER ENSUITE SHOWER SEAT MUST BE MOVED TO OPPOSITE SIDE OF SHOWER TO ACCOMODATE PLUMBING FOR FRAMELESS GLASS ENCLOSURE. SEAT TO BE ON SAME WALL AS FRAMELESS GLASS NEXT TO TUB- SEE SKETCH  
25Jan19 Note:

COUNTER TOP

1 - HARD SURFACE COUNTERTOP - KITCHEN- REVISED LAYOUT  
25Jan19 Note:

CONSTRUCTION SUMMARY

Mayfield Village 2 (G) - Minnisale Homes Corp.

PURCHASERS: Swarnjit Kaur GREWAL and Ravandeep Singh GREWAL

TEL:

LOT / PHASE	REG. PLAN #	HOUSE TYPE		
20 / 2	43M-2060	Sandstone 2A Elev 2 (5 Bedroom Plan)		

ELECTRICAL

1 - BUILT IN OVEN AND COOKTOP PROVISION - PROVISION ONLY - ELECTRICAL ONLY 25Jan19 Note:	
1 - PLUG - ELECTRICAL PLUG WITH GFI AND SWITCH - FOR FESTIVE LIGHTING 04Jan19 Note:	
1 - PLUG - ELECTRICAL PLUG - TO BE INSTALLED OVER FIREPLACE 04Jan19 Note:	
1 - 200 AMP ELECTRICAL SERVICE 04Jan19 Note:	

HARDWOOD FLOORING

1 - HARDWOOD - PROMO SERIES 3 1/4 INCH - IN LIEU OF 2 1/4 INCH NATURAL RED OAK - - FIRST FLOOR COMPLETE 25Jan19 Note:	
--	--

MIRRORS AND GLASS

1 - FRAMELESS GLASS SHOWER ENCLOSURE WITH CHROME KNOB- MASTER ENSUITE 04Jan19 Note:	
--	--

PLUMBING

1 - TOE TESTER - ADD TOE TESTER TO SHOWER MASTER ENSUITE 25Jan19 Note:	
1 - SINK - UNDERMOUNT SINK - BLANCO STELLAR U 1 3/4 #401026 KITCHEN 25Jan19 Note:	
1 - RELOCATE KITCHEN SINK AND DISHWASHER TO EXTENDED CABINETRY ON STOVE WALL 25Jan19 Note:	

PROMOTIONAL

1 - LESS CREDIT FROM PURCHASER EXTRA SHEET IN OFFER 25Jan19 Note:	
1 - PARTIAL REDEMPTION OF PROMOTIONAL PACKAGE \$4,270 BALANCE FORWARD \$15,730 TO BE USED AT A LATER DATE. ORIGINAL PROMOTIONAL PACKAGE OF \$20,000 AS PER SCHEDULE PE 04Jan19 Note:	

STAIRS AND RAILINGS

1 - STAINED HANDRAIL, TREADS, RISERS AND STRINGER EXCLUDING PICKETS (FOR IRON PICKETS) - STANDARD STAIRCASE - PRICE IS PER SET 25Jan19 Note:	
1 - EUROLINE 1- BLACK IRON PICKETS 25Jan19 Note:	
1 - V GROOVE HANDRAIL 25Jan19 Note:	

EXTRAS AS PER OFFER

(20) The Vendor agrees that notwithstanding any other term or provision in this Agreement included in the Purchase Price and in addition to those items detailed in Schedule GP to the Agreement of Purchase and Sale, the Purchaser is entitled to a credit o Worksheet Note:	
The Purchaser acknowledges that the Purchase Price is inclusive of all credits and promotional packages available at the time of purchase. Worksheet Note:	



INTERIOR COLOUR SCHEME

Purchasers: Swarnjit Kaur GREWAL & Ravandeep Singh GRE

Property: 20

Telephone Res. / Bus: /

Project: Minnisale Homes Corp.

Decor Advisor: Natalie Mancuso

Model and Elevation: Sandstone 2A Elev 2 (5 Bedroom Plan)

Lock Date: 25-Jan-19

25-Jan-19

Plan #: 43M-2060

Layout Changes: ☐ Yes ☒ No

Sketch Attached: ☒ Yes ☐ No

Exterior Colour Scheme:

1. Cabinetry

	Style and Colour	Hardware
Kitchen / Breakfast	MONACO W821XZ4	2004
Laundry Room	N/A	N/A
Powder Room	CONTINENTAL 814 DARK CHOCOLATE	2001
Master Ensuite Bathroom	CONTINENTAL 814 DARK CHOCOLATE	2001
Ensuite Bath - Bedroom 2/3	MODENA CHOCOLATE	2001
Ensuite Bath - Bedroom 4	HASTING CHOCOLATE	2001

Appliances:

Built In Appliances ☒ Yes ☐ No

Slide In Stove ☐ Yes ☒ No

Dishwasher Cabinet ☐ Closed ☒ Open

41" Upper Cabinets ☒ Yes ☐ No

Please NOTE: Standard Cabinet Height is 30"

Stove Opening 

36"

NOTE: If not specified, opening will be set to builder's standard opening of approximately 30" width

Fridge Opening

NOTE: If not specified, opening will be set to builder's standard opening of approximately 37" width x 74" height

\*\* Refer to Construction Summary

2. Counters

	Counter	Edge
Kitchen / Breakfast	GRANITE- BIANCO ANTICO	#360 EDGE
Laundry Room	N/A	
Powder Room	LAMINATE-SMOKEY TOPAZ 4589K-07	
Master Ensuite Bathroom	LAMINATE-BAHIA GRANITE 4595K-52	
Ensuite Bath - Bedroom 2/3	LAMINATE-PALOMA DARK GREY 6366-46	
Ensuite Bath - Bedroom 4	LAMINATE-BORDEAUX JUPARANA 4929-52	

\*\* Refer to Construction Summary

Initials: 

54

Purchasers: Swarnjit Kaur GREWAL & Ravandeep Singh GRE

Telephone Res. / Bus: /

Decor Advisor: Natalie Mancuso

Lock Date: 25-Jan-19

Property: 20

Project: Minnisale Homes Corp.

Model and Elevation: Sandstone 2A Elev 2 (5 Bedroom Plan)

Plan #: 43M-2060

3. Ceramic Flooring

Entrance Vestibule	TILE- VERSAILLES CHATEAUX IVORIE BRILL 12X24	<input type="checkbox"/>	At a 45 Threshold-If App.
Main Hall	HARDWOOD	<input type="checkbox"/>	METAL STRIP THROUGHOUT
Kitchen / Breakfast	TILE- VERSAILLES CHATEAUX IVORIE BRILL 12X24	<input type="checkbox"/>	
Laundry Room	N/A	<input type="checkbox"/>	
Powder Room	TILE- VERSAILLES CHATEAUX IVORIE BRILL 12X24	<input type="checkbox"/>	
Master Ensuite Bathroom	TILE- ESSENZE NERO 13X13	<input type="checkbox"/>	
Ensuite Bath - Bedroom 2/3	TILE- ESSENZE GRIGIO 13X13	<input type="checkbox"/>	
Ensuite Bath - Bedroom 4	TILE- BEACH IVORY 13X13	<input type="checkbox"/>	
SIDE ENTRANCE	TILE- VERSAILLES CHATEAUX IVORIE BRILL 12X24	<input type="checkbox"/>	
		<input type="checkbox"/>	
		<input type="checkbox"/>	

\*\* Refer to Construction Summary

4. Ceramic Wall Tile

Master Ensuite Bathroom	Selection	Describe
Tub Deck Wall		
Tub Deck		
Tub Deck Skirt		
Shower Stall	TILE- LUC CONCEPT NEVE 8X16	
Bathtub Enclosure Walls		
Ensuite Bath - Bedroom 2/3	TILE- LUC 09 AFRICA 8X16	
Ensuite Bath - Bedroom 4	TILE- LUC BEIGE AMERICA 8X16	
SIDE ENTRANCE		
Kitchen Backsplash		

\*\* Refer to Construction Summary - STANDARD GROUT THROUGHOUT UNLESS SPECIFIED

5. Plumbing Fixtures

All Bathrooms

White

Whirlpool

☐ Yes ☒ No

Dishwasher Rough-In

☒ Yes ☐ No

Waterline for Fridge

☐ Yes ☒ No

\*\* Refer to Construction Summary

6. Trim Carpentry

Interior Doors	CARRARA
Interior Trim	3" BB CASING WITH 5 1/4" BASEBOARD - COLONIAL
Door Handles	SATIN NICKEL LEVER
Exterior Front Door Handle	As Per Construction Specifications

\*\* Refer to Construction Summary

Initials: 

54

Purchasers:

Swarnjit Kaur GREWAL & Ravandeep Singh GRE

Property: 20

Telephone Res. / Bus:

/

Project: Minnisale Homes Corp.

Decor Advisor:

Natalie Mancuso

Model and Elevation: Sandstone 2A Elev 2 (5 Bedroom Plan)

Lock Date:

25-Jan-19

25-Jan-19

Plan #: 43M-2060

7. Other Flooring

Main Hall	HARDWOOD- MIRAGE- 3 1/4 MAPLE- WATERLOO- SEMI GLOSS
Living Room	HARDWOOD- MIRAGE- 3 1/4 MAPLE- WATERLOO- SEMI GLOSS
Dining Room	HARDWOOD- MIRAGE- 3 1/4 MAPLE- WATERLOO- SEMI GLOSS
Family Room	HARDWOOD- MIRAGE- 3 1/4 MAPLE- WATERLOO- SEMI GLOSS
Den / Library / Study	
Basement Landing(If Applies)	
Lower Landing (If Applies)	TILE- VERSAILLES CHATEAUX IVORIE BRILL 12X24
Upper Landing	HARDWOOD- MIRAGE- 3 1/4 MAPLE- WATERLOO- SEMI GLOSS
Upper Hall	LAMINATE-MANHATTAN - BOARDWALK ACACIA TL-15019
Master Bedroom	LAMINATE-MANHATTAN - BOARDWALK ACACIA TL-15019
Bedroom #2	LAMINATE-MANHATTAN - BOARDWALK ACACIA TL-15019
Bedroom #3	LAMINATE-MANHATTAN - BOARDWALK ACACIA TL-15019
Bedroom #4	LAMINATE-MANHATTAN - BOARDWALK ACACIA TL-15019
Bedroom #5	LAMINATE-MANHATTAN - BOARDWALK ACACIA TL-15019

Underpad	Type	Area

\*\* Refer to Construction Summary

8. Railings and Pickets

Railing Type	V-GROOVE	Colour	MIRAGE- WATERLOO
Picket Type	EUROLINE 1	Colour	BLACK
Stringer / Riser	AS PER CONSTRUCTION SPECIFICATIO	Colour	MIRAGE- WATERLOO
Treads	AS PER CONSTRUCTION SPECIFICATIO	Colour	MIRAGE- WATERLOO
Red Oak Stairs with Semi Gloss Finish		<input checked="" type="radio"/> Yes	<input type="radio"/> No

\*\* Refer to Construction Summary

9. Wall Paint Flat Finish

Main & Upper Hall	43 BIRCH WHITE	Master Bedroom	43 BIRCH WHITE
Living Room	43 BIRCH WHITE	Bedroom #2	43 BIRCH WHITE
Dining Room	43 BIRCH WHITE	Bedroom #3	43 BIRCH WHITE
Kitchen / Breakfast	43 BIRCH WHITE	Bedroom #4	43 BIRCH WHITE
Family Room	43 BIRCH WHITE	Bedroom #5	43 BIRCH WHITE
Powder Room	43 BIRCH WHITE	Master Ensuite	43 BIRCH WHITE
Laundry Room	43 BIRCH WHITE	Ensuite Bath - Bedroom 2/3	43 BIRCH WHITE
Den/Library		Ensuite Bath - Bedroom 4	43 BIRCH WHITE
Trim Paint-Semi Gloss	43 BIRCH WHITE		

Smooth Ceilings First Floor ☐ Yes ☒ No

\*\* Refer to Construction Summary

Initials: SG

Purchasers: Swarnjit Kaur GREWAL & Ravandeep Singh GREWAL

Telephone Res. / Bus: /

Decor Advisor: Natalie Mancuso

Lock Date: 25-Jan-19

Property: 20

Project: Minnisale Homes Corp.

Model and Elevation: Sandstone 2A Elev 2 (5 Bedroom Plan)

Plan #: 43M-2060

10. Plaster Mouldings and Medallions

Entrance Vestibule			Kitchen/Breakfast		
Main Hall			Den/Library		
Living Room			Lower Landing		
Dining Room					
Family Room					

\*\* Refer to Construction Summary

11. Fireplace

	Living Room			Family Room			Other Room - Specify		
	Purchased	As Per Plan	N/A	Purchased	As Per Plan	N/A	Purchased	As Per Plan	N/A
Fireplace Type	<input type="radio"/>	<input type="radio"/>	<input checked="" type="radio"/>	<input type="radio"/>	<input checked="" type="radio"/>	<input type="radio"/>	<input type="radio"/>	<input type="radio"/>	<input checked="" type="radio"/>
Mantle Type				FLAT ON WALL					
Colour / Stain				MANTLE M2-STANDARD					
Surround				AS PER CONSTRUCTION SPECIFICATIONS					
Hearth				NERO					
				NO					

\*\* Refer to Construction Summary

12. Heating and Air Conditioning

Air Conditioning	NO	Gas Provisions Stove	NO
Gas Provisions Dryer	NO	Gas Provisions Barbecue	NO
Comment			

\*\* Refer to Construction Summary

13. Electrical

Plugs and Switches	<input checked="" type="radio"/> White	DECOR	Above Kitchen Cabinet Light	<input type="radio"/> Yes	<input checked="" type="radio"/> No
Hood Fan	STANDARD WHITE		Below Kitchen Cabinet Light	<input type="radio"/> Yes	<input checked="" type="radio"/> No
Appliances	Built in Cooktop	Built in Oven	Gas Stove	Microwave	
	<input checked="" type="radio"/> Yes <input type="radio"/> No	<input checked="" type="radio"/> Yes <input type="radio"/> No	<input type="radio"/> Yes <input checked="" type="radio"/> No	<input checked="" type="radio"/> Yes <input type="radio"/> No	
Dishwasher Rough-in	Yes				

\*\* Refer to Construction Summary

14. General Comments

\*\* Refer to Construction Summary

Disclaimers and Notes

- 1) Colours of all materials are as close as possible to builder's selection, but not necessarily identical due to variances in manufacturing.
- 2) Any extras listed above are null and void unless accompanied by a separate invoice/amendment. Said invoice must be paid in full.
- 3) The Purchaser agrees that this colour selection is final and that no changes will be permitted, unless required by the Vendor.
- 4) The Purchaser acknowledges reading and accepting document which contains other miscellaneous disclaimers.


Signature: Sumrit Kaur Date: Jan 25

Signature: \_\_\_\_\_ Date: \_\_\_\_\_

2019

# 36" Electric Cooktop

800 Series – Black with Stainless Steel Frame NET8668SUC

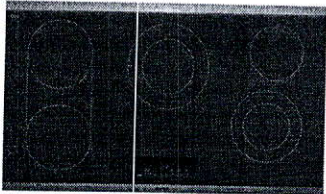

**NET8668SUC**  
Black with Stainless  
Steel Frame

Also available in:  
Frameless NET8668UC

The 800 Series electric cooktop is sleek in design, and features SpeedBoost® which adds even more power to speed up the cooking process.

### Features & Benefits

Bridge element accommodates oblong pans and many diameters of cookware.

Each zone's timer automatically shuts off when cooking is done.

SpeedBoost® offers shorter heat-up times for liquids.

PreciseSelect® offers 17 different direct cooking level settings.

Element Performance	
Power of Front Left heating element	1,800 W
Power of Back Left heating element	1,800 W
Power of Center heating element	3,600 / 1,400 W
Power of Back Right heating element	1,200 W
Power of Front Right heating element	1,900 / 800 W
Element Size	
Dimension of Front Left heating element	7"
Dimension of Back Left heating element	7"
Dimension of Center heating element	9", 6"
Dimension of Back Right heating element	6"
Dimension of Front Right heating element	8", 5"
Technical Details	
Watts	10,200 W
Circuit breaker	50 A
Volts	208-240 V
Frequency	60 Hz
Plug type	No plug
Energy source	Electric

Dimensions & Weight	
Overall appliance dimensions (HxWxD)	1/4" +4" x 37" x 21 1/4"
Required cutout size (HxWxD)	4" x 34 7/8" x 20"
Minimum distance from counter front	2 1/4"
Minimum distance from rear wall	2"
Net weight	37 lbs
Accessories – Optional	



**HEZ390210**  
8" AutoChef® pan



**HEZ390220**  
9" AutoChef® pan



**HEZ390230**  
10" AutoChef® pan



**Accessories:** To purchase Bosch accessories, cleaners & parts please visit [www.bosch-home.com/us/store](http://www.bosch-home.com/us/store) or call 1-800-944-2904 (Mon to Fri 5 am to 6 pm PST, Sat 6 am to 3 pm PST).  
**Notes:** All height, width and depth dimensions are shown in inches. BSH reserves the absolute and unrestricted right to change product materials and specifications, at any time, without notice. Consult the product's installation instructions for final dimensional data and other details prior to making cutout.

**Warranties:** Please see Use & Care manual or Bosch website for statement of limited warranty.

For more information on our entire line of products, go to [www.bosch-home.com/us](http://www.bosch-home.com/us) or call 1-800-944-2904

© BSH Home Appliances Corporation. All rights reserved. Bosch is a registered trademark of Robert Bosch GmbH.

# 36" Electric Cooktop


800 Series – Black with Stainless Steel Frame NET8668SUC



**BOSCH**

Invented for life


## Installation Details

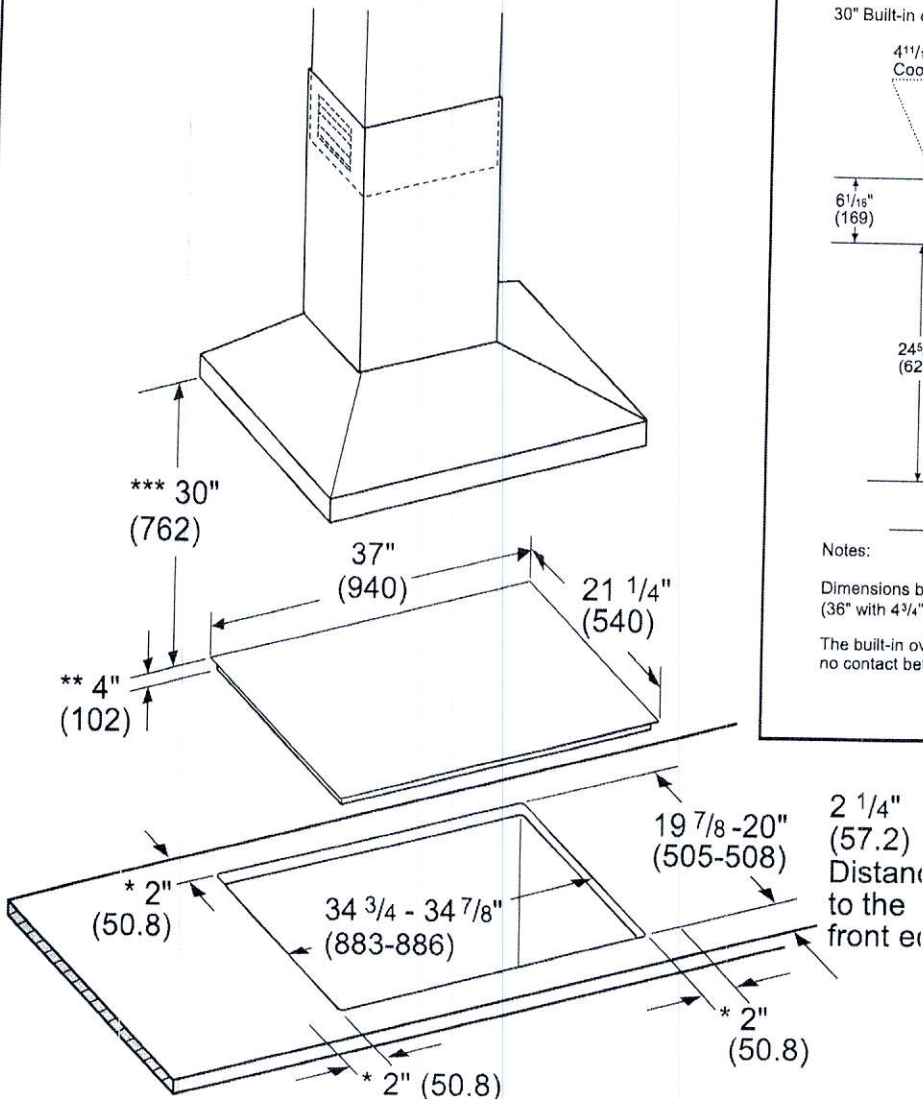

- \* Minimum distance from the cooktop cutout to the wall
- \*\* Maximum cutout depth
- \*\*\* Minimum distance between the cooktop surface and

## Installation above Wall Ovens

30" Built-in oven – under electric cooktop

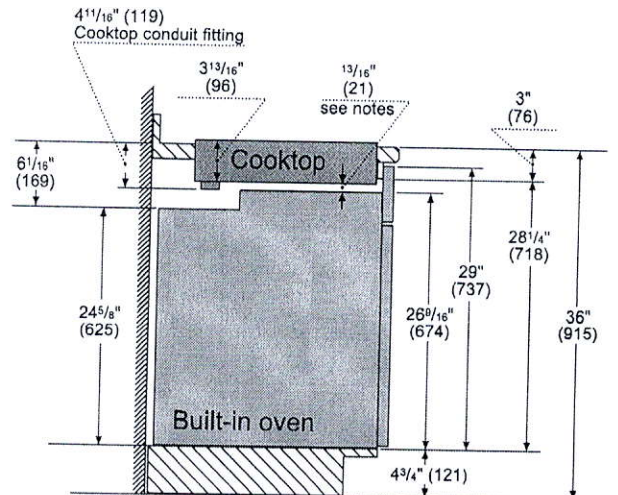


Notes:

Dimensions based on standard countertop height (36" with 4 3/4" toe kick including base plate).

The built-in oven can be installed below the electric cooktop as long as there is no contact between the bottom of the cooktop and the top of the oven.

measurements in inches (mm)

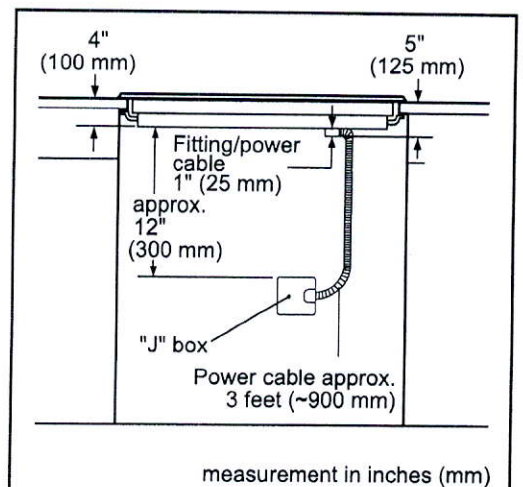

measurement in inches (mm)

**Accessories:** To purchase Bosch accessories, cleaners & parts please visit [www.bosch-home.com/us/store](http://www.bosch-home.com/us/store) or call 1-800-944-2904 (Mon to Fri 5 am to 6 pm PST, Sat 6 am to 3 pm PST).

**Notes:** All height, width and depth dimensions are shown in inches. BSH reserves the absolute and unrestricted right to change product materials and specifications, at any time, without notice. Consult the product's installation instructions for final dimensional data and other details prior to making cutout.

**Warranties:** Please see Use & Care manual or Bosch website for statement of limited warranty.

**For more information on our entire line of products, go to [www.bosch-home.com/us](http://www.bosch-home.com/us) or call 1-800-944-2904**

© BSH Home Appliances Corporation. All rights reserved. Bosch is a registered trademark of Robert Bosch GmbH.



07/18

# 30" Speed Combination Oven

Benchmark® Series – Stainless Steel HBLP752UC



## Installation Details

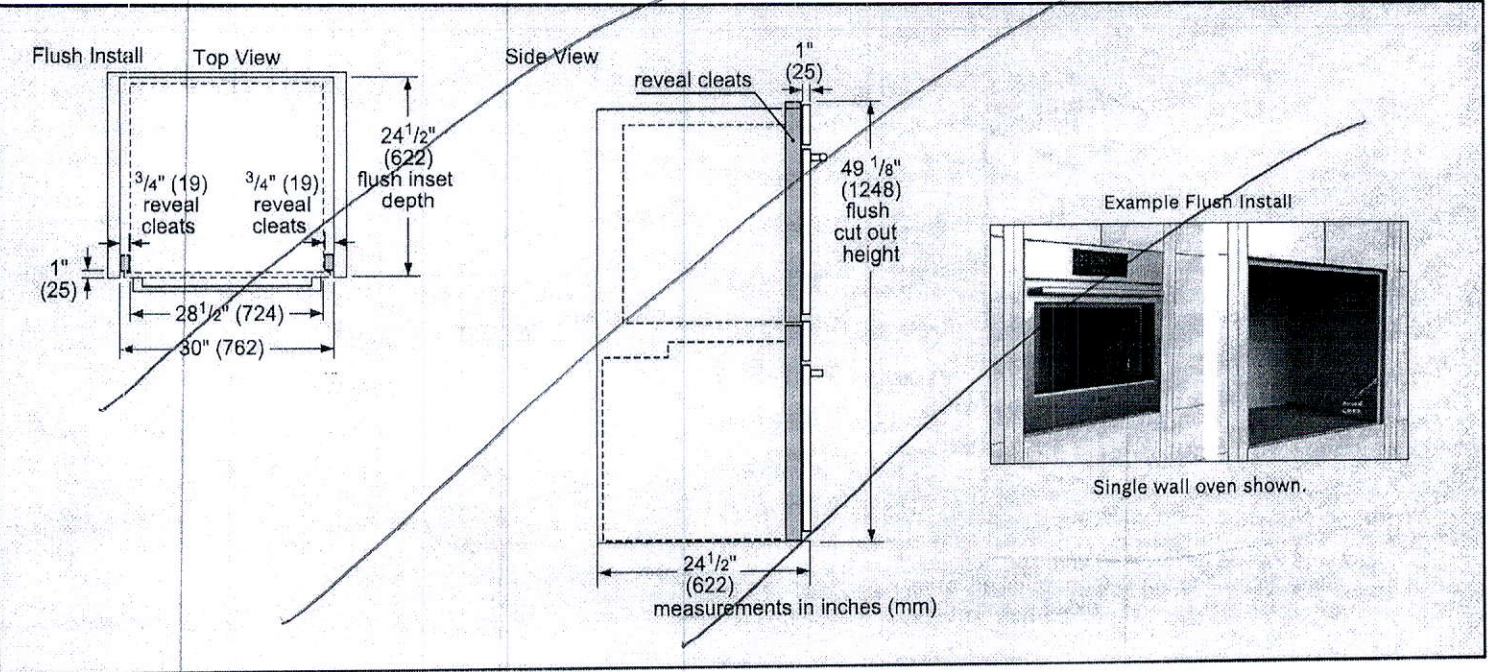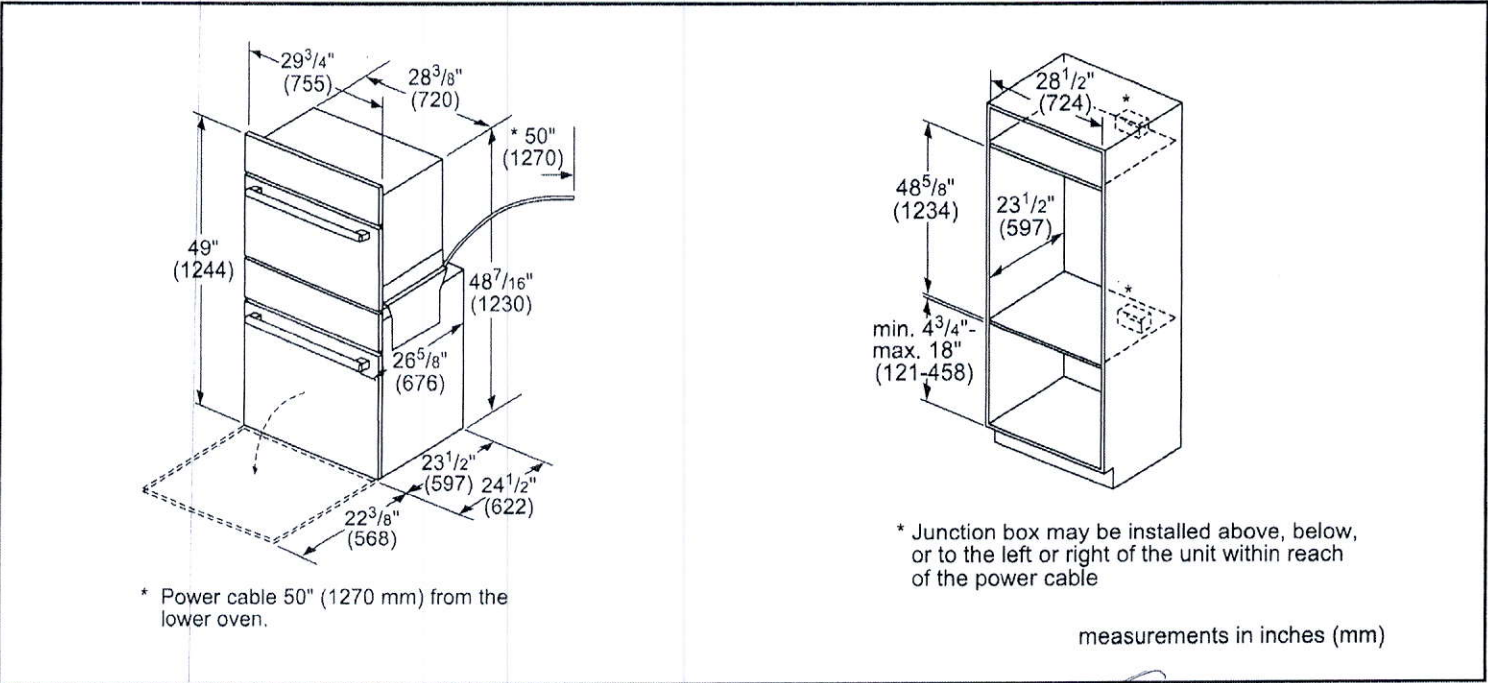

**Accessories:** To purchase Bosch accessories, cleaners & parts please visit [www.bosch-home.com/us/store](http://www.bosch-home.com/us/store) or call 1-800-944-2904 (Mon to Fri 5 am to 6 pm PST, Sat 6 am to 3 pm PST).

**Notes:** All height, width and depth dimensions are shown in inches. BSH reserves the absolute and unrestricted right to change product materials and specifications, at any time, without notice. Consult the product's installation instructions for final dimensional data and other details prior to making cutout.

**Warranties:** Please see Use & Care manual or Bosch website for statement of limited warranty.

**For more information on our entire line of products, go to [www.bosch-home.com/us](http://www.bosch-home.com/us) or call 1-800-944-2904**

© BSH Home Appliances Corporation. All rights reserved. Bosch is a registered trademark of Robert Bosch GmbH.


# 30" Speed Combination Oven

Benchmark® Series – Stainless Steel HBLP752UC


**BOSCH**  
Invented for life

## Installation Details

Side-by-Side Installation

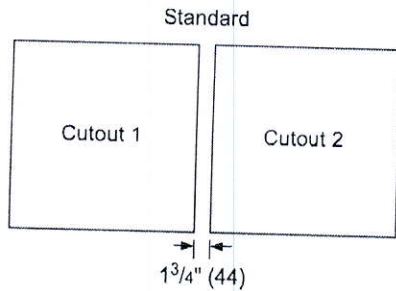

Flush

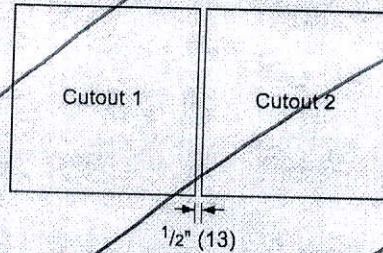


The ovens will overlap the cutout resulting in a 1/2" (13) spacing between the products

**IMPORTANT:** The spacing between cutouts applies when installing any BOSCH 30" or 27" single, double, combination and 27"/30" compact oven in a side-by-side installation.

Measurements in inches (mm)

Standard Installation  
Combination Oven over Storage or Warming Drawer

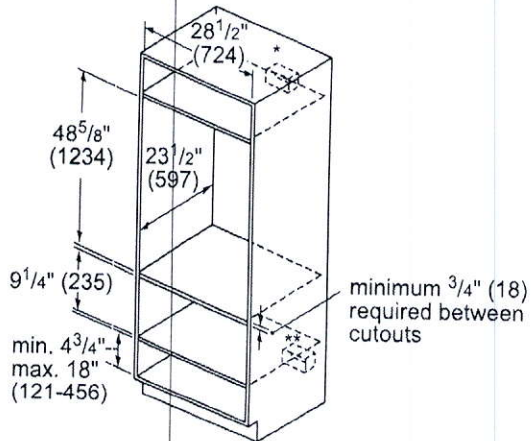


\*Wall oven junction box may be located above or right or left of the unit within reach of the power conduit.

\*\*Electrical hook up may be located below (depending on space) or next to the drawer within the reach of the power cord.

Measurements in inches (mm)

Flush Installation  
Combination Oven over Storage or Warming Drawer

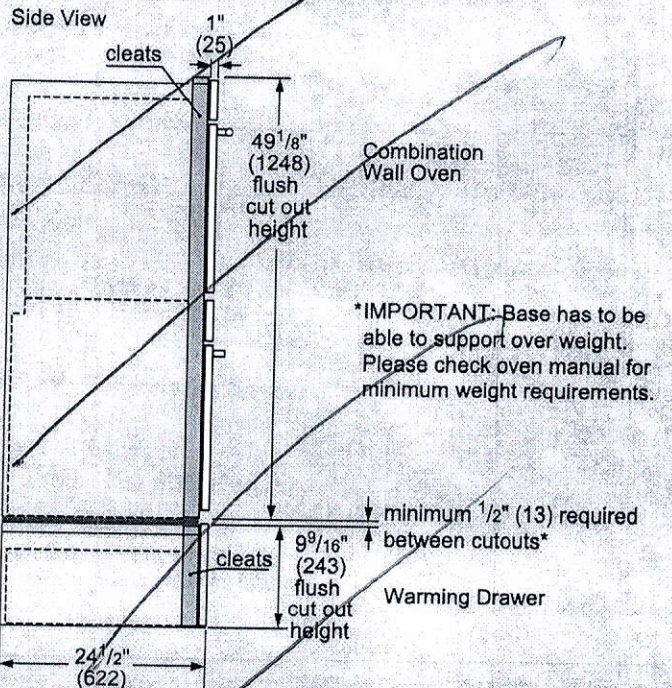

**\*IMPORTANT:** Base has to be able to support over weight. Please check oven manual for minimum weight requirements.

Measurements in inches (mm)

**Accessories:** To purchase Bosch accessories, cleaners & parts please visit [www.bosch-home.com/us/store](http://www.bosch-home.com/us/store) or call 1-800-944-2904 (Mon to Fri 5 am to 6 pm PST, Sat 6 am to 3 pm PST).  
**Notes:** All height, width and depth dimensions are shown in inches. BSH reserves the absolute and unrestricted right to change product materials and specifications, at any time, without notice. Consult the product's installation instructions for final dimensional data and other details prior to making cutout.  
**Warranties:** Please see Use & Care manual or Bosch website for statement of limited warranty.






For more information on our entire line of products, go to [www.bosch-home.com/us](http://www.bosch-home.com/us) or call 1-800-944-2904

© BSH Home Appliances Corporation. All rights reserved. Bosch is a registered trademark of Robert Bosch GmbH.


08/18


FEB 8 19 FB

**THIS LAYOUT CONTAINS EXTRAS  
THAT ARE NOT PART OF CONTRACT**

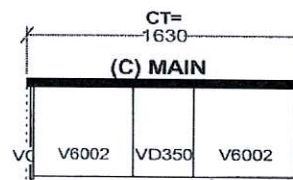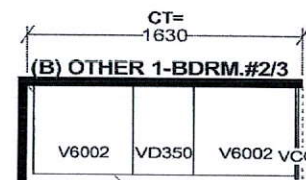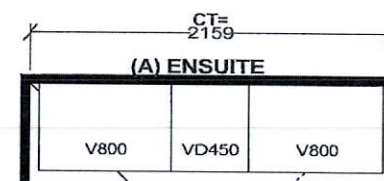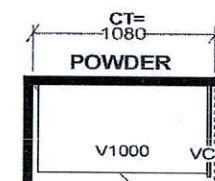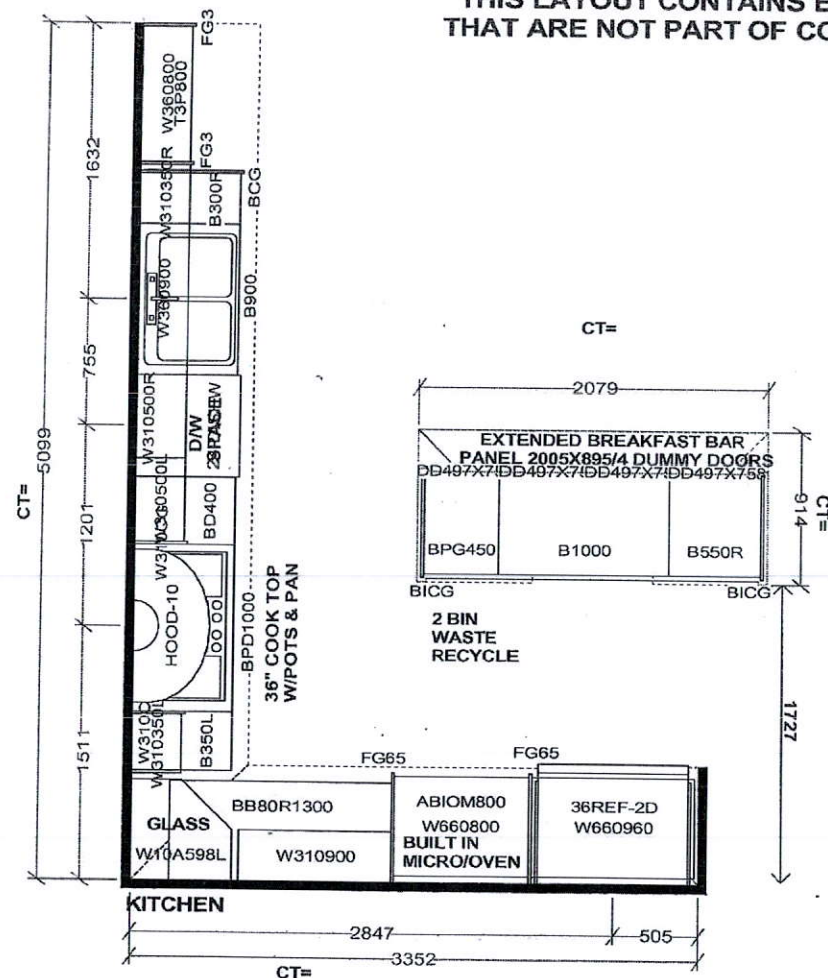

Selba Industries

W W DTH	W H GHT	W CNT	FL H GHT	DWY H	ST CENT	2X4	VENT BOX COVER
STANDARD FEATURES:				<i>This drawing is the Intellectual property of SELBIA INDUSTRIES INC. and is an original design which must not be reused or copied unless applicable fee has been paid or job order placed.</i>		<b>JOB NUMBER:</b> <b>BUILDER:</b> GREENPARK <b>SITE NAME:</b> MINNISALE, Brampton <b>MODEL:</b> SANDSTONE 2X4 OPT 5 BORM EL 1,2 <b>LOT #:</b> 20 PH2 <b>DESIGNER:</b> KS <b>DATE:</b> AUG 8 18	
<b>1040MM HIGH UPPERS</b> <b>DISHWASHER SPACE</b> <b>DUMMY DOORS ON EXPOSED BACKS</b> <b>LAMINATE COUNTERTOPS</b>							

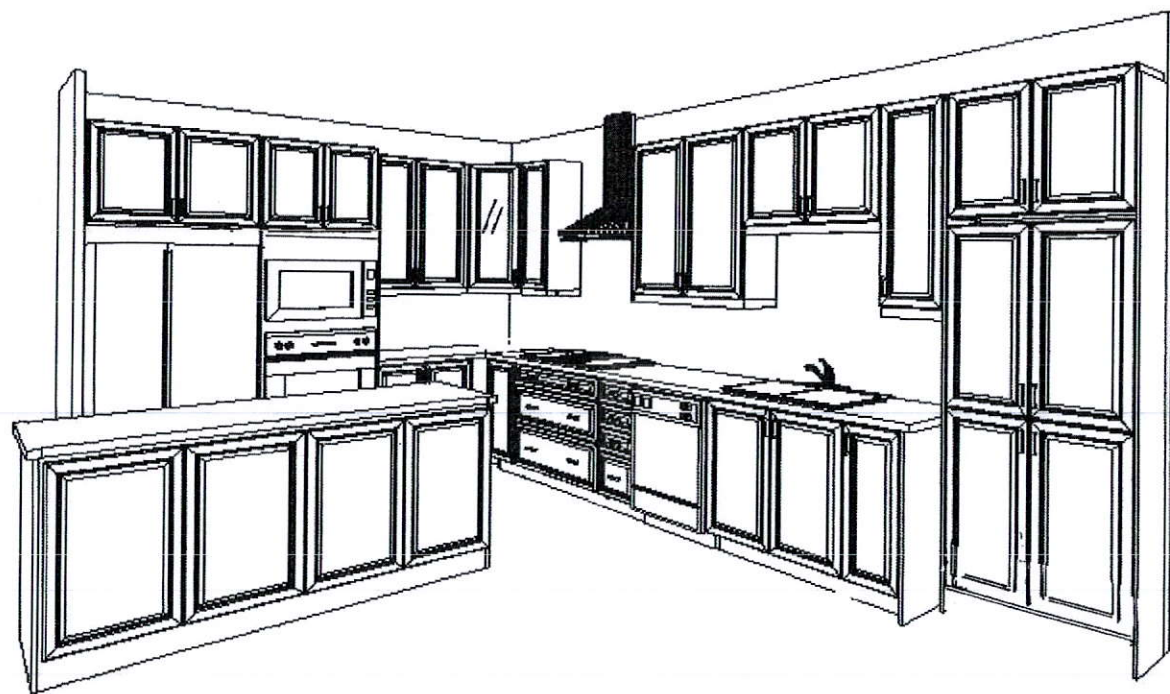


This drawing is the intellectual property of SELBA INDUSTRIES INC. and is an artistic interpretation of the general appearance of the design. It is not meant to be an exact rendition.



Designed: 2/8/2019  
Printed: 2/8/2019

MINNISALES LOT 20

MINNISALES LOT 20 P112.kit Drawing #: 1

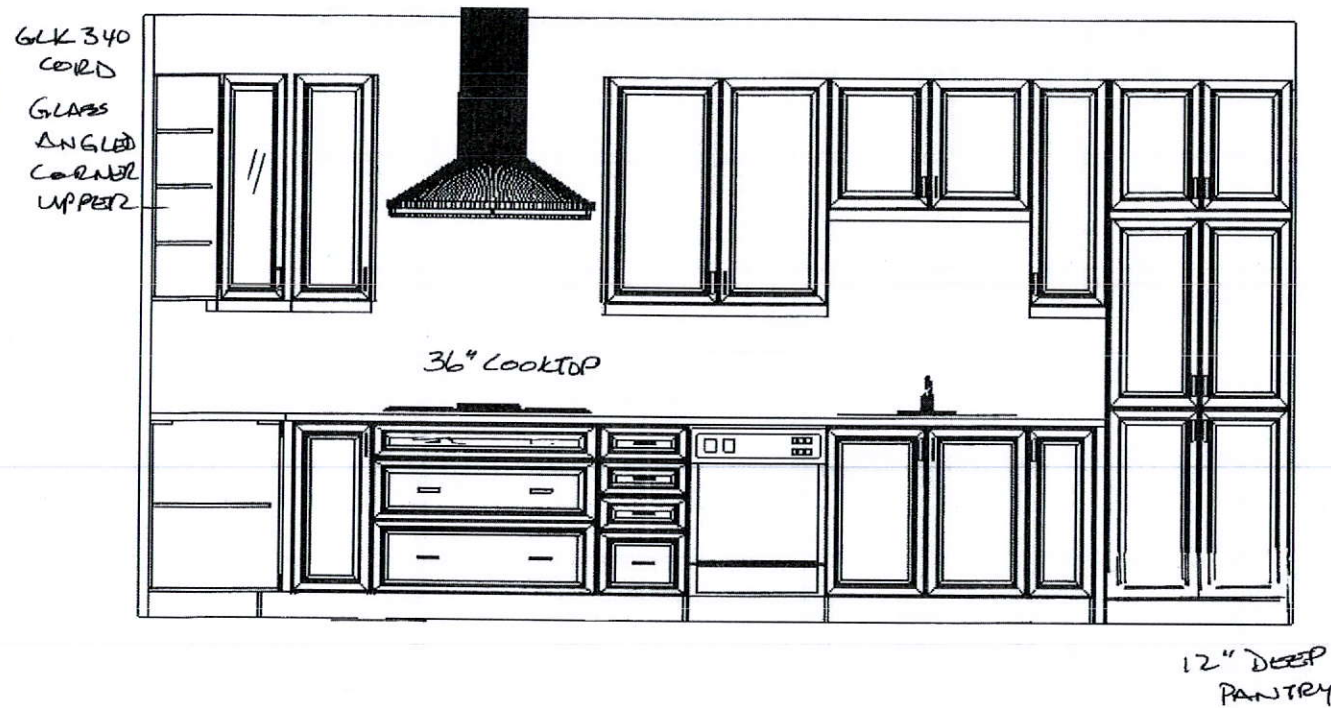

This drawing is the intellectual property of SELBA INDUSTRIES INC. and is an artistic interpretation of the general appearance of the design. It is not meant to be an exact rendition.

**Selba**  
Kitchen + Bath Designs

Designed: 2/8/2019  
Printed: 2/8/2019

MINNISALES LOT 20

MINNISALES LOT 20 PH2.kit Drawing #: 1

See Kitchen  
Sketch for  
Revised  
Layout

Plug above  
Fireplace

plumbing on this wall

Set to be on this wall

Frameless glass enclosure

Seat moved to other wall

→ Sent to be on this wall

Frameless glass

Festive Plug

