

CONSTRUCTION SUMMARY

Mountainview Heights (G) - Russell Gardens Building Ltd.

PURCHASERS: KRISTIN FRANCES NOBLE and LARRY DUONG

TEL:

LOT / PHASE Block 211 TH 3 / 2	REG. PLAN # 62M-1238	HOUSE TYPE Highgrove 2 Elev 3		
-----------------------------------	-------------------------	----------------------------------	--	--


ELECTRICAL

1 - POWDER ROOM - INSTALL STANDARD LIGHT ABOVE MIRROR ON WALL - AS PER SKETCH 03Apr19 Note:	
1 - FRONT PORCH - INSTALL STANDARD LIGHT AS PER SKETCH - IF CONSTRUCTION PERMITS 03Apr19 Note:	
1 - STANDARD DINING ROOM LIGHT TO BE CENTERED BETWEEN LIVING AND DINING ROOM - AS PER SKETCH 03Apr19 Note:	
1 - RELOCATE STANDARD KITCHEN LIGHT TO BE CENTERED OVER ISLAND 03Apr19 Note:	

This Document is Extremely Time Sensitive - Printed 3 Apr 19 at 12:58

# HIGHGROVE 2 1,796 SQ.FT.

AVAILABLE IN BLOCK: 200, 201, 202, 205, 206, 207, 208, 211, 216 & 217

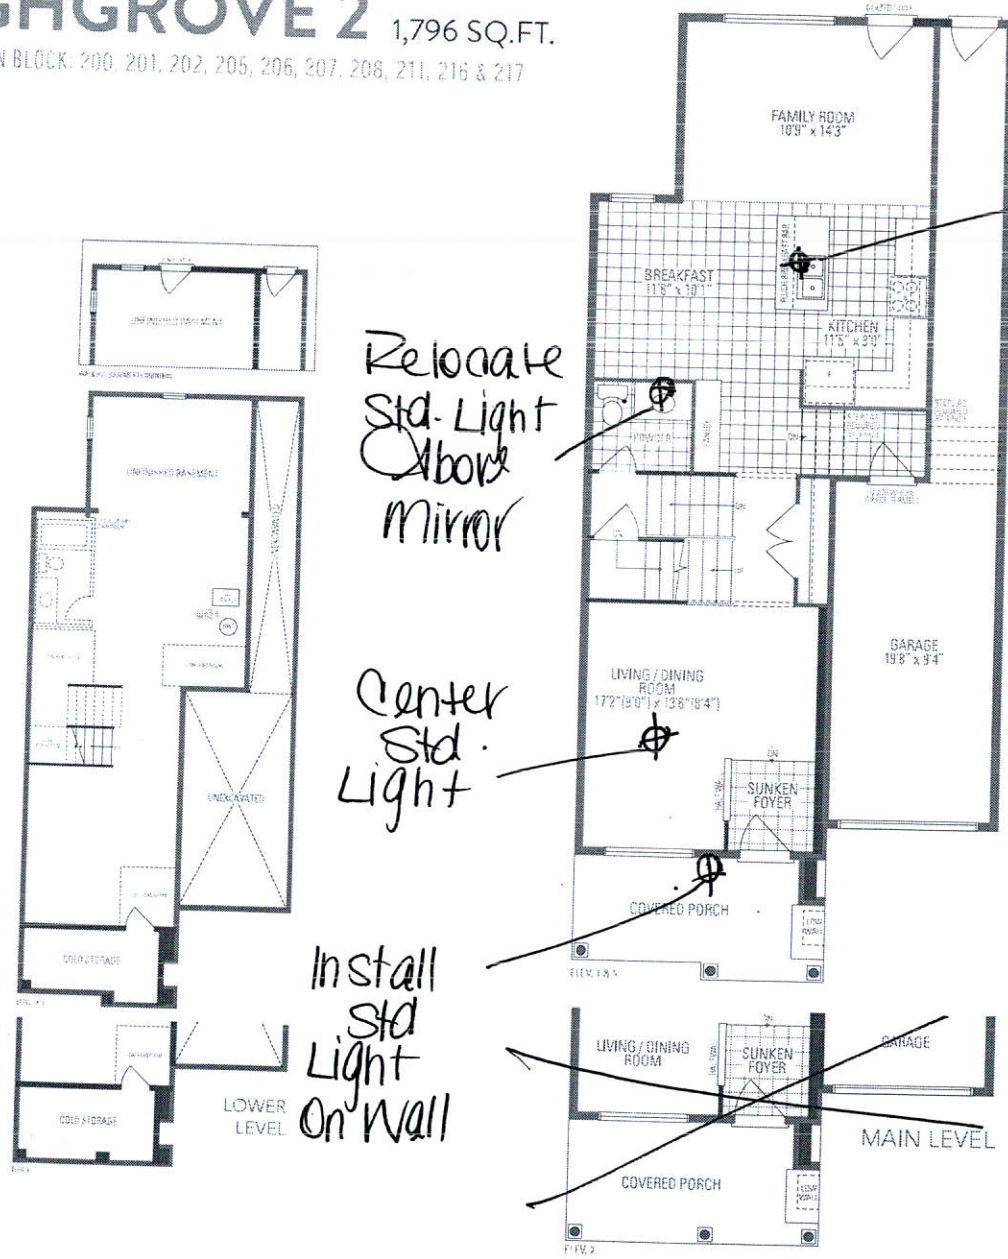


Relocate  
Std. Light  
Above  
Mirror

Install  
Std.  
Light  
Above  
Island

Center  
Std.  
Light

Install  
Std.  
Light  
On Wall

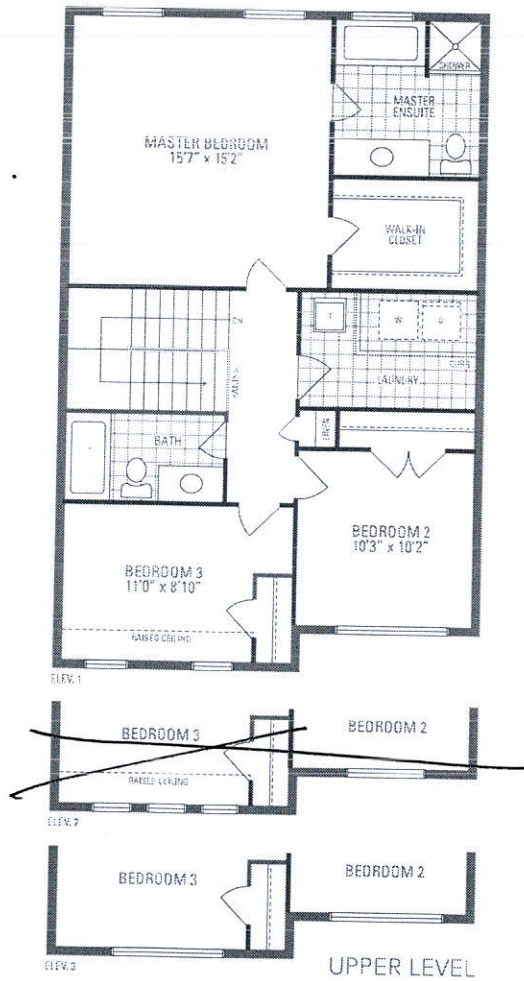

KN

LD

Prices may vary due to timing. E. & G.C. LLC Highgrove 1 • Copyright Sept. 2017

Orientation of home may be reversed and purchaser agrees to accept the same. Steps and porches may vary at any exterior entrance ways due to grading variance. Actual usable floor space may vary from the stated floor area. All renderings are artist's concept. Dimensions, specifications and architectural detailing subject to minor modifications. Final location of sump pump is based on site conditions. Roofline and adjoining model types may vary due to timing. E. & G.C. LLC Highgrove 2 • Copyright Sept. 2017