

WATER PIPE SIZING AND PLUMBING DATA SHEET
CERTIFIED MODEL WITH ONE DWELLING UNIT
THIS TABLE IS APPLICABLE FOR A HOUSE AFTER DECEMBER 31, 2017

 Builder Name: GREENPARK HOMES
 Certified Model Name: **MILLWOOD 12 - LOT 33**
 Optional Floor Layout:
 Application No.:

SWhite

The Ontario Building Code Div. B, 7.6.3 regulates size and capacity of pipes for a new house. Please enter the number of individual fixtures as listed and bathroom groups⁽⁶⁾ or powder room groups⁽⁷⁾ per floor. The fixture units and required minimum size of water service will automatically be calculated.


Description	Basement Floor	First Floor	Second Floor	Third Floor
	Qty.	Qty.	Qty.	Qty.
Bathroom group ⁽⁶⁾	1		3	
Bidet				
Extra Shower			1	
Lav			1	
Bar Sink				
Powder room ⁽⁷⁾		1		
Kitchen Sink		1		
Dishwasher		1		
Laundry Tub			1	
Washing Machine			1	
Hose Bib		2		

 Total Fixture Units **30**

 Minimum Diameter of Water Service Pipe
 Required from the Property Line to the
 House (Inch) **1**
Notes:

- (1) A potable water system shall be designed, constructed and installed to conform to good engineering practice appropriate to the circumstances, such as that described in the ASHRAE Handbooks and ASPE Data Books.
- (2) No water system between the point of connection with the water service pipe or the water meter and the first branch that supplies a water heater that serves more than one fixture shall be less than ¾ in. in size.
- (3) The minimum water pressure at the entry to the building is 200 kPa, and the total maximum length of the water system is 90 m.
- (4) In a hot water distribution system of a developed length of more than 30 m from the HWT to the farthest fixture or supplying more than 4 storeys, the water temperature shall be maintained by, (a) recirculation, or (b) a self-regulating heat tracing system.
- (5) Where piping may be exposed to freezing conditions, it shall be protected from the effects of freezing.
- (6) A bathroom group consists of 1 water closet, 1 lavatory, and 1 bathtub (with or without showerhead)
- (7) A powder room group consists of 1 water closet and 1 lavatory.

**PLEASE SEE
NOTES AS T
OF THE REV**

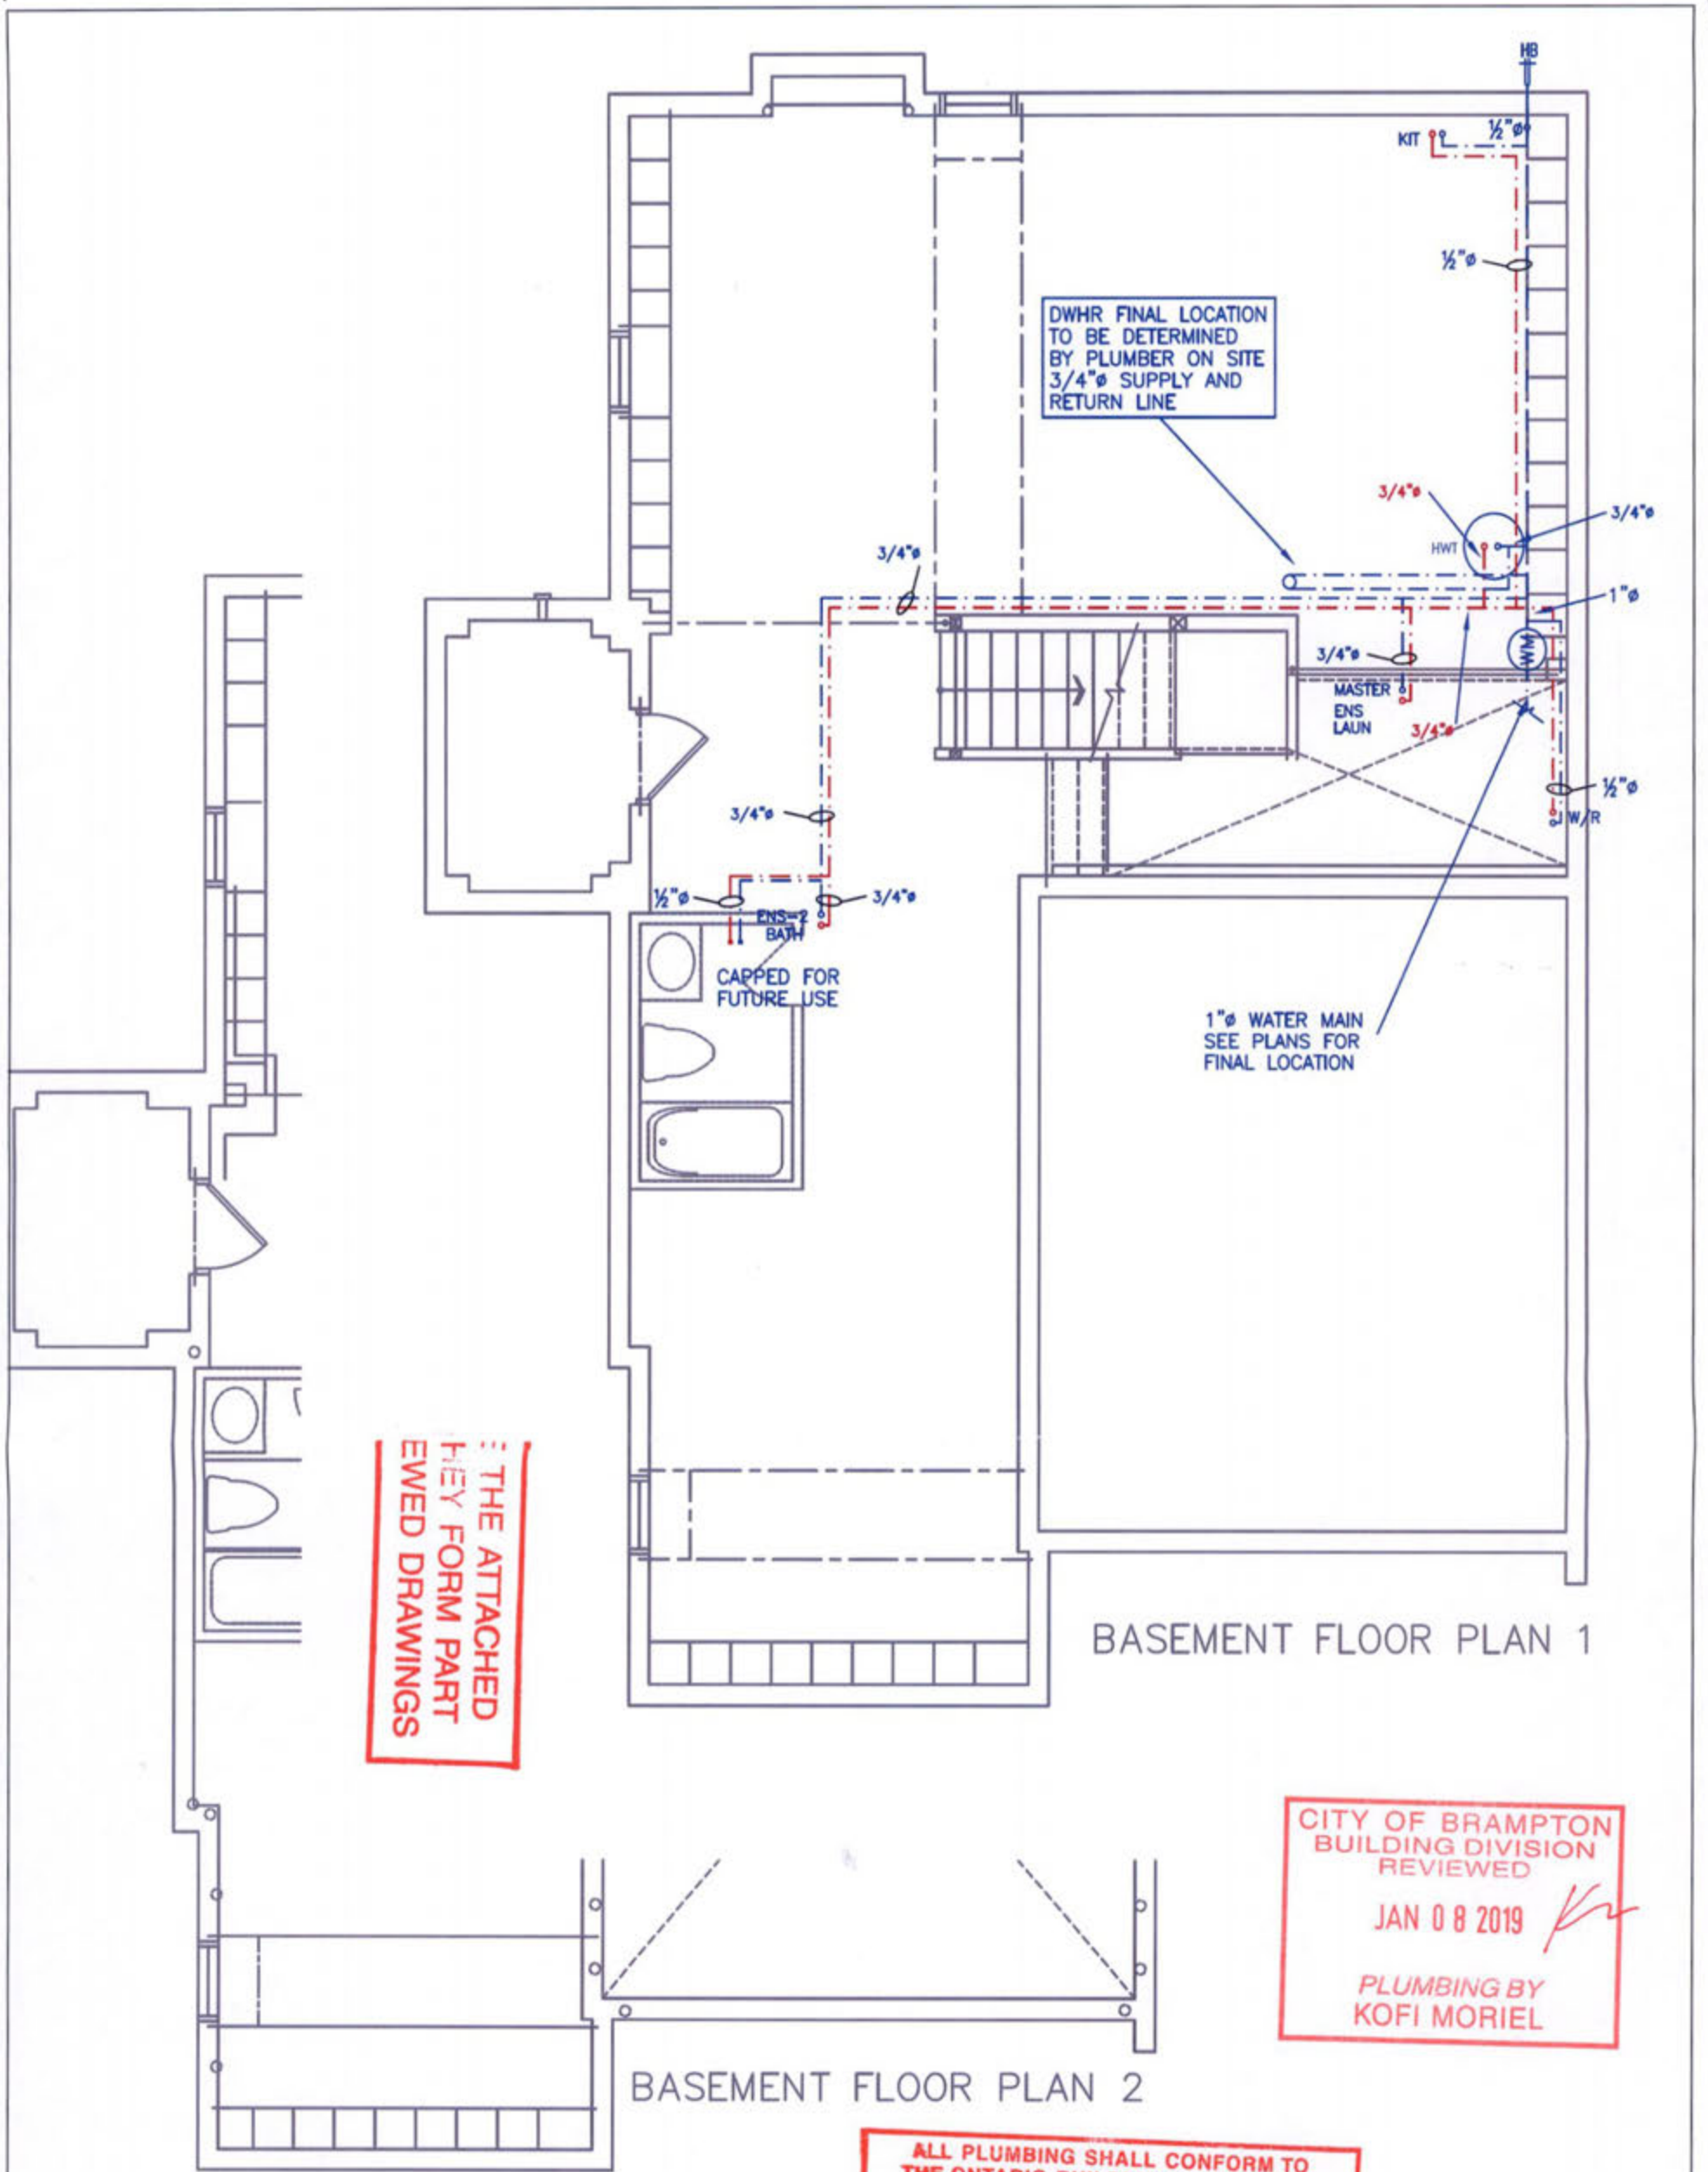

THE ATTACHED
PERMIT APPLICATION
IS THE PART
OF THE DRAWINGS

CITY OF BRAMPTON
BUILDING DIVISION
REVIEWED
JAN 08 2019
PLUMBING BY
KOFI MORIEL

ALL PLUMBING SHALL CONFORM TO
THE ONTARIO BUILDING CODE, O.REG.
332/12, AS AMENDED, DIVISION B, PART 7.

NOTES


1. DRAWINGS ARE TO BE PRINTED IN COLOUR
2. WHERE A 3/4" TUB SPOUT/ SPIGOT CONNECTION IS USED ON THE BATHTUB FAUCET THE WATER SUPPLY PIPE SHALL BE 3/4" TO THE BRANCH FOR THE BATHTUB
3. BASEMENT BATHROOM ROUGH-IN SHALL BE USED IN SIZING OF WATER PIPE
4. EXACT LOCATION OF ALL PLUMBING PIPING TO BE DETERMINED ON SITE

LEGEND

SYMBOL	DESCRIPTION (SEE PLAN FOR PIPE SIZING)
WM	WATER METER, PROVIDE SUPPLY PIPE SIZE/ Ø
HB	HOSE BIB
—	PROPOSED COLD WATER LINE & RISER
—	PROPOSED HOT WATER LINE & RISER
FD	FLOOR DRAIN



Client GREENAPRK HOMES	HVAO DESIGNS LTD. 375 Finley Ave. Suite 202 - Ajax, Ontario L1S 2E2 Tel. 905.619.2300 - 905.420.5300 Fax 905.619.2375 Email: info@hvadesigns.ca Web: www.hvadesigns.ca Specializing in Residential Mechanical Design Services	Sheet Title BASEMENT PLUMBING LAYOUT
Project Name Lot 33 MINNISALE HOMES CORP BRAMPTON, ONTARIO		Date AUGUST 2018 Scale 3/16" = 1'-0"
MILLWOOD 12 2642 sqft		LO# 79588

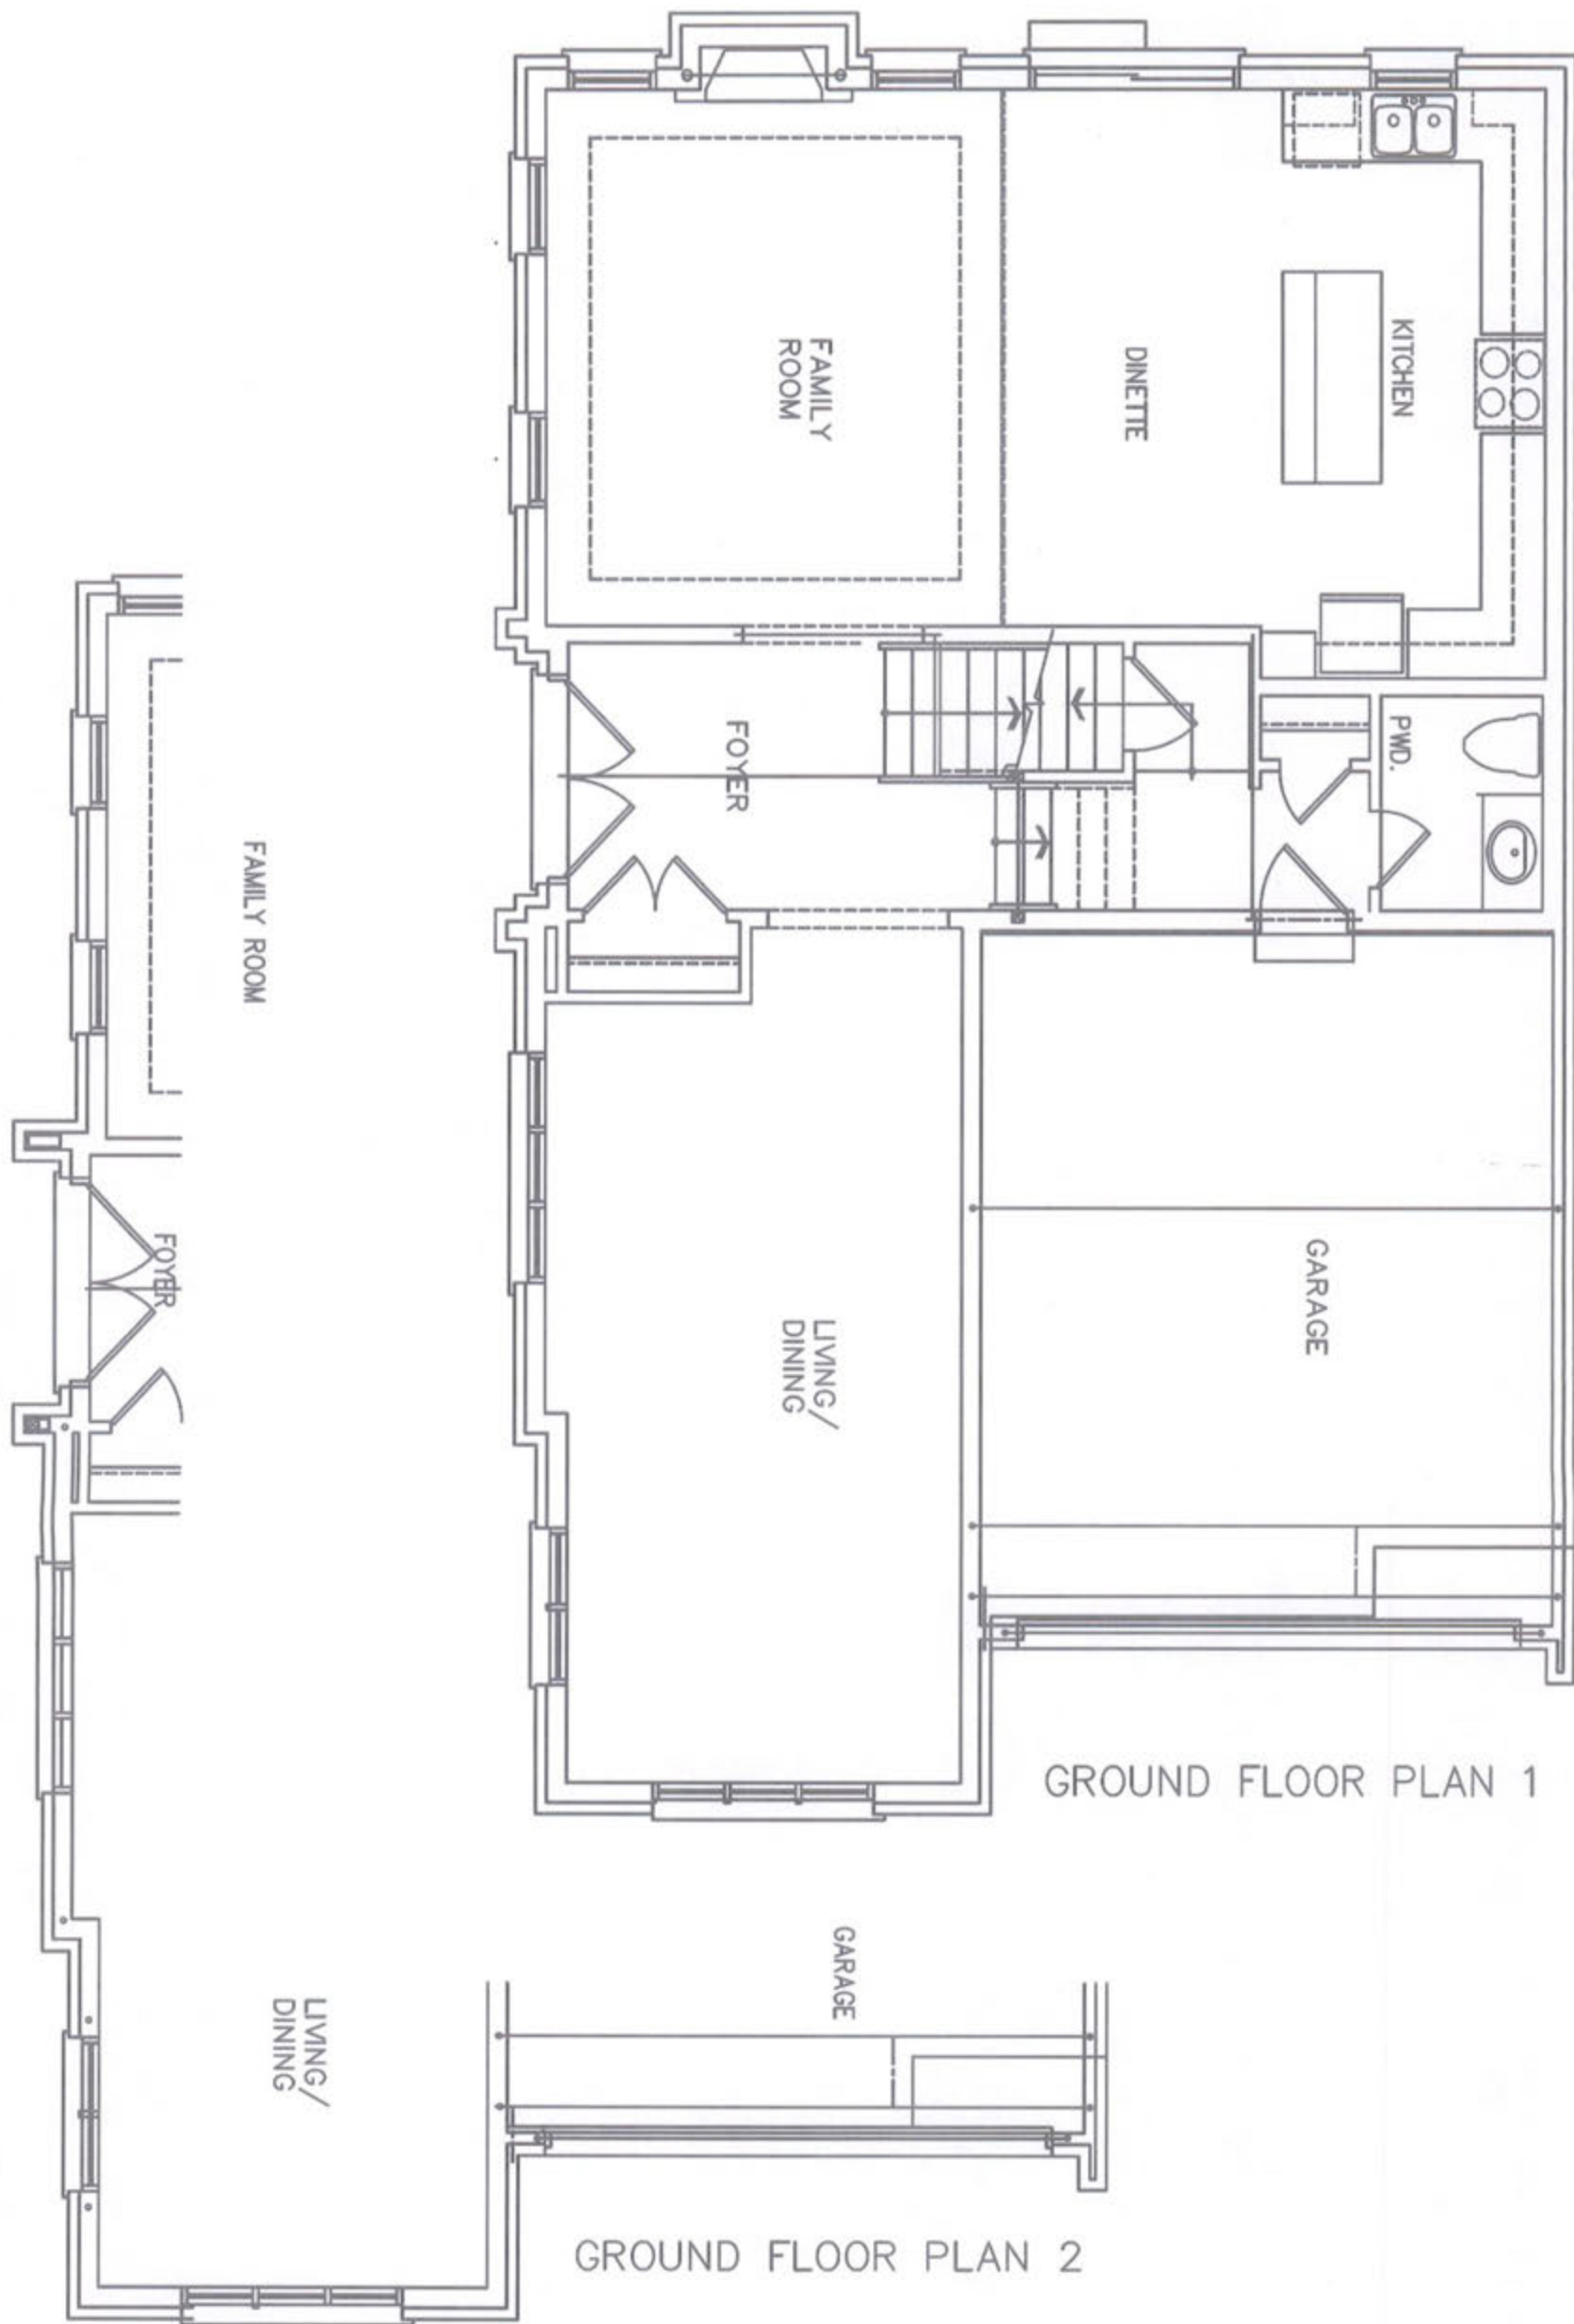


CITY OF BRAMPTON
BUILDING DIVISION
REVIEWED

JAN 08 2019

PLUMBING BY
KOFI MORIEL



<div>Client</div> <div>GREENAPRK HOMES</div> <div>Project Name</div> <div>LOT 33</div> <div>MINNISALE HOMES CORP BRAMPTON, ONTARIO</div> <div>MILLWOOD 12 2642 sqft</div>	<div> HVACDESIGNS LTD. 375 Finley Ave. Suite 202 - Ajax, Ontario L1S 2E2 Tel. 905.619.2300 - 905.420.5300 Fax 905.619.2375 Email: info@hvacdesigns.ca Web: www.hvacdesigns.ca Specializing in Residential Mechanical Design Services </div>	<div>Sheet Title</div> <div>FIRST FLOOR PLUMBING LAYOUT</div> <div>Date</div> <div>AUGUST 2018</div> <div>Scale</div> <div>3/16" = 1'-0"</div> <div>LO#</div> <div>79588</div>
--	---	--

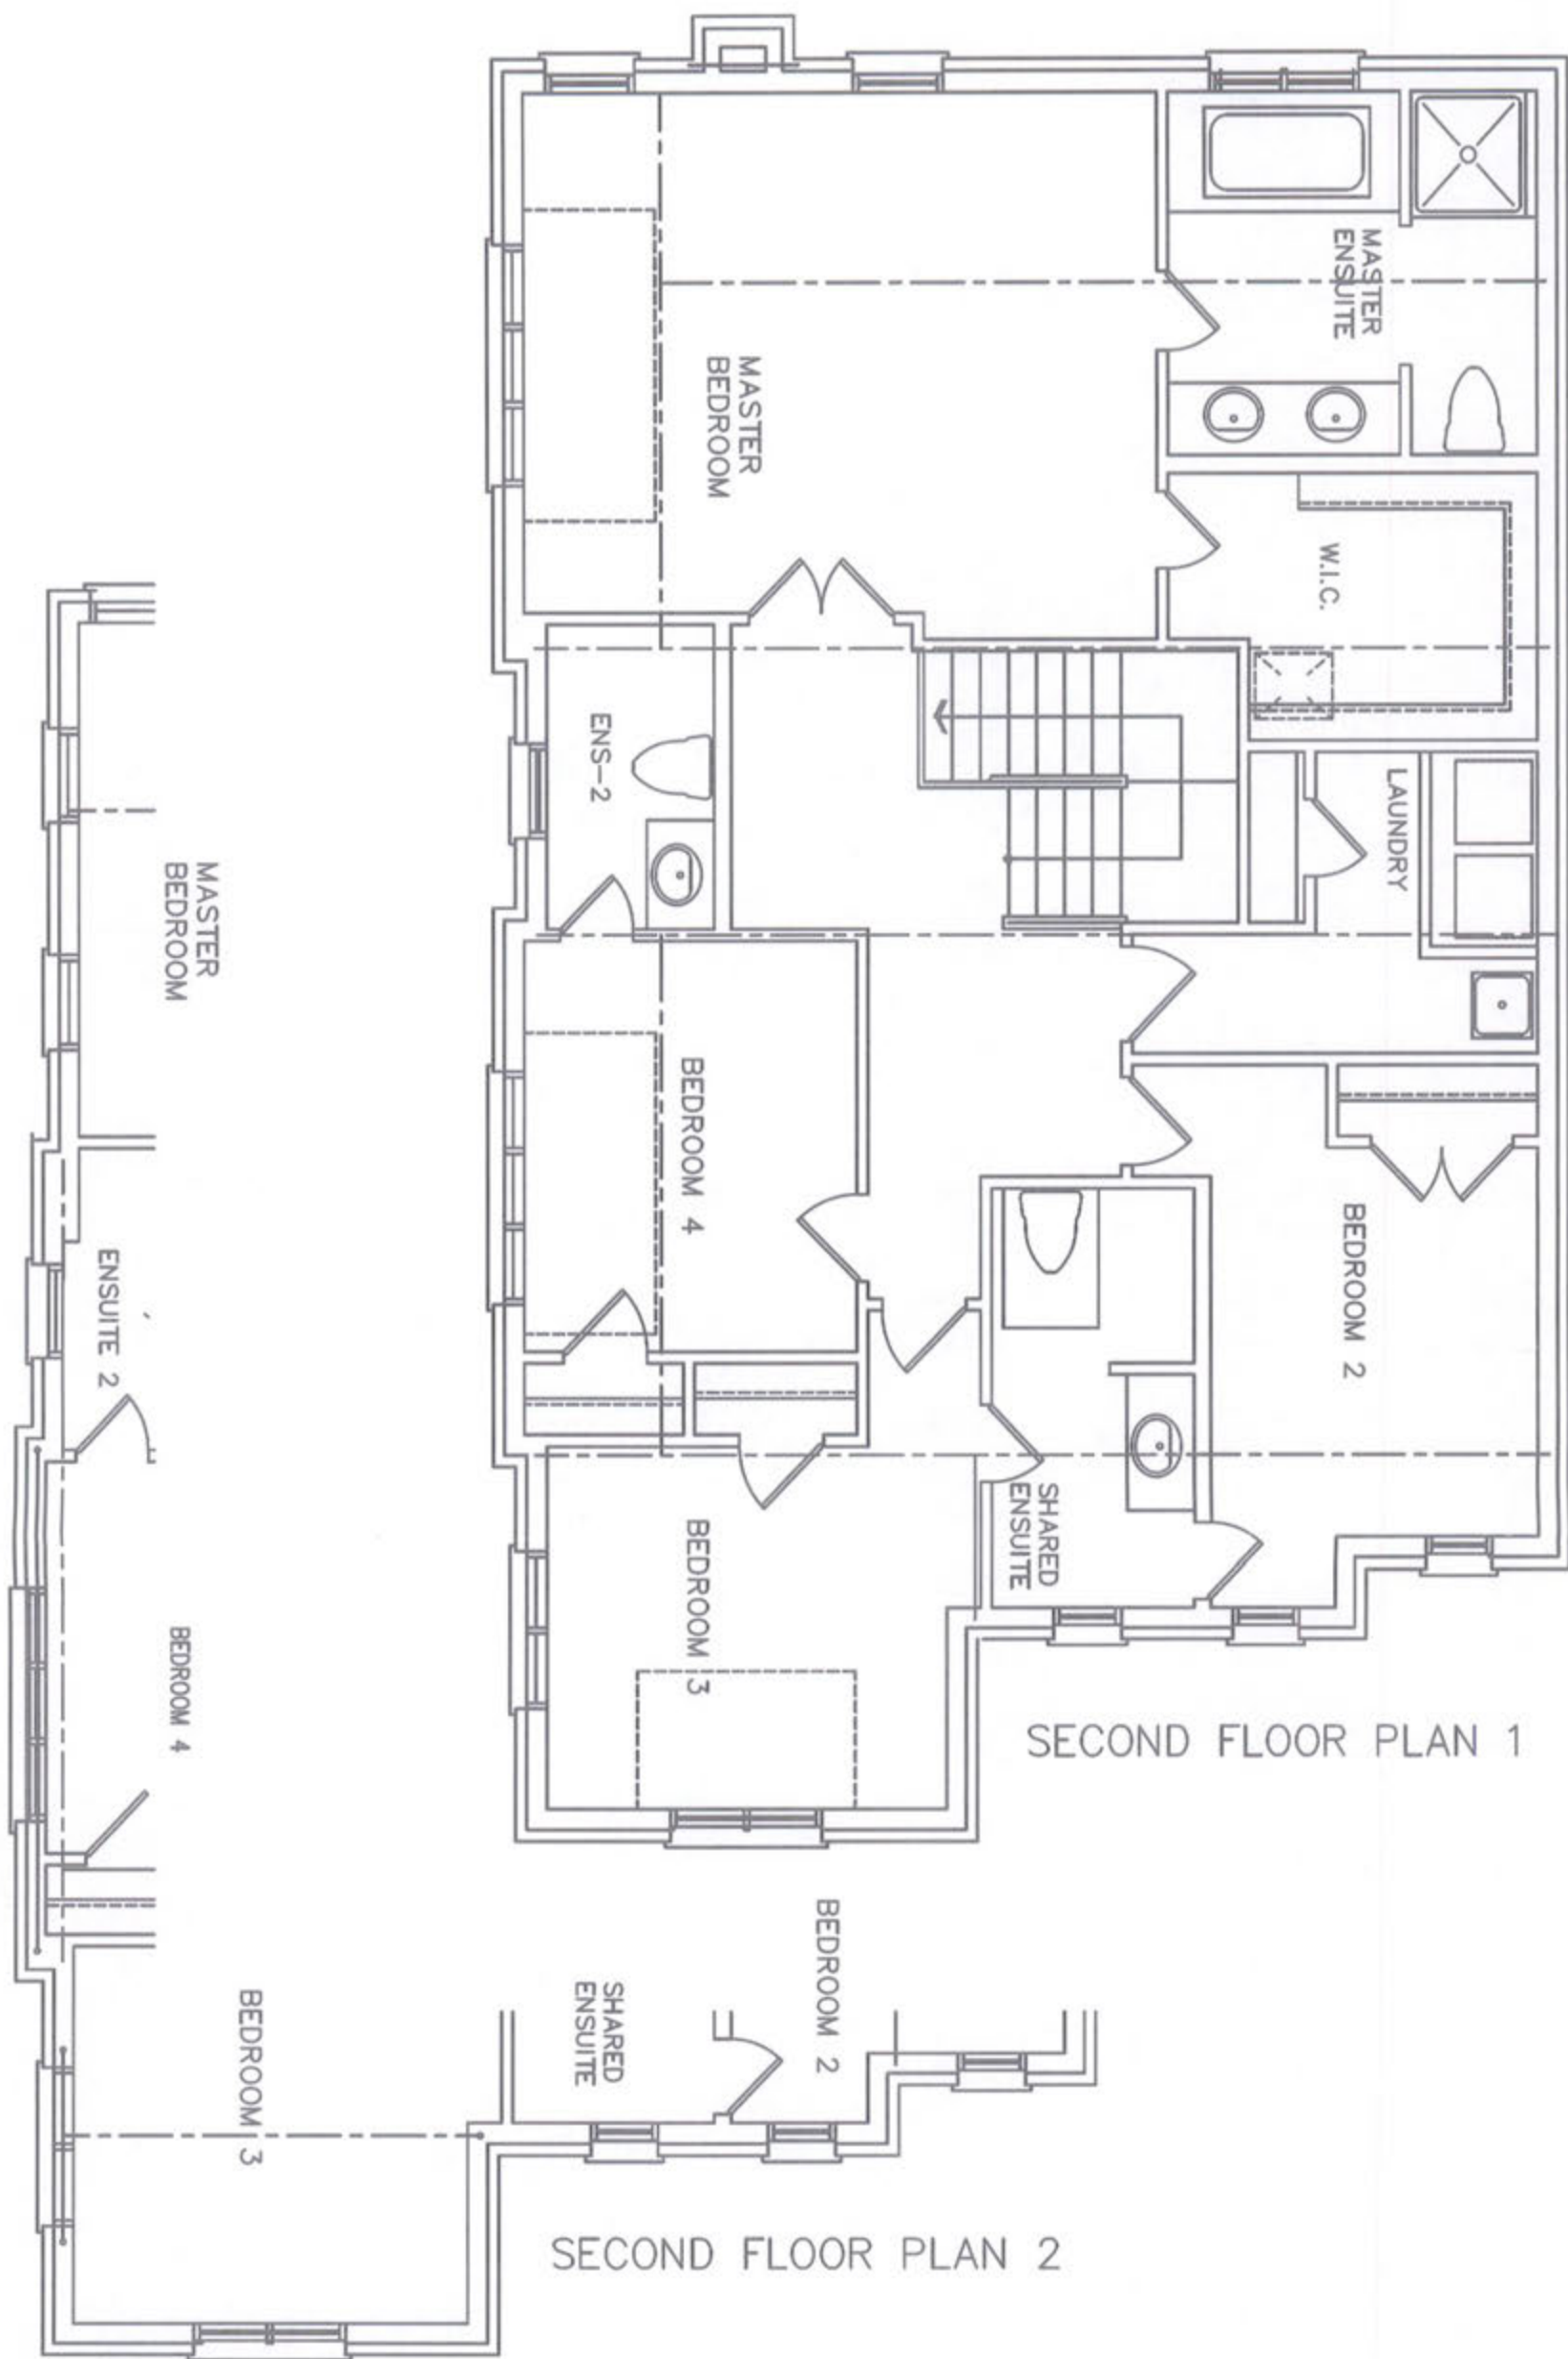

CITY OF BRAMPTON
BUILDING DIVISION
REVIEWED
JAN 08 2019
PLUMBING BY
KOFI MORIEL



Client
GREENAPRK HOMES

Project Name
LOT 33
MINNISALE HOMES CORP
BRAMPTON, ONTARIO

MILLWOOD 12 2642 sqft

HVACDESIGNS LTD.

375 Finley Ave. Suite 202 - Ajax, Ontario
L1S 2E2 Tel. 905.619.2300 - 905.420.5300 Fax 905.619.2375
Email: info@hvacdesigns.ca
Web: www.hvacdesigns.ca
Specializing in Residential Mechanical Design Services

Sheet Title
SECOND FLOOR
PLUMBING
LAYOUT

Date
AUGUST 2018

Scale
3/16" = 1'-0"

LO# 79588