

CONSTRUCTION SUMMARY

Mountainview Heights (G) - Russell Gardens Building Ltd.

RECEIVED MAY 16 2019

PURCHASERS: MAXWELL DABANKAH and FELICIA O AKUOKO

TEL: RES.: 289-795-0591

LOT / PHASE 199 / 2	REG. PLAN # 62M-1238	HOUSE TYPE Rosewood 1A Elev 3		
------------------------	-------------------------	----------------------------------	--	--

ELECTRICAL

1 - PLUG - ELECTRICAL PLUG - TO BE INSTALLED OVER FIREPLACE 16May19 Note:	
1 - ABOVE KITCHEN ISLAND - ADD LIGHT AND SWITCH - NO FIXTURE INCLUDED 16May19 Note:	
1 - RELOCATE STANDARD KITCHEN LIGHT TO BE OVER ISLAND 16May19 Note:	
1 - PLUG - ELECTRICAL PLUG WITH GFI AND SWITCH - FOR FESTIVE LIGHTING 16May19 Note:	
3 - POT LIGHT - LED - FIRST FLOOR INSTALLATION 16May19 Note:	
5 - POT LIGHT - EXTERIOR - SOFFIT MOUNT - REGULAR VOLTAGE 16May19 Note:	
1 - 200 AMP ELECTRICAL SERVICE 16May19 Note:	




PROMOTIONAL

1 - PARTIAL REDEMPTION OF PROMOTIONAL PACKAGE \$3,460 BALANCE FORWARD \$16,540 TO BE USED AT A LATER DATE. ORIGINAL PROMOTIONAL PACKAGE OF \$20,000 AS PER SCHEDULE PE 16May19 Note:	
---	--

EXTRAS AS PER OFFER

The Vendor agrees that notwithstanding any other term or provision in this Agreement included in the Purchase Price and in addition to those items detailed in Schedule GP to the Agreement of Purchase and Sale, the Purchaser is entitled to a credit of Two Worksheet Note:	
The Purchaser acknowledges that the Purchase Price is inclusive of all credits and promotional packages available at the time of purchase. Worksheet Note:	

This Document is Extremely Time Sensitive - Printed 16 May 19 at 15:04

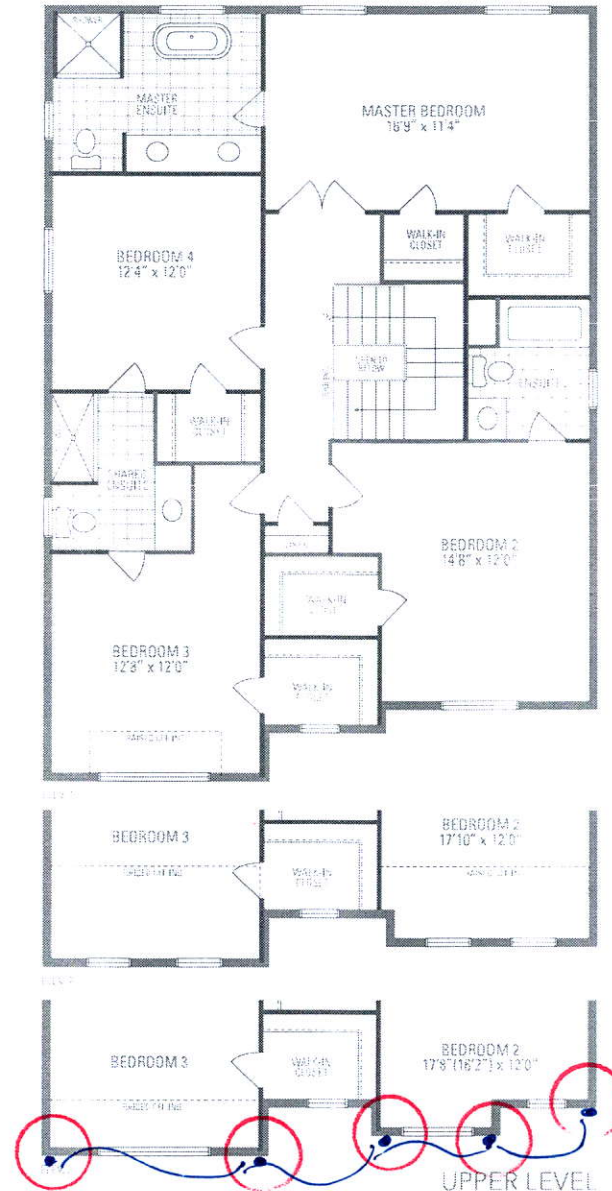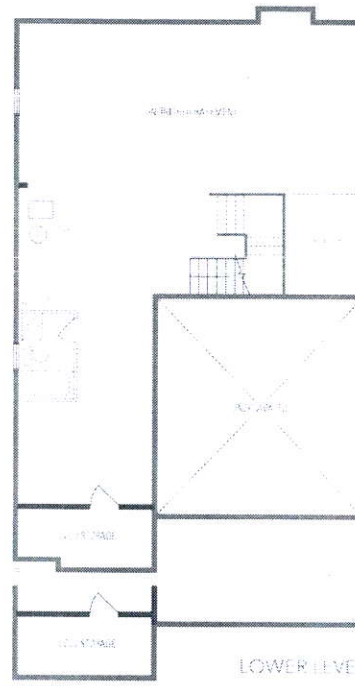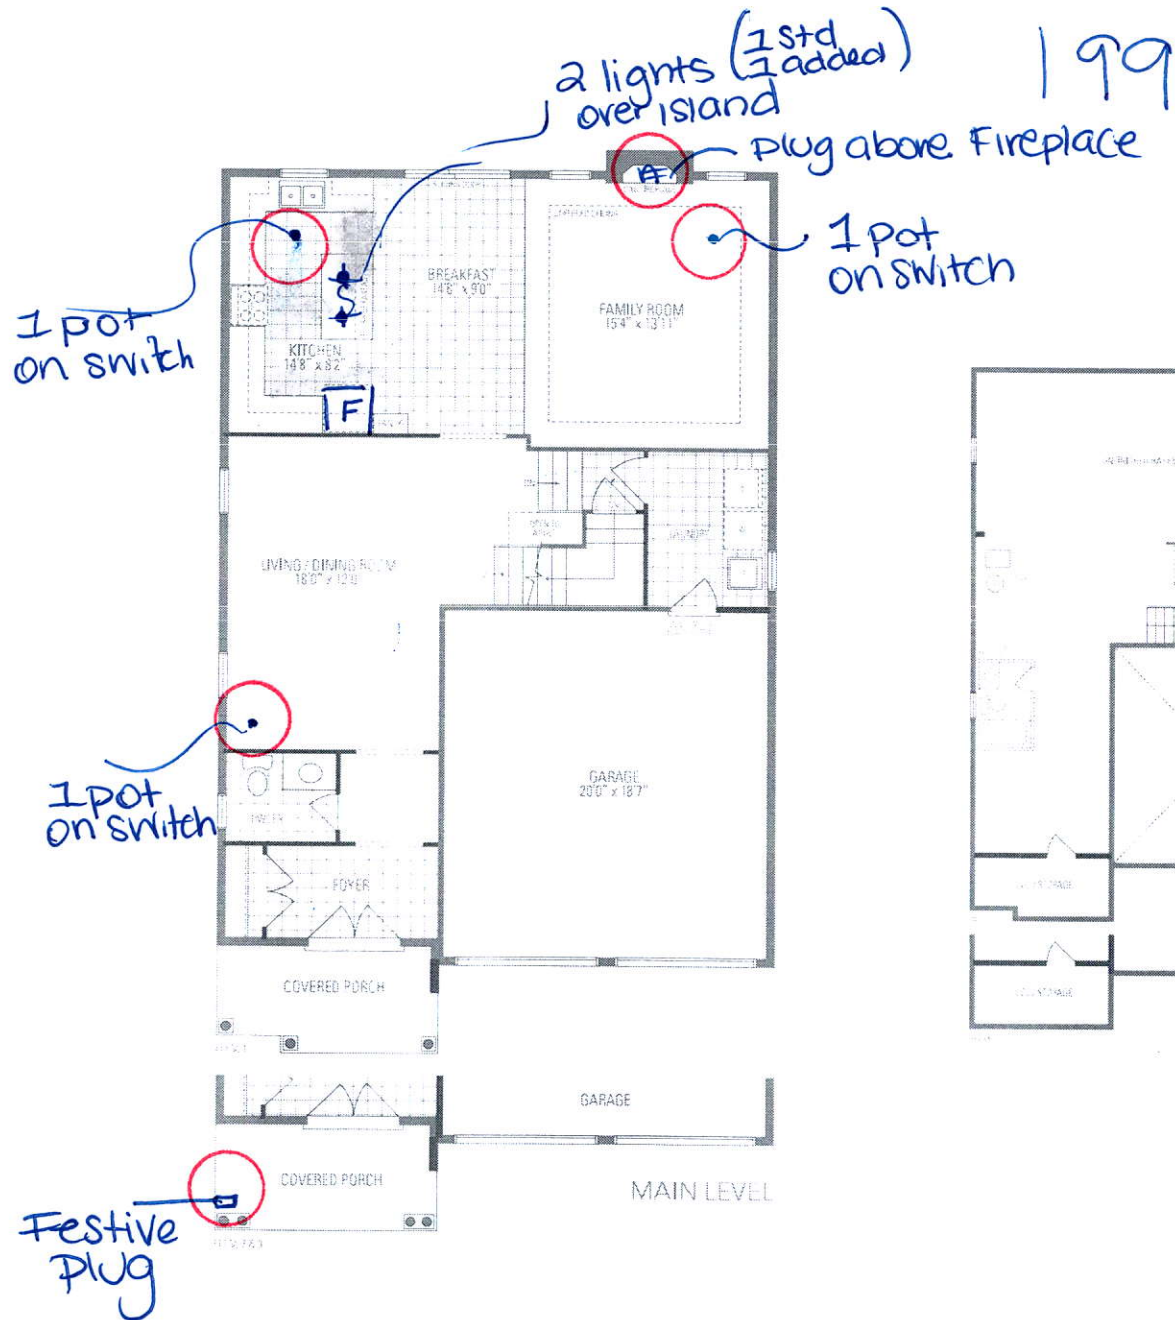

5 exterior
pots on
1 switch

ROSEWOOD 1A
2,572 sq.ft. includes 10 sq.ft. of open area

Read and understand drawings to accept the same. Steps and porches may vary. All exterior entrance ways due to grading variance. Actual usable floor space may vary from the stated floor area. All renderings are artist's concept. Dimensions, specifications and architectural detailing subject to minor modification. Final location of pump pump is based on site conditions. Roofline and adjoining model types may vary due to string, S, S/C, L, L/C, F.