


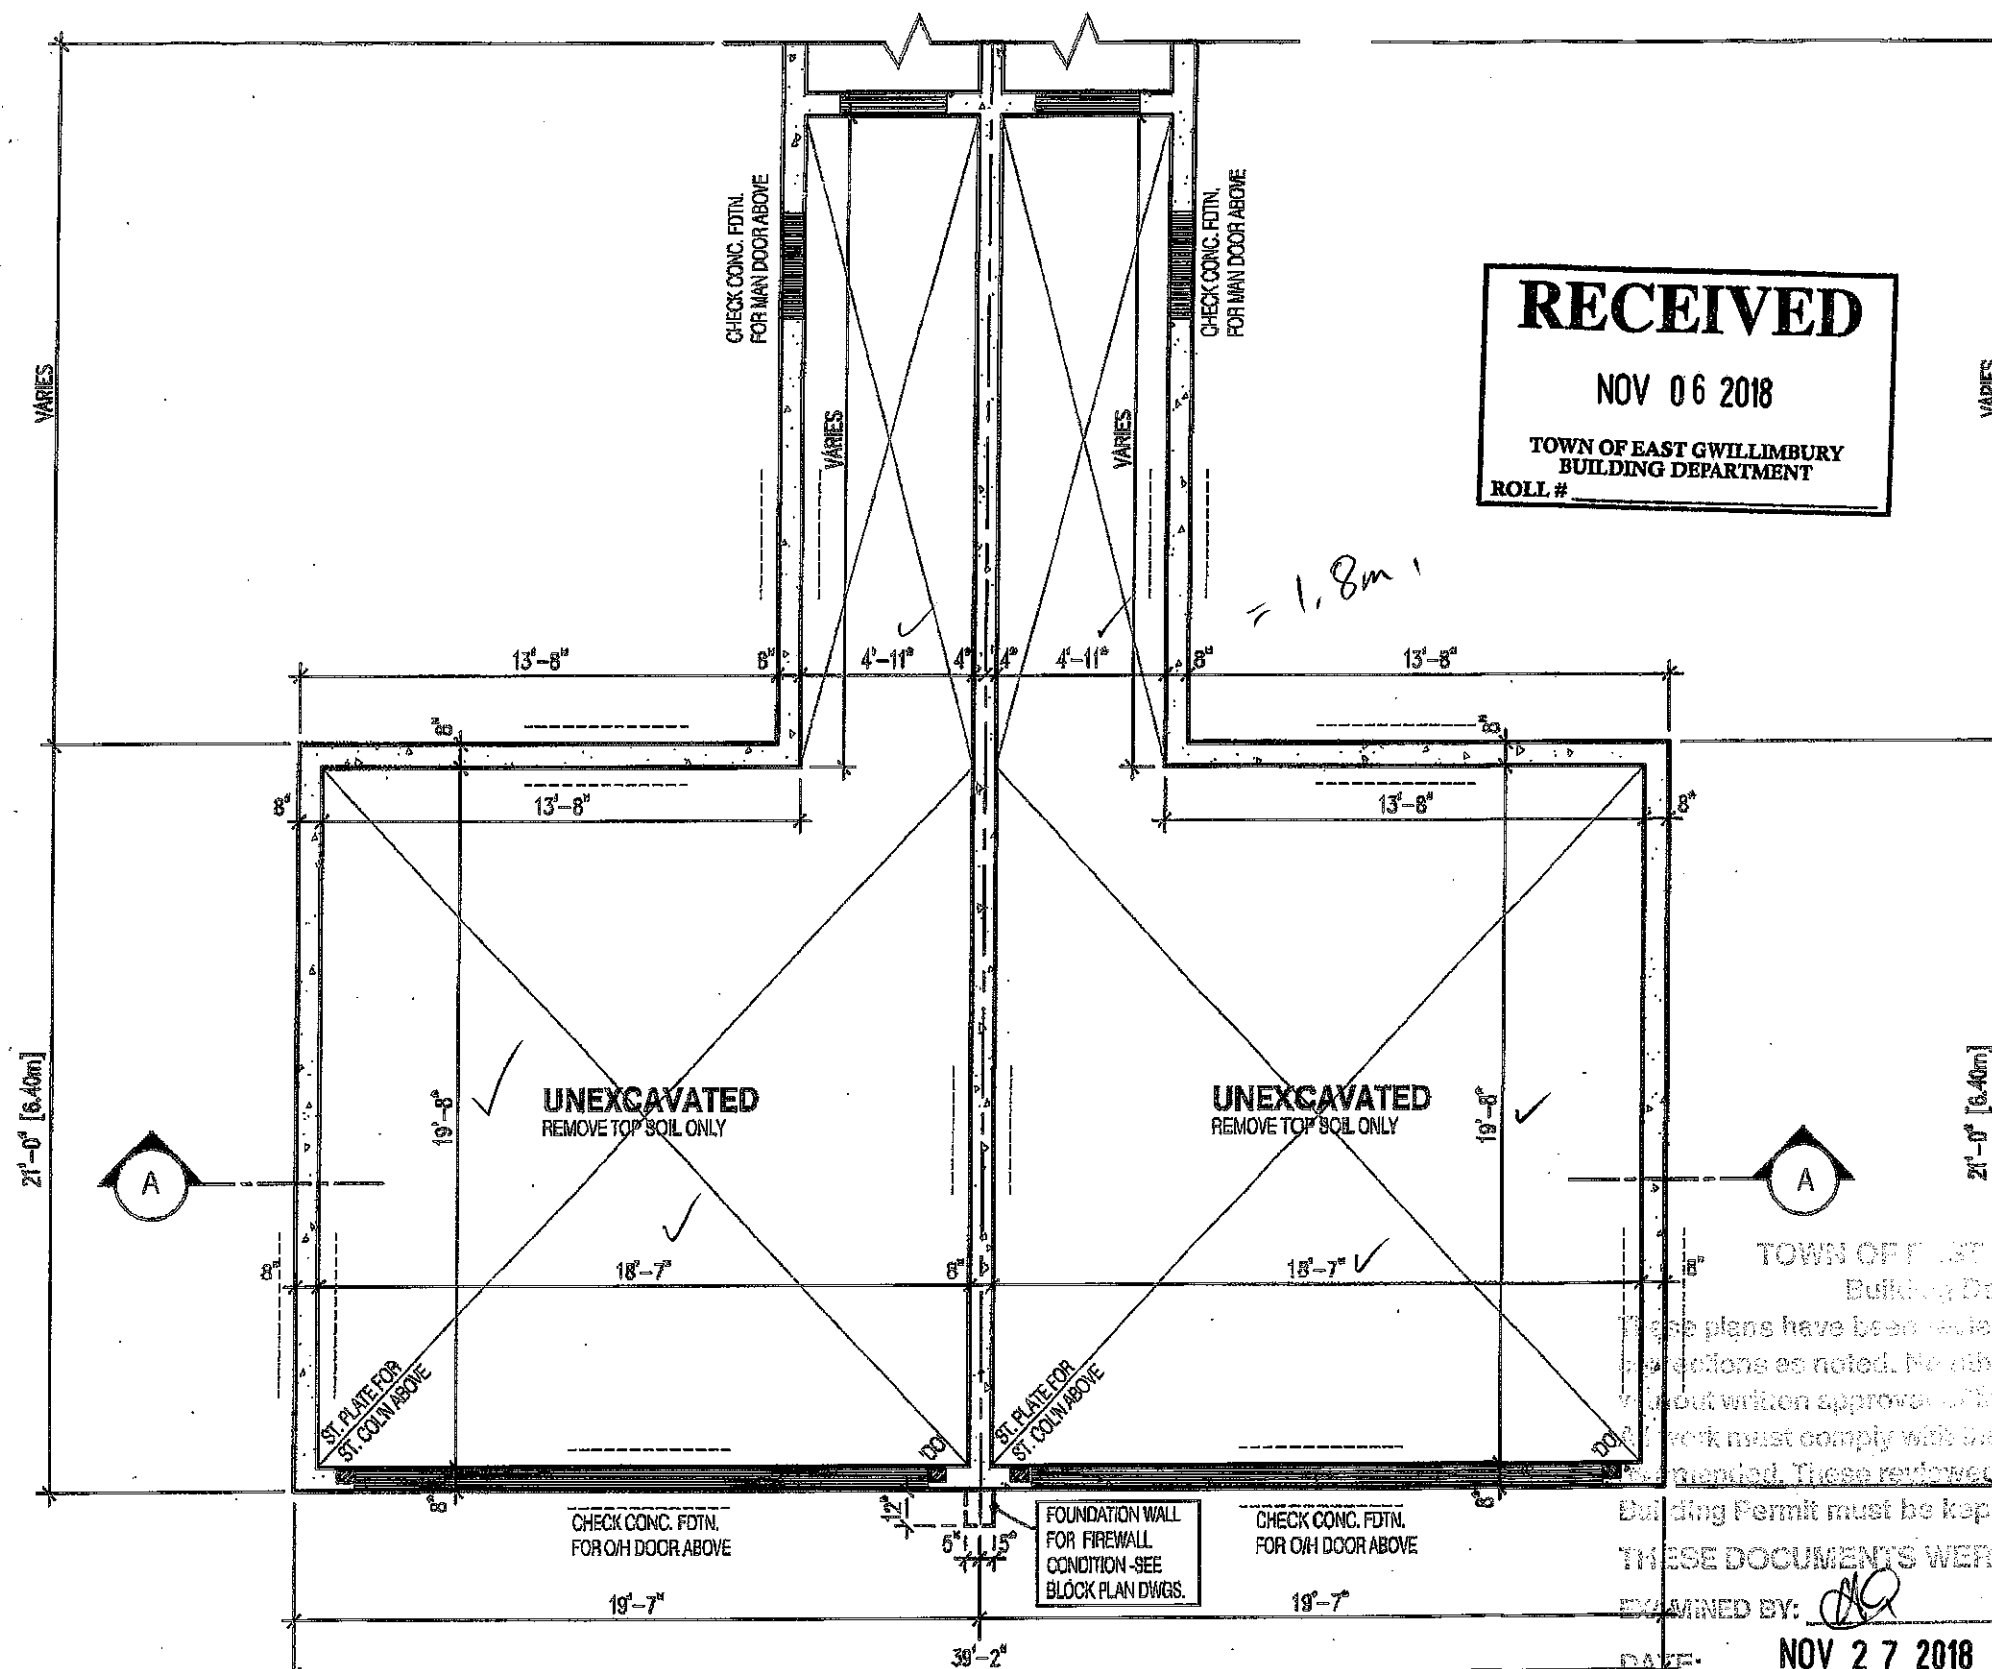

GALE 1A
ELEV. - 1, 2

GALE 1A
ELEV. - 1, 3

APPLICANT COPY

OCT 29 2018

RECEIVED
NOV 06 2018
TOWN OF EAST GWILLIMBURY
BUILDING DEPARTMENT
ROLL #

It is the builder's complete responsibility to ensure that all plans submitted for approval fully comply with the Architectural Guidelines and all applicable regulations and requirements including zoning provisions and any provisions in the subdivision agreement. The Control Architect is not responsible in any way for examining or approving site (lotting plans or working drawings with respect to any zoning or building code or permit matter or that any house can be properly built or located on its lot.

ARCHITECTURAL REVIEW
AND APPROVAL
TOWN OF EAST GWILLIMBURY

Signed: _____
Date: **OCT 31 2018**
JOHN G. WILLIAMS LIMITED
ARCHITECT



These plans have been reviewed for use with the regulations as noted. No other changes may be made without written approval of the Building Department. All work must comply with the Ontario Building Code, as amended. These reviewed documents and the Building Permit must be kept on site at all times.

NOTE:
FOR STRUCTURAL INFORMATION SEE BLOCK PLAN DRAWINGS

NOTE:
ALL GARAGE SLABS, PORCH SLABS, STAIRS (EXPOSED CONC. FLAT WORK) TO BE 32 MPa WITH 5-8% AIR ENTRAINMENT

GARAGE SLAB
100MM (4") 32MPa (4640psi) CONC. SLAB WITH 5-8% AIR ENTRAINMENT ON OPT. 100mm (4") COARSE GRANULAR FILL WITH COMPACTED SUB-BASE OR COMPACTED NATIVE FILL SLOPE TO FRONT AT 1% MIN.

O.REG. 332/12

**GARAGE
GALE 1A
BLOCK 51
BLOCK 52**

THE CONTRACTOR SHALL CHECK AND VERIFY ALL DIMENSIONS AND CONDITIONS ON SITE BEFORE PROCEEDING WITH CONSTRUCTION. ANY DISCREPANCIES SHALL BE REPORTED TO JARDIN DESIGN GROUP INC. PRIOR TO COMMENCEMENT OF WORK.
JARDIN DESIGN GROUP INC. IS NOT RESPONSIBLE FOR THE ACCURACY OF SURVEY, STRUCTURAL OR ENGINEERING INFORMATION SHOWN ON THESE DRAWINGS OR FOR CONSTRUCTION. STATED PRIOR TO THE ISSUANCE OF A BUILDING PERMIT. REFER TO THE APPROPRIATE ENGINEERING DRAWINGS BEFORE PROCEEDING WITH WORK.
AS CONSTRUCTED DIMENSIONS MUST BE VERIFIED PRIOR TO POURING FOOTINGS.
JARDIN DESIGN GROUP INC. HAS NOT BEEN RETAINED TO CARRY OUT GENERAL REVIEW OF THE WORK AND ASSUMES NO RESPONSIBILITY FOR THE FAILURE OF THE CONTRACTOR OR SUB-CONTRACTOR TO CARRY OUT THE WORK IN ACCORDANCE WITH THE CONTRACT DOCUMENTS.
THIS DRAWING IS AN INSTRUMENT OF SERVICE, PROVIDED BY AND IS THE PROPERTY OF JARDIN DESIGN GROUP INC. THIS DRAWING IS NOT TO BE REPRODUCED.

7		
6		
5		
4		
3	OCT. 24, 2018	REVISED BREEZEWAY WIDTH AS PER CITY COMMENTS
2	DEC. 21, 2017	ISSUED FOR BUILDING PERMIT
1	OCT. 25, 2017	ISSUED TO CLIENT FOR REVIEW

No: DATE: WORK DESCRIPTION:

jardin
DESIGN GROUP INC
64 JARDIN DR. SUITE 3A
VAUGHAN ONT. L4K 3P3
TEL: 905 660-3377 FAX: 905 660-3713
EMAIL: info@jardindesign.ca

The undersigned has reviewed and takes responsibility for this design and has the qualifications and meets the requirements set out in the Ontario Building Code to be a designer.


Walter Boffer 21031
NAME SIGNATURE BCIN

REGISTRATION INFORMATION
Required unless design is exempt under Division C, Subsection 3.2.4 of the building code

jardin design group inc. 27763
FIRM NAME BCIN

FOUNDATION PLAN
SECONDO VALES ESTATES
TOWN OF EAST GWILLIMBURY

BILD
MODEL:
SCALE: 3/16" = 1'-0"
PROJ. No. 17-41 DWG. No. 1

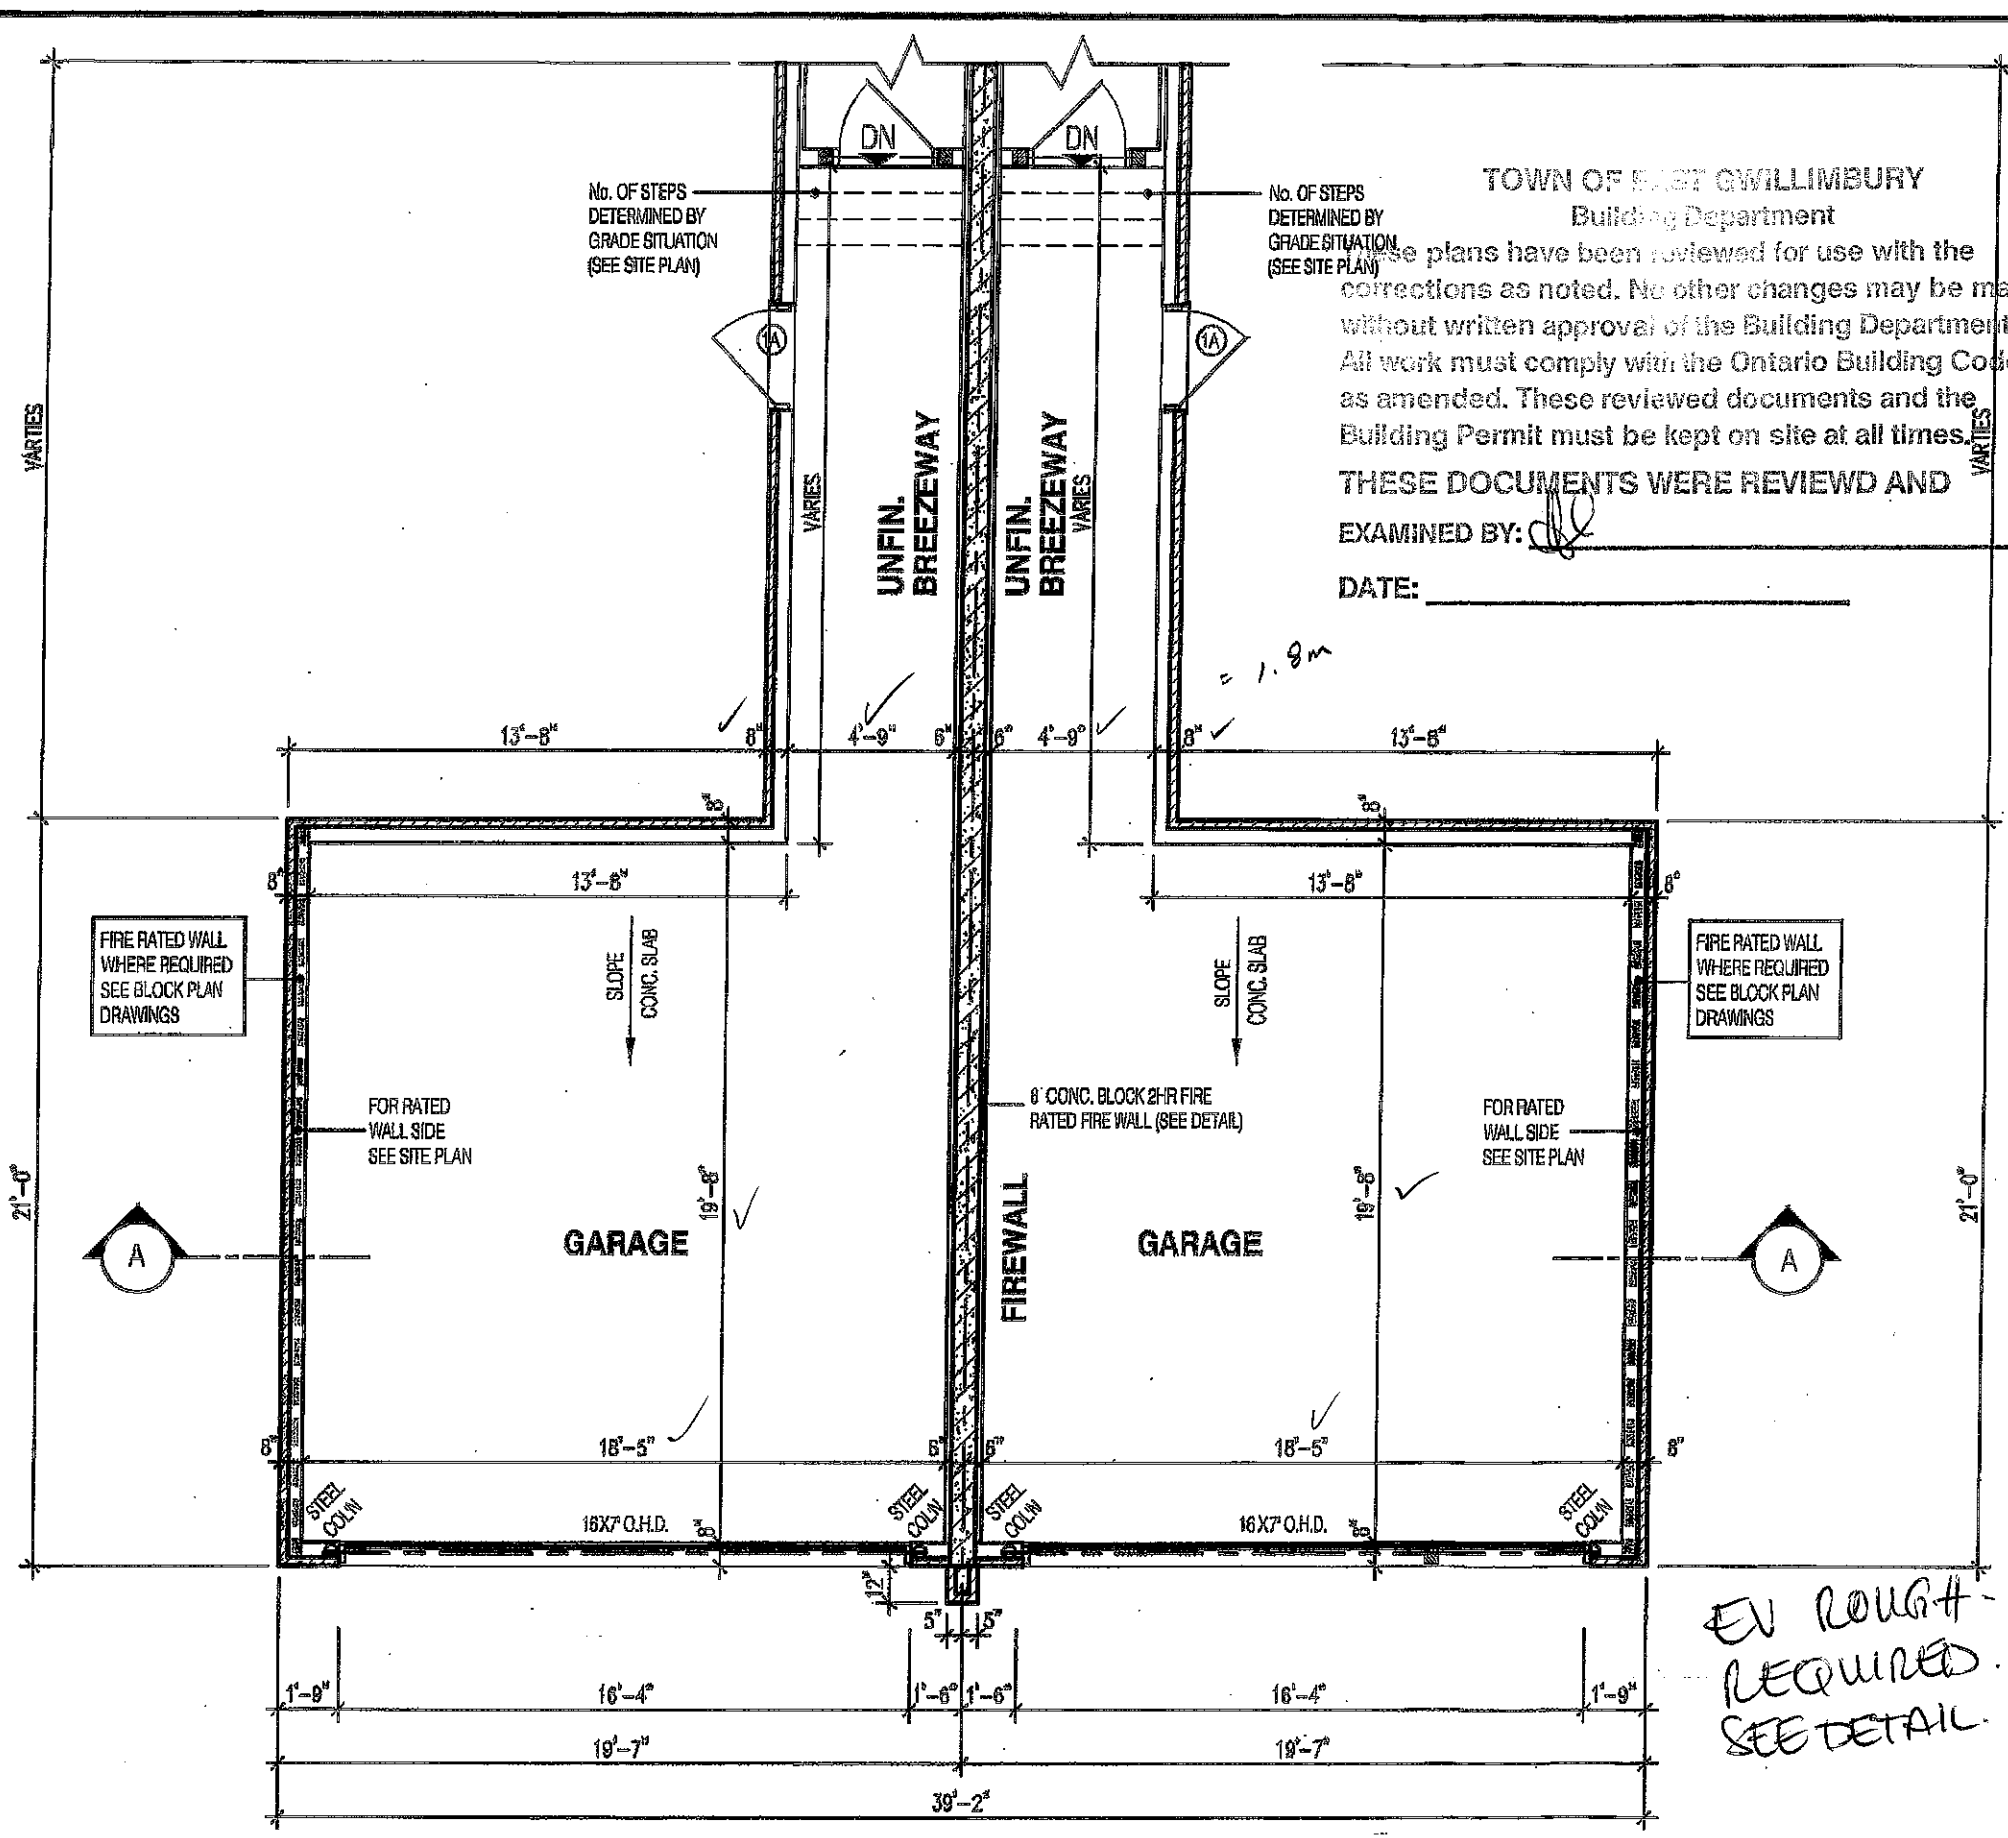

**GALE 1A
ELEV. - 1**

**GALE 1A
ELEV. - 1**

OCT 29 2018

O.REG. 332/12

**GARAGE
GALE 1A
BLOCK 52**

**TOWN OF EAST GWILLIMBURY
Building Department**
These plans have been reviewed for use with the corrections as noted. No other changes may be made without written approval of the Building Department. All work must comply with the Ontario Building Code, as amended. These reviewed documents and the Building Permit must be kept on site at all times.
THESE DOCUMENTS WERE REVIEWED AND EXAMINED BY: [Signature]
DATE: _____

It is the builder's complete responsibility to ensure that all plans submitted for approval fully comply with the Architectural Guidelines and all applicable regulations and requirements including zoning provisions and any provisions in the subdivision agreement. The Control Architect is not responsible in any way for examining or approving site (lotting) plans or working drawings with respect to any zoning or building code or permit matter or that any house can be properly built or located on its lot.

**ARCHITECTURAL REVIEW
AND APPROVAL
TOWN OF EAST GWILLIMBURY**

Signed: _____
Date: **OCT 21 2018**
JOHN G. WILLIAMS LIMITED
ARCHITECT



FOR STRUCTURE ONLY

NOTE:
FOR STRUCTURAL INFORMATION SEE BLOCK PLAN DRAWINGS

NOTE:
ALL GARAGE SLABS, PORCH SLABS, STAIRS (EXPOSED CONC. FLAT WORK) TO BE 32 MPa WITH 5-8% AIR ENTRAINMENT

GARAGE SLAB
100MM (4") 32MPa (4640psi) CONC. SLAB WITH 5-8% AIR ENTRAINMENT ON OPT. 100mm (4") COARSE GRANULAR FILL WITH COMPACTED SUB-BASE OR COMPACTED NATIVE FILL SLOPE TO FRONT AT 1% MIN.

THE CONTRACTOR SHALL CHECK AND VERIFY ALL DIMENSIONS AND CONDITIONS ON SITE BEFORE PROCEEDING WITH CONSTRUCTION. ANY DISCREPANCIES SHALL BE REPORTED TO JARDIN DESIGN GROUP INC. PRIOR TO COMMENCEMENT OF WORK.
JARDIN DESIGN GROUP INC. IS NOT RESPONSIBLE FOR THE ACCURACY OF SURVEY, STRUCTURAL OR ENGINEERING INFORMATION SHOWN ON THESE DRAWINGS OR FOR CONSTRUCTION STARTED PRIOR TO THE ISSUANCE OF A BUILDING PERMIT. REFER TO THE APPROPRIATE ENGINEERING DRAWINGS BEFORE PROCEEDING WITH WORK.
AS CONSTRUCTED INVERTS MUST BE VERIFIED PRIOR TO POLING FOOTINGS.
JARDIN DESIGN GROUP INC. HAS NOT BEEN RETAINED TO CARRY OUT GENERAL REVIEW OF THE WORK AND ASSUMES NO RESPONSIBILITY FOR THE FAILURE OF THE CONTRACTOR OR SUB CONTRACTOR TO CARRY OUT THE WORK IN ACCORDANCE WITH THE CONTRACT DOCUMENTS.
THIS DRAWING IS AN INSTRUMENT OF SERVICE, PROVIDED BY AND IS THE PROPERTY OF JARDIN DESIGN GROUP INC. THIS DRAWING IS NOT TO BE SCALED.

7	
6	
5	
4	
3	OCT. 24, 2018 REVISED BREEZEWAY WIDTH AS PER CITY COMMENTS
2	DEC. 21, 2017 ISSUED FOR BUILDING PERMIT
1	OCT. 25, 2017 ISSUED TO CLIENT FOR REVIEW

No: _____ DATE: _____ WORK DESCRIPTION: _____
jardin
DESIGN GROUP INC
64 JARDIN DR. SUITE 3A
VAUGHAN ONT. L4K 3P3
TEL: 905 660-3377 FAX: 905 660-3713
EMAIL: info@jardindesign.ca


The undersigned has reviewed and takes responsibility for this design and has the qualifications and meets the requirements set out in the Ontario Building Code to be a designer

Walter Botter [Signature] 21031
NAME SIGNATURE BCIN

jardin design group inc. 27763
FIRM NAME BCIN

GARAGE PLAN
SECONDO VALES ESTATES
TOWN OF EAST GWILLIMBURY

BILD
MODEL: _____
SCALE: 3/16"=1'-0"
PROJ. No. 17-41 DWG. No. 2

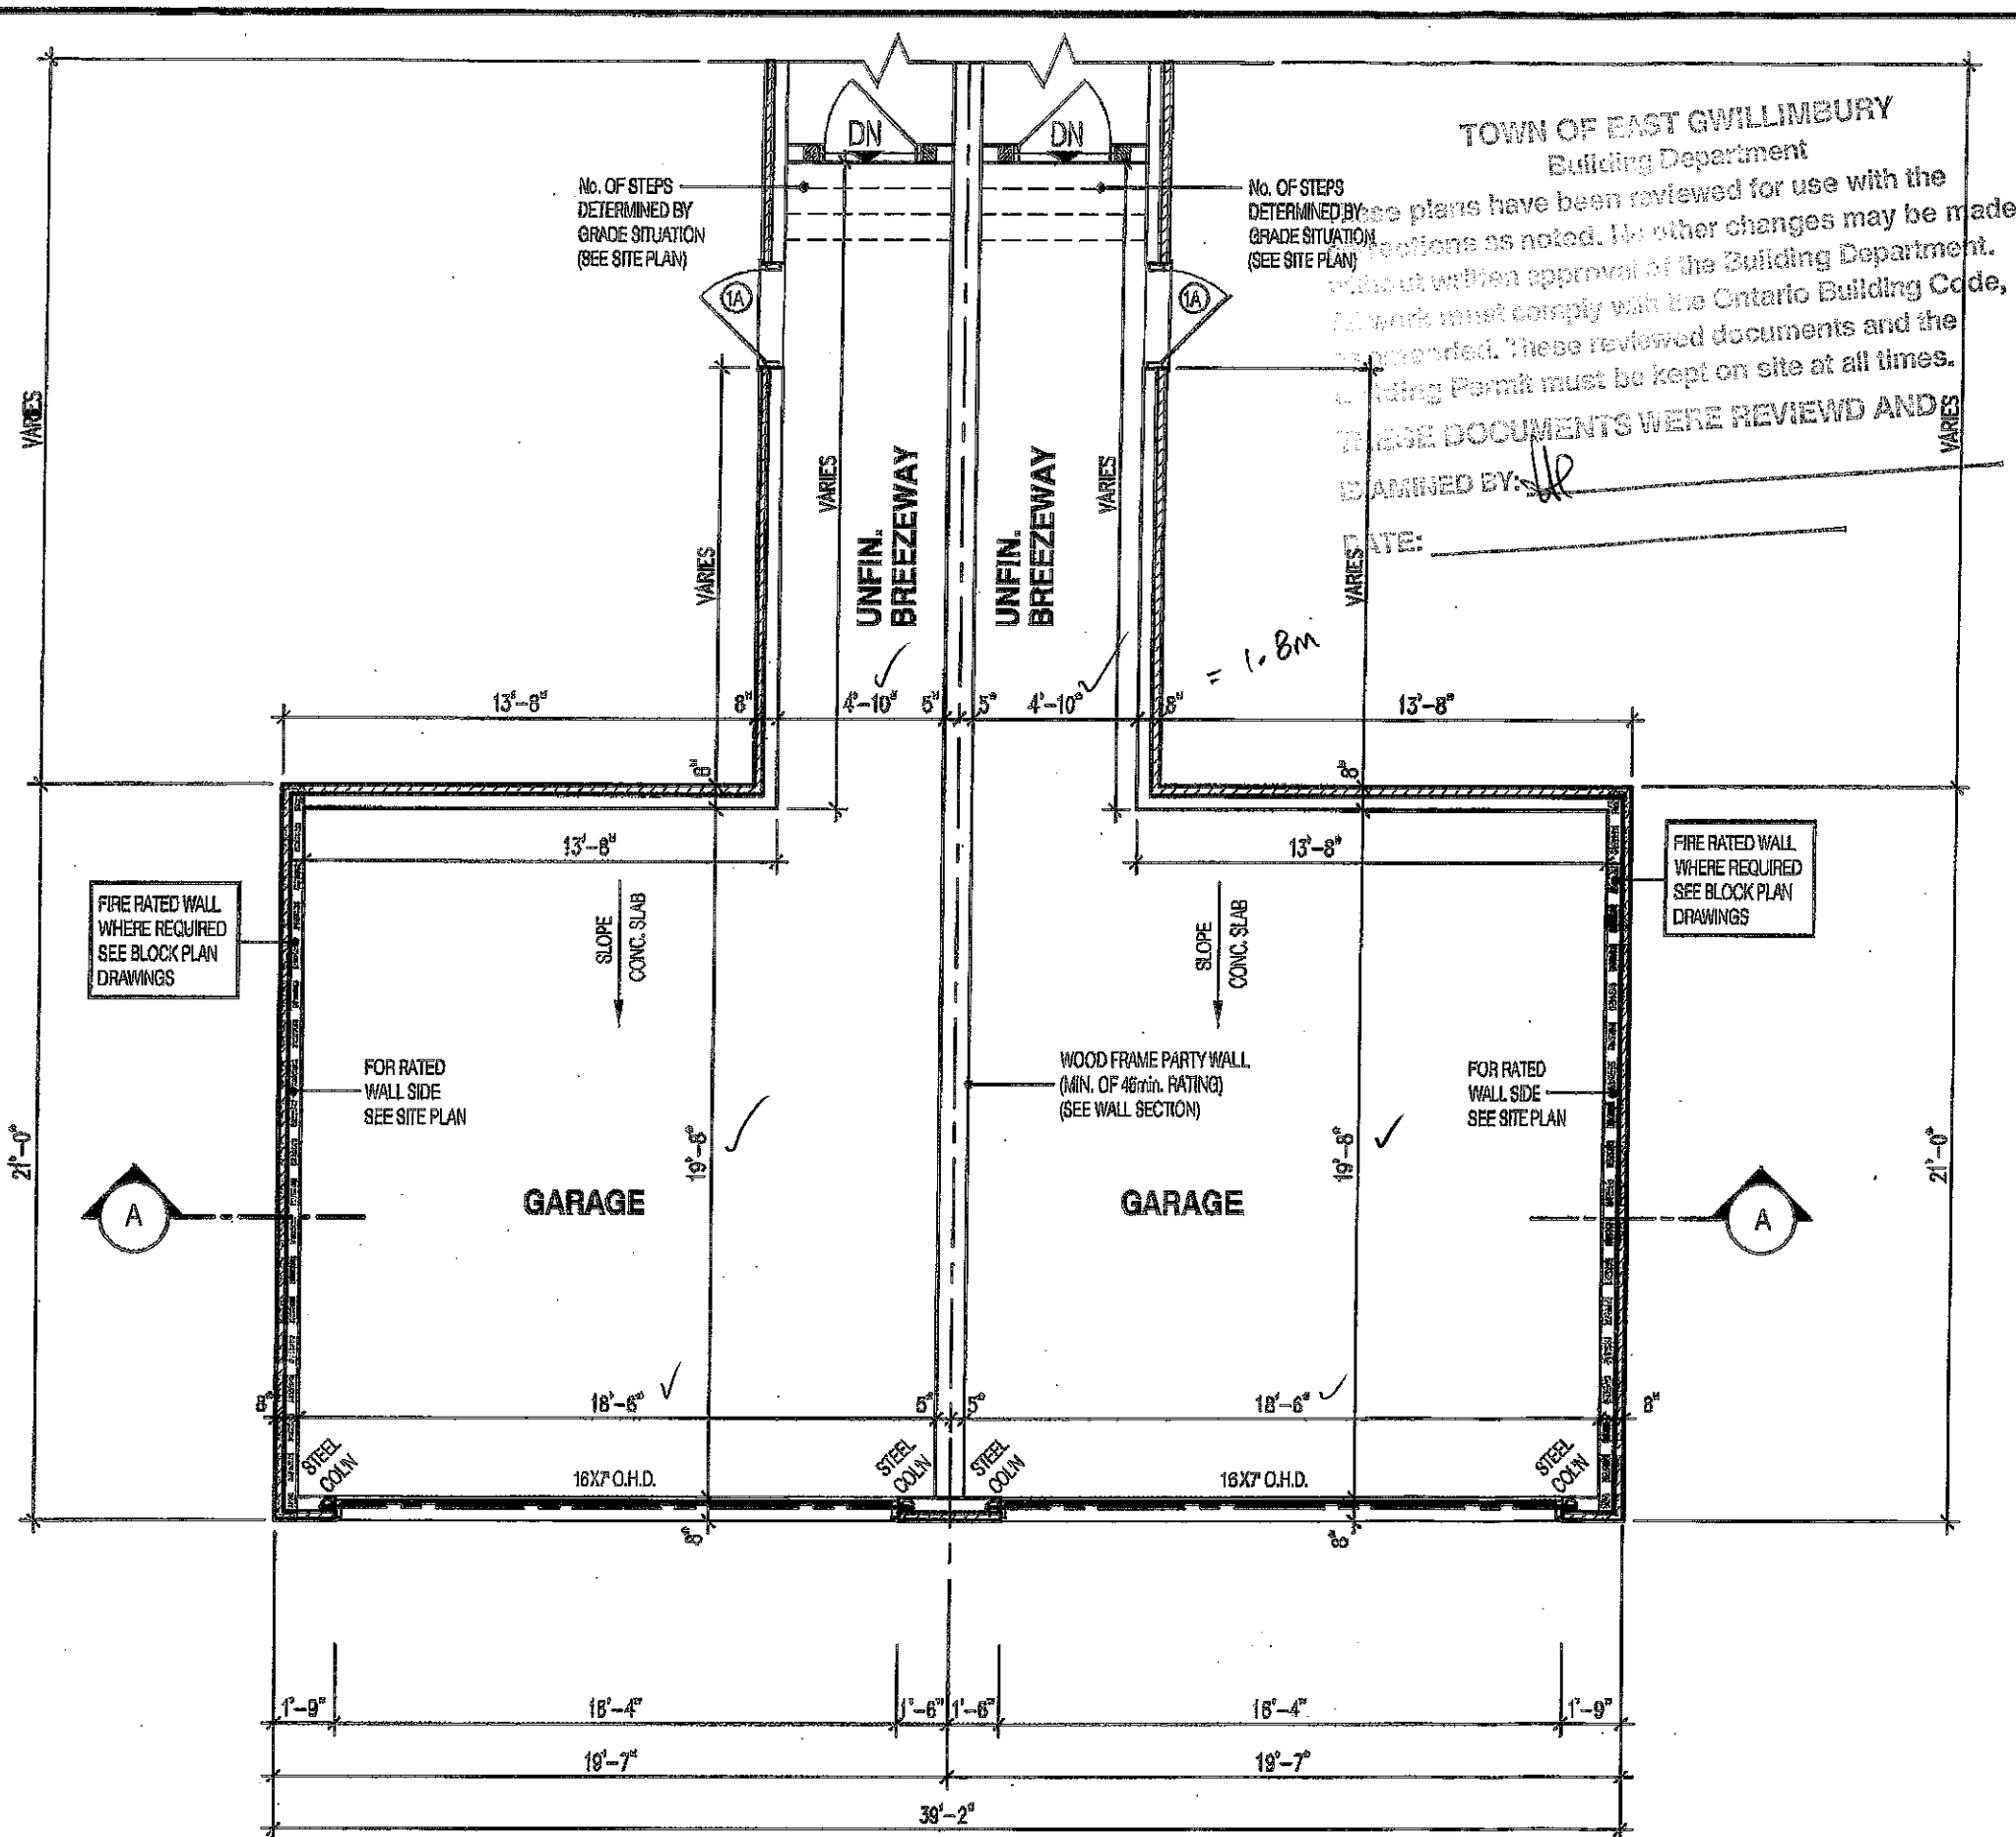

GALE 1A
ELEV. - 2

GALE 1A
ELEV. - 3

OCT 29 2018

O.REG. 332/12

**GARAGE
GALE 1A
BLOCK 51
BLOCK 52**

It is the builder's complete responsibility to ensure that all plans submitted for approval fully comply with the Architectural Guidelines and all applicable regulations and requirements including zoning provisions and any provisions in the subdivision agreement. The Control Architect is not responsible in any way for examining or approving site (lotting) plans or working drawings with respect to any zoning or building code or permit matter or that any house can be properly built or located on its lot.

**ARCHITECTURAL REVIEW
AND APPROVAL
TOWN OF EAST GWILLIMBURY**

Signed: _____

Date: **OCT 31 2018**
JOHN G. WILLIAMS LIMITED
ARCHITECT

STRUDET INC.



FOR STRUCTURE ONLY

NOTE:
FOR STRUCTURAL INFORMATION SEE BLOCK PLAN DRAWINGS

NOTE:
ALL GARAGE SLABS, PORCH SLABS,
STAIRS (EXPOSED CONC. FLAT WORK) TO
BE 32 MPa WITH 5-8% AIR ENTRAINMENT

GARAGE SLAB

100MM (4") 32MPa (4640psi) CONC. SLAB WITH 5-8%
AIR ENTRAINMENT ON OPT. 100mm (4") COARSE GRANULAR
FILL WITH COMPACTED SUB-BASE OR COMPACTED NATIVE
FILL SLOPE TO FRONT AT 1% MIN.

THE CONTRACTOR SHALL CHECK AND VERIFY ALL DIMENSIONS AND CONDITIONS ON SITE BEFORE PROCEEDING WITH CONSTRUCTION. ANY DISCREPANCIES SHALL BE REPORTED TO JARDIN DESIGN GROUP INC. PRIOR TO COMMENCEMENT OF WORK.
JARDIN DESIGN GROUP INC. IS NOT RESPONSIBLE FOR THE ACCURACY OF SURVEY, STRUCTURAL OR ENGINEERING INFORMATION SHOWN ON THESE DRAWINGS OR FOR CONSTRUCTION STARTED PRIOR TO THE ISSUANCE OF A BUILDING PERMIT. REFER TO THE APPROPRIATE ENGINEERING DRAWINGS BEFORE PROCEEDING WITH WORK.
AS CONSTRUCTED (INVERTS MUST BE VERIFIED PRIOR TO POURING FOOTINGS).
JARDIN DESIGN GROUP INC. HAS NOT BEEN RETAINED TO CARRY OUT GENERAL REVIEW OF THE WORK AND ASSUMES NO RESPONSIBILITY FOR THE FAILURE OF THE CONTRACTOR OR SUB CONTRACTOR TO CARRY OUT THE WORK IN ACCORDANCE WITH THE CONTRACT DOCUMENTS.
THIS DRAWING IS AN INSTRUMENT OF SERVICE, IS PROVIDED BY AND IS THE PROPERTY OF JARDIN DESIGN GROUP INC. THIS DRAWING IS NOT TO BE SCALED.

7		
6		
5		
4		
3	OCT. 24, 2018	REVISED BREEZEWAY WIDTH AS PER CITY COMMENTS
2	DEC. 21, 2017	ISSUED FOR BUILDING PERMIT
1	OCT. 25, 2017	ISSUED TO CLIENT FOR REVIEW

No: DATE: WORK DESCRIPTION:

jardin
DESIGN GROUP INC
64 JARDIN DR. SUITE 3A
VAUGHAN ONT. L4K 3P3
TEL: 905 660-3377 FAX: 905 660-3713
EMAIL: info@jardindesign.ca

The undersigned has reviewed and takes responsibility for this design and has the qualifications and meets the requirements set out in the Ontario Building Code to be a designer

QUALIFICATION INFORMATION
Required unless design is exempt under Division C, Subsection 3.2.5 of the building code


Walter Boller *WLB* 21037
NAME SIGNATURE BCIN

REGISTRATION INFORMATION
Required unless design is exempt under Division C, Subsection 3.2.4 of the building code

jardin design group inc. 27763
FIRM NAME BCIN

GARAGE PLAN
SECONDO VALES ESTATES
TOWN OF EAST GWILLIMBURY

MODEL: ---
SCALE: 3/16" = 1'-0"
PROJ. No. 17-41 DWG. No. 3

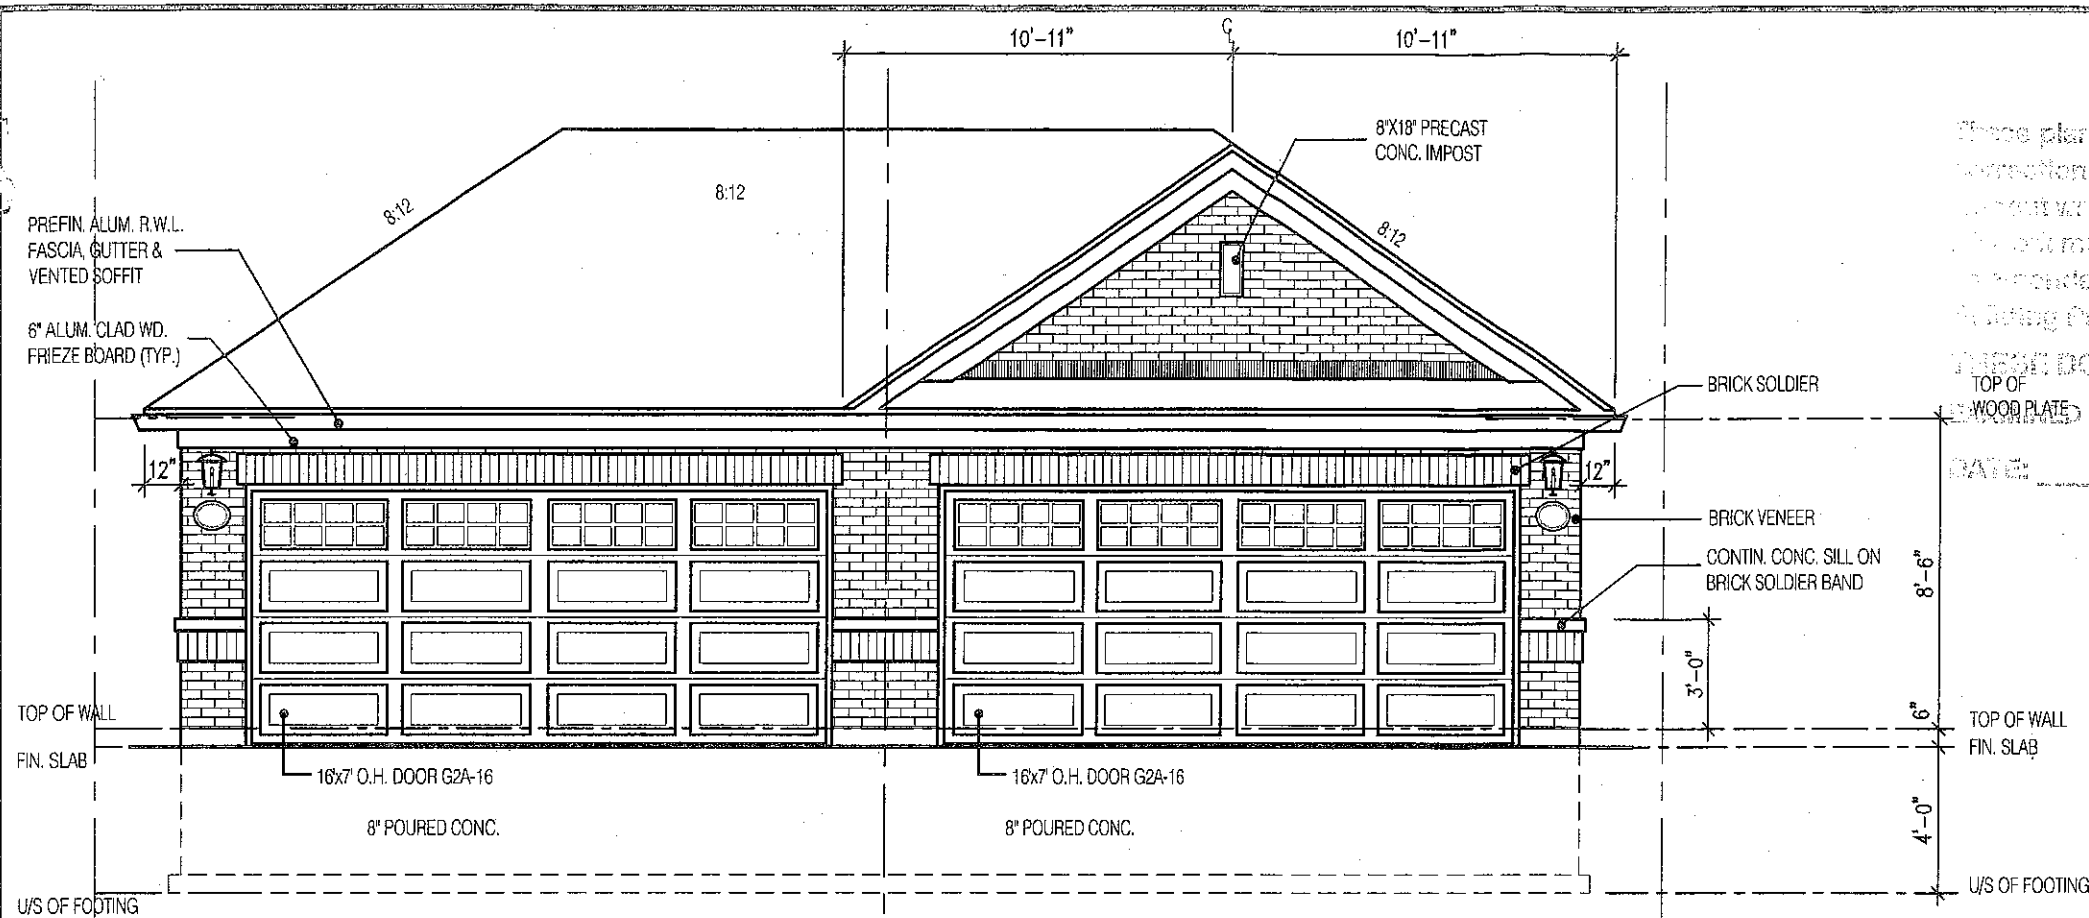

TOWN OF EAST GWILLIMBURY
Building Department

These plans have been reviewed for use with the
conditions as noted. No other changes may be made
without written approval of the Building Department.
The permit must comply with the Ontario Building Code,
as amended. These reviewed documents and the
Building Permit must be kept on site at all times.

THESE DOCUMENTS WERE REVIEWED AND

DATE: _____

DATE: _____

It is the builder's complete responsibility to ensure
that all plans submitted for approval fully comply with
the Architectural Guidelines and all applicable
regulations and requirements including zoning
provisions and any provisions in the subdivision
agreement. The Council Architect is not responsible
in any way for examining or approving site (lotting)
plans or working drawings with respect to any zoning
or building code or permit matter or that any building
can be properly built or located on its lot.

ARCHITECTURAL REVIEW
AND APPROVAL
TOWN OF EAST GWILLIMBURY

Signed: _____


Date: JUL 27 2018
JOHN G. WILLIAMS LIMITED
ARCHITECT

TH 51-3
GALE 1A
FRONT ELEV. - 2

TH 52-2
GALE 1A
FRONT ELEV. - 2

TH 51-4
GALE 1A
FRONT ELEV. - 3

TH 52-1
GALE 1A
FRONT ELEV. - 3

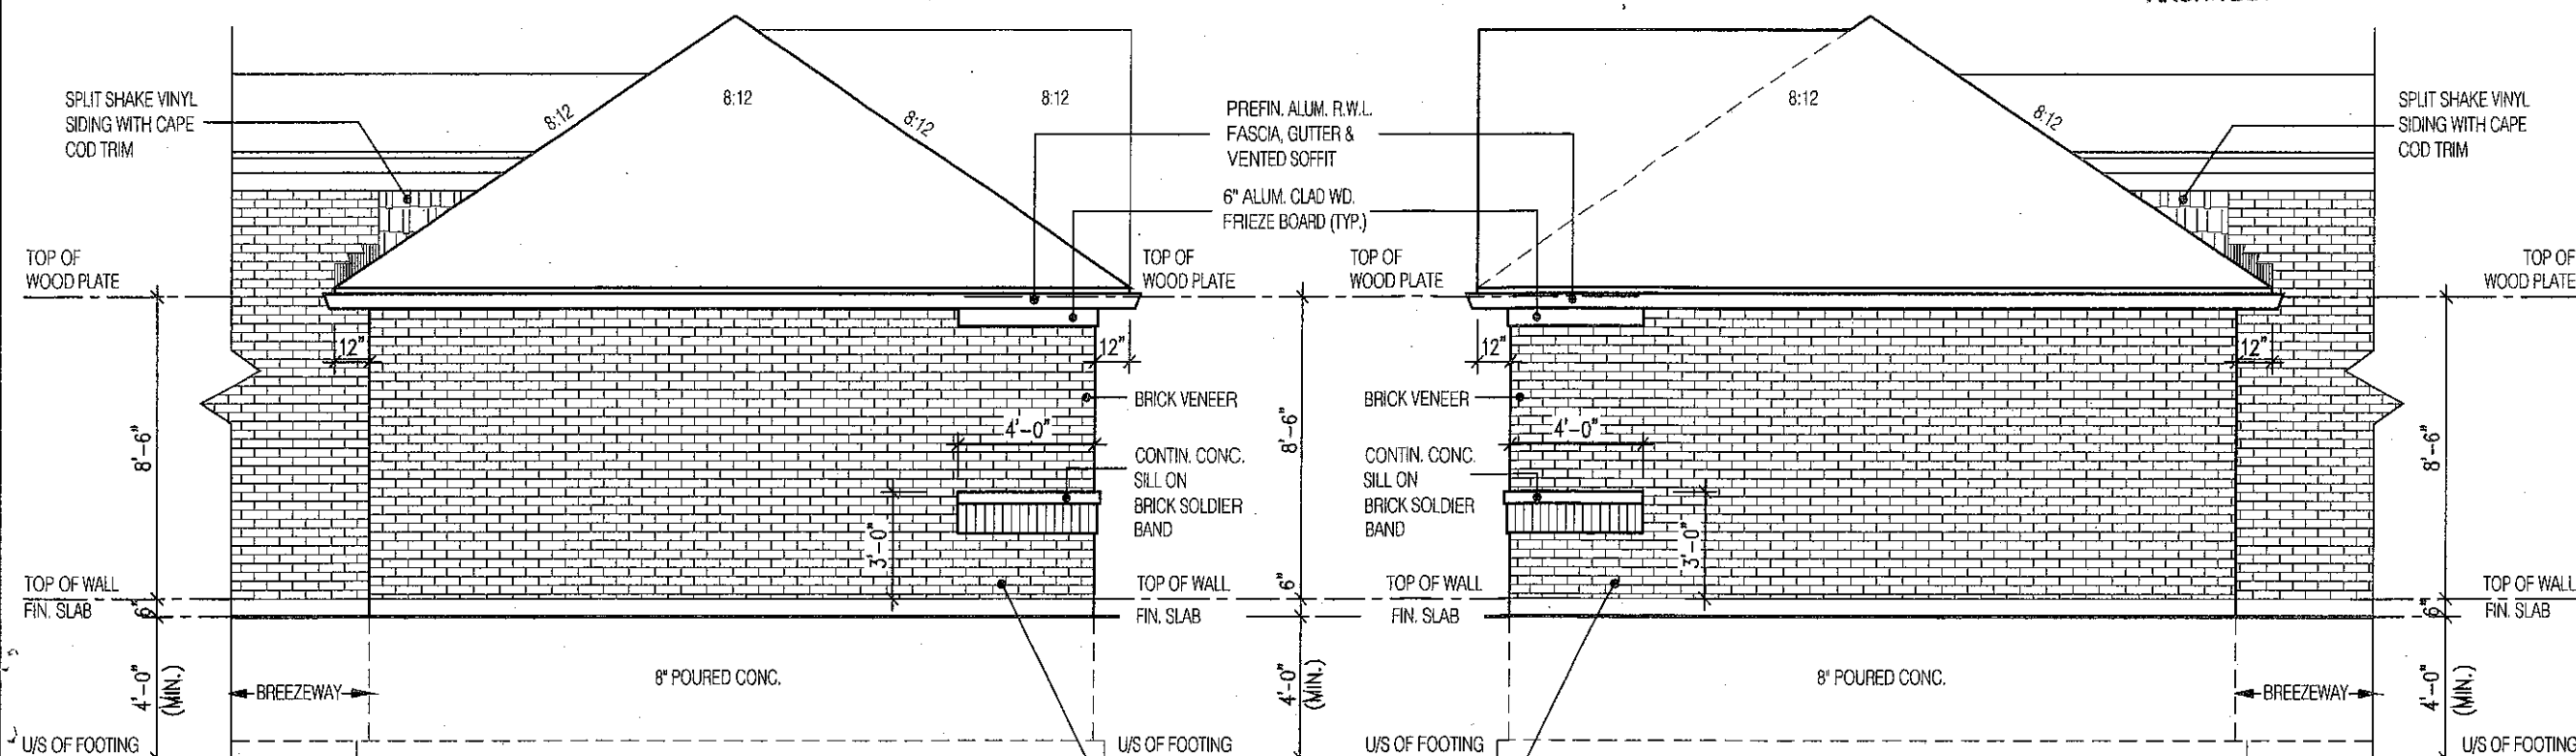

TH 51-3
GALE 1A
SIDE ELEV. - 2

TH 52-2
GALE 1A
SIDE ELEV. - 2

TH 51-4
GALE 1A
SIDE ELEV. - 3

TH 52-1
GALE 1A
SIDE ELEV. - 3

FIRE RATED WALL
WHERE REQUIRED
SEE BLOCK PLAN
DRAWINGS

APR 20 2018

GARAGE
GALE 1A

BLOCK 51
BLOCK 52

THE CONTRACTOR SHALL CHECK AND VERIFY ALL DIMENSIONS AND
CONDITIONS ON SITE BEFORE PROCEEDING WITH CONSTRUCTION.
ANY DISCREPANCIES SHALL BE REPORTED TO JARDIN DESIGN GROUP
INC. PRIOR TO COMMENCEMENT OF WORK.

JARDIN DESIGN GROUP INC. IS NOT RESPONSIBLE FOR THE ACCURACY
OF SURVEY, STRUCTURAL OR ENGINEERING INFORMATION SHOWN ON
THESE DRAWINGS OR FOR CONSTRUCTION STARTED PRIOR TO THE
ISSUANCE OF A BUILDING PERMIT. REFER TO THE APPROPRIATE
ENGINEERING DRAWINGS BEFORE PROCEEDING WITH WORK.

AS CONSTRUCTED INVERTS MUST BE VERIFIED PRIOR TO POURING
FOOTINGS.

JARDIN DESIGN GROUP INC. HAS NOT BEEN RETAINED TO CARRY OUT
GENERAL REVIEW OF THE WORK AND ASSUMES NO RESPONSIBILITY
FOR THE FAILURE OF THE CONTRACTOR OR SUB CONTRACTOR TO
CARRY OUT THE WORK IN ACCORDANCE WITH THE CONTRACT
DOCUMENTS.

THIS DRAWING IS AN INSTRUMENT OF SERVICE, IS PROVIDED BY AND IS
THE PROPERTY OF JARDIN DESIGN GROUP INC. THIS DRAWING IS NOT
TO BE SCALED.

7		
6		
5		
4		
3		
2	DEC. 21, 2017	ISSUED FOR BUILDING PERMIT
1	OCT. 25, 2017	ISSUED TO CLIENT FOR REVIEW

No: _____ DATE: _____ WORK DESCRIPTION: _____

jardin
DESIGN GROUP INC
64 JARDIN DR. SUITE 3A
VAUGHAN ONT. L4K 3P3
TEL: 905 660-3377 FAX: 905 660-3713
EMAIL: info@jardindesign.ca

The undersigned has reviewed and takes responsibility
for this design and has the qualifications and meets the
requirements set out in the Ontario Building Code to be
a designer

QUALIFICATION INFORMATION
Required unless design is exempt under Division C, Subsection
3.2.5 of the building code

Walter Botter *WBe* 21031
NAME SIGNATURE BCIN


REGISTRATION INFORMATION
Required unless design is exempt under Division C, Subsection
3.2.4 of the building code


jardin design group inc. 27763
FIRM NAME BCIN

FRONT & SIDE ELEV.


SECONDO VALES ESTATES
TOWN OF EAST GWILLIMBURY

MODEL: _____
SCALE: 3/16"=1'-0"
PROJ. No. _____ DWG. No. _____
17 11 1

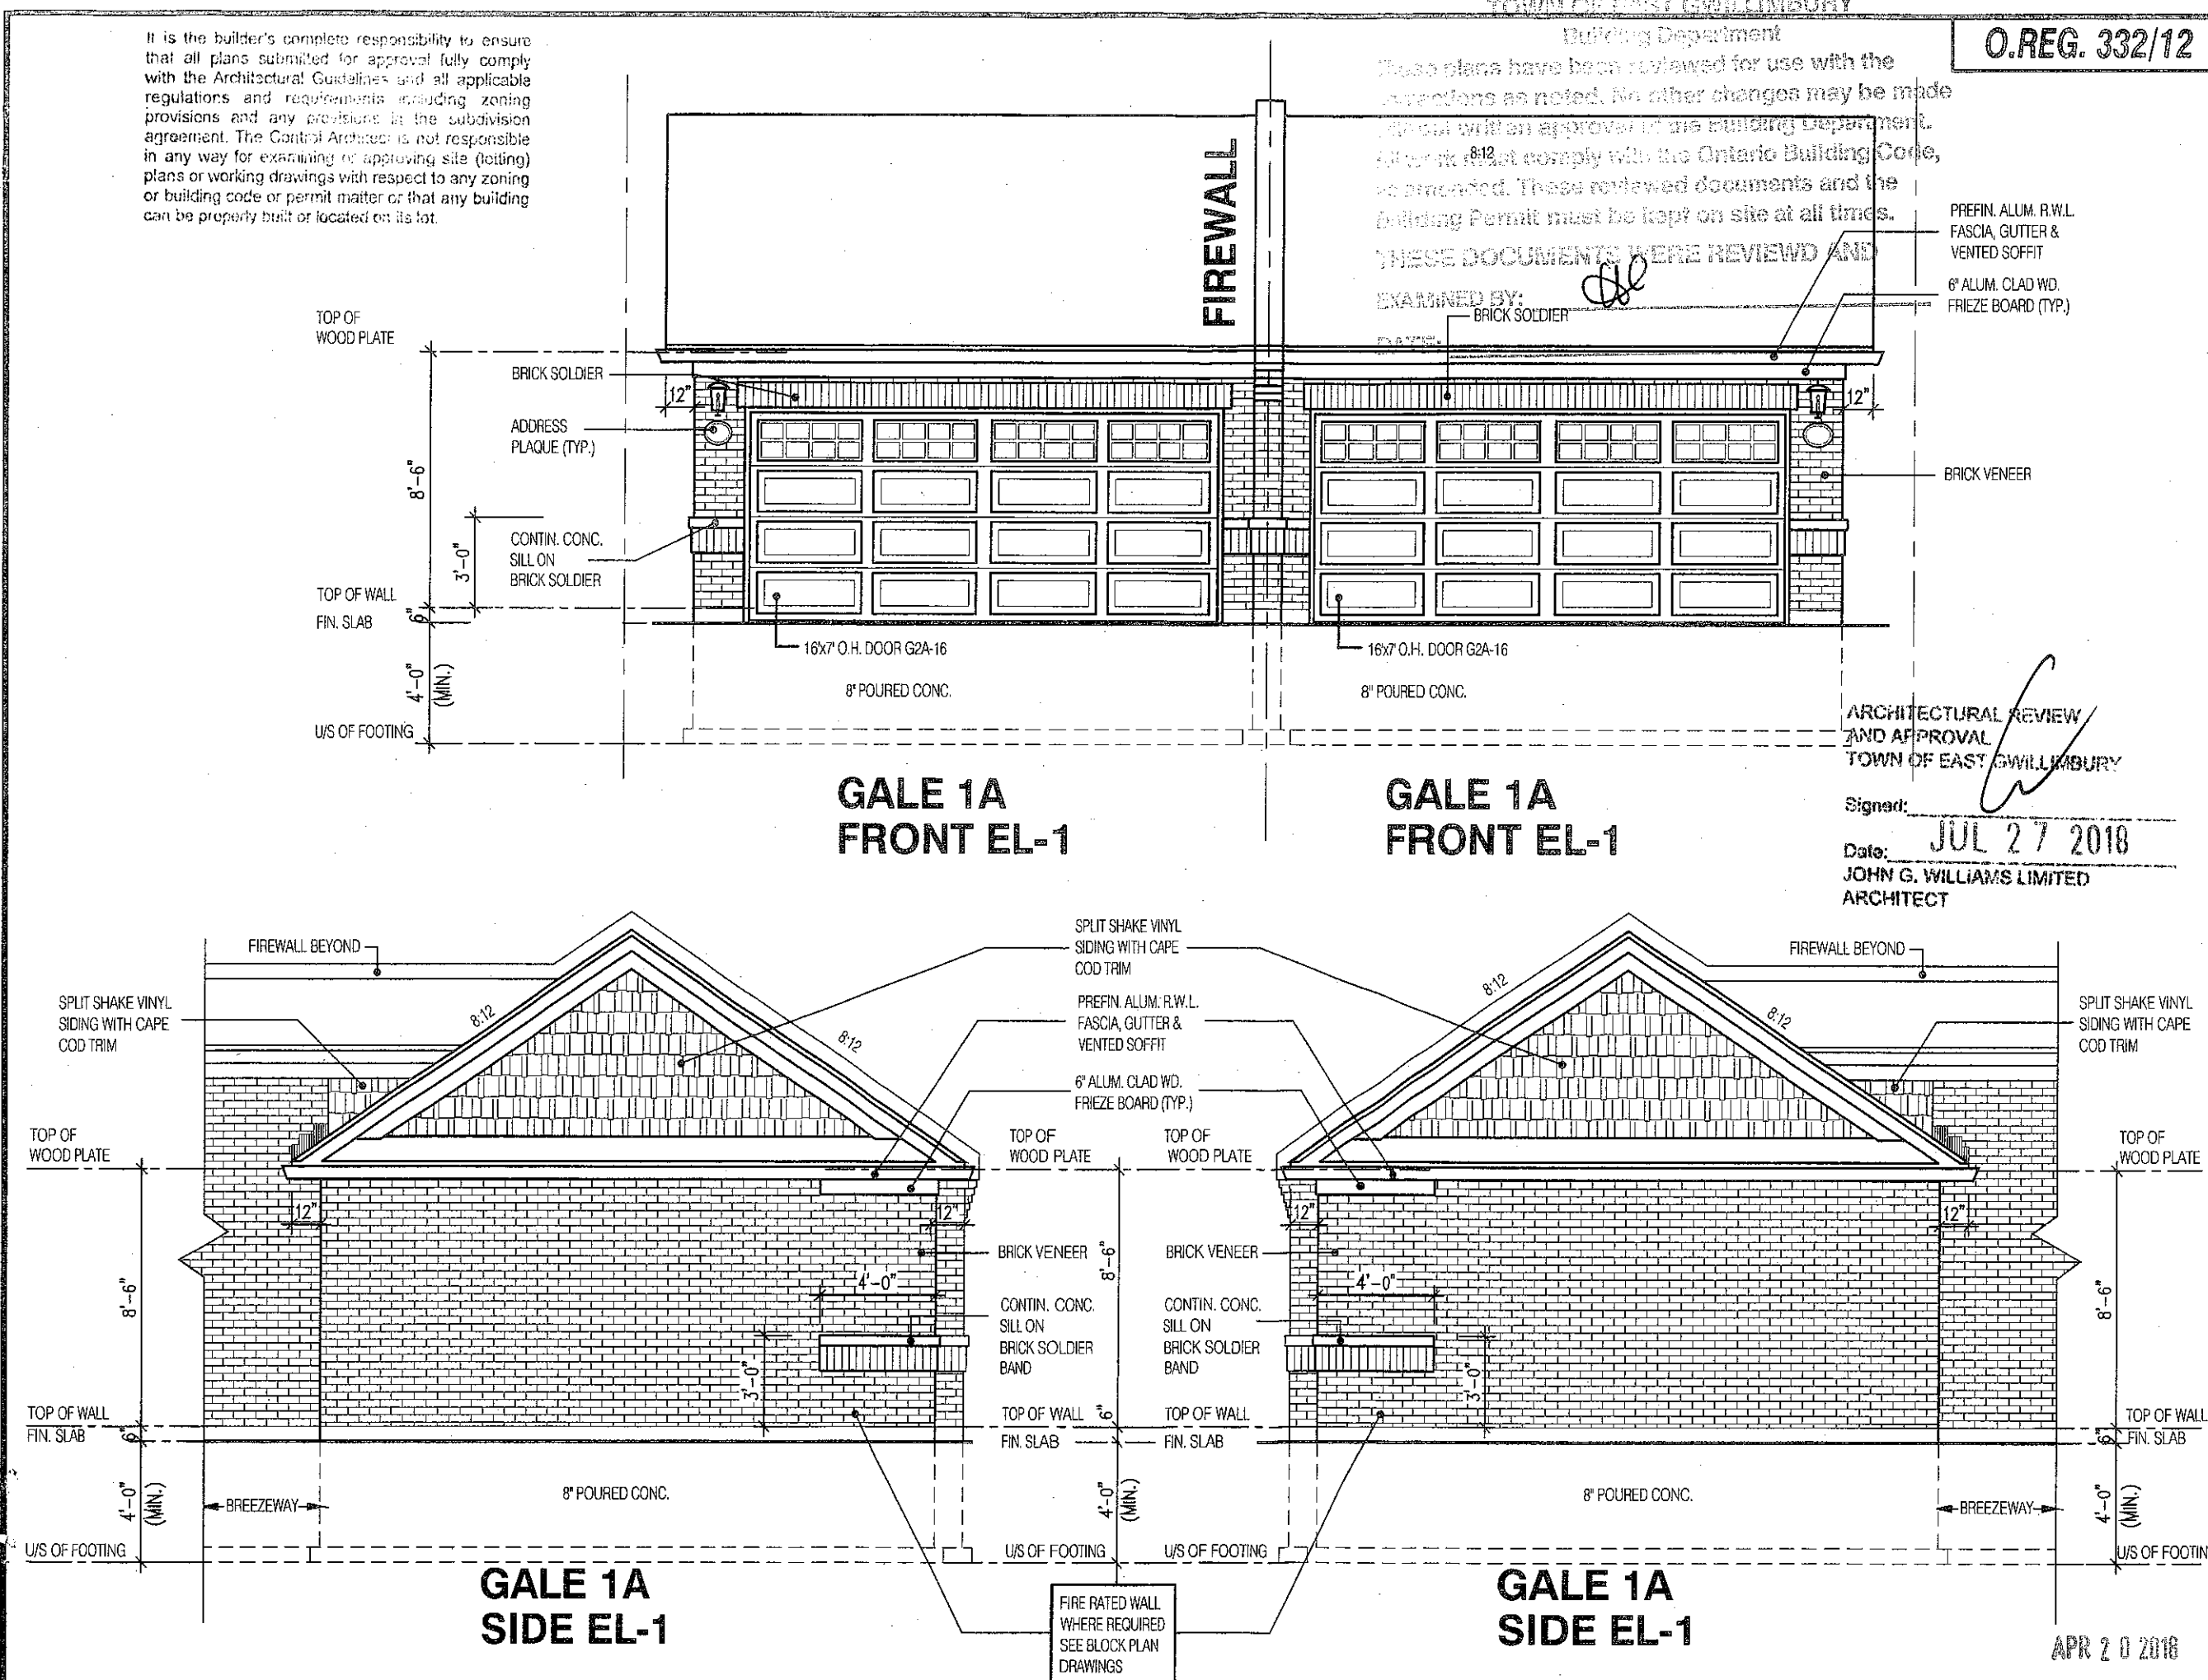

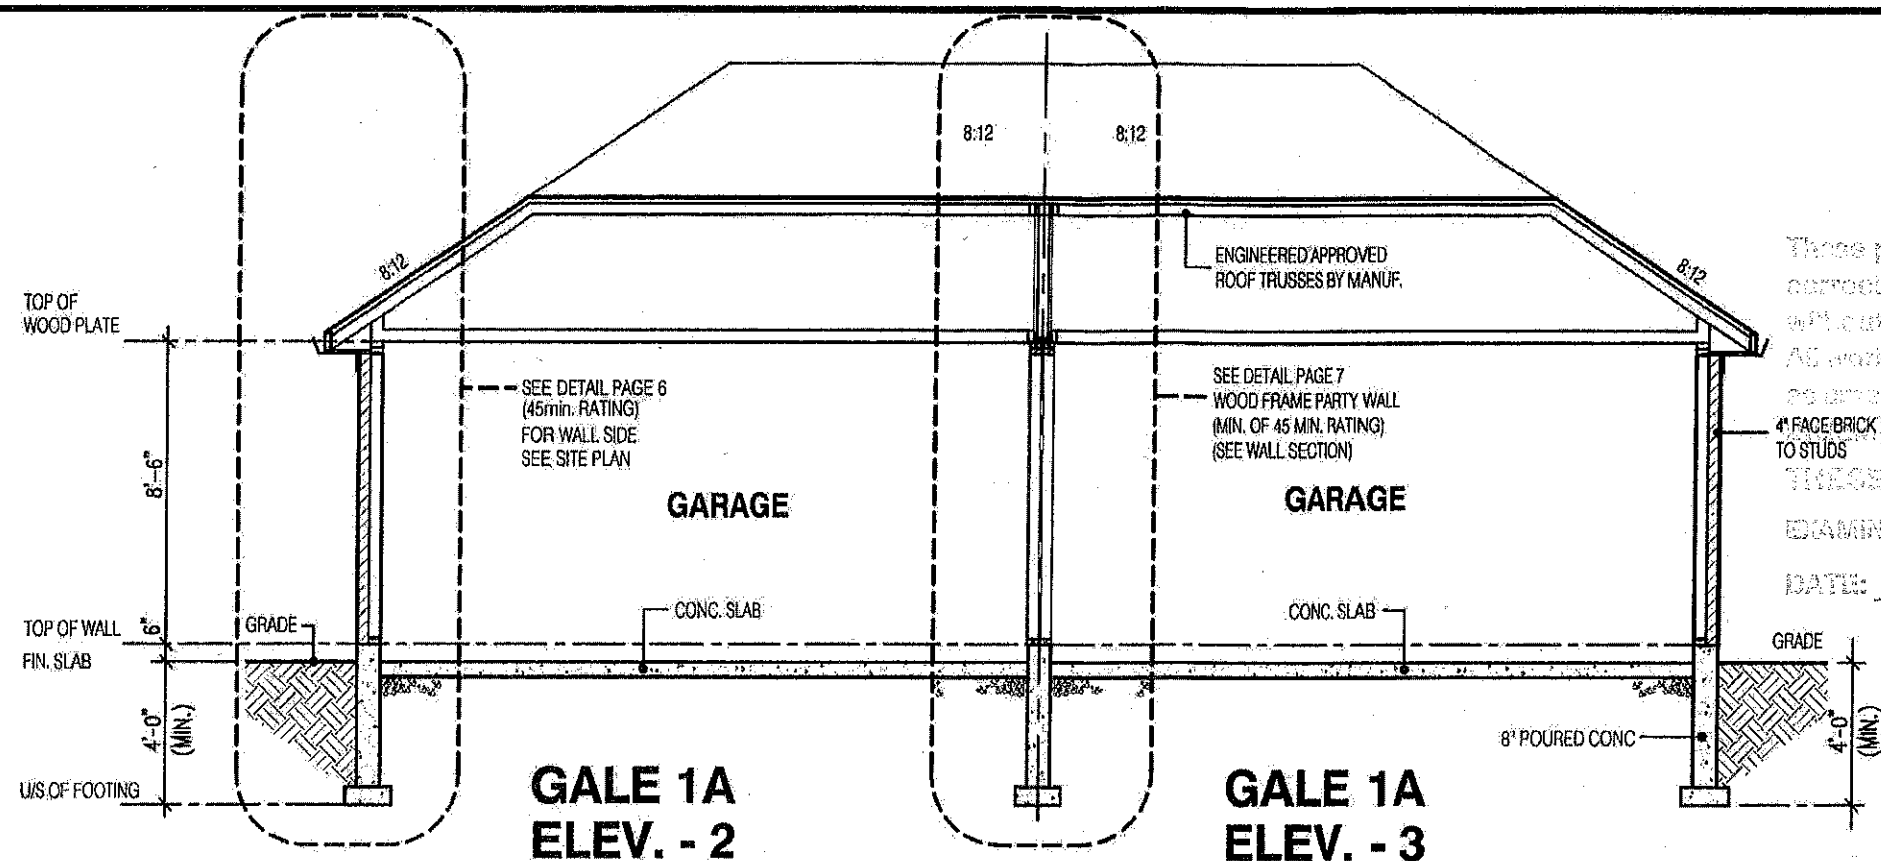

SECTION A-A

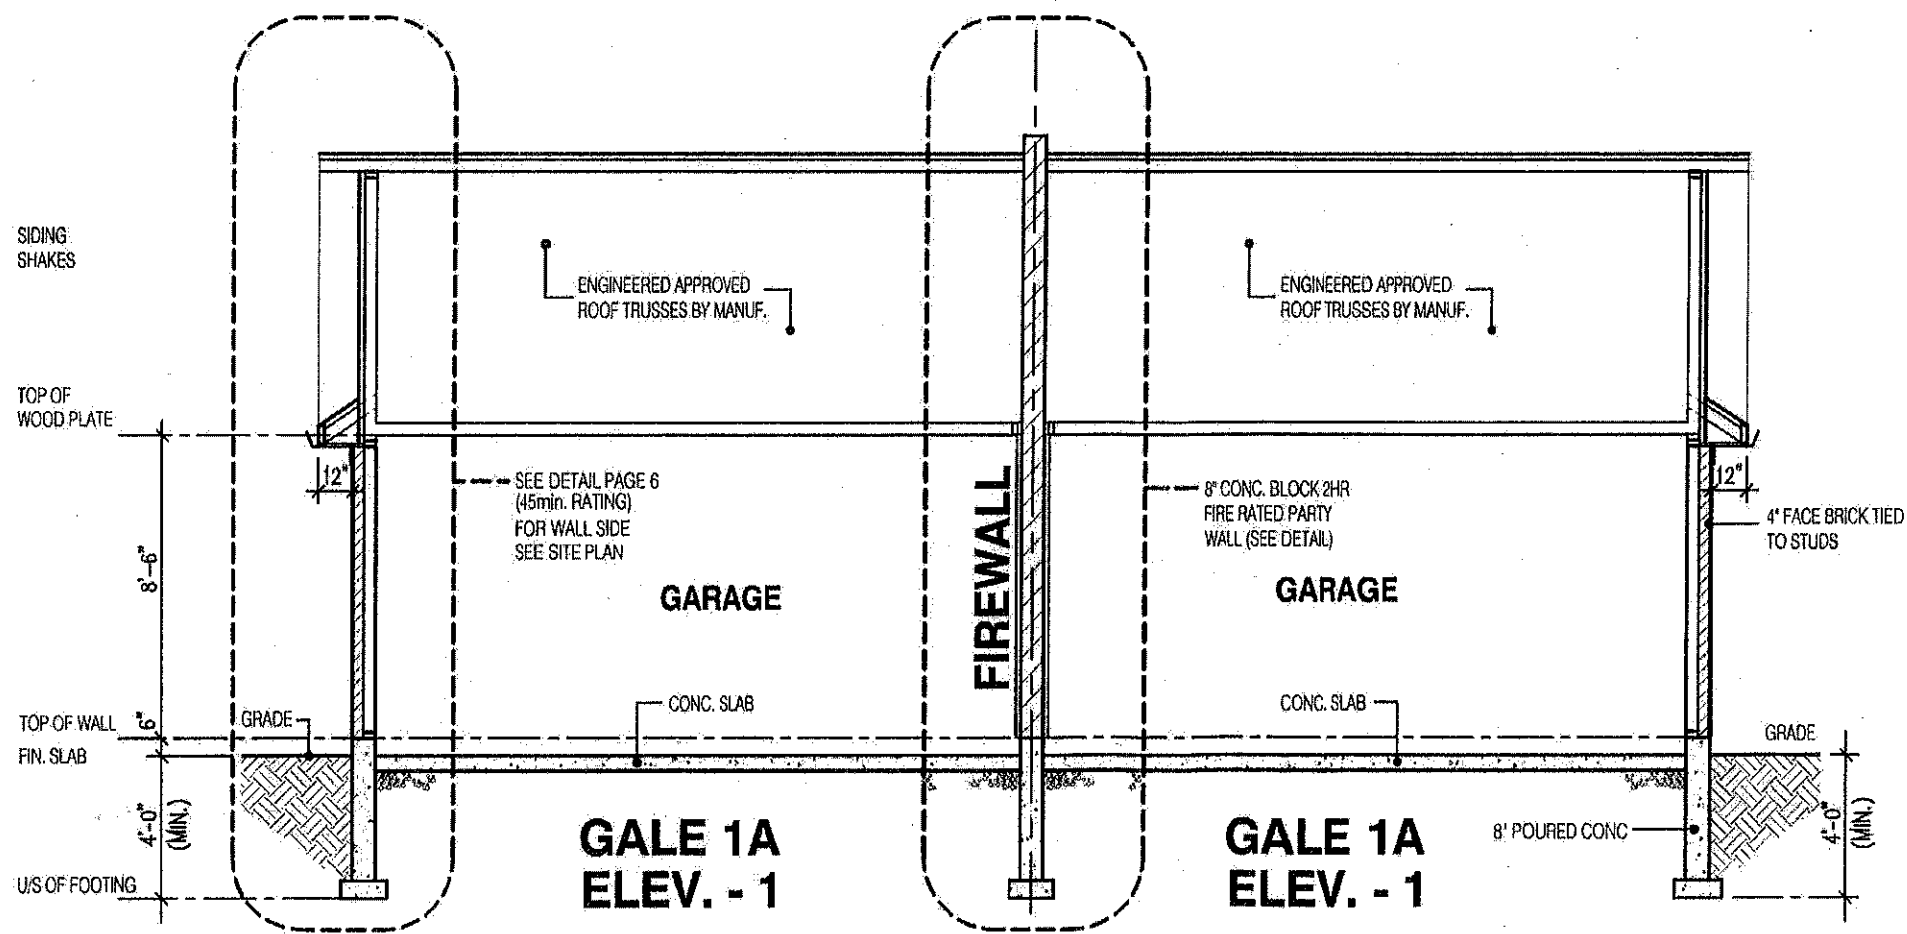

SECTION A-A

O.REG. 332/12

**GARAGE
GALE 1A
BLOCK 51
BLOCK 52**

TOWN OF EAST GWILLIMBURY
Building Department

These plans have been reviewed for use with the
corrections as noted. No other changes may be made
without written approval of the Building Department.
All work must comply with the Ontario Building Code,
as amended. These reviewed documents and the
original plans must be kept on site at all times.

THESE DOCUMENTS WERE REVIEWED

EXAMINED BY: *[Signature]*

DATE: _____

STRUDET INC.



FOR STRUCTURE ONLY

No: DATE: WORK DESCRIPTION:

jardin
DESIGN GROUP INC
64 JARDIN DR. SUITE 3A
VAUGHAN ONT. L4K 3P3
TEL: 905 660-3377 FAX: 905 660-3713
EMAIL: info@jardindesign.ca

The undersigned has reviewed and takes responsibility
for this design and has the qualifications and meets the
requirements set out in the Ontario Building Code to be
a designer

QUALIFICATION INFORMATION
Required unless design is exempt under Division C, Subsection
3.2.5 of the building code

Walter Boffer *[Signature]* 21031
NAME SIGNATURE BCIN

REGISTRATION INFORMATION
Required unless design is exempt under Division C, Subsection
3.2.4 of the building code

jardin design group inc. 27763
FIRM NAME BCIN

SECTION

SECONDO VALES ESTATES
TOWN OF EAST GWILLIMBURY

MODEL

SCALE

3/16" = 1'-0"

PROJ. No.

17-41

DWG. No.

6



FEB 15 2018

O.REG. 332/12

GARAGE
GALE 1ABLOCK 51
BLOCK 52

ROOF CONSTRUCTION

210 LB. (10.25kg/m²) ASPHALT SHINGLES, 3/8" (9.5 mm)
PLYWOOD SHEATHING WITH "H" CLIPS, APPROVED WOOD
TRUSSES @ 24" (600 mm) o.c. MAX., 2"x4" (38X89 mm) TRUSS
BRACING @ 6'-0" (1830 mm) o.c. AT BOTTOM CHORD, PREFIN.
ALUM. FASCIA, VENTED SOFFIT, EAVESTROUGH, & RWL.

BRICK VENEER EXTERIOR WALL CONSTRUCTION (2"x4")


4" (90MM) FACE BRICK, 7/8"x7"x0.03" (22 X 180 X 0.76 mm)
GALV. METAL TIES @ 16" (400 mm) o.c. HORIZONTAL 24" (600
mm) o.c. VERTICAL, 1" (25 mm) AIR SPACE, APPROVED
SHEATHING PAPER ON 3/8" (9.5 mm) EXT. GRADE SHEATHING
ON 2"x4" (38 X 89 mm) STUDS @ 16" (400 mm) o.c.
(MAX. HGT. - 9'-10" (3000 mm)) WITH APPROVED DIAGONAL
WALL BRACING, 1/2" (13 mm) INTERIOR DRYWALL FINISH.
PROVIDE WEEP HOLES @ 32" (800 mm) o.c. BOTTOM COURSE
AND OVER ALL OPENINGS. PROVIDE BASE WALL FLASHING UP
MIN. 6" (150 mm) BEHIND BUILDING PAPER.

SILL PLATE

2" X 4" (38 mm X 89 mm) SILL PLATE WITH 1/2" (13 mm) DIA.
ANCHOR BOLTS 8" (200 mm) LONG, EMBEDDED MIN. 4" (100
mm) INTO CONC. @ 7'-10" (2400 mm) o.c. CAULKING OR 1" (25
mm) MIN. MINERAL WOOL OR POLY GASKET BETWEEN PLATE
AND TOP OF FNDTN. WALL. USE MORTAR TO LEVEL SILL
PLATE WHEN REQUIRED.

FOUNDATION WALL/ FOOTING: OBC 9.15.3 & 9.15.4

8" (200 mm) POURED CONC. FNDTN. WALL 2200 PSI (15 MPa)
ON 20" x 6" POURED CONC. FOOTING TO REST ON NATURAL
UNDISTURBED SOIL OR COMPACTED ENGINEERED FILL WITH
MIN. BEARING CAPACITY OF 10.9 PSI (75 KPa) OR GREATER.

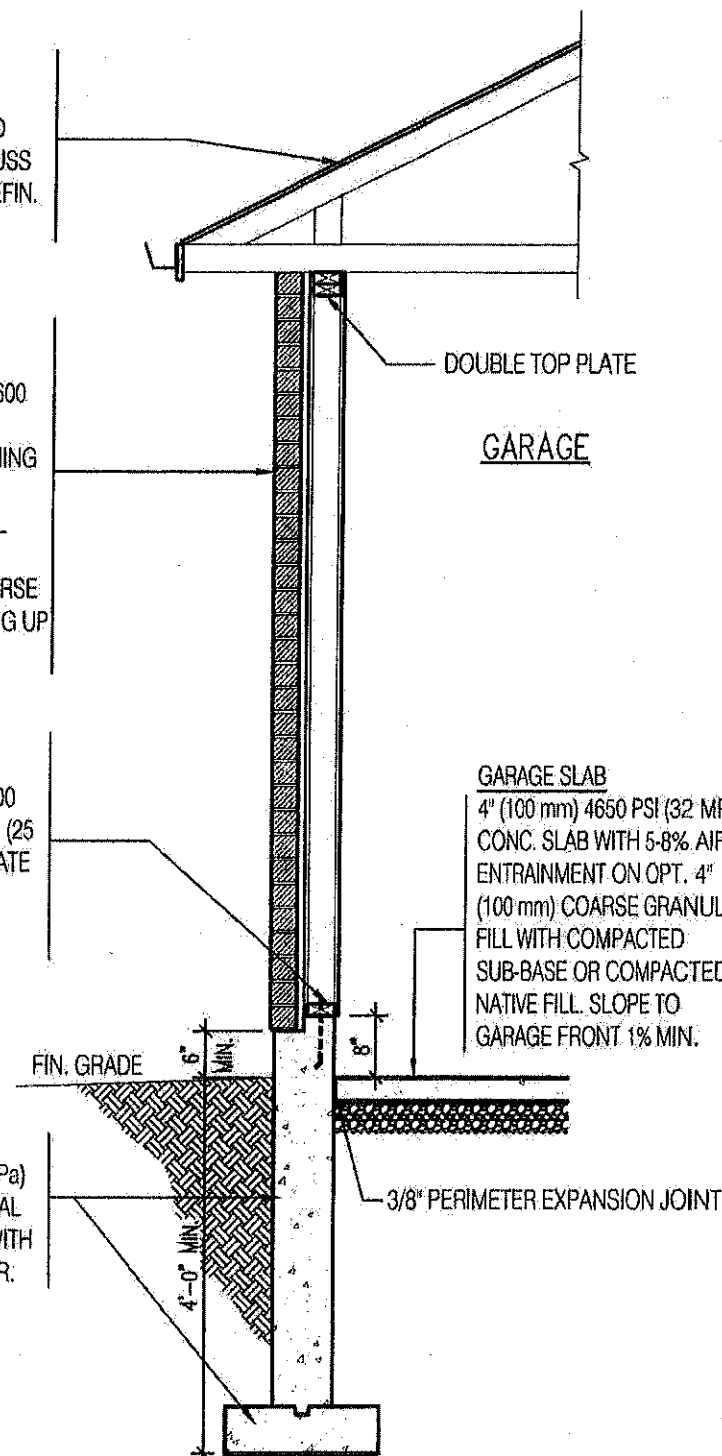

EXTERIOR WALL SECTION

ROOF CONSTRUCTION

210 LB. (10.25kg/m²) ASPHALT SHINGLES, 3/8" (9.5 mm)
PLYWOOD SHEATHING WITH "H" CLIPS, APPROVED WOOD
TRUSSES @ 24" (600 mm) o.c. MAX., 2"x4" (38X89 mm) TRUSS
BRACING @ 6'-0" (1830 mm) o.c. AT BOTTOM CHORD, PREFIN.
ALUM. FASCIA, VENTED SOFFIT, EAVESTROUGH, & RWL.

BRICK VENEER EXTERIOR WALL CONSTRUCTION (2"x4")


(45min. RATING)
4" (90MM) FACE BRICK, 7/8"x7"x0.03" (22 X 180 X 0.76 mm)
GALV. METAL TIES @ 16" (400 mm) o.c. HORIZONTAL 24" (600
mm) o.c. VERTICAL, 1" (25 mm) AIR SPACE, APPROVED
SHEATHING PAPER ON 3/8" (9.5 mm) EXT. GRADE SHEATHING
ON 2"x4" (38 X 89 mm) STUDS @ 16" (400 mm) o.c.
(MAX. HGT. - 9'-10" (3000 mm)) WITH APPROVED DIAGONAL
WALL BRACING, 1/2" (13 mm) TYPE "X" GYPSUM BOARD. ALL
JOINTS TO BE TAPED AND SEALED. ALL EDGES TO BE
SUPPORTED. FASTENER TYPES AND SPACING SHALL
CONFORM TO CSA-A82.31-M.
PROVIDE WEEP HOLES @ 32" (800 mm) o.c. BOTTOM COURSE
AND OVER ALL OPENINGS. PROVIDE BASE WALL FLASHING
UP MIN. 6" (150 mm) BEHIND BUILDING PAPER.

SILL PLATE

2" X 4" (38 mm X 89 mm) SILL PLATE WITH 1/2" (13 mm) DIA.
ANCHOR BOLTS 8" (200 mm) LONG, EMBEDDED MIN. 4" (100
mm) INTO CONC. @ 7'-10" (2400 mm) o.c. CAULKING OR 1" (25
mm) MIN. MINERAL WOOL OR POLY GASKET BETWEEN PLATE
AND TOP OF FNDTN. WALL. USE MORTAR TO LEVEL SILL
PLATE WHEN REQUIRED.

FOUNDATION WALL/ FOOTING: OBC 9.15.3 & 9.15.4

8" (200 mm) POURED CONC. FNDTN. WALL 2200 PSI (15 MPa)
ON 20" x 6" POURED CONC. FOOTING TO REST ON NATURAL
UNDISTURBED SOIL OR COMPACTED ENGINEERED FILL WITH
MIN. BEARING CAPACITY OF 10.9 PSI (75 KPa) OR GREATER.

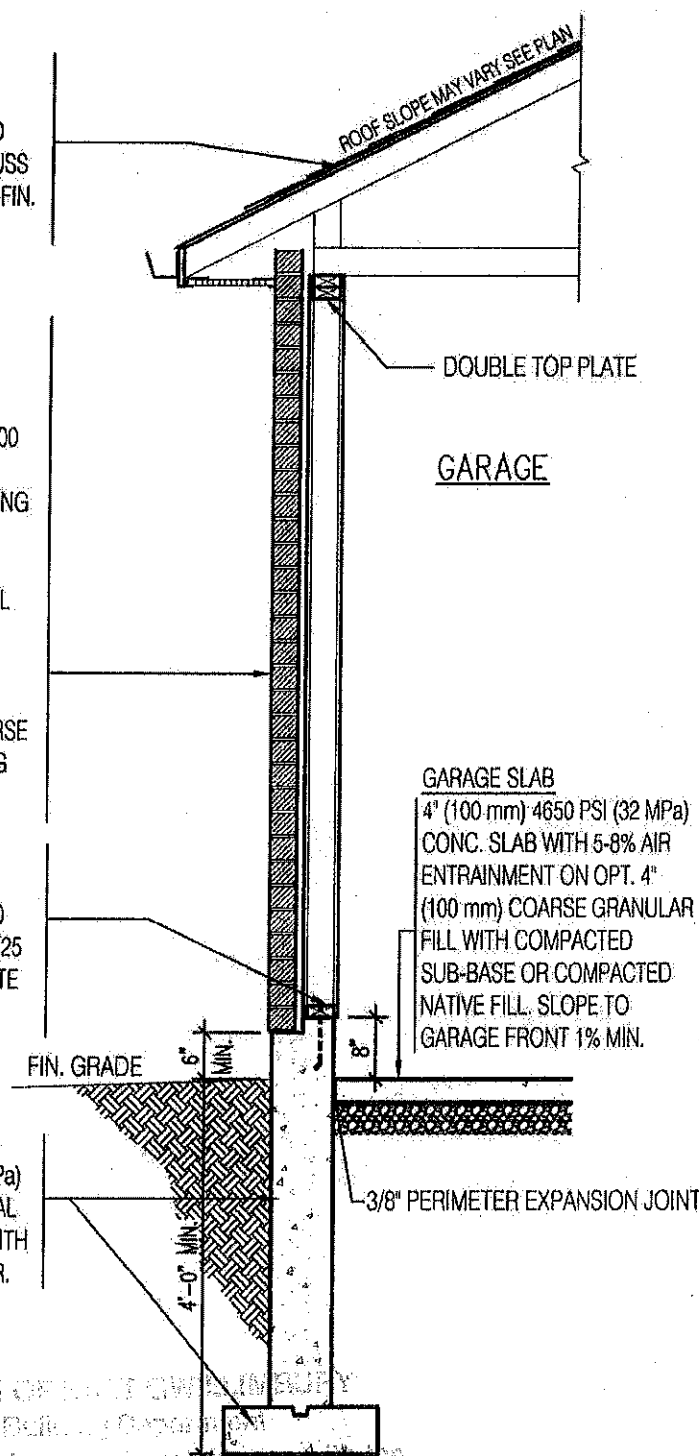EXTERIOR WALL SECTION
(45min. RATING)

STRUDET INC.



FOR STRUCTURE ONLY

DATE:

THESE DOCUMENTS WERE REVIEWED AND
EXAMINED BY: *[Signature]* FEB 15 2018

THE CONTRACTOR SHALL CHECK AND VERIFY ALL DIMENSIONS AND
CONDITIONS ON SITE BEFORE PROCEEDING WITH CONSTRUCTION.
ANY DISCREPANCIES SHALL BE REPORTED TO JARDIN DESIGN GROUP
INC. PRIOR TO COMMENCEMENT OF WORK.

JARDIN DESIGN GROUP INC. IS NOT RESPONSIBLE FOR THE ACCURACY
OF SURVEY, STRUCTURAL OR ENGINEERING INFORMATION SHOWN ON
THESE DRAWINGS OR FOR CONSTRUCTION STARTED PRIOR TO THE
ISSUANCE OF A BUILDING PERMIT. REFER TO THE APPROPRIATE
ENGINEERING DRAWINGS BEFORE PROCEEDING WITH WORK.

AS CONSTRUCTED, INVERTS MUST BE VERIFIED PRIOR TO POURING
FOOTINGS.

JARDIN DESIGN GROUP INC. HAS NOT BEEN RETAINED TO CARRY OUT
GENERAL REVIEW OF THE WORK AND ASSUMES NO RESPONSIBILITY
FOR THE FAILURE OF THE CONTRACTOR OR SUB CONTRACTOR TO
CARRY OUT THE WORK IN ACCORDANCE WITH THE CONTRACT
DOCUMENTS.

THIS DRAWING IS AN INSTRUMENT OF SERVICE, IS PROVIDED BY AND IS
THE PROPERTY OF JARDIN DESIGN GROUP INC. THIS DRAWING IS NOT
TO BE SCALED.

7		
6		
5		
4		
3		
2	DEC. 21, 2017	ISSUED FOR BUILDING PERMIT
1	OCT. 25, 2017	ISSUED TO CLIENT FOR REVIEW

No. DATE: WORK DESCRIPTION:

jardin
DESIGN GROUP INC
64 JARDIN DR. SUITE 3A
VAUGHAN ONT. L4K 3P3
TEL: 905 660-3377 FAX: 905 660-3713
EMAIL: info@jardindesign.ca

The undersigned has reviewed and takes responsibility
for this design and has the qualifications and meets the
requirements set out in the Ontario Building Code to be
a designer.

QUALIFICATION INFORMATION
Required unless design is exempt under Division C, Subsection
3.2.5 of the building code

Walter Botter *[Signature]* 21031
NAME SIGNATURE BCIN

REGISTRATION INFORMATION
Required unless design is exempt under Division C, Subsection
3.2.4 of the building code

jardin design group inc. 27763
FIRM NAME BCIN

WALL SECTION

SECONDO VALES ESTATES
TOWN OF EAST GWILLIMBURY

BILD	MODEL	----
	SCALE	3/16" = 1'-0"
	PROJ. No.	DWG. No.
	17-41	7

O.REG. 332/12

GARAGE

GALE 1A

BLOCK 51

BLOCK 52

ASPHALT SHINGLES (CSA-A123.1/A123.5) ON 3/8" (9.5mm) OR 7/16" (11.1mm) PLYWOOD SHEATHING * USE H-CLIPS FOR TRUSSES * FASTEN SHEATHING @ MAXIMUM SPACING OF 150mm ALONG EDGES & INTERMEDIATE SUPPORTS (9.23.3.5. O.B.C.)

PRE-ENGINEERED ROOF TRUSSES BY TRUSS MFG. @ 24" (610mm) O.C.

FIRE WALL TO EXTEND MIN. 6" (150mm) ABOVE FINISHED ROOF SURFACE (SEE 3.10.1.4. O.B.C.)

TYPICAL ROOF CONSTRUCTION

1/2" TYPE 'X' GYPSUM BOARD TIGHTLY SEALED TO U/S OF ROOF SHEATHING

2"x4" WOOD STUDS AT MAX. 16" O.C.

DOUBLE TOP PLATE

B6d LOADBEARING WALL AS PER SUPPLEMENTARY STANDARD SB-3 TABLE 1 *

7 1/2" (190mm) HOLLOW CONCRETE BLOCK (NORMAL WEIGHT AGGREGATE) (MIN 2 HR) * FIRE RESISTANCE RATING PROVIDED FOR ASSEMBLY IS 2.5 HOURS * MINIMUM FIRE RESISTANCE RATING REQ'D IS 2 HRS (AS PER SENTENCE 3.1.10.2.(2) OF O.B.C.) * 2"x2" (38mmx38mm) VERTICAL WOOD STRAPPING ON EACH SIDE * 1 1/2" (38mm) ABSORPTIVE MATERIAL FILLING STRAPPING SPACE ON EACH SIDE (SEE NOTE (4) TO TABLE 1) * 1 LAYER OF 1/2" (12.7mm) TYPE 'X' GYPSUM BOARD ON EACH SIDE (SEE NOTE (5) TO TABLE 1) * STC RATING PROVIDED IS 59 * STC RATING REQ'D IS 50 (AS PER SENTENCE 9.11.2.1.(1) O.B.C.)

GARAGE

GARAGE

PARTY WALL CONSTRUCTION (2"x4") (45min. RATING) OBC WALL TYPE W131

TWO ROWS 2"x4" (38mmx89mm) WOOD STUDS EACH SPACED 16" O.C. ON SEPARATE 2"x4" (38mmx89mm) SILL PLATES SET 1" APART. 1/2" TYPE 'X' GYPSUM BOARD ON EACH SIDE. ALL JOINTS TO BE TAPED AND SEALED. ALL EDGES TO BE SUPPORTED. FASTENER TYPES AND SPACING SHALL CONFORM TO CSA-A82.31-M.

SILL PLATE SEPARATE 2" X 4" (38 mm X 89 mm) SET APART 1" SILL PLATE WITH 1/2" (13 mm) DIA. ANCHOR BOLTS 8" (200 mm) LONG, EMBEDDED MIN. 4" (100 mm) INTO CONC. @ 7'-10" (2400 mm) o.c., CAULKING OR 1" (25 mm) MIN. MINERAL WOOL OR POLY GASKET BETWEEN PLATE AND TOP OF FND'TN. WALL. USE MORTAR TO LEVEL SILL PLATE WHEN REQUIRED.

GARAGE SLAB 4" (100 mm) 4650 PSI (32 MPa) CONC. SLAB WITH 5-8% AIR ENTRAINMENT ON OPT. 4" (100 mm) COARSE GRANULAR FILL WITH COMPACTED SUB-BASE OR COMPACTED NATIVE FILL. SLOPE TO GARAGE FRONT 1% MIN.

GARAGE SLAB 4" (100 mm) 4650 PSI (32 MPa) CONC. SLAB WITH 5-8% AIR ENTRAINMENT ON OPT. 4" (100 mm) COARSE GRANULAR FILL WITH COMPACTED SUB-BASE OR COMPACTED NATIVE FILL. SLOPE TO GARAGE FRONT 1% MIN.

3/8" PERIMETER EXPANSION JOINT


8" POURED CONC. FOUNDATION WALL

FIRE WALL SECTION

3/8" PERIMETER EXPANSION JOINT

8" POURED CONC. FOUNDATION WALL

STRUDET INC.

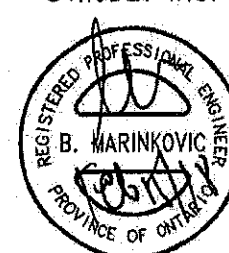

FOR STRUCTURE ONLY

GARAGE

GARAGE

TOWN OF EAST GWILLIMBURY

Building Department

These plans have been reviewed for use with the corrections as noted. No other changes may be made without written approval of the Building Department. All work must comply with the Ontario Building Code, as amended. These reviewed documents and the Building Permit must be kept on site at all times.

THESE DOCUMENTS HAVE BEEN REVIEWED AND EXAMINED BY: *[Signature]*

DATE: _____



PARTY WALL SECTION

FEB 15 2018

THE CONTRACTOR SHALL CHECK AND VERIFY ALL DIMENSIONS AND CONDITIONS ON SITE BEFORE PROCEEDING WITH CONSTRUCTION. ANY DISCREPANCIES SHALL BE REPORTED TO JARDIN DESIGN GROUP INC. PRIOR TO COMMENCEMENT OF WORK.

JARDIN DESIGN GROUP INC. IS NOT RESPONSIBLE FOR THE ACCURACY OF SURVEY, STRUCTURAL OR ENGINEERING INFORMATION SHOWN ON THESE DRAWINGS OR FOR CONSTRUCTION STARTED PRIOR TO THE ISSUANCE OF A BUILDING PERMIT. REFER TO THE APPROPRIATE ENGINEERING DRAWINGS BEFORE PROCEEDING WITH WORK.

AS CONSTRUCTED INVERTS MUST BE VERIFIED PRIOR TO POURING FOOTINGS.

JARDIN DESIGN GROUP INC. HAS NOT BEEN RETAINED TO CARRY OUT GENERAL REVIEW OF THE WORK AND ASSUMES NO RESPONSIBILITY FOR THE FAILURE OF THE CONTRACTOR OR SUB CONTRACTOR TO CARRY OUT THE WORK IN ACCORDANCE WITH THE CONTRACT DOCUMENTS.

THIS DRAWING IS AN INSTRUMENT OF SERVICE, IS PROVIDED BY AND IS THE PROPERTY OF JARDIN DESIGN GROUP INC. THIS DRAWING IS NOT TO BE SCALED.

7		
6		
5		
4		
3		
2	DEC. 21, 2017	ISSUED FOR BUILDING PERMIT
1	OCT. 25, 2017	ISSUED TO CLIENT FOR REVIEW

No: DATE: WORK DESCRIPTION:

jardin
DESIGN GROUP INC

64 JARDIN DR. SUITE 3A
VAUGHAN ONT. L4K 3P3
TEL: 905 660-3377 FAX: 905 660-3713
EMAIL: info@jardindesign.ca

The undersigned has reviewed and takes responsibility for this design and has the qualifications and meets the requirements set out in the Ontario Building Code to be a designer.

QUALIFICATION INFORMATION
Required unless design is exempt under Division C, Subsection 3.2.5 of the building code

Walter Botter *[Signature]* 21031
NAME SIGNATURE BCIN

REGISTRATION INFORMATION
Required unless design is exempt under Division C, Subsection 3.2.4 of the building code

jardin design group inc. 27763
FIRM NAME BCIN

WALL SECTION

SECONDO VALES ESTATES
TOWN OF EAST GWILLIMBURY



MODEL:	----
SCALE:	3/16" = 1'-0"
PROJ. No.	17-41
DWG. No.	8