

CONSTRUCTION SUMMARY

Mountainview Heights (G) - Russell Gardens Building Ltd.

RECEIVED JUN 11 2019

PURCHASER: GOWSIGAN PUSHPANANTHAN

TEL: RES.: 289-981-7004

LOT / PHASE 169 / 2	REG. PLAN # 62M-1238	HOUSE TYPE Sawmill 2 Elev 3		
------------------------	-------------------------	--------------------------------	--	--

CONSTRUCTION

1 - DELETE BULK HEADS IN KITCHEN IF CONSTRUCTION PERMITS 10Jun19 Note:	
---	--

ELECTRICAL

1 - PLUG - ELECTRICAL PLUG - TO BE INSTALLED OVER FIREPLACE 10Jun19 Note:	
1 - RELOCATE STANDARD KITCHEN LIGHT TO BE CENTERED OVER ISLAND 10Jun19 Note:	
1 - LIGHT AND SWITCH - NO FIXTURE INCLUDED - LIVING ROOM 10Jun19 Note:	

FIREPLACE AND ACCESSORIES

1 - GAS LINE ROUGH-IN FOR STOVE (INCLUDES ELECTRICAL OUTLET) - FIRST FLOOR 10Jun19 Note:	
---	--

PLUMBING

1 - WATER LINE FOR FRIDGE - ROUGH-IN ONLY 10Jun19 Note:	
--	--


PROMOTIONAL

1 - PARTIAL REDEMPTION OF PROMOTIONAL PACKAGE \$8690.00 BALANCE FORWARD TO BE USED AT A LATER DATE. ORIGINAL PROMOTIONAL PACKAGE OF \$10,000.00 AS PER SCHEDULE PE 10Jun19 Note:	
---	--


This Document is Extremely Time Sensitive - Printed 10 Jun 19 at 16:03

Relocate Std Light


Add Plug Above Fireplace

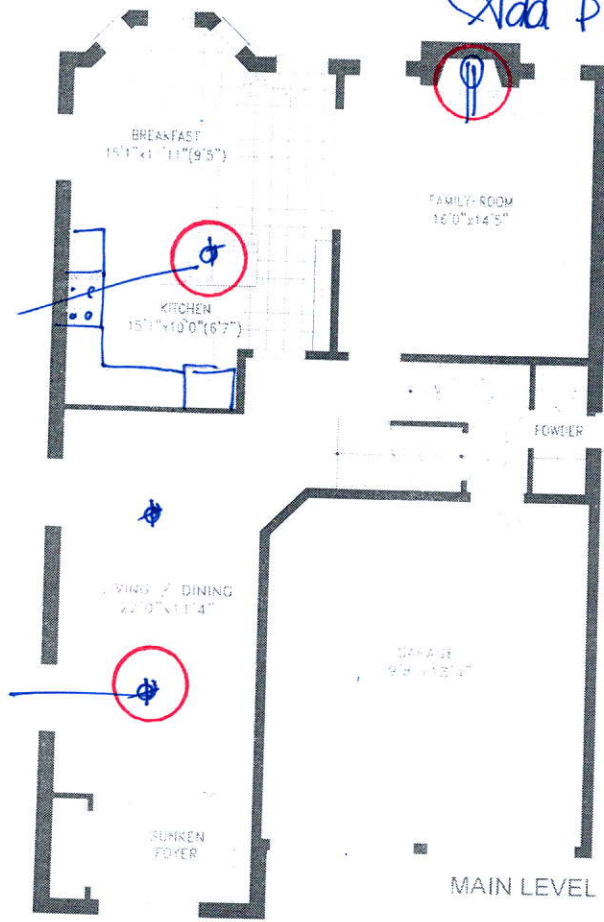

Add Light

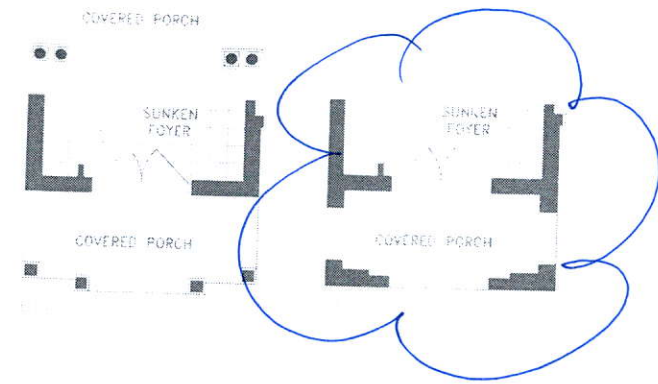

P-6

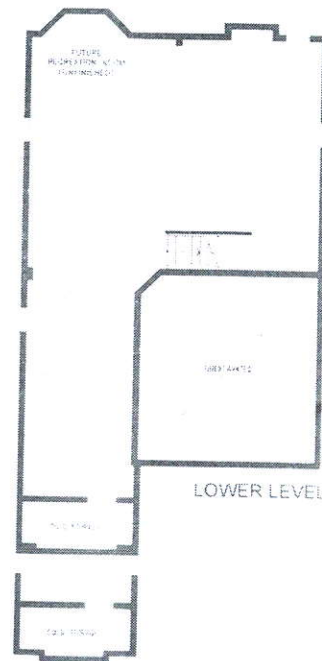

LOWER LEVEL

SAWMILL 2
2,654 SQ.FT.

