

CONSTRUCTION SUMMARY					
Mountainview Heights (G) - Russell Gardens Building Ltd.					
PURCHASER: INVENTORY HOME_2_170					TEL:
LOT / PHASE	REG. PLAN #	HOUSE TYPE			
170 / 2	62M-1238	Sawmill 2 Elev 1			

CABINETRY

1 - KITCHEN- UPGRADE 2 CABINETS	
06Sep19 Note:	

CABINETRY ACCESSORIES

1 - KITCHEN- STOVE WALL- EXTEND UPPER AND BASE CABINETS TO WINDOW	
06Sep19 Note:	
1 - KITCHEN CABINETRY UPPER - GLASS DOOR - GLK340 CORD GLASS - FINISHED INTERIOR - FITS TALL UPPER CABINETS ONLY - PRICE IS PER DOOR - UPGRADE 2	
06Sep19 Note:	
1 - KITCHEN CABINETRY UPPER - ANGLED CORNER CABINET - FITS TALL UPPER CABINETS - PER UNIT - UPGRADE 2	
06Sep19 Note:	
1 - KITCHEN CABINETRY UPPER - FULL DEPTH ABOVE FRIDGE - WITH GABLES - 600MM - PRICE IS EACH - UPGRADE 2	
06Sep19 Note:	

CERAMIC TILE

1 - MASTER ENSUITE- UPGRADE 1 TILES- FLOOR ONLY	
06Sep19 Note:	
1 - UPGRADE 1 TILES IN ALL TILED AREAS- FIRST FLOOR	
06Sep19 Note:	

COUNTER TOP

1 - KITCHEN- COUNTERTOP EXTEND ON STOVE WALL TO MATCH CABINET EXTENSION- SEE SKETCH	
06Sep19 Note:	
1 - ALL BATHROOMS TO HAVE HARDSURFACE STONE COUNTERTOPS WITH TECO UNDERMOUNT SINKS	
06Sep19 Note:	
1 - KITCHEN- QUARTZ COUNTERTOP WITH TECO UNDERMOUNT SINK	
06Sep19 Note:	

HARDWOOD FLOORING

1 - SECOND FLOOR- UPGRADE 1 LAMINATE	
06Sep19 Note:	
1 - FIRST FLOOR- PROMO HARDWOOD THROUGHOUT- 4 7/16	
06Sep19 Note:	

STAIRS AND RAILINGS

1 - V-GROOVE HANDRAIL	
06Sep19 Note:	
1 - STAINED STAIRS, RAILING AND PICKETS – STANDARD STAIRCASE - PRICE IS PER SET	
06Sep19 Note:	

This Document is Extremely Time Sensitive - Printed 6 Sep 19 at 11:03

RECEIVED SEP 09 2019

Purchaser:INVENTORY HOME_2_170

Property:170

Telephone Res. / Bus: /

Project:Russell Gardens Building Ltd.

Decor Advisor:Natalie Mancuso

Model and Elevation:Sawmill 2 Elev 1

Lock Date:6-Sep-196-Sep-19

Plan #:62M-1238

Layout Changes:☐ Yes☒ No

Sketch Attached:☒ Yes☐ No

Exterior Colour Scheme:

1. Cabinetry

	Style and Colour	Hardware
Kitchen / Breakfast	HAMPTON W823XZ4	447SA
Laundry Room	ELISSE	Standard
Powder Room	MONACO W823XZ4	411SB
Master Ensuite Bathroom	MONACO W823XZ4	411SB
Ensuite Bath - Bedroom 2	EVEREST WHITE	411SB
Ensuite Bath - Bedroom 3/4	MONACO W821XZ4	411SB

Appliances:

Built In Appliances☐ Yes☒ No

Slide In Stove☐ Yes☒ No

Dishwasher Cabinet

☐ Closed☒ Open

41" Upper Cabinets☒ Yes☐ No

Please NOTE: Standard Cabinet Height is 30"

Stove Opening

NOTE: If not specified, opening will be set to builder's standard opening of approximately 30" width

Fridge Opening

NOTE: If not specified, opening will be set to builder's standard opening of approximately 37" width x 74" height

** Refer to Construction Summary

2. Counters

	Counter	Edge
Kitchen / Breakfast	QUARTZ- FUSION WHITE	#360 EDGE
Laundry Room	N/A	
Powder Room	MARBLE- BIANCO CARRARA	#360 EDGE
Master Ensuite Bathroom	QUARTZ- FROST CARRARA	#360 EDGE
Ensuite Bath - Bedroom 2	GRANITE- MISTY NIGHT	#360 EDGE
Ensuite Bath - Bedroom 3/4	QUARTZITE- CALCATTA SM	#360 EDGE

** Refer to Construction Summary

Purchaser:

INVENTORY HOME_2_170

Telephone Res. / Bus:

/

Decor Advisor:

Natalie Mancuso

Lock Date:

6-Sep-19

Property:

170

Project:

Russell Gardens Building Ltd.

Model and Elevation:

Sawmill 2 Elev 1

Plan #:

62M-1238

3. Ceramic Flooring

		At a 45	Threshold-If App.
Entrance Vestibule	TILE- STONE WHITE 12X24	<input type="checkbox"/>	Metal Strip Where Applic.
Main Hall	HARDWOOD	<input type="checkbox"/>	
Kitchen / Breakfast	TILE- STONE WHITE 12X24	<input type="checkbox"/>	
Laundry Room	TILE- ESSENZE GRIGIO 13X13	<input type="checkbox"/>	
Powder Room	TILE- STONE WHITE 12X24	<input type="checkbox"/>	
Master Ensuite Bathroom	TILE- PALLISANDRO WHITE 12X24	<input type="checkbox"/>	
Ensuite Bath - Bedroom 2	TILE- RETRO WHITE 12X12	<input type="checkbox"/>	
Ensuite Bath - Bedroom 3/4	TILE- RAINBOW WHITE 13X13	<input type="checkbox"/>	
		<input type="checkbox"/>	
		<input type="checkbox"/>	
		<input type="checkbox"/>	

** Refer to Construction Summary

4. Ceramic Wall Tile

Master Ensuite Bathroom	Selection	Describe
Tub Deck Wall		
Tub Deck		
Tub Deck Skirt		
Shower Stall	TILE- LUC CONCEPT NEVE 8X16	
Bathtub Enclosure Walls		
Ensuite Bath - Bedroom 2	TILE- SAT BLANC GROENLANDIA 8X16	
Ensuite Bath - Bedroom 3/4	TILE- MARVEL GREY 10X13 VERTICAL	
Kitchen Backsplash		

** Refer to Construction Summary - STANDARD GROUT THROUGHOUT UNLESS SPECIFIED

5. Plumbing Fixtures

All Bathrooms

White

Whirlpool

☐ Yes ☒ No

Dishwasher Rough-In

☒ Yes ☐ No

Waterline for Fridge

☐ Yes ☒ No

** Refer to Construction Summary

6. Trim Carpentry

Interior Doors	800 SERIES
Interior Trim	3" BB CASING WITH 5 1/4" BASEBOARD - COLONIAL
Door Handles	SATIN NICKEL LEVER
Exterior Front Door Handle	As Per Construction Specifications

** Refer to Construction Summary

Property: 170

Project: Russell Gardens Building Ltd.

Model and Elevation: Sawmill 2 Elev 1

6-Sep-19

Plan #: 62M-1238

7. Other flooring

Main Hall	HARDWOOD- MIRAGE 4 7 16 MAPLE- CHARCOAL- CASHMERE
Living Room	HARDWOOD- MIRAGE 4 7 16 MAPLE- CHARCOAL- CASHMERE
Dining Room	HARDWOOD- MIRAGE 4 7 16 MAPLE- CHARCOAL- CASHMERE
Family Room	HARDWOOD- MIRAGE 4 7 16 MAPLE- CHARCOAL- CASHMERE
Den / Library / Study	
Basement Landing(If Applies)	
Lower Landing (If Applies)	TILE- STONE WHITE 12X24
Upper Landing	HARDWOOD- MIRAGE 4 7 16 MAPLE- CHARCOAL- CASHMERE
Upper Hall	HARDWOOD- MIRAGE 4 7 16 MAPLE- CHARCOAL- CASHMERE
Master Bedroom	LAMINATE- TORLYS- FJORD- ASTRID OAK TL-NEUM06
Bedroom #2	LAMINATE- TORLYS- FJORD- ASTRID OAK TL-NEUM06
Bedroom #3	LAMINATE- TORLYS- FJORD- ASTRID OAK TL-NEUM06
Bedroom #4	LAMINATE- TORLYS- FJORD- ASTRID OAK TL-NEUM06
Bedroom #5	

Underpad	Type	Area

**** Refer to Construction Summary**

8. Railings and Pickets

Railing Type	V-GROOVE	Colour	MIRAGE- CHARCOAL
Picket Type	1 3/4 PICKETS COLONIAL	Colour	MIRAGE- CHARCOAL
Stringer / Riser	AS PER CONSTRUCTION SPECIFICATIO	Colour	MIRAGE- CHARCOAL
Treads	AS PER CONSTRUCTION SPECIFICATIO	Colour	MIRAGE- CHARCOAL
Red Oak Stairs with Semi Gloss Finish		<input checked="" type="radio"/> Yes <input type="radio"/> No	

**** Refer to Construction Summary**

9. Wall Paint Flat Finish

Main & Upper Hall	22 WARM GREY	Master Bedroom	22 WARM GREY
Living Room	22 WARM GREY	Bedroom #2	22 WARM GREY
Dining Room	22 WARM GREY	Bedroom #3	22 WARM GREY
Kitchen / Breakfast	22 WARM GREY	Bedroom #4	22 WARM GREY
Family Room	22 WARM GREY	Bedroom #5	
Powder Room	22 WARM GREY	Master Ensuite	22 WARM GREY
Laundry Room	22 WARM GREY	Ensuite Bath - Bedroom 2	22 WARM GREY
Den/Library		Ensuite Bath - Bedroom 3/4	22 WARM GREY
Trim Paint-Semi Gloss	BIRCH WHITE		

Smooth Ceilings First Floor ☐ Yes ☒ No

**** Refer to Construction Summary**

Purchaser:INVENTORY HOME_2_170

Telephone Res. / Bus: /

Decor Advisor: Natalie Mancuso

Lock Date: 6-Sep-19

Property: 170

Project: Russell Gardens Building Ltd.

Model and Elevation: Sawmill 2 Elev 1

Plan #: 62M-1238

10. Plaster Mouldings and Medallions

Entrance Vestibule			Kitchen/Breakfast		
Main Hall			Den/Library		
Living Room			Lower Landing		
Dining Room					
Family Room					

** Refer to Construction Summary

11. Fireplace

Living Room	Family Room	Other Room - Specify
Purchased <input type="radio"/> As Per Plan <input type="radio"/> N/A <input checked="" type="radio"/>	Purchased <input type="radio"/> As Per Plan <input checked="" type="radio"/> N/A <input type="radio"/>	Purchased <input type="radio"/> As Per Plan <input type="radio"/> N/A <input checked="" type="radio"/>

Fireplace Type	FLAT ON WALL	
Mantle Type	MANTLE M2-STANDARD	
Colour / Stain	AS PER CONSTRUCTION SPECIFICATIONS	
Surround	GRIGIO CARNICO	
Hearth	NO	

** Refer to Construction Summary

12. Heating and Air Conditioning

Air Conditioning	NO	Gas Provisions Stove	NO
Gas Provisions Dryer	NO	Gas Provisions Barbecue	NO

Comment

** Refer to Construction Summary

13. Electrical

Plugs and Switches	<input checked="" type="radio"/> White	DECOR	Above Kitchen Cabinet Light	<input type="radio"/> Yes <input checked="" type="radio"/> No
Hood Fan	STANDARD WHITE		Below Kitchen Cabinet Light	<input type="radio"/> Yes <input checked="" type="radio"/> No
Appliances	Built in Cooktop	Built in Oven	Gas Stove	Microwave
	<input type="radio"/> Yes <input checked="" type="radio"/> No	<input type="radio"/> Yes <input checked="" type="radio"/> No	<input type="radio"/> Yes <input checked="" type="radio"/> No	<input type="radio"/> Yes <input checked="" type="radio"/> No
Dishwasher Rough-in	Yes			

** Refer to Construction Summary

14. General Comments

** Refer to Construction Summary

Disclaimers and Notes



- 1) Colours of all materials are as close as possible to builder's selection, but not necessarily identical due to variances in manufacturing.

2) Any extras listed above are null and void unless accompanied by a separate invoice/amendment. Said invoice must be paid in full.

3) The Purchaser agrees that this colour selection is final and that no changes will be permitted, unless required by the Vendor.

4) The Purchaser acknowledges reading and accepting document which contains other miscellaneous disclaimers.

Signature: _____ Date: _____

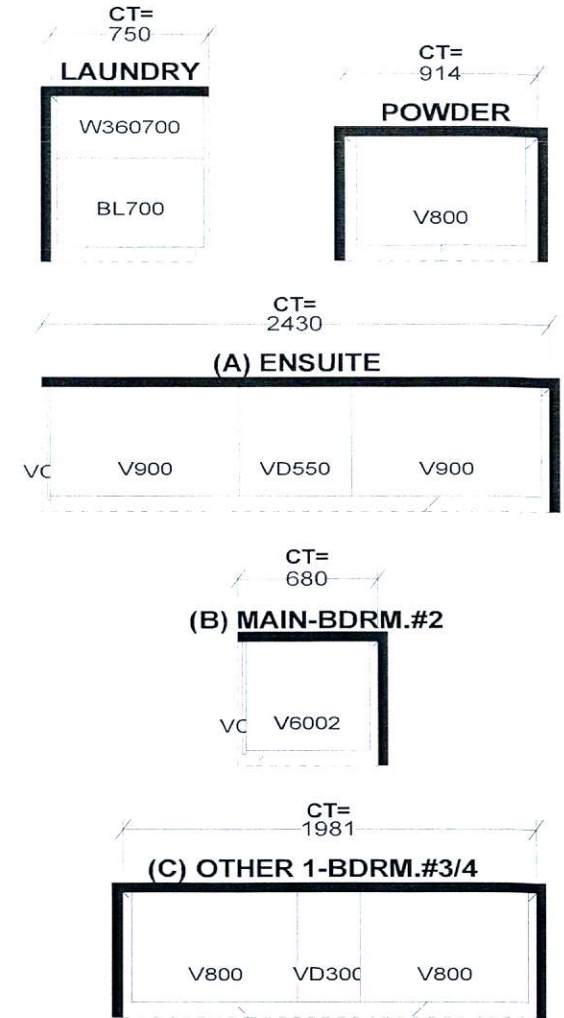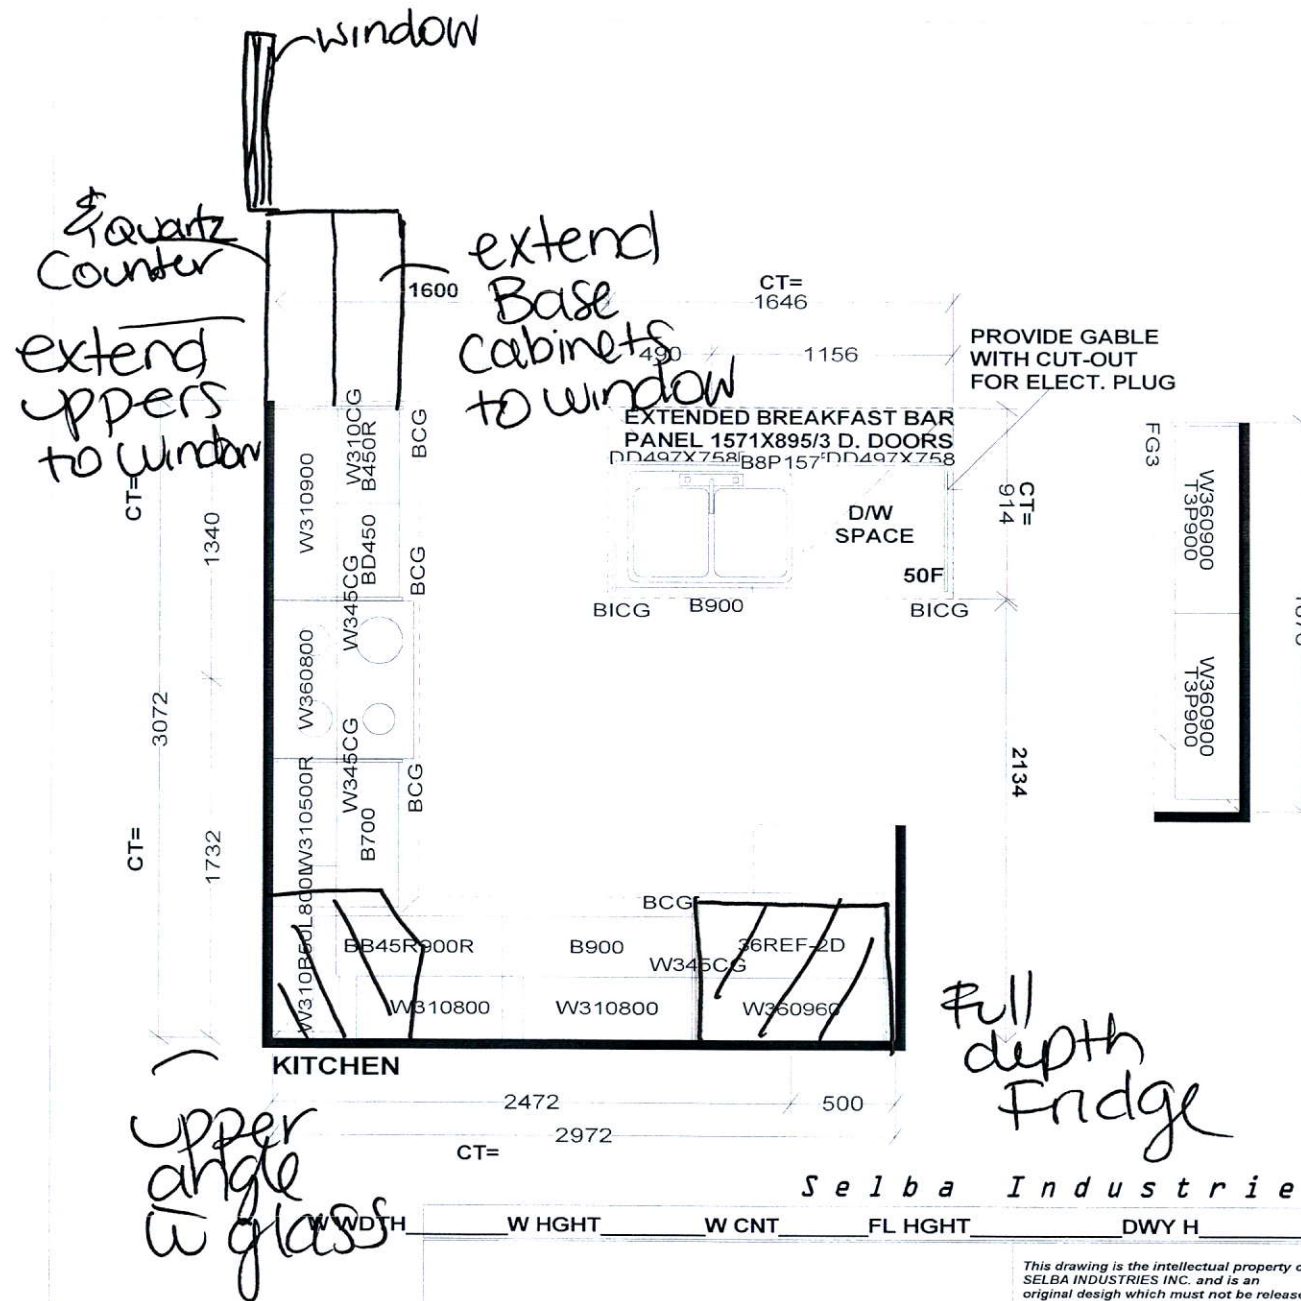

Selba Industries

W W D T H W H G H T W C N T F L H G H T D W Y H S T C E N T 2 X 4 V E N T B O X C O V E R

This drawing is the intellectual property of SELBA INDUSTRIES INC. and is an original design which must not be released or copied unless applicable fee has been paid or job order placed.



JOB NUMBER:
 BUILDER: GREENPARK
 SITE NAME: RUSSEL GARDENS PH.2
 MODEL: SAWMILL 2X ELEV 1,2,3
 LOT #:
 DESIGNER: KS
 DATE: SEPT 24 18

