PLAN SURVEYOR'S PART 1 OF LOT REAL 199 PROPERTY REPORT

PLAN 유 62M-1238 **HAMILTON**

300

R-PE SURVEYING LTD., O.L.S.

METRIC

DISTANCES SHOWN ON THIS PLAN ARE IN METRES
BE CONVERTED TO FEET BY DIVIDING BY 0.3048. AND CAN

PART 2 (SURVEY REPORT)

REGISTERED EASEMENTS AND/OR RIGHT-OF-WAYS: LOT 191 IS
SUBJECT TO AN EASEMENT IN GROSS AS SET OUT IN INST. No. WE1193623
THIS PLAN DOES NOT CERTIFY COMPLIANCE WITH ZONING BY-LAWS

SURVEYOR'S CERTIFICATE


CERTIFY THAT:
THIS SURVEY AND PLAN ARE CORRECT AND IN ACCORDANCE
WITH THE SURVEYS ACT, THE SURVEYORS ACT AND THE LAND
TITLES ACT AND THE REGULATIONS MADE UNDER THEM.
THE SURVEY WAS COMPLETED ON THE 3 ^{rd.} DAY OF JUNE

,2019.

DATE , 2019.

ONTARIO SURVEYOR

HUMPHREY (BY PLAN 62M-1238) STREET

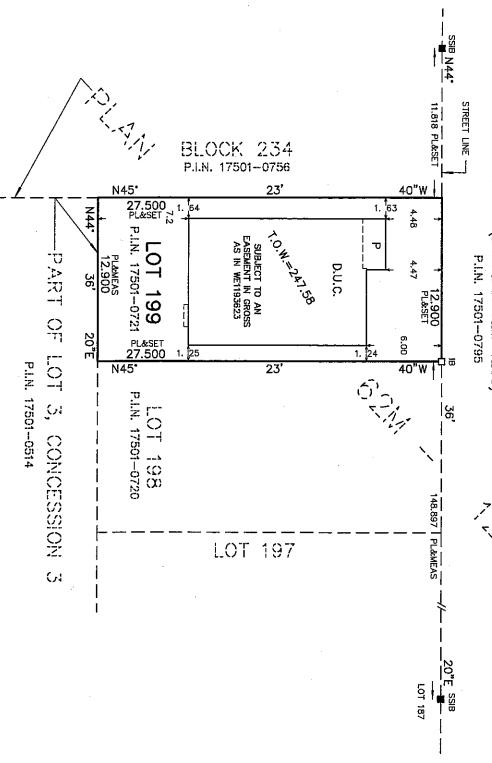

ASSOCIATION OF ONTARIO LAND SURVEYORS
PLAN SUBMISSION FORM 2101058

NOTES

DENOTES MONUMENT SET
DENOTES MONUMENT FOUND
DENOTES IRON BAR
DENOTES SHORT STANDARD IRON BAR
DENOTES DWELLING UNDER CONSTRUCTION
DENOTES PROPERTY IDENTIFIER NUMBER
DENOTES PORCH
DENOTES TOP OF WALL ELEVATION
DENOTES NORTHWEST

ALL TIES TO CONCRETE FOUNDATIONS ALL FOUND MONUMENTS BY J. D. BARNES LIMITED, O.L.S.

BEARINGS ARE GRID AND ARE REFERRED TO THE SOUTHEASTERLY LIMIT OF HUMPHREY STREET AS SHOWN ON PLAN 62M—1238 HAVING A BEARING OF N44"36'20"E.

THIS REPORT WAS PREPARED FOR GREENPARK HOMES
AND THE UNDERSIGNED ACCEPTS NO RESPONSIBILITY FOR USE BY OTHER PARTIES

SURVEYING LTD.,O.L.S.2019.



R-PE SURVEYNG LTD.
ONTARIO LAND SURVEYORS
643 Chrislea Road, Suite 7
Woodbridge, Ontario L4L 8/
Tel.(416)635-5000 Fax (4 . 8A3 < (416)635—5001 < (905)264—2099

Tel.(905)264-0881 Website: www.r-pe.ca 18-067 CHECKED: G.Y./T.S.
CAD FILE No.1238-199

Fax