

SURVEYOR'S REAL PROPERTY REPORT
PART 1
PLAN OF LOTS 6, 7, 8, 9 AND 10
PLAN 43M-2060
CITY OF BRAMPTON
REGIONAL MUNICIPALITY OF PEEL

SCALE 1:300
10m 5m 0 10m 20metres
R-PE SURVEYING LTD., O.L.S.
METRIC
DISTANCES SHOWN ON THIS PLAN ARE IN METRES AND CAN BE CONVERTED TO FEET BY DIVIDING BY 0.3048.


PART 2 (SURVEY REPORT)
REGISTERED EASEMENTS AND/OR RIGHT-OF-WAYS: LOTS 6 TO 10 ARE SUBJECT TO AN EASEMENT AS SET OUT IN PR1279464. THIS PLAN DOES NOT CERTIFY COMPLIANCE WITH ZONING BY-LAWS

SURVEYOR'S CERTIFICATE

I CERTIFY THAT:
1. THIS SURVEY AND PLAN ARE CORRECT AND IN ACCORDANCE WITH THE SURVEYS ACT, THE SURVEYORS ACT AND THE LAND TITLES ACT AND THE REGULATIONS MADE UNDER THEM.
2. THE SURVEY WAS COMPLETED ON THE 14th DAY OF MAY, 2019.

DATE: July 15, 2019.

ONTARIO LAND SURVEYOR

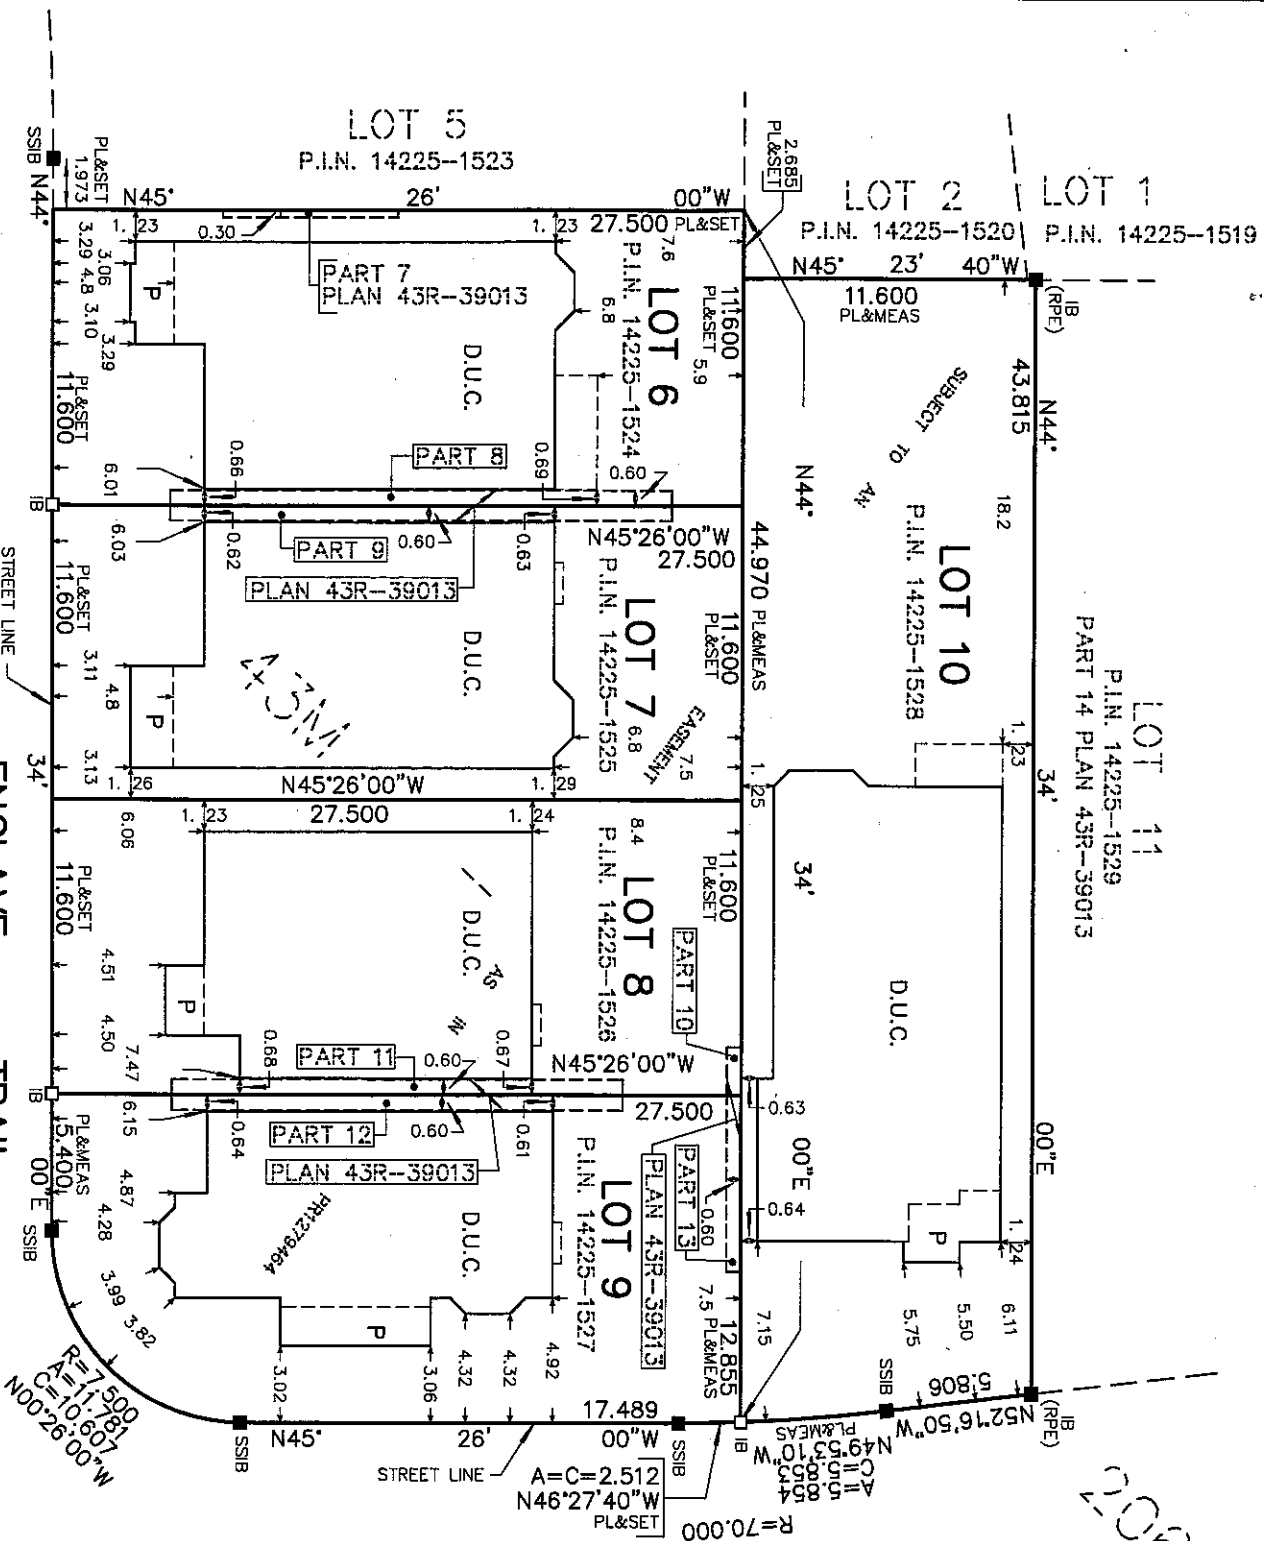

ENCLAVE TRAIL
(BY PLAN 43M-2060)
P.I.N. 14225-1864

NOTES

- DENOTES MONUMENT SET
- DENOTES MONUMENT FOUND
- IB DENOTES IRON BAR
- SSIB DENOTES SHORT STANDARD IRON BAR
- D.U.C. DENOTES DWELLING UNDER CONSTRUCTION
- P.I.N. DENOTES PROPERTY IDENTIFIER NUMBER
- P DENOTES PORCH
- PL DENOTES PLAN 43M-2060
- (RPE) DENOTES R-PE SURVEYING LTD., O.L.S.


ALL FOUND MONUMENTS BY J. D. BARNES SURVEYING, O.L.S. UNLESS NOTED OTHERWISE.

ALL TIES TO CONCRETE FOUNDATIONS.

BEARINGS ARE GRID AND ARE REFERRED TO THE NORTHWESTERLY LIMIT OF ENCLAVE TRAIL AS SHOWN ON PLAN 43M-2060 HAVING A BEARING OF N44°34'00"E.

THIS REPORT WAS PREPARED FOR GREENPARK HOMES AND THE UNDERSIGNED ACCEPTS NO RESPONSIBILITY FOR USE BY OTHER PARTIES.

©R-PE SURVEYING LTD., O.L.S. 2019.

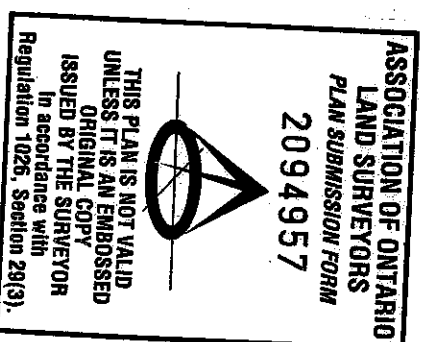

R-PE SURVEYING LTD.
ONTARIO LAND SURVEYORS
643 Christie Road, Suite 7
Woodbridge, Ontario L4L 8A3
Tel. (416) 635-5000 Fax (416) 635-5001
Tel. (905) 264-0881 Fax (905) 264-2099
Website: www.r-pe.ca
DRAWN: V.H.
CHECKED: G.Y./T.S.
JOB NO. 19-060 CAD FILE No. 2060(19-060)-6

19-060 *43M-2060 L6-10*