

SURVEYOR'S REAL PROPERTY REPORT
PART 1
PLAN OF LOTS 16, 17, 18, 19 AND 20
PLAN 43M-2060
CITY OF BRAMPTON
REGIONAL MUNICIPALITY OF PEEL

SCALE 1:300

10m 5m 0 10m 20metres

R-PE SURVEYING LTD., O.L.S.

METRIC

DISTANCES SHOWN ON THIS PLAN ARE IN METRES AND CAN
BE CONVERTED TO FEET BY DIVIDING BY 0.3048.

PART 2 (SURVEY REPORT)

REGISTERED EASEMENTS AND/OR RIGHT-OF-WAYS: LOTS 16 TO 20 ARE
SUBJECT TO AN EASEMENT AS SET OUT IN PR1279464.
THIS PLAN DOES NOT CERTIFY COMPLIANCE WITH ZONING BY-LAWS



SURVEYOR'S CERTIFICATE

I CERTIFY THAT:

1. THIS SURVEY AND PLAN ARE CORRECT AND IN ACCORDANCE
WITH THE SURVEYS ACT, THE SURVEYORS ACT AND THE LAND
TITLES ACT AND THE REGULATIONS MADE UNDER THEM.
2. THE SURVEY WAS COMPLETED ON THE 6th. DAY OF MAY, 2019.

DATE: July 15, 2019.

T. SINGH
T. SINGH
ONTARIO LAND SURVEYOR

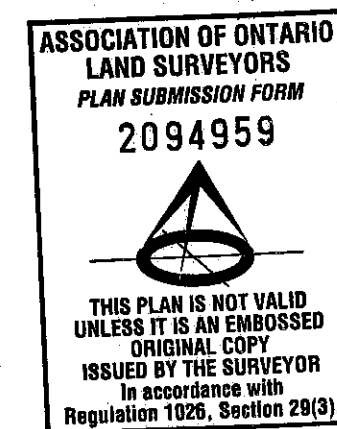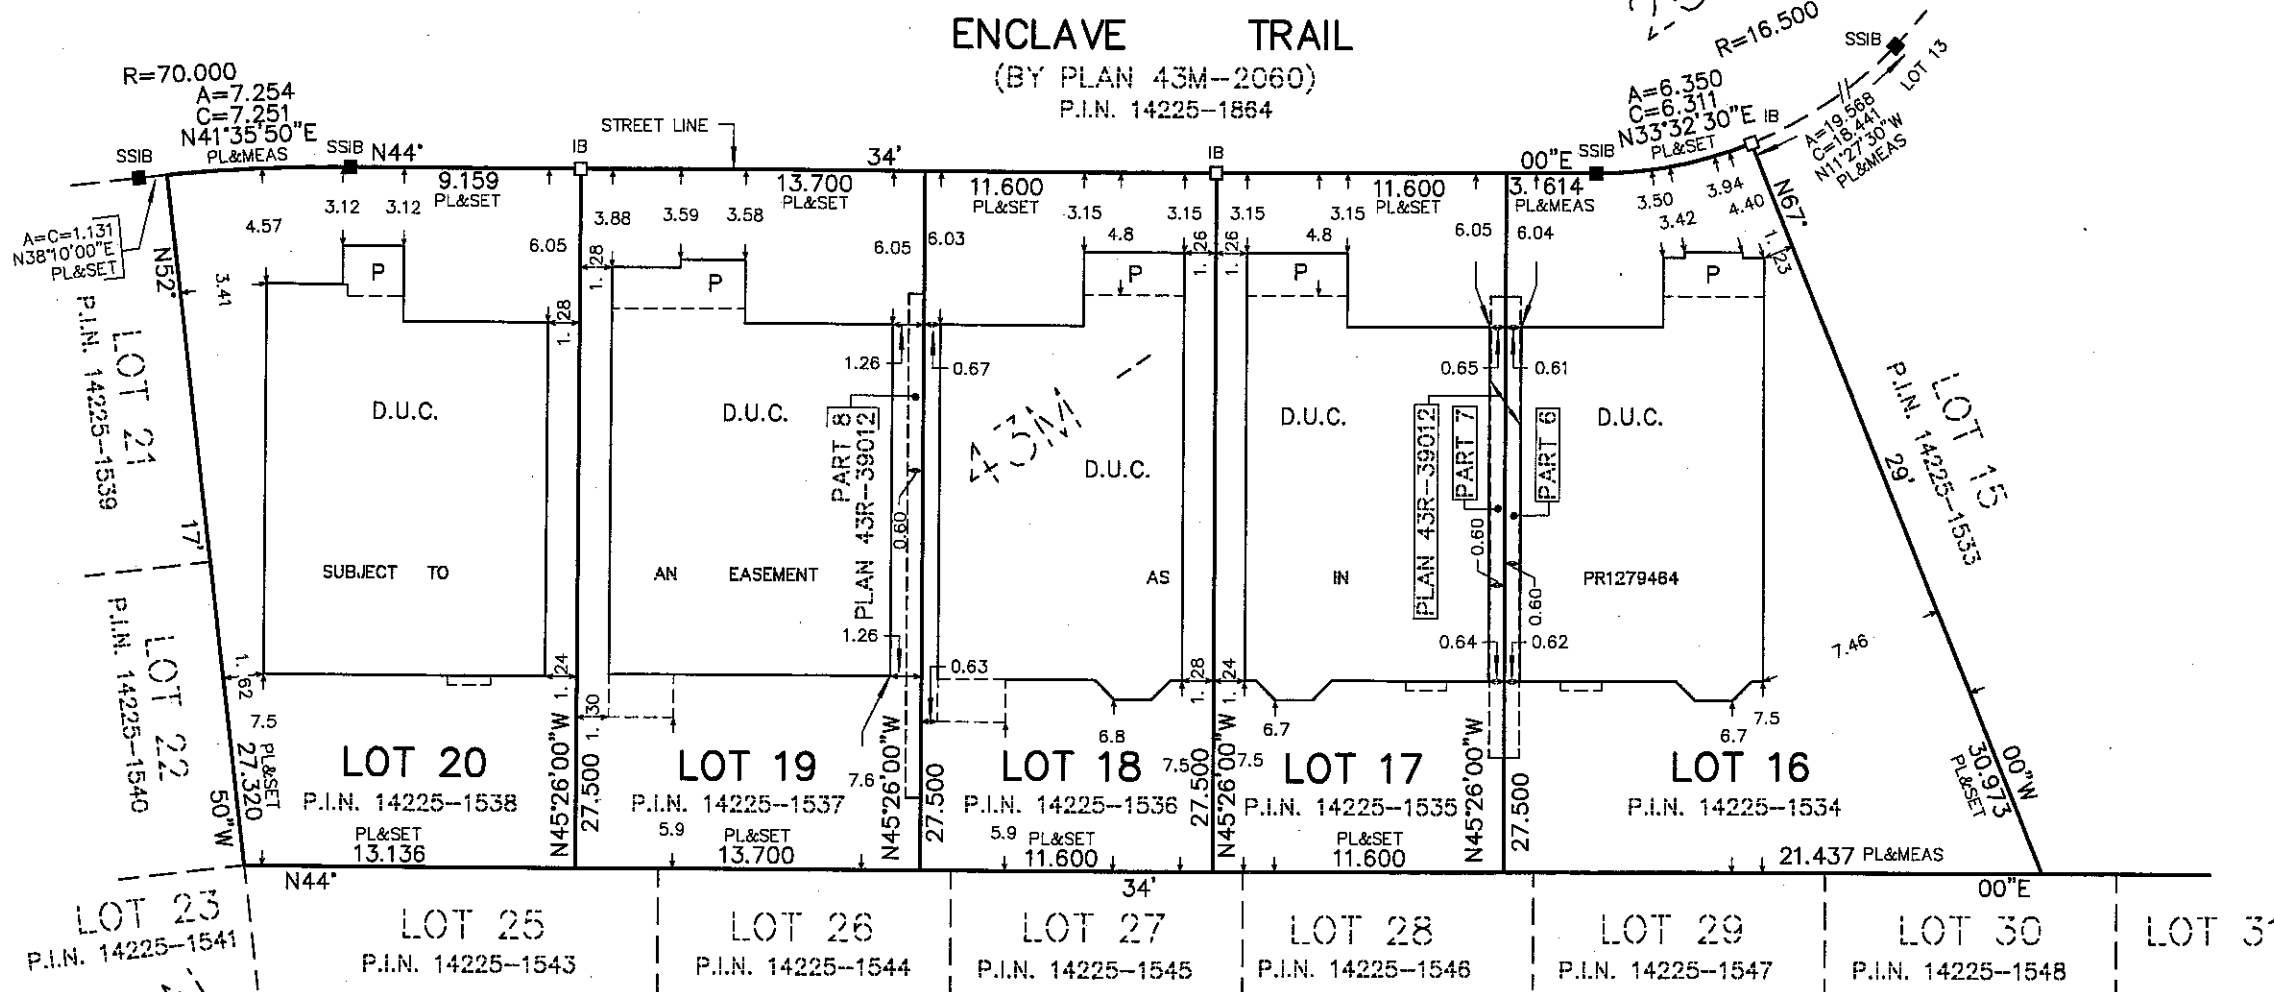

NOTES

- DENOTES MONUMENT SET
- DENOTES MONUMENT FOUND
- IB DENOTES IRON BAR
- SSIB DENOTES SHORT STANDARD IRON BAR
- D.U.C. DENOTES DWELLING UNDER CONSTRUCTION
- P.I.N. DENOTES PROPERTY IDENTIFIER NUMBER
- P DENOTES PORCH
- PL DENOTES PLAN 43M-2060

ALL FOUND MONUMENTS BY J. D. BARNES
SURVEYING, O.L.S.

ALL TIES TO CONCRETE FOUNDATIONS.

BEARINGS ARE GRID AND ARE REFERRED TO THE
SOUTHEASTERLY LIMIT OF ENCLAVE TRAIL AS
SHOWN ON PLAN 43M-2060 HAVING A BEARING
OF N44°34'00"E.



R-PE SURVEYING LTD.

ONTARIO LAND SURVEYORS

643 Chrislea Road, Suite 7

Woodbridge, Ontario L4L 8A3

Tel.(416)635-5000 Fax (416)635-5001

Tel.(905)264-0881 Fax (905)264-2099

Website: www.r-pe.ca

DRAWN: V.H.

JOB No. 19-060

CHECKED: G.Y./T.S.

CAD FILE No.2060(19-060)-16

THIS REPORT WAS PREPARED FOR
GREENPARK HOMES
AND THE UNDERSIGNED ACCEPTS NO
RESPONSIBILITY FOR USE BY OTHER PARTIES.

© R-PE SURVEYING LTD., O.L.S. 2019.

19-060 *43M-2060 L16-20*

