

CONSTRUCTION SUMMARY				
Lotus Pointe 2 (G) - Lamberts Lane Home Corp.				
PURCHASERS: SARBJIT SINGH UPPAL and RAMANDEEP UPPAL				TEL:
LOT / PHASE	REG. PLAN #	HOUSE TYPE		
63 / 2	43M-2071	Preston Two Elev 2 4 Bedroom		

ELECTRICAL

1 - RELOCATE STANDARD KITCHEN LIGHT TO BE CENTERED OVER ISLAND 02Oct19 Note:		
1 - LIGHT AND SWITCH - NO FIXTURE INCLUDED - LIVING ROOM 02Oct19 Note:		
1 - PLUG - ELECTRICAL PLUG - TO BE INSTALLED OVER FIREPLACE 02Oct19 Note:		

MIRRORS AND GLASS

1 - FRAMELESS GLASS SHOWER ENCLOSURE- MASTER ENSUITE WITH CHROME KNOB 02Oct19 Note:		
----------------------------------------------------------------------------------------	--	--


PROMOTIONAL

1 - PARTIAL REDEMPTION OF PROMOTIONAL PACKAGE \$3,375 BALANCE FORWARD \$4,125 TO BE USED AT A LATER DATE. ORIGINAL PROMOTIONAL PACKAGE OF \$7,500 AS PER SCHEDULE PE 02Oct19 Note:		
---------------------------------------------------------------------------------------------------------------------------------------------------------------------------------------	--	--

EXTRAS AS PER OFFER


Complete Central Air Conditioning Supplied and installed Worksheet Note:		
(7,5) The Vendor agrees that notwithstanding any other term or provision in this Agreement included in the Purchase Price and in addition to those items detailed in Schedule GP to the Agreement of Purchase and Sale, the Purchaser is entitled to a credit Worksheet Note:		
The Purchaser acknowledges that the Purchase Price is inclusive of all credits and promotional packages available at the time of purchase. Worksheet Note:		

This Document is Extremely Time Sensitive - Printed 2 Oct 19 at 11:16

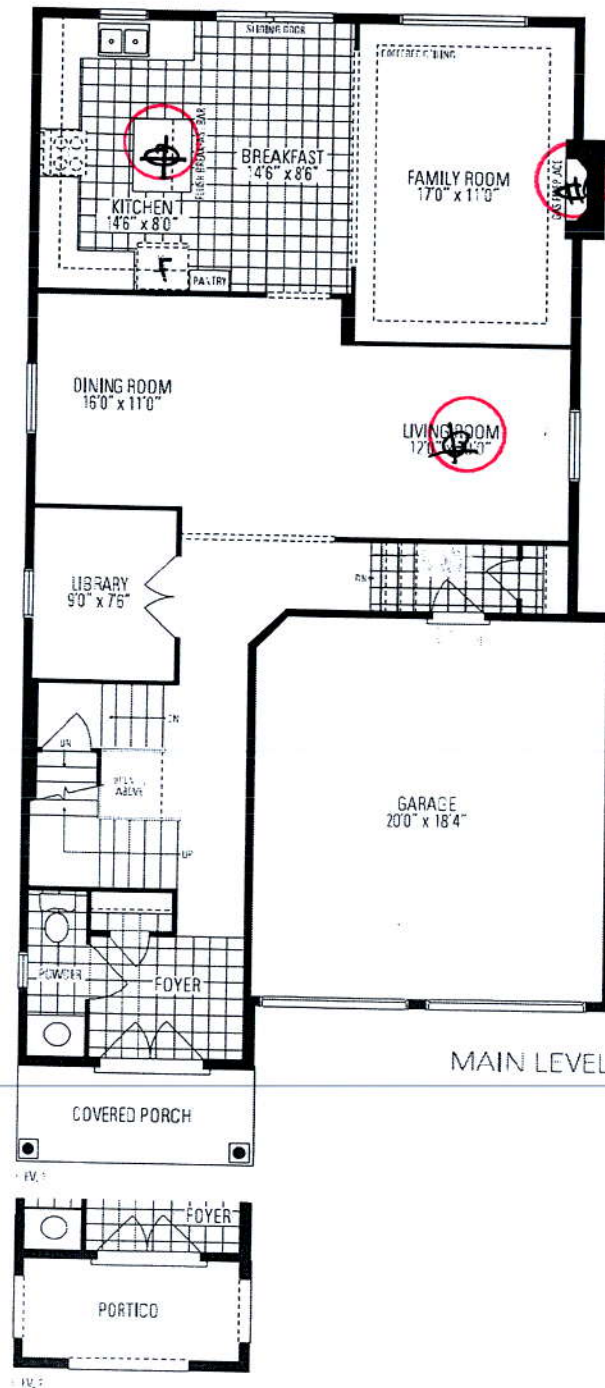

add
plug
over
fireplace

63

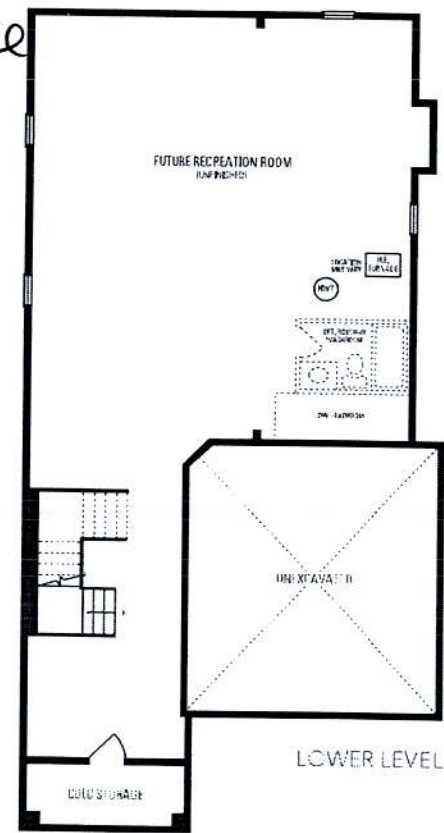

Preston
TWO
INCLUDES 12 SQ. FT. OF OPEN AREA

