

CONSTRUCTION SUMMARY

Lotus Pointe 2 (G) - Lamberts Lane Home Corp.

PURCHASERS: Navjinder SINGH and Rajwinder Kaur DHINDSA

TEL: RES.: 647-923-3773

LOT / PHASE	REG. PLAN #	HOUSE TYPE		
52 / 2	43M-2071	Woodcroft Three Elev 2 5 Bedroom		

ELECTRICAL

1 - LIGHT AND SWITCH - NO FIXTURE INCLUDED- ADD EXTRA LIGHT IN MASTER ENSUITE VANITY 11Nov19 Note:	
1 - KITCHEN - VALANCE LIGHTING - FLORESCENT LIGHTING 11Nov19 Note:	
4 - PLUG - ELECTRICAL PLUG 11Nov19 Note: FOR FUTURE TV	
1 - PLUG - ELECTRICAL PLUG - TO BE INSTALLED OVER FIREPLACE 11Nov19 Note:	
1 - PLUG - ELECTRICAL PLUG WITH GFI AND SWITCH - FOR FESTIVE LIGHTING 11Nov19 Note:	

PLUMBING

3 - TOE TESTER - ADD TOE TESTER TO SHOWER 11Nov19 Note:	
1 - 5 FOOT SHOWER WITH SLIDING GLASS CHROME DOORS IN LIEU OF TUB 11Nov19 Note: in bedroom 3 ENSUITE	

PROMOTIONAL

1 - LESS CREDIT FROM PURCHASER EXTRA SHEET IN OFFER 11Nov19 Note:	
--	--

EXTRAS AS PER OFFER

(7,5) The Vendor agrees that notwithstanding any other term or provision in this Agreement included in the Purchase Price and in addition to those items detailed in Schedule GP to the Agreement of Purchase and Sale, the Purchaser is entitled to a credit Worksheet Note:	
The Purchaser acknowledges that the Purchase Price is inclusive of all credits and promotional packages available at the time of purchase. Worksheet Note:	

This Document is Extremely Time Sensitive - Printed 14 Nov 19 at 11:50



# Woodcraft THREE | 45' LOT • 2,907 SQ.FT.



ELEVATION 2





ELEVATION 3



ELEVATION 1

Orientation of home may be reversed and purchaser agrees to accept the same. Steps and porches may vary at any exterior entrance ways due to grading variance. Actual usable floor space may vary from the stated floor areas. All renderings are artists' concept. Dimensions, specifications and architectural detailing subject to modifications. Roofline and adjoining model types may vary due to siting. Appliances, furniture and furnishings not included. E. & O. E. March 2019.

Festive Plug

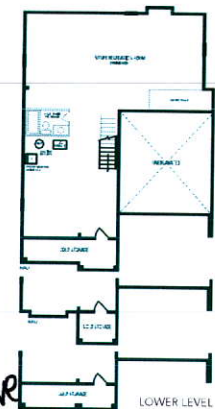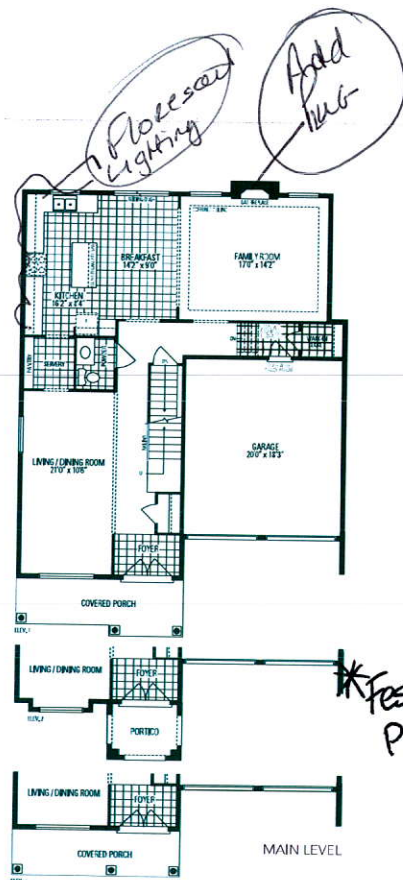

UPPER LEVEL  
OPTIONAL 5 BEDROOM  
UPPER LEVEL AVAILABLE

Orientation of home may be reversed and purchaser agrees to accept the same. Steps and porches may vary at any exterior entrance ways due to grading variance. Actual usable floor space may vary from the stated floor areas. All renderings are artists' concept. Dimensions, specifications and architectural detailing subject to modifications. Roofline and adjoining model types may vary due to siting. Appliances, furniture and furnishings not included. E. & O. E. March 2019.