

CONSTRUCTION SUMMARY				
Lotus Pointe 2 (G) - Lamberts Lane Home Corp.				
PURCHASERS: Sukhwinder Kaur GREWAL and GAGANDEEP GREWAL			TEL: RES.: 647-321-5400	
LOT / PHASE	REG. PLAN #	HOUSE TYPE		
54 / 2	43M-2071	Woodcroft Three Elev 3 4 Bedroom		

CONSTRUCTION

1 - BASEMENT 8 FOOT 6 INCH CONCRETE POUR - MEASURED FROM TOP OF FOOTING TO TOP OF FOUNDATION WALL	
14May19 Note:	

ELECTRICAL

1 - PLUG - ELECTRICAL PLUG WITH GFI AND SWITCH - FOR FESTIVE LIGHTING	
13Nov19 Note:	
1 - LIGHT AND SWITCH - NO FIXTURE INCLUDED - LIVING ROOM	
13Nov19 Note:	

MIRRORS AND GLASS

1 - MASTER ENSUITE----FRAMELESS GLASS SHOWER ENCLOSURE	
13Nov19 Note:	

PLUMBING

3 - TOE TESTER - ADD TOE TESTER TO SHOWER	
13Nov19 Note:	
1 - 5 FOOT SHOWER WITH SLIDING GLASS CHROME DOORS IN LIEU OF TUB	
13Nov19 Note: in ensuite 2/3	

PROMOTIONAL



1 - LESS CREDIT FROM PURCHASER EXTRA SHEET IN OFFER	
14May19 Note:	

EXTRAS AS PER OFFER

The Purchaser acknowledges that the Purchase Price is inclusive of all credits and promotional packages available at the time of purchase.	
Worksheet Note:	
Complete Central Air Conditioning Supplied and installed	
Worksheet Note:	
(7,5) The Vendor agrees that notwithstanding any other term or provision in this Agreement included in the Purchase Price and in addition to those items detailed in Schedule GP to the Agreement of Purchase and Sale, the Purchaser is entitled to a credit	
Worksheet Note:	


This Document is Extremely Time Sensitive - Printed 13 Nov 19 at 17:04

Add

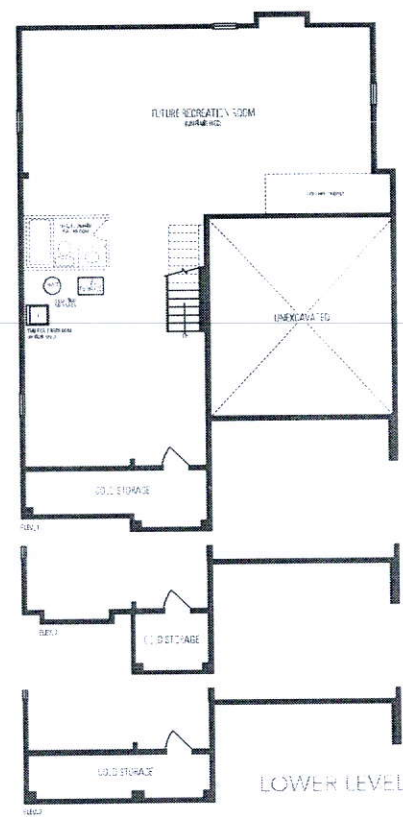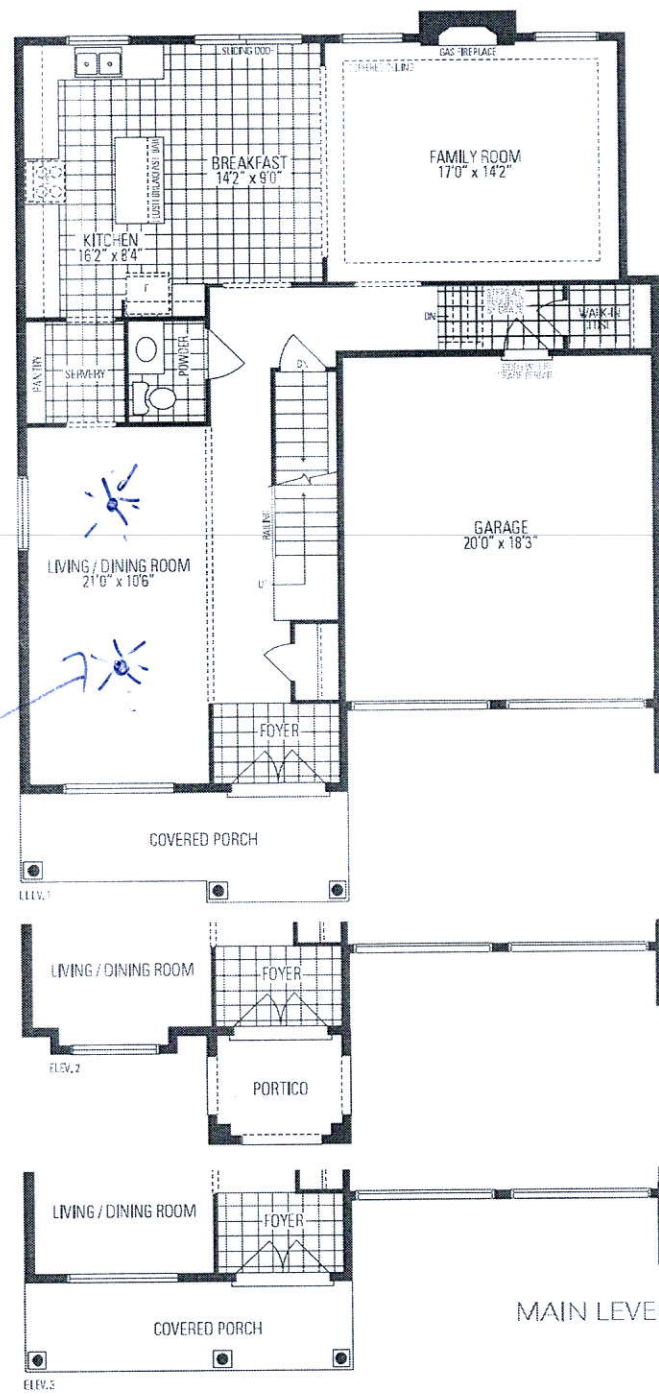

* Festive Plug: **Woodcroft THREE**

Handels
Glass
Enclosure

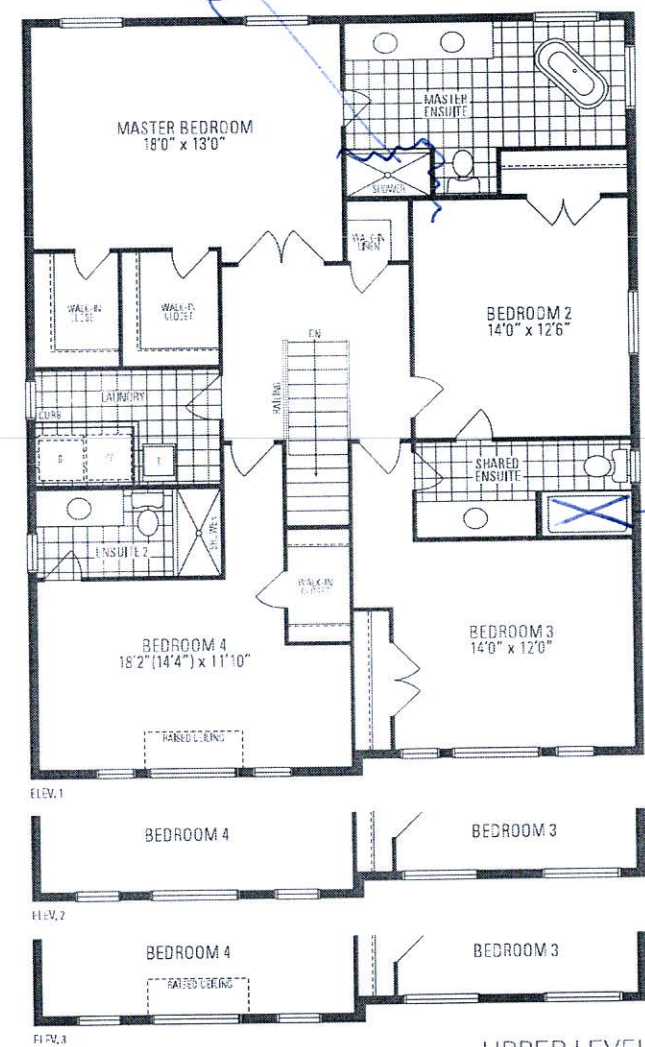

tub to
shower

OPTIONAL 5 BEDROOM
UPPER LEVEL AVAILABLE