

CONSTRUCTION SUMMARY

Lotus Pointe 2 (G) - Lamberts Lane Home Corp.

TEL:

PURCHASER: Jagdip Singh GREWAL

LOT / PHASE 69 / 2	REG. PLAN # 43M-2071	HOUSE TYPE Preston Two Elev 2 4 Bedroom		
-----------------------	-------------------------	--	--	--

ELECTRICAL

1 - PLUG - ELECTRICAL PLUG WITH GFI AND SWITCH - FOR FESTIVE LIGHTING <i>13Nov19</i> Note:	
1 - PLUG - ELECTRICAL PLUG - TO BE INSTALLED OVER FIREPLACE <i>13Nov19</i> Note:	
1 - LIGHT AND SWITCH - NO FIXTURE INCLUDED - LIVING ROOM <i>13Nov19</i> Note:	

MIRRORS AND GLASS

1 - MASTER ENSUITE- ADD FRAMELESS GLASS SHOWER ENCLOSURE <i>13Nov19</i> Note:	
--	--

PLUMBING

3 - TOE TESTER - ADD TOE TESTER TO SHOWER <i>13Nov19</i> Note:	
1 - 5 FOOT SHOWER WITH SLIDING GLASS CHROME DOORS IN LIEU OF TUB <i>13Nov19</i> Note: in bed 2/3 ensuite--	

PROMOTIONAL




1 - PARTIAL REDEMPTION OF PROMOTIONAL PACKAGE \$\$\$\$\$\$ BALANCE FORWARD TO BE USED AT A LATER DATE. ORIGINAL PROMOTIONAL PACKAGE OF \$\$\$\$ AS PER SCHEDULE PE DATED MMMDDYYYY. <i>13Nov19</i> Note: PROMO AS PER OFFER \$7500 LESS \$5855 NEW PROMO BALANCE \$1645.00	
---	--

EXTRAS AS PER OFFER

The Purchaser acknowledges that the Purchase Price is inclusive of all credits and promotional packages available at the time of purchase. <i>Worksheet</i> Note:	
Main level ceiling height to be 10 feet. <i>Worksheet</i> Note:	
(7,5) The Vendor agrees that notwithstanding any other term or provision in this Agreement included in the Purchase Price and in addition to those items detailed in Schedule GP to the Agreement of Purchase and Sale, the Purchaser is entitled to a credit <i>Worksheet</i> Note:	

This Document is Extremely Time Sensitive - Printed 14 Nov 19 at 11:47

10ft ceiling

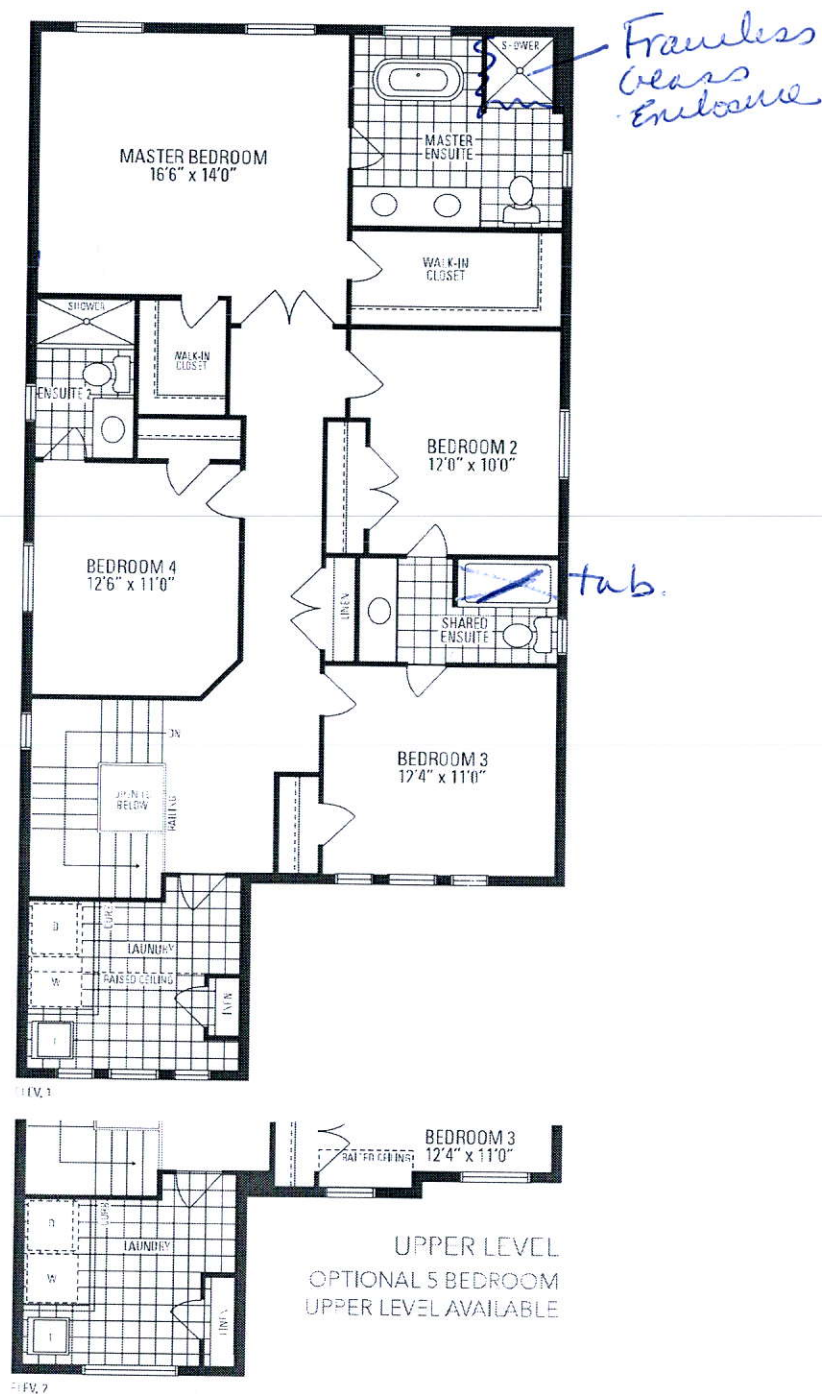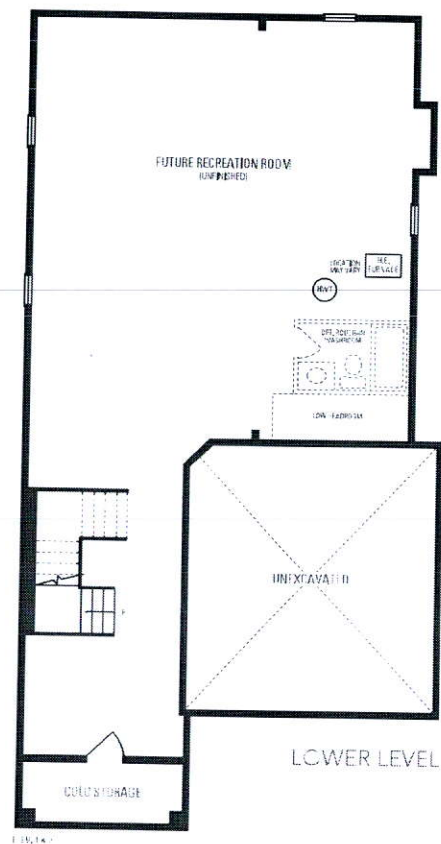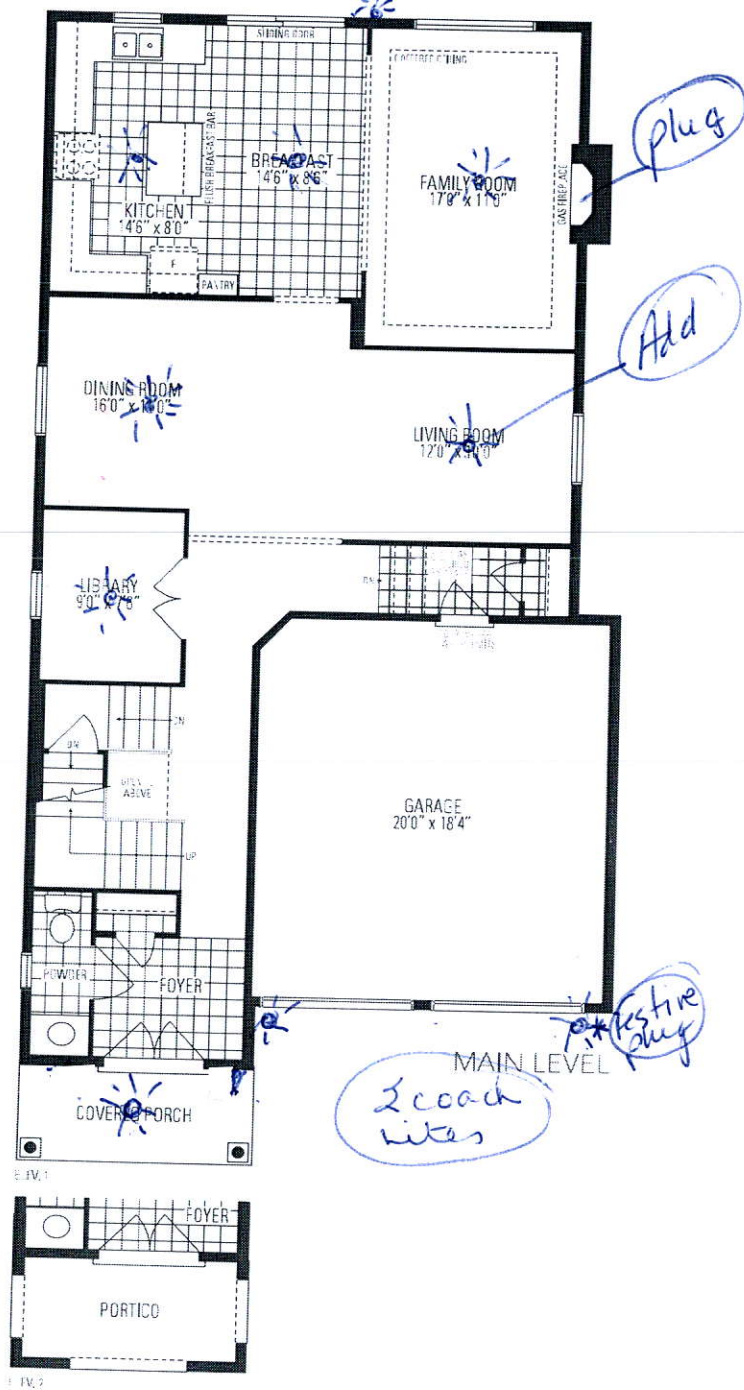

Preston
TWO
 INCLUDES 12 SQ. FT. OF OPEN AREA