

CONSTRUCTION SUMMARY

Lotus Pointe 2 (G) - Lamberts Lane Home Corp.

PURCHASERS: Alhan BEHNAM and Raed Yashooa HANNA

TEL: RES.: 647-448-4607

LOT / PHASE 53 / 2	REG. PLAN # 43M-2071	HOUSE TYPE Woodcroft Three Elev 1 4 Bedroom		
-----------------------	-------------------------	--	--	--

ELECTRICAL

1 - PLUG - ELECTRICAL PLUG - TO BE INSTALLED OVER FIREPLACE 11Nov19 Note:	
--	--

PLUMBING

1 - 5 FOOT SHOWER WITH SLIDING GLASS CHROME DOORS IN LIEU OF TUB 11Nov19 Note: Bed 2/3 Ensuite	
---	--



PROMOTIONAL

1 - LESS CREDIT FROM PURCHASER EXTRA SHEET IN OFFER 11Nov19 Note: PROMO AS PER OFFER \$7500 LESS \$1975.00 NEW PROMO BALANCE \$5525.00	
---	--


EXTRAS AS PER OFFER

The Purchaser acknowledges that the Purchase Price is inclusive of all credits and promotional packages available at the time of purchase. Worksheet Note:	
(7,5) The Vendor agrees that notwithstanding any other term or provision in this Agreement included in the Purchase Price and in addition to those items detailed in Schedule GP to the Agreement of Purchase and Sale, the Purchaser is entitled to a credit Worksheet Note:	

This Document is Extremely Time Sensitive - Printed 11 Nov 19 at 13:23

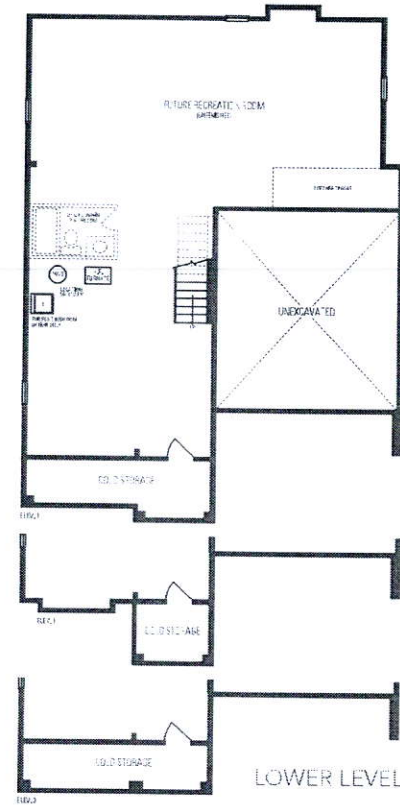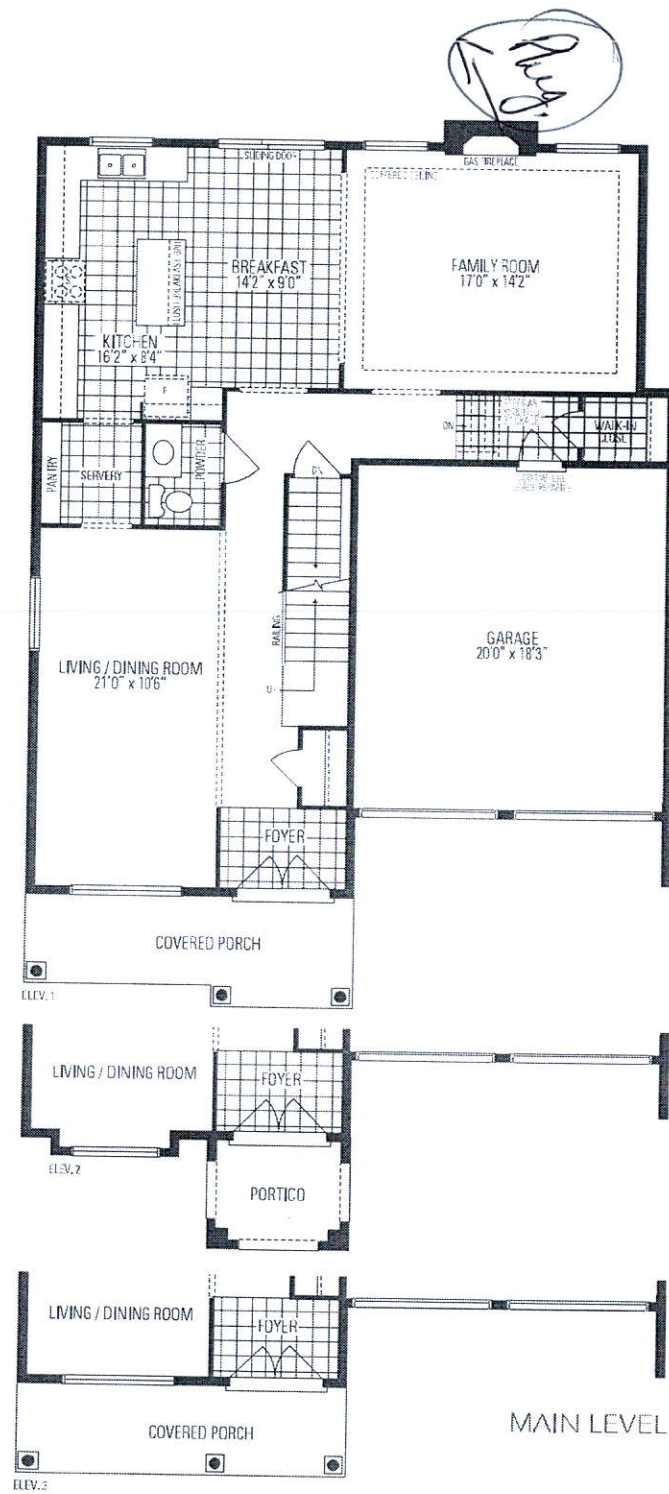

Woodcraft
THREE

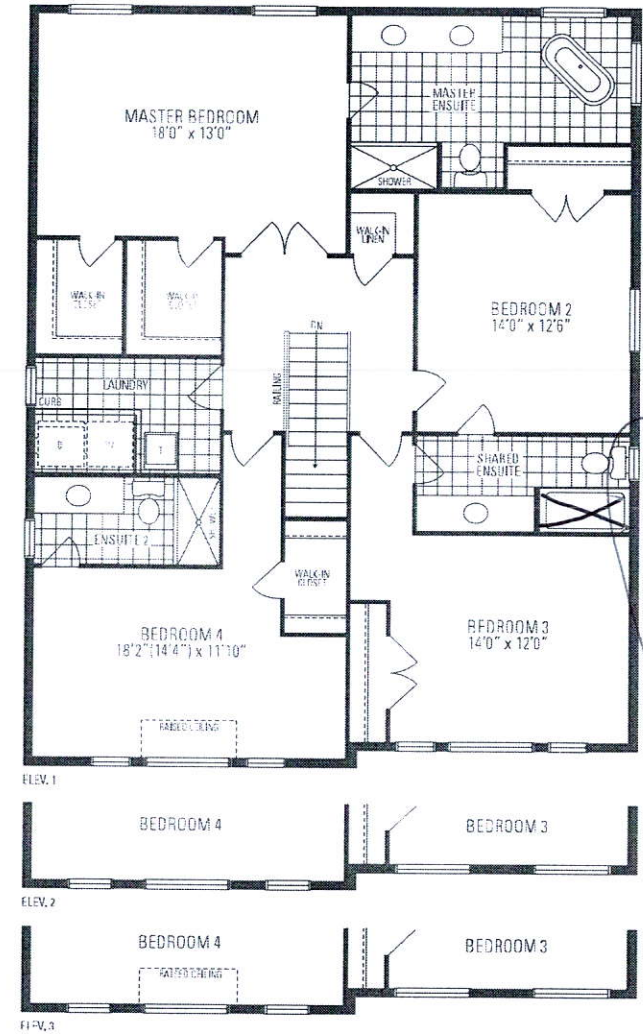

UPPER LEVEL
OPTIONAL 5 BEDROOM
UPPER LEVEL AVAILABLE

Handwritten: tub to shower