

CONSTRUCTION SUMMARY

Lotus Pointe 2 (G) - Lamberts Lane Home Corp.

PURCHASERS: Manjot Singh PURBA and Gagandeep Kaur PURBA

TEL: RES.: 647-280-6420

LOT / PHASE 70 / 2	REG. PLAN # 43M-2071	HOUSE TYPE Preston Two Elev 1 4 Bedroom		
-----------------------	-------------------------	--	--	--

ELECTRICAL

1 - PLUG - ELECTRICAL PLUG - TO BE INSTALLED OVER FIREPLACE 15Nov19 Note:	
1 - LIGHT AND SWITCH - NO FIXTURE INCLUDED - LIVING ROOM 15Nov19 Note: XXXXXXXXXXXXXXXXXXXX	

MIRRORS AND GLASS

1 - MASTER ENSUITE-----FRAMELESS GLASS SHOWER ENCLOSURE 15Nov19 Note:	
--	--

PLUMBING

1 - 5 FOOT SHOWER WITH SLIDING GLASS CHROME DOORS IN LIEU OF TUB 15Nov19 Note: in bed. 2/3 ensuite-----	
--	--



PROMOTIONAL

1 - PARTIAL REDEMPTION OF PROMOTIONAL PACKAGE \$\$\$\$\$\$ BALANCE FORWARD TO BE USED AT A LATER DATE. ORIGINAL PROMOTIONAL PACKAGE OF \$\$\$\$ AS PER SCHEDULE PE DATED MMMDDYYYY. 15Nov19 Note: PROMO AS PER OFFER \$7500 LESS PROMO \$5175 NEW PROMO BALANCE \$2325.00	
--	--

EXTRAS AS PER OFFER

(7,5) The Vendor agrees that notwithstanding any other term or provision in this Agreement included in the Purchase Price and in addition to those items detailed in Schedule GP to the Agreement of Purchase and Sale, the Purchaser is entitled to a credit Worksheet Note:	
The Purchaser acknowledges that the Purchase Price is inclusive of all credits and promotional packages available at the time of purchase. Worksheet Note:	

This Document is Extremely Time Sensitive - Printed 15 Nov 19 at 9:24

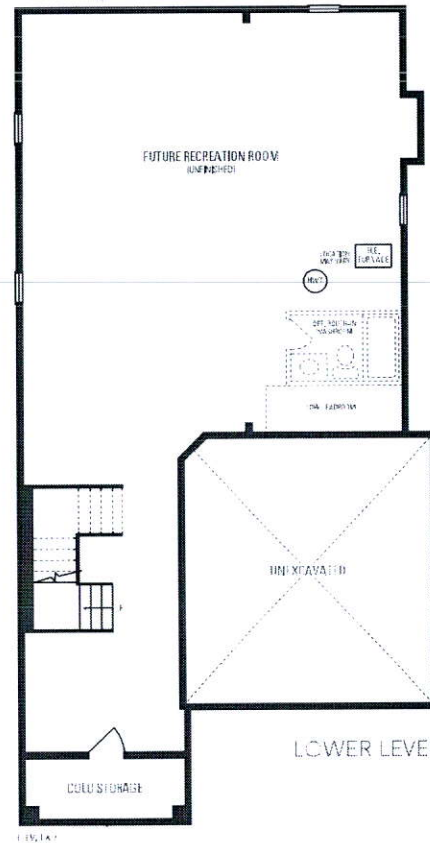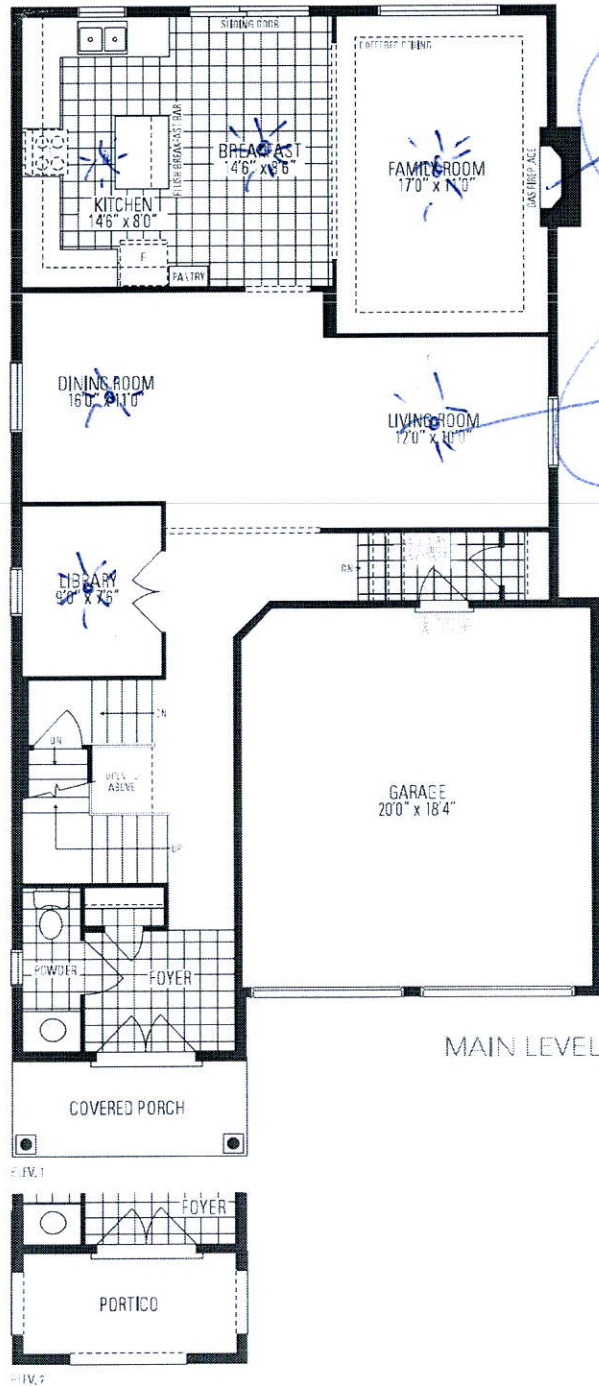

Preston **TWO** INCLUDES 12 SQ. FT. OF OPEN AREA

