

STORM CONNECTION

SANITARY CONNECTION

WATER CONNECTION

HYDRO CONNECTION

DOUBLE CATCH BASIN

CATCH BASIN

HYDRANT

VALVE AND CHAMBER

ENTRANCE DOOR LOCATION

GARAGE DOOR LOCATION

ENGINEERED FILL LOT

SANITARY MANHOLE

STORM MANHOLE

COMMUNITY MAILBOX

DOWNSPOUT LOCATION

SWALE DIRECTION

STREET LIGHT

TRANSFORMER

CABLE TV PEDESTAL

BELL PEDESTAL

BELL/ROG. FLUSH TO GRADE

HYDRO METER

GAS METER

AIR-CONDITIONING UNIT

SLUMP PUMP

F.F.L.R. FINISHED FLOOR ELEVATION

T.WALL TOP OF FOUNDATION WALL

F.SLAB FIN. BASEMENT FLOOR SLAB

U.F.T.G. UNDERSIDE FOOTING ELEVATION

PROPOSED 3:1 SLOPE

PROPOSED GRADE

PROPOSED SWALE GRADE

100.00

SW


100.00

100.00

SW

100.00

NORTH

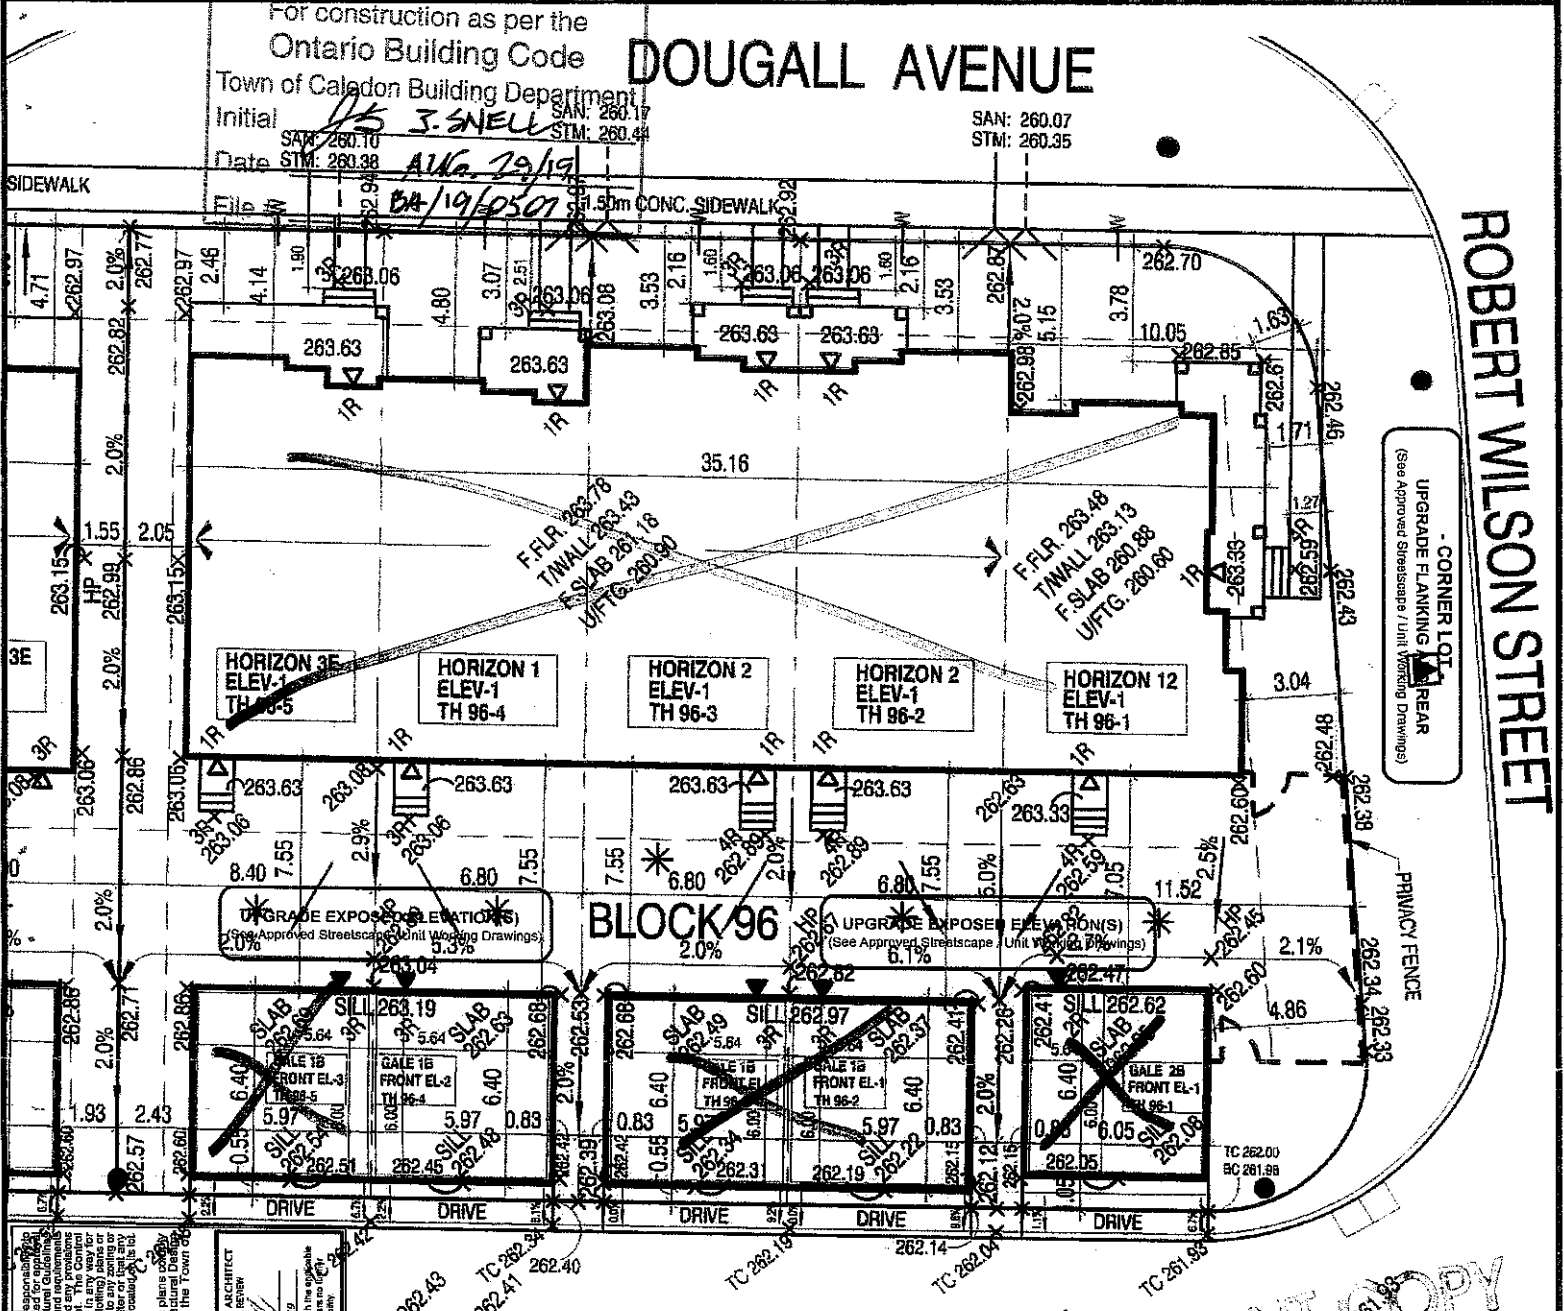

THE AS-CONSTRUCTED STORM AND SANITARY CONNECTIONS HAVE BEEN PROVIDED BY CONSTRUCTION GROUP

NOTE: ANY ENGINEERED FILL LOTS NOTED ARE ESTIMATED AND FOR REFERENCE ONLY AND THE ENGINEERED FILL CERTIFICATE PROVIDED BY THE PROJECT GEOTECHNICAL CONSULTANT WILL GOVERN

NOTE: IT IS THE BUILDER'S RESPONSIBILITY TO CONFIRM IN THE FIELD THAT ALL SANITARY AND STORM LATERALS ELEVATIONS ARE ACCEPTABLE PRIOR TO POURING FOOTINGS

Registered Plan No. 43M-2071

Lot No(s). Block 96

Date: JUNE/20/2019

Scale 1:250

5m 0m 5m 10m

PLAN OF SUBDIVISION OF PART OF LOTS 21 AND 22 CONCESSION 1 EAST OF HURONTARIO STREET REGIONAL MUNICIPALITY OF PEEL (GEOGRAPHIC TOWNSHIP OF CHINGACOSU TOWN OF CALEDON REGISTERED PLAN 43M.

THE CONTRACTOR SHALL CHECK AND VERIFY ALL DIMENSIONS AND CONDITIONS ON SITE BEFORE PROCEEDING WITH CONSTRUCTION. ANY DISCREPANCIES SHALL BE REPORTED TO JARDIN DESIGN GROUP INC. PRIOR TO COMMENCEMENT OF WORK.

AND/OR DESIGN GROUP INC. IS NOT RESPONSIBLE FOR THE ACCURACY OF SURVEY, STRUKTURAL OR ENGINEERING INFORMATION SHOWN ON THESE DRAWINGS OR FOR CONSTRUCTION STARTED PRIOR TO THE ISSUANCE OF A BUILDING PERMIT. REFER TO THE APPROPRIATE ENGINEERING DRAWINGS BE-OR-PROCEEDING WITH WORK.

AS CONSTRUCTED IN THIS MUST BE VERIFIED PRIOR TO POURING FOOTINGS.

JARDIN DESIGN GROUP INC. HAS NOT BEEN RETAINED TO CARRY OUT GENERAL REVIEW OF THE WORK AND ASSUMES NO RESPONSIBILITY FOR THE FAILURE OF THE CONTRACTOR OR SUB CONTRACTOR TO CARRY OUT THE WORK IN ACCORDANCE WITH THE CONTRACT DOCUMENTS.

THIS DRAWING IS AN INSTRUMENT OF SERVICE, IS PROVIDED BY AND IS THE PROPERTY OF JARDIN DESIGN GROUP INC. THIS DRAWING IS NOT TO BE REPRODUCED.