

CONSTRUCTION SUMMARY

Lotus Pointe 2 (G) - Lamberts Lane Home Corp.

PURCHASER: Salomey MENSAH

TEL:

LOT / PHASE	REG. PLAN #	HOUSE TYPE		
46 / 2	43M-2071	Kinmount Six-A Elev 2		

CONSTRUCTION

1 - DELETE BULKHEADS IN KITCHEN AS PER PURCHASERS REQUEST- IF CONSTRUCTION PERMITS 04Dec19 Note:	
1 - ADD BASEMENT WALK-UP 22May19 Note:	

ELECTRICAL

1 - PLUG - ELECTRICAL PLUG - TO BE INSTALLED OVER FIREPLACE 04Dec19 Note:	
1 - PLUG - ELECTRICAL PLUG WITH GFI AND SWITCH - FOR FESTIVE LIGHTING 04Dec19 Note:	

PROMOTIONAL

1 - LESS CREDIT FROM PURCHASER EXTRA SHEET IN OFFER 22May19 Note:	
--	--

EXTRAS AS PER OFFER



The Purchaser acknowledges that the Purchase Price is inclusive of all credits and promotional packages available at the time of purchase. Worksheet Note:	
(7,5) The Vendor agrees that notwithstanding any other term or provision in this Agreement included in the Purchase Price and in addition to those items detailed in Schedule GP to the Agreement of Purchase and Sale, the Purchaser is entitled to a credit Worksheet Note:	

This Document is Extremely Time Sensitive - Printed 4 Dec 19 at 14:52

46


plug above
Fireplace

★ delete
bulkheads
in Kitchen
IF Cons.
permits

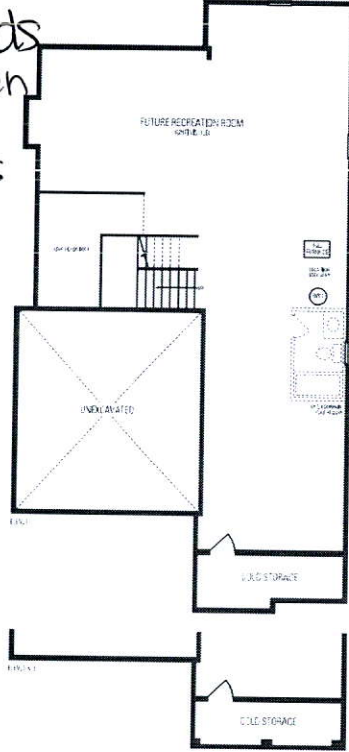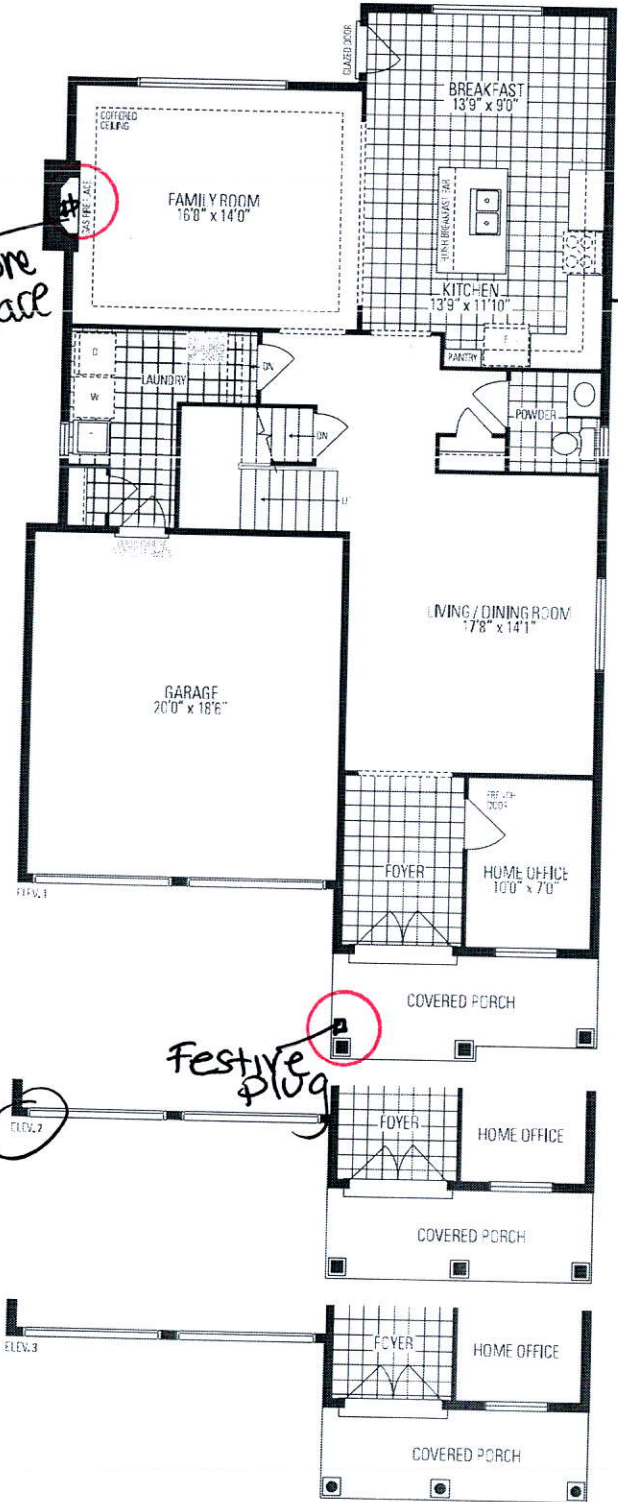

LOWER LEVEL

Kinsmount
SIX - A

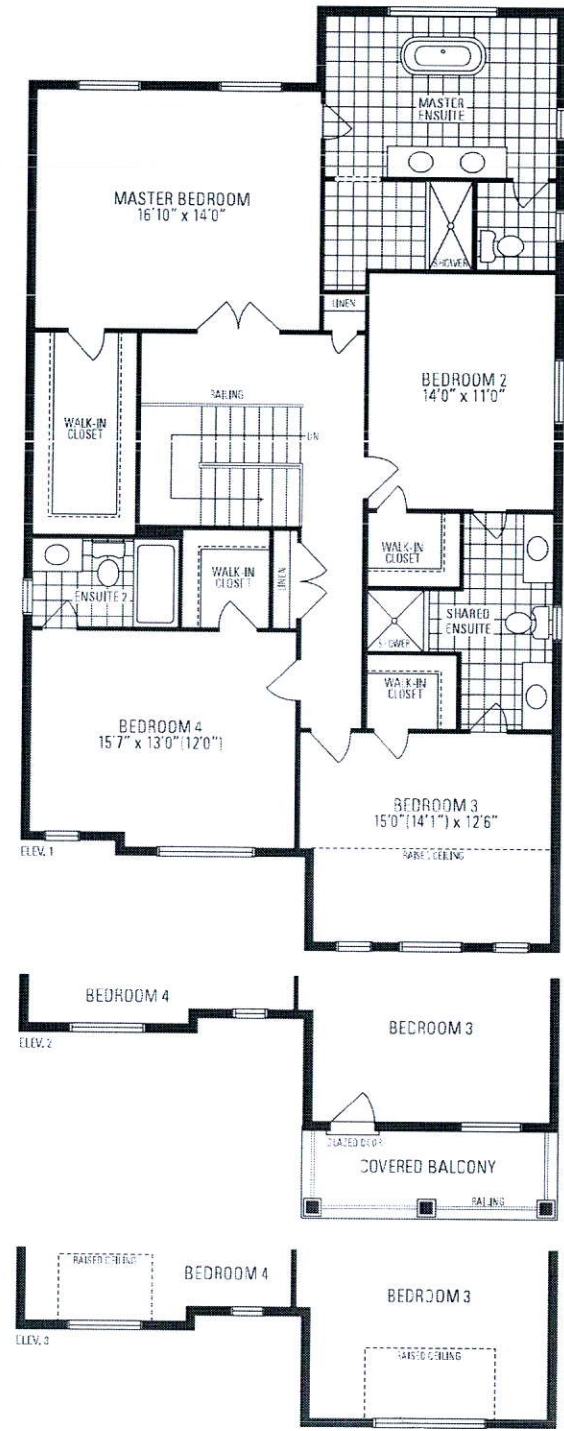


UPPER LEVEL

LOT 46
LAMBERST LANE
PHASE 2


KINMOUNT 6A
ELEVATION 2

REVISIONS:

1. ADD EXTERIOR WALK-UP BASEMENT STAIRS.
2. GRADING REQUIRES WOOD DECK.

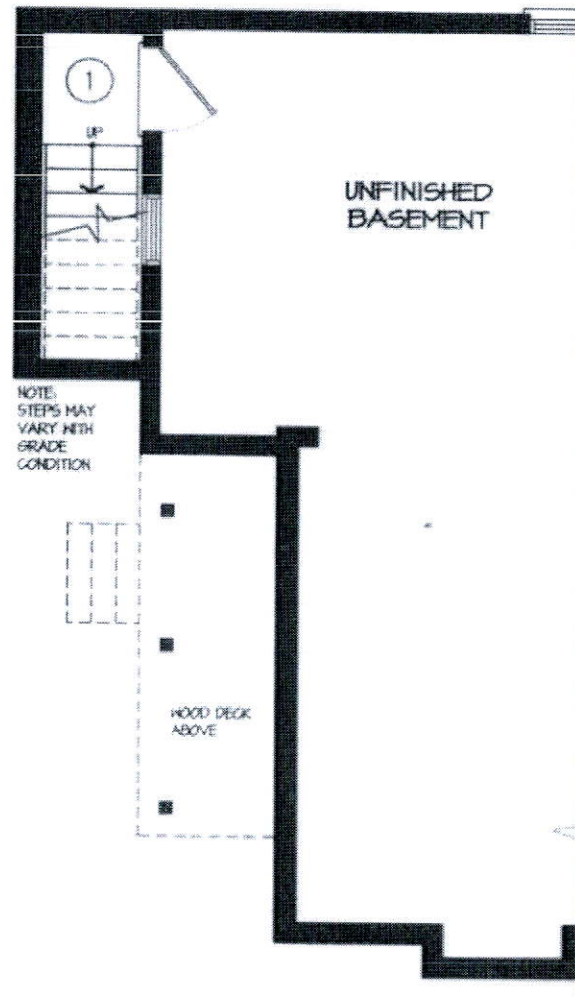

LOWER LEVEL

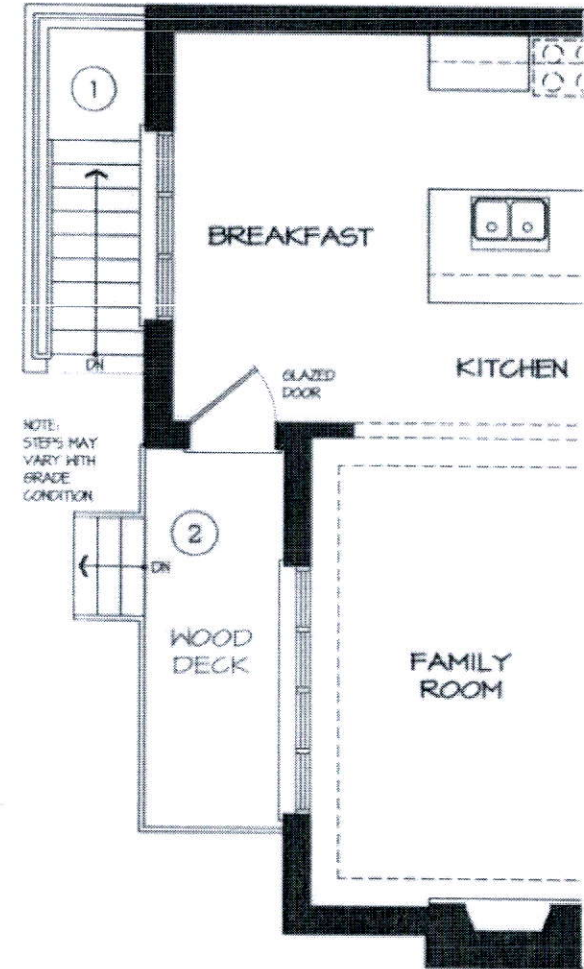

MAIN LEVEL

DISCLAIMERS: SKETCH NOT TO SCALE. DIMENSIONS, SPECIFICATIONS AND ARCHITECTURAL DETAILS SUBJECT TO MODIFICATION BY THE VENDOR. SKETCH IS ONLY FOR THE PURPOSE OF ILLUSTRATING REVISIONS REQUESTED BY THE PURCHASER AND ALL REVISIONS ARE SUBJECT TO VENDOR'S FINAL APPROVAL. ONLY REVISIONS ACCEPTED IN WRITING BY THE PURCHASER AND VENDOR ON A PURCHASER'S EXTRA SHEET WILL BE INCORPORATED INTO THE PLANS FILED WITH THE MUNICIPALITY. E. & O.E.

REGION
DESIGN
INC.

SCALE
N.T.S.
BY
MB
PAGE No.
1 OF 1

Greenpark
GROUP