

CONSTRUCTION SUMMARY

Lotus Pointe 2 (G) - Lamberts Lane Home Corp.

PURCHASERS: Edwin Julius SOOSAIMUTHU and Mabel Shanthi EDWIN JULIUS

TEL:

LOT / PHASE 64 / 2	REG. PLAN # 43M-2071	HOUSE TYPE Preston Eleven Elev 2 4 Bedroom		
-----------------------	-------------------------	-----------------------------------------------	--	--

CONSTRUCTION

1 - ADD BASEMENT WALK-UP

14May19 Note:

PLUMBING

1 - 5 FOOT SHOWER WITH SLIDING GLASS CHROME DOORS IN LIEU OF TUB- IN SHARED ENSUITE

06Jan20 Note:

PROMOTIONAL

1 - LESS CREDIT FROM PURCHASER EXTRA SHEET IN OFFER

14May19 Note:

EXTRAS AS PER OFFER

(7,5) The Vendor agrees that notwithstanding any other term or provision in this Agreement included in the Purchase Price and in addition to those items detailed in Schedule GP to the Agreement of Purchase and Sale, the Purchaser is entitled to a credit

Worksheet Note:







The Purchaser acknowledges that the Purchase Price is inclusive of all credits and promotional packages available at the time of purchase.

Worksheet Note:

Complete Central Air Conditioning Supplied and installed

Worksheet Note:

This Document is Extremely Time Sensitive - Printed 6 Jan 20 at 10:15

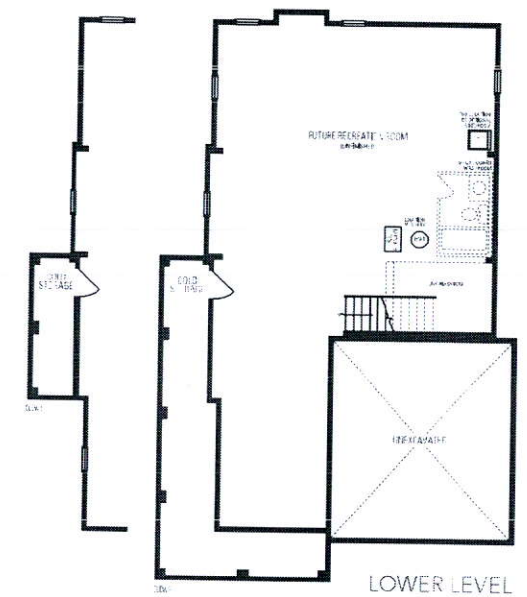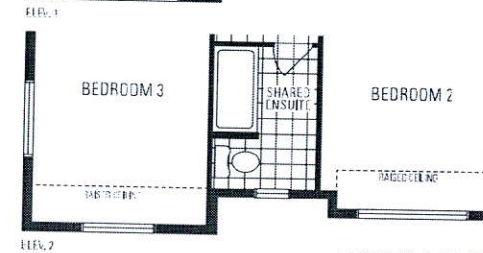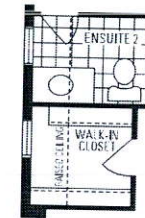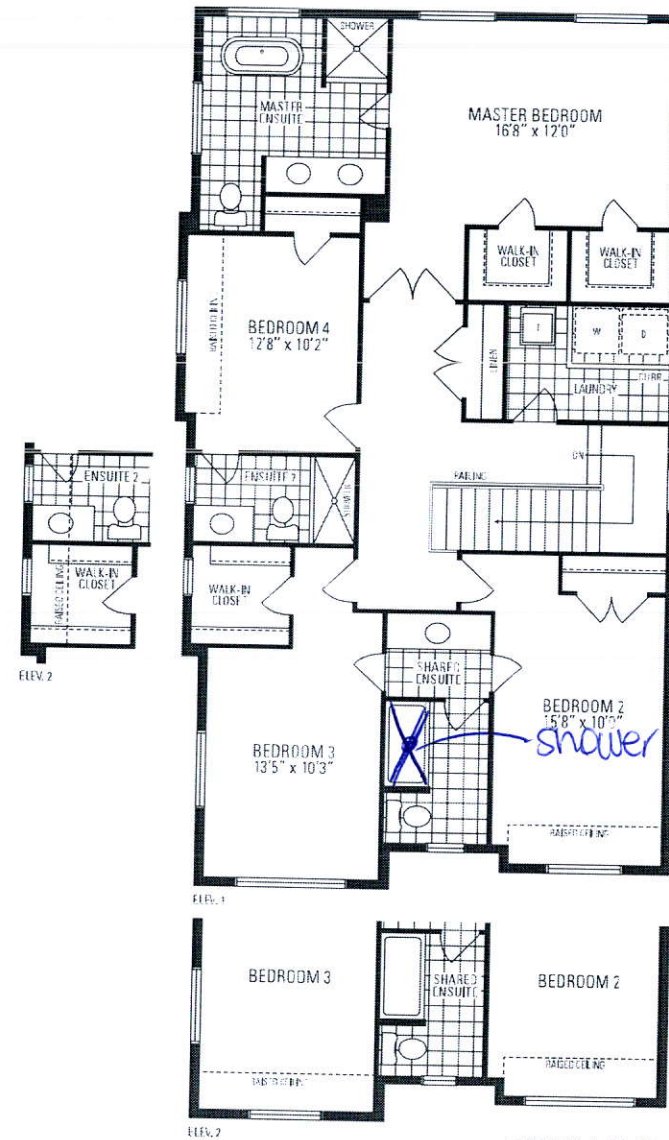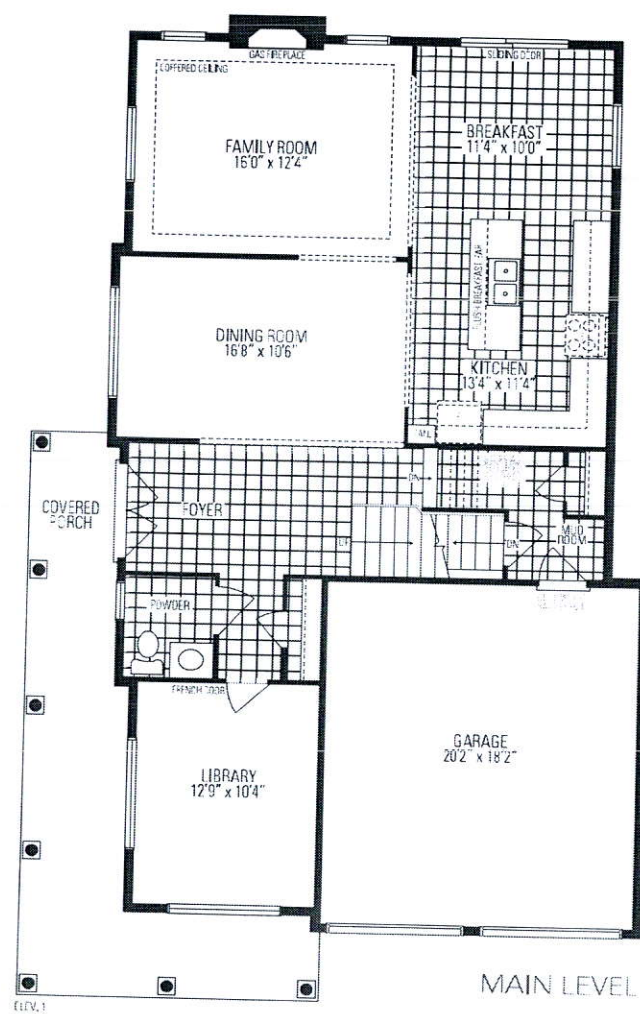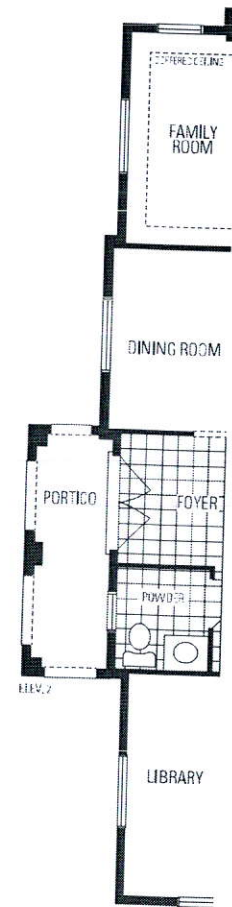

*Preston*  
ELEVEN