

CONSTRUCTION SUMMARY - PARTIAL ONLY
Georgian Estate Collection - Tiburtino Buildup Corp.

MAR 09 2020



PURCHASER: Milos VARAKLJC

TEL: RES.: 647-449-1987 BUS.: 905-829-3538

LOT NUMBER	PHASE	HOUSE TYPE	REG. PLAN #
7	1	Georgian Three Elev B	20M-1210
INV#	QTY	EXTRA / CHANGE	

ELECTRICAL

23,957 25Jun19	1 - LIGHT AND SWITCH - NO FIXTURE INCLUDED - LIVING ROOM Note:	
24,478 09Mar20	1 - GARAGE-ADD 2 60 AMPS EACH CONNECTIONS IN THE GARAGE AS PER SKETCH Note:	 new
23,957 25Jun19	1 - ABOVE KITCHEN ISLAND - ADD LIGHT AND SWITCH - NO FIXTURE INCLUDED Note:	
23,957 25Jun19	3 - PLUG - ELECTRICAL PLUG- FAMILY ROOM, MASTER BEDROOM AND REC ROOM- 5FT FROM FLOOR FOR TV Note:	
23,957 25Jun19	1 - POT LIGHT - SHOWER POT LIGHT- ADD TO TUB IN SHARED ENSUITE 2/3 Note:	
23,957 25Jun19	3 - LIGHT AND SWITCH - NO FIXTURE INCLUDED- ADD LIGHT TO SHARED ENSUITE 2/3 , BEDROOM 4 ENSUITE AND BED 5 REC ROOM ENSUITE Note:	
23,957 25Jun19	1 - PLUG - ELECTRICAL PLUG - ADD TO ISLAND Note:	
23,957 25Jun19	3 - POT LIGHTS TO BE ON DIMMER SWITCH- KITCHEN, BREAKFAST, FAMILY Note:	
23,957 25Jun19	1 - REC ROOM- ADD ROUGH IN ELECTRICAL FOR FUTURE WET BAR DISHWASHER & FRIDGE - SEE SKETCH Note:	
23,957 25Jun19	19 - POT LIGHT - LED - BASEMENT REC ROOM INSTALLATION Note:	
23,957 25Jun19	3 - REC ROOM- POT LIGHTS ON DIMMER SWITCHES- SEE SKETCH Note:	
23,957 25Jun19	1 - FIRST FLOOR MAIN HALL- DELETE STANDARD MAIN HALL LIGHTS- SEE SKETCH Note:	
23,957 25Jun19	1 - BASEMENT REC ROOM AND MAIN HALL- DELETE STANDARD LIGHTS - SEE SKETCH Note:	
23,957 25Jun19	1 - STANDARD PORCH LIGHT TO BE CENTERED IN PORCH CEILING Note:	
23,957 25Jun19	1 - MASTER BEDROOM CLOSET- ROUGH IN FOR FUTURE STACKABLE WASHER AND DRYER- PLUMBING, ELECTRICAL AND VENTING- SEE SKETCH FOR LOCATION Note:	
23,957 25Jun19	1 - MASTER BEDROOM- 3 WAY SWITCH - SEE SKETCH Note:	

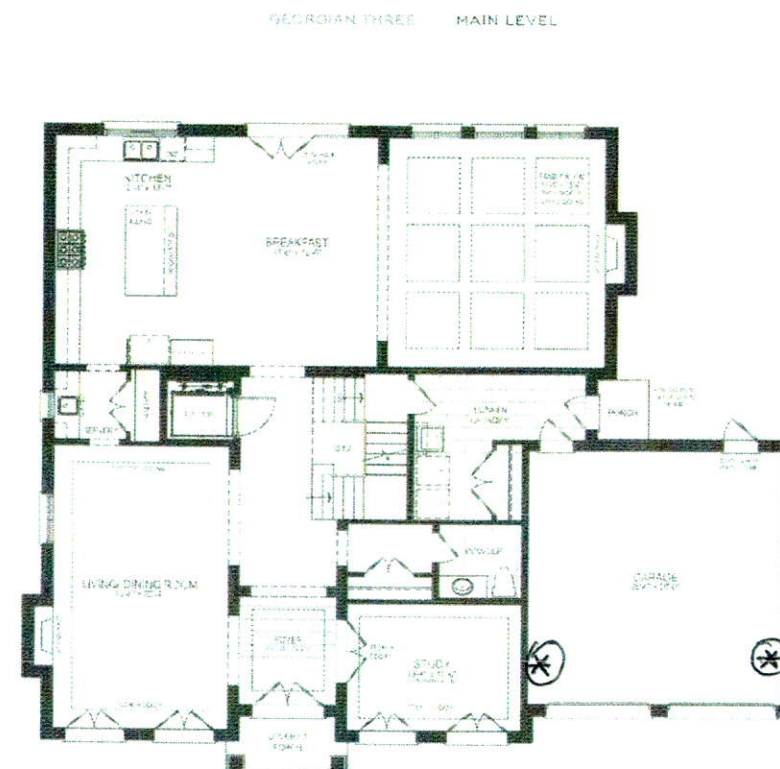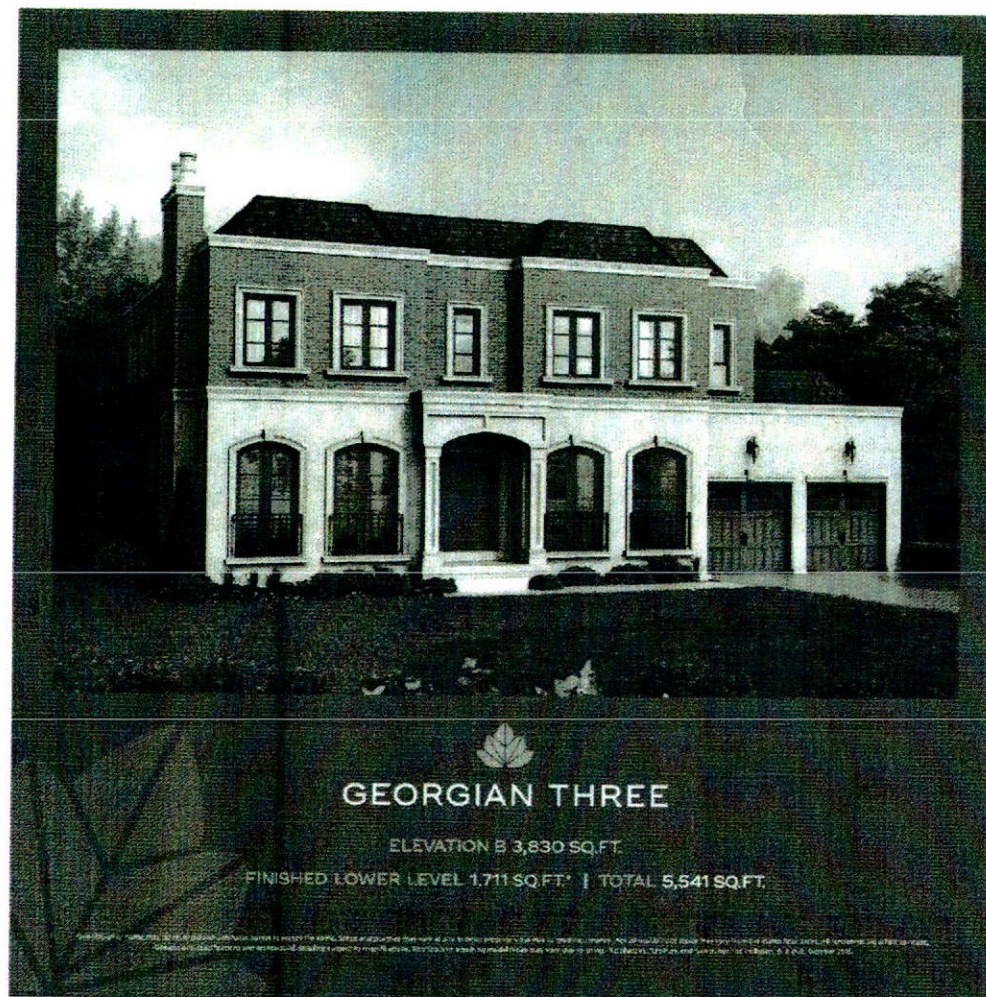

Impact North • 8555 Jane Street, Suite 300, Vaughan • 905.278.8555 • impactnorth.com

Role	Executive Director	Project #	1182
Client	Impact North	File Format	AutoCAD 2017
Job	Georgian Three - Elevation	File Size	12.1 MB
Publication		Name	
Revision Date			

Impact North Approval

Client Approval / Comments

Final Design Approval