


10/02/2010
N. R. POKHAREL
100156322
Province of Ontario

This stamp certifies compliance with the applicable
Design Guidelines only and bears no further
professional responsibility.

© 2004 Blackwell Publishing Ltd, *Journal of Internal Medicine* 255: 111–118

REC'D BY _____ DATE _____
REC'D TO _____ DATE _____

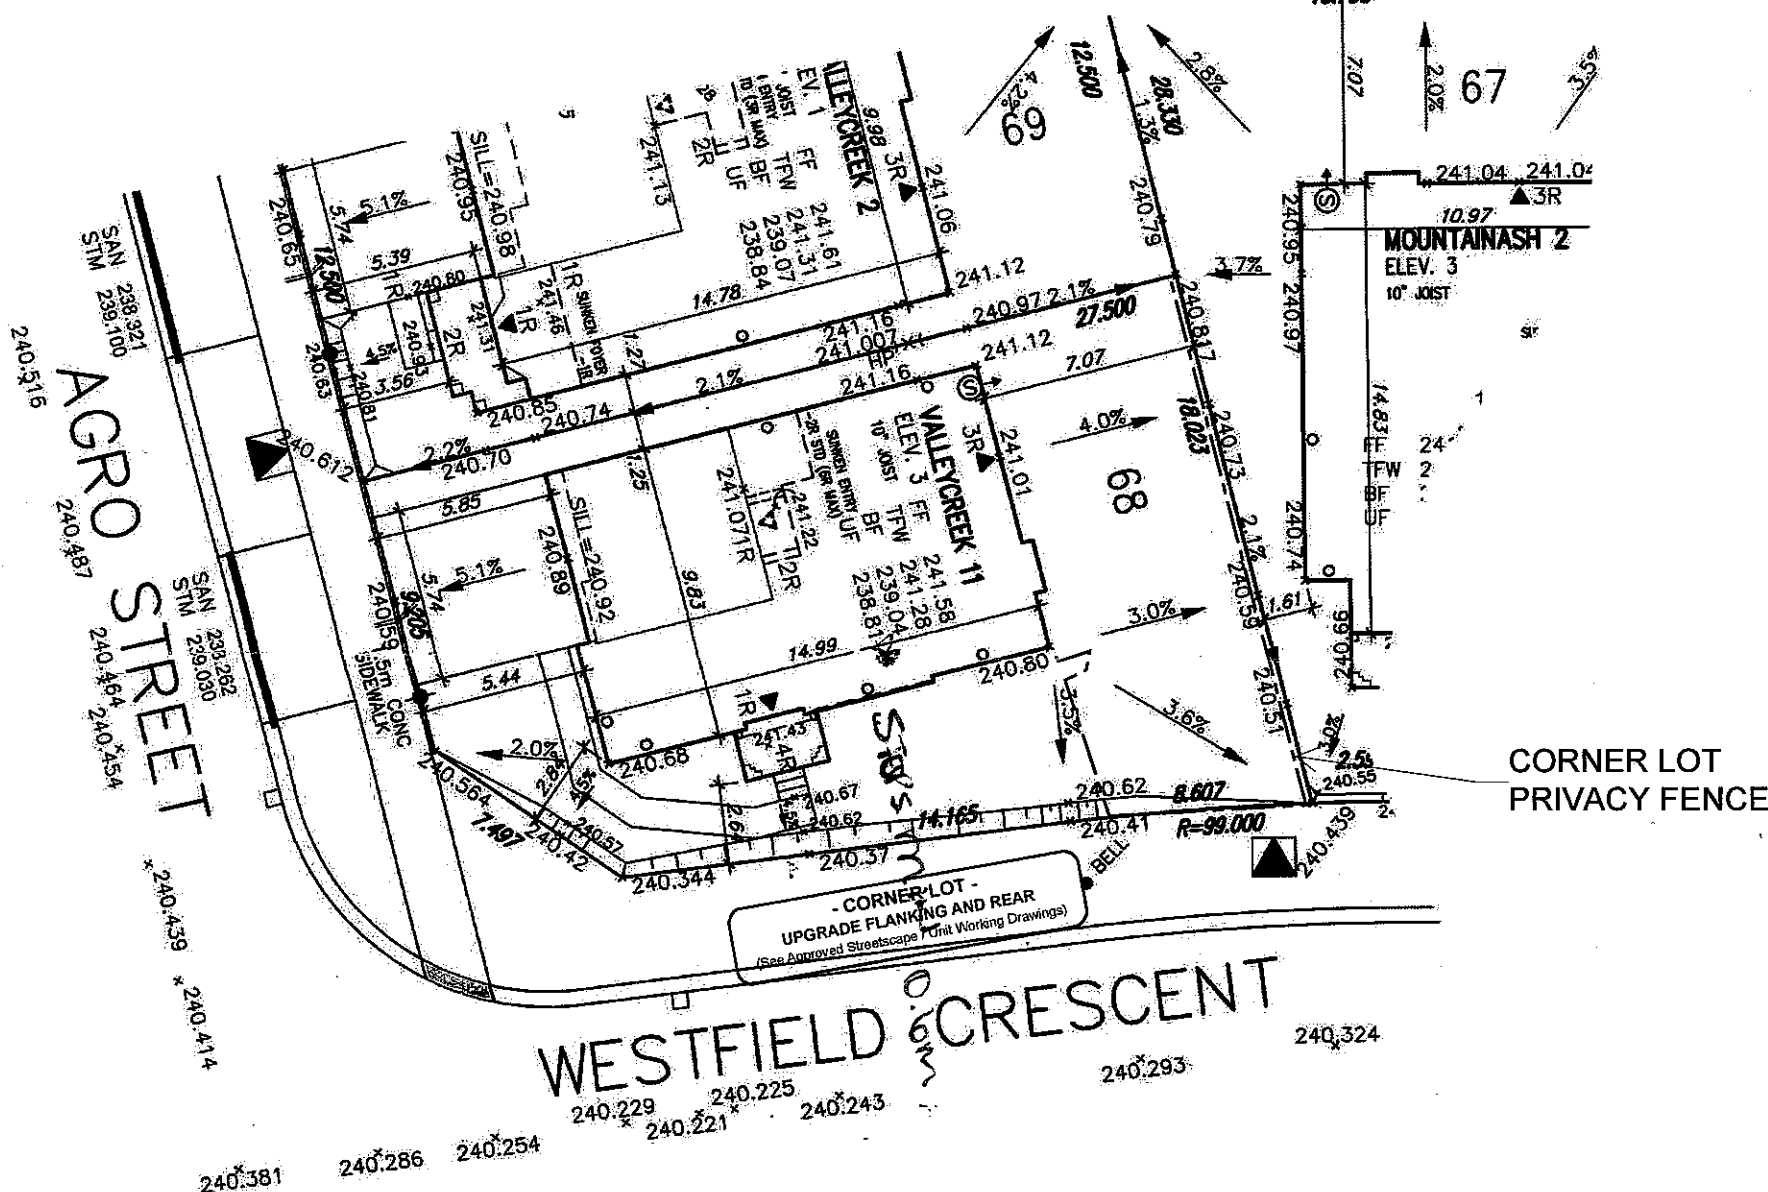

LOT 68		
LOT No.	LOT WIDTH (M) (@ 6.0m)	LOT AREA (M ²)
68	14.95	426.61

north · east

 Greenpark™		lot/block no. 068 registered plan no. 62M-1266
project name RUSSELL GARDENS PHASE 3		municipality HAMILTON project no. 19014
date SEPT. 2020		LOT SITING/GRADING drawing no. 1
drawn by GW	checked by -	scale 1:250
title 19014-RG3-SITE-LAYOUTS		file name 19014-RG3-SITE-LAYOUTS
GRCG - H:\ARCHIVE\WORKING\2019\19014\GRCG\SITE PLAN\19014-RG3-SITE-LAYOUTS.dwg - Fri - Oct 2 2020 - 9:11 AM		

All drawings, specifications, related documents and designs are the copyright property of W3 DESIGN. Reproduction of this property in whole or in part is strictly prohibited without W3 DESIGN's written permission.