

CONSTRUCTION SUMMARY

PURCHASERS: Mohit SABHARWAL and Puneet SIDHU
Mountainview Heights 3 (G) - Russell Gardens Building Ltd.

JUL 20 2020

TEL: RES.: 416-802-2312

LOT / PHASE 82 / 3	REG. PLAN # 62M-1266	HOUSE TYPE Valleycreek Five Elev 3	
-----------------------	-------------------------	---------------------------------------	--

CONSTRUCTION

4 - ENLARGE BASEMENT WINDOWS (MAY REQUIRE WINDOW WELLS) - WINDOW IS 30 INCHES X 24 INCHES 20Jul20 Note: IF CONSTRUCTION PERMITS	
---	--

ELECTRICAL

1 - 200 AMP ELECTRICAL SERVICE 20Jul20 Note:	
--	--





PLUMBING

2 - TOE TESTER - ADD TOE TESTER TO SHOWER - ALL SHOWERS 20Jul20 Note:	
---	--


PROMOTIONAL

1 - PARTIAL REDEMPTION OF PROMOTIONAL PACKAGE \$3,105.00 BALANCE (\$8,895.00) FORWARD TO BE USED AT A LATER DATE. ORIGINAL PROMOTIONAL PACKAGE OF \$12,000.00 AS PER SCHEDULE PE DATED 06/28/2020. 20Jul20 Note:	
--	--

This Document is Extremely Time Sensitive - Printed 20 Jul 20 at 15:09

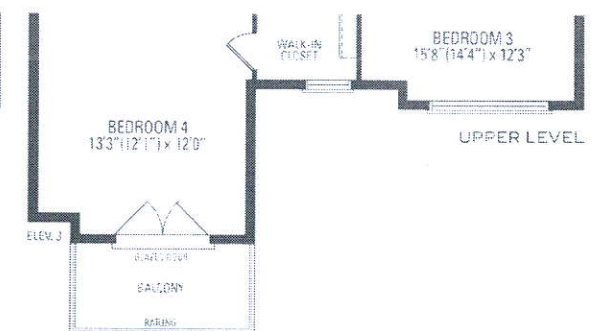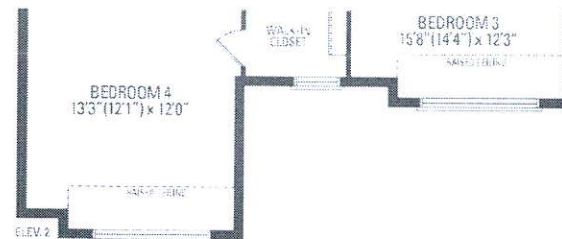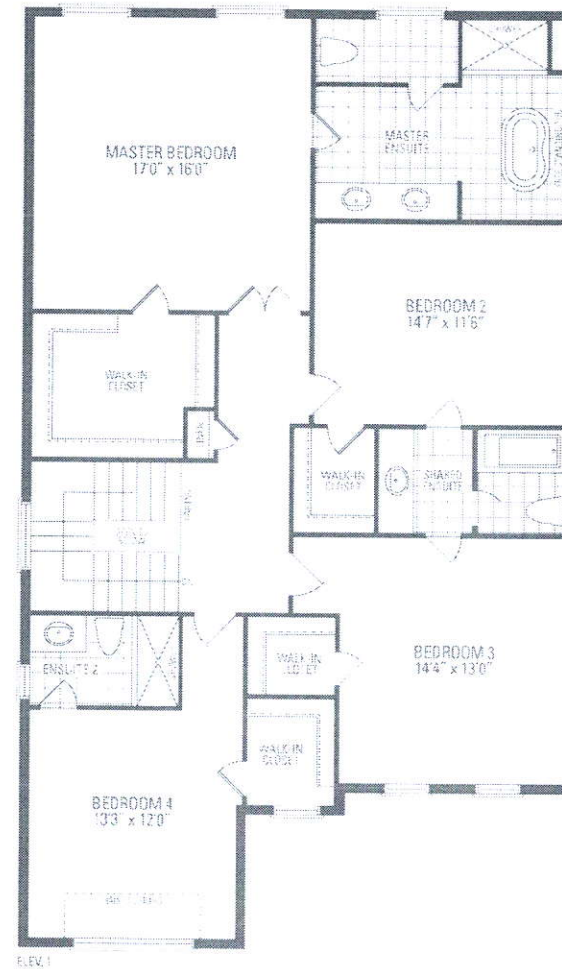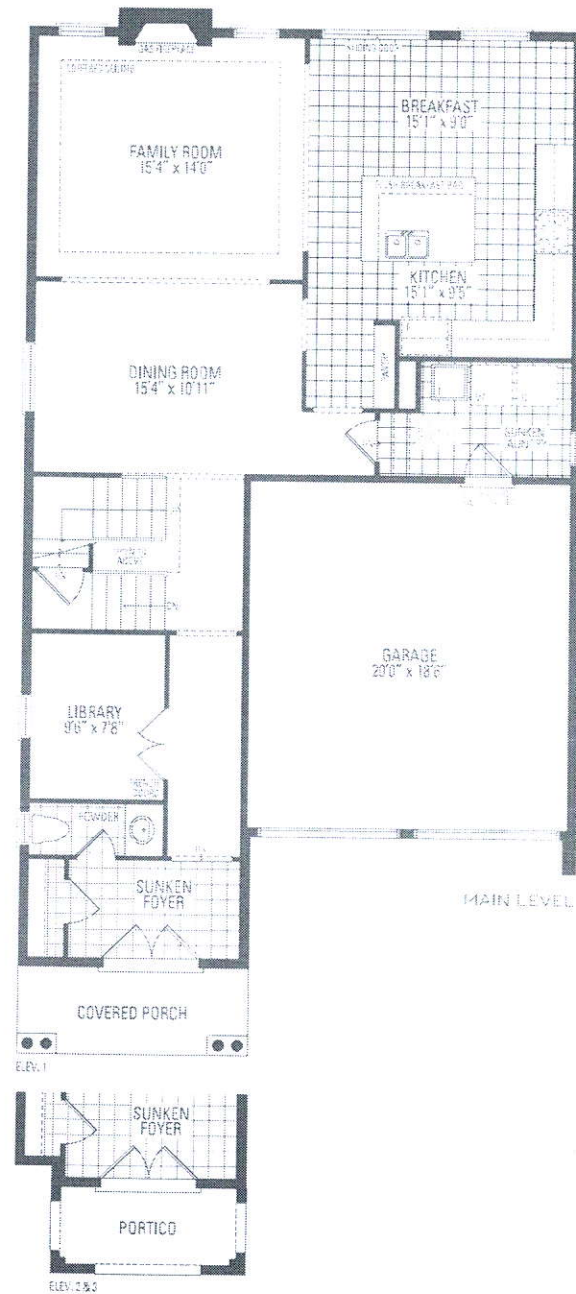

Larger Basement Windows

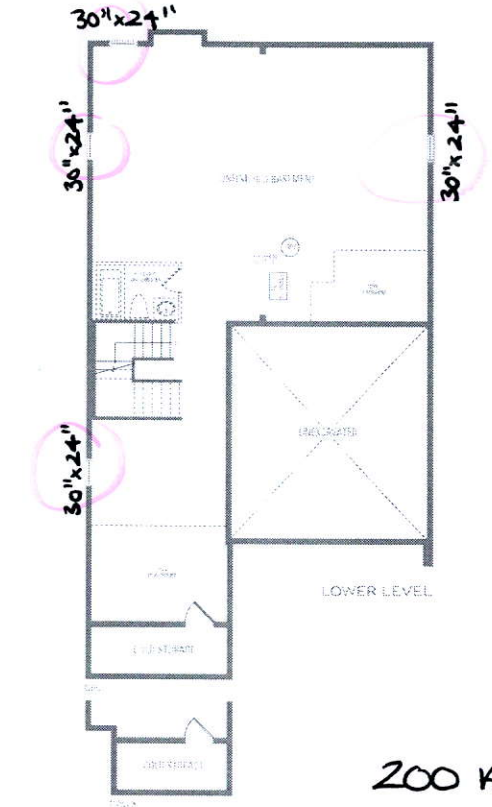

200 AMP

VALLEYCREEK FIVE

ELEV. 1 • 2,930 sq.ft. | ELEV. 2 + 3 • 2,933 sq.ft.

Orientation of home may be reversed and purchaser agrees to accept the same. Steps and porches may vary at any exterior entrance ways due to grading variance. Actual usable floor space may vary from the stated floor areas. All renderings are artist's concept. Dimensions, specifications and architectural detailing subject to modifications. Roofline and adjoining model types may vary due to siting. E. & D. E. May 2020