

CONSTRUCTION SUMMARY

Mountainview Heights 3 (G) - Russell Gardens Building Ltd.

PURCHASER: SUPREET SINGH

JUL 24 2020

TEL:

LOT / PHASE 98 / 3	REG. PLAN # 62M-1266	HOUSE TYPE Mountainash Eleven S Elev 3	
-----------------------	-------------------------	---	--

CONSTRUCTION

4 - ENLARGE BASEMENT WINDOWS (MAY REQUIRE WINDOW WELLS) - WINDOW IS 30 INCHES X 24 INCHES

23.Jul20 Note: IF CONSTRUCTION PERMITS

ELECTRICAL

1 - 200 AMP ELECTRICAL SERVICE

23.Jul20 Note:

PLUMBING

2 - TOE TESTER - ADD TOE TESTER TO SHOWER - ALL SHOWERS

23.Jul20 Note:


PROMOTIONAL

1 - PARTIAL REDEMPTION OF PROMOTIONAL PACKAGE \$3,105.00 BALANCE (\$8,895.00) FORWARD TO BE USED AT A LATER DATE. ORIGINAL PROMOTIONAL PACKAGE OF \$12,000.00 AS PER SCHEDULE PE DATED 07/02/2020.

23.Jul20 Note:

This Document is Extremely Time Sensitive - Printed 23 Jul 20 at 9:56

44' Lot • MOUNTAINASH 11S 2,943 SQ.FT.

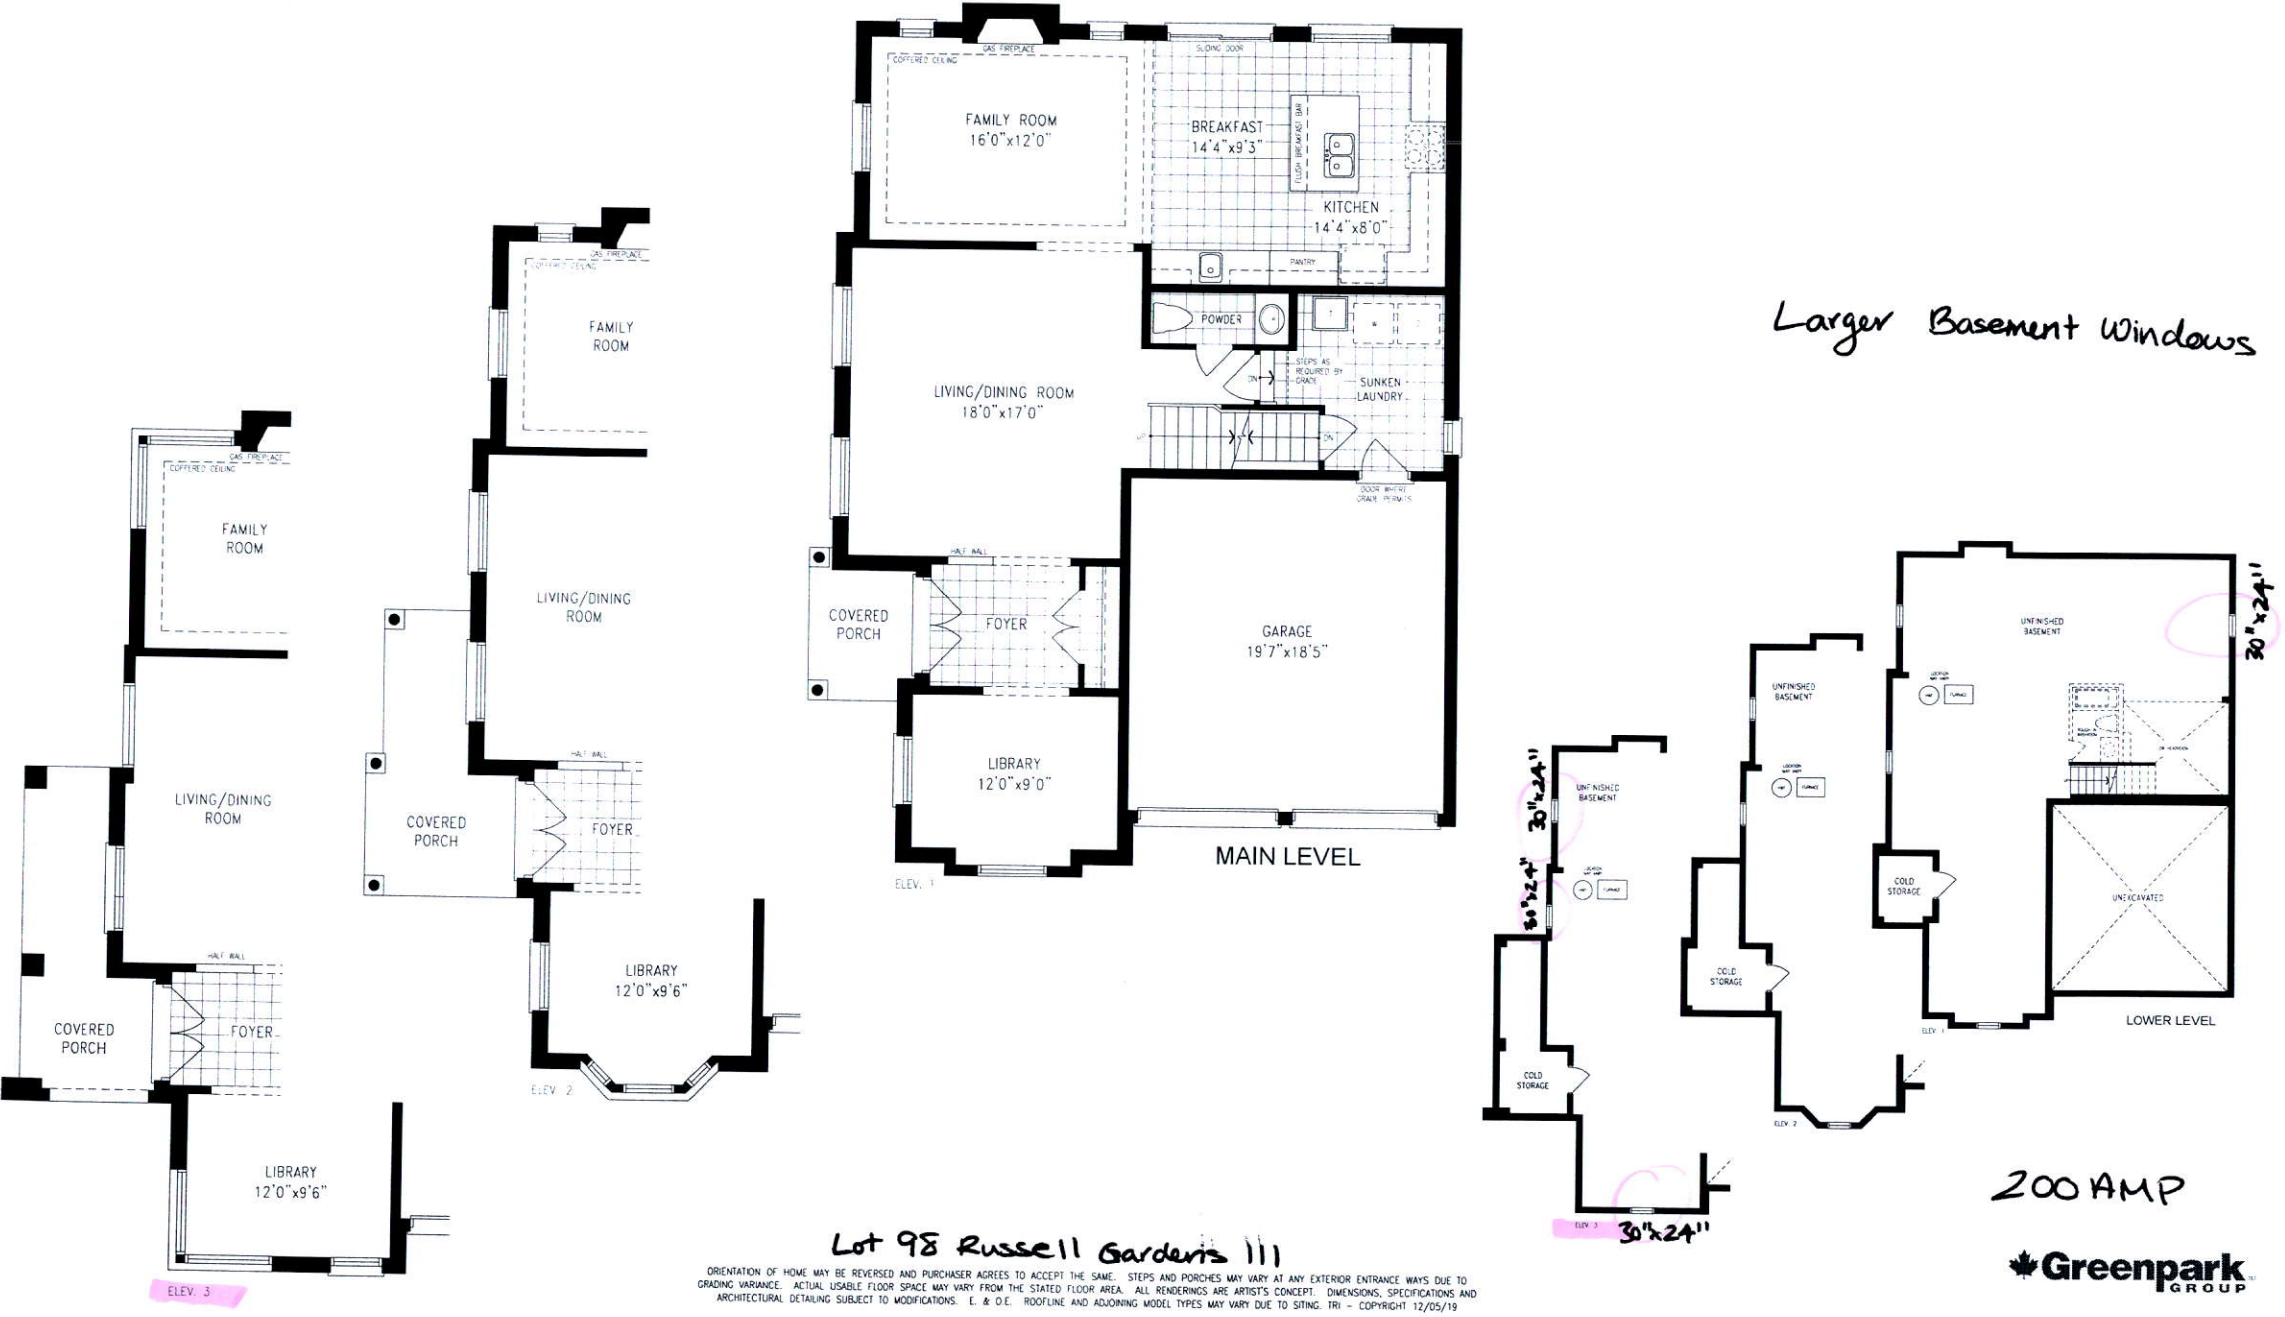

ORIENTATION OF HOME MAY BE REVERSED AND PURCHASER AGREES TO ACCEPT THE SAME. STEPS AND PORCHES MAY VARY AT ANY EXTERIOR ENTRANCE WAYS DUE TO GRADING VARIANCE. ACTUAL USABLE FLOOR SPACE MAY VARY FROM THE STATED FLOOR AREA. ALL RENDERINGS ARE ARTIST'S CONCEPT. DIMENSIONS, SPECIFICATIONS AND ARCHITECTURAL DETAILING SUBJECT TO MODIFICATIONS. E. & O.E. ROOFLINE AND ADJOINING MODEL TYPES MAY VARY DUE TO SITING. TRI - COPYRIGHT 12/05/19

44' Lot • MOUNTAINASH 11S 2,943 SQ.FT.



ORIENTATION OF HOME MAY BE REVERSED AND PURCHASER AGREES TO ACCEPT THE SAME. STEPS AND PORCHES MAY VARY AT ANY EXTERIOR ENTRANCE WAYS DUE TO GRADING VARIANCE. ACTUAL USABLE FLOOR SPACE MAY VARY FROM THE STATED FLOOR AREA. ALL RENDERINGS ARE ARTIST'S CONCEPT. DIMENSIONS, SPECIFICATIONS AND ARCHITECTURAL DETAILING SUBJECT TO MODIFICATIONS. E. & O.E. ROOFLINE AND ADJOINING MODEL TYPES MAY VARY DUE TO SITING. TRI - COPYRIGHT 12/05/19