

CONSTRUCTION SUMMARY			
PURCHASERS: BHAVESH PRABHUDAS PATEL and SANGEETA BHAVESH PATEL			
Mountainview Heights 3 (G) - Russell Gardens Building Ltd.			
TEL:			
AUG 13 2020			
LOT / PHASE	REG. PLAN #	HOUSE TYPE	
246 / 3	62M-1266	Mountainash Three (4 Bedroom) Elev 1	

CONSTRUCTION

1 - SHARED ENSUITE BEDROOM 3/4 - 5 FOOT SHOWER WITH SLIDING GLASS CHROME DOORS IN LIEU OF TUB 12Aug20 Note:	
1 - MASTER ENSUITE – FRAMELESS GLASS SHOWER ENCLOSURE – INCLUDES CHROME KNOB AND HINGES 12Aug20 Note: IF CONSTRUCTION PERMITS	

PLUMBING

3 - TOE TESTER - ADD TOE TESTER TO SHOWER - ALL SHOWERS 12Aug20 Note:	
--	--

PROMOTIONAL




1 - PARTIAL REDEMPTION OF PROMOTIONAL PACKAGE \$5,950.00 BALANCE (\$9,050.00) FORWARD TO BE USED AT A LATER DATE. ORIGINAL PROMOTIONAL PACKAGE OF \$15,000.00 AS PER SCHEDULE PE DATED 07/25/2020. 12Aug20 Note:	
---	--

EXTRAS AS PER OFFER


200 AMP	
3 LARGER BASEMENT WINDOWS Worksheet Note:	
(1) The Vendor agrees that notwithstanding any other term or provision in this Agreement included in the Purchase Price and in addition to those items detailed in Schedule GP to the Agreement of Purchase and Sale, the Purchaser is entitled to a credit of Worksheet Note:	
PURCHASER(S) ACKNOWLEDGES THAT THE PURCHASE PRICE IS INCLUSIVE OF ALL CREDITS AND PROMOTIONAL PACKAGES AVAILABLE AT TIME OF PURCHASE. Worksheet Note:	

Frameless Glass
(shower Enclosure)

Larger Basement Windows

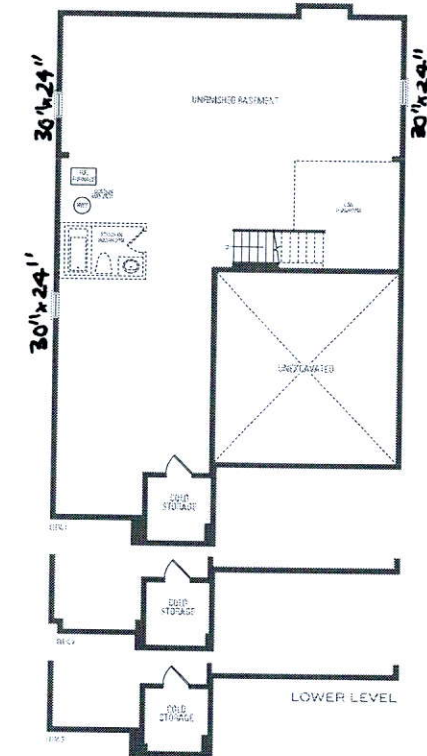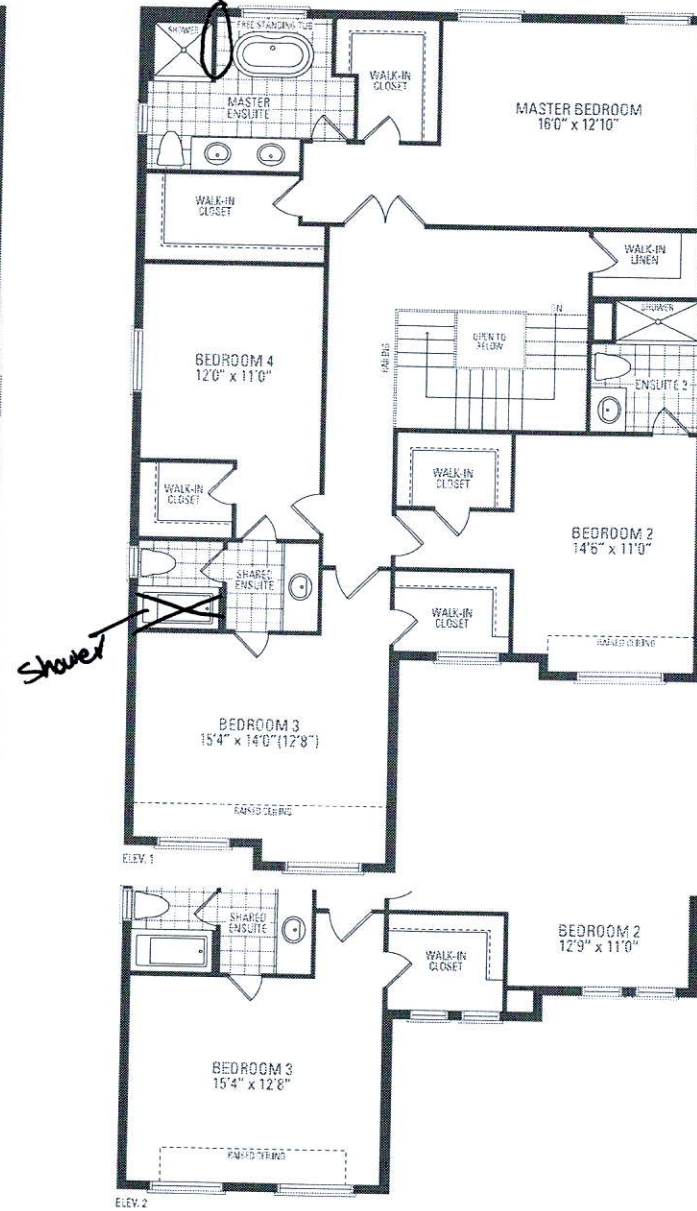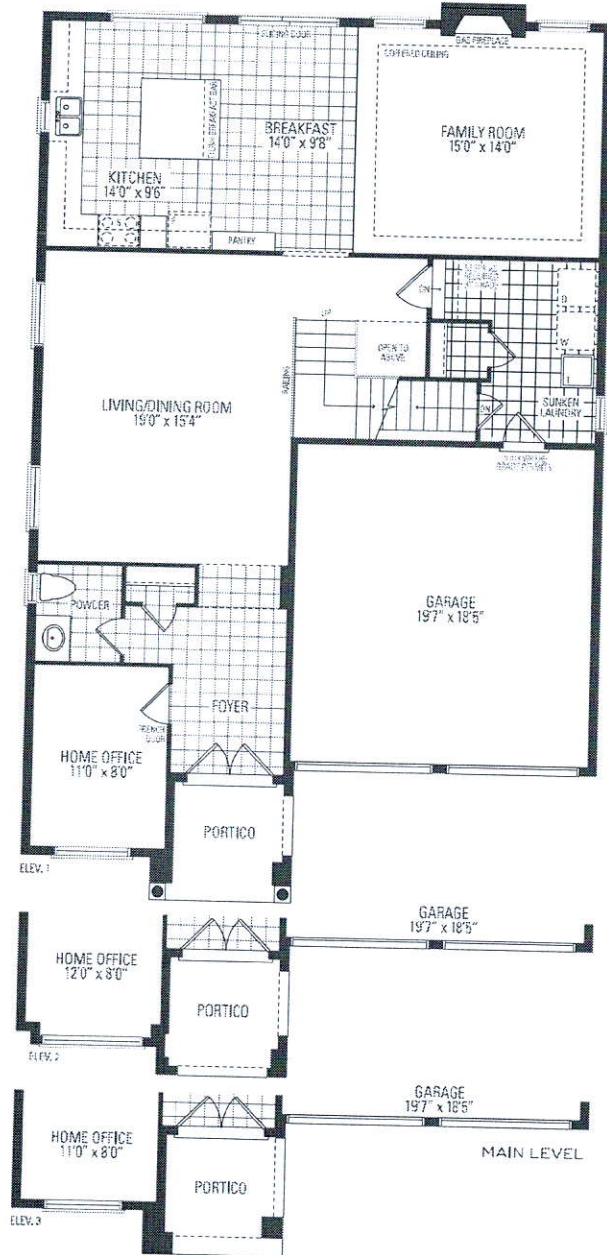

200 AMP

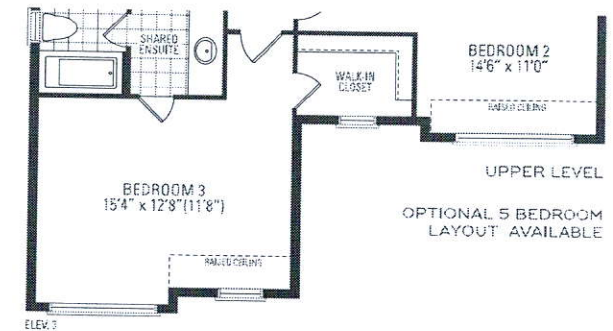

Lot 246 Russell Gardens III
MOUNTAINASH THREE ELEV. 1 • 3,086 sq.ft. | ELEV. 2 •

Orientation of home may be reversed and purchaser agrees to accept the same. Steps and porches may vary at any exterior entrance ways due to grading variances. Actual usable floor space may vary from the stated floor areas. All renderings are artist's concept. Dimensions, specifications and architectural detailing subject to modifications. Footing and adjoining model types may vary due to the siting. L & O, E. May 2020