



CONSTRUCTION SUMMARY				JUL 27 2020
PURCHASERS: Ravi Prafullach DAVE and Jayshree P. DAVE // Monalben Girish DAVE				TEL:
LOT / PHASE	REG. PLAN #	HOUSE TYPE		
264 / 3	62M-1266	Mountainash Six (4 Bedroom) Elev 2		
CONSTRUCTION				
1 - BASEMENT 8 FOOT 6 INCH CONCRETE POUR - MEASURED FROM TOP OF FOOTING TO TOP OF FOUNDATION WALL				
27Jul20	Note:			
1 - ADD BASEMENT WALK-UP				
27Jul20	Note:			
ELECTRICAL				
1 - 200 AMP ELECTRICAL SERVICE				
27Jul20	Note:			
MIRRORS AND GLASS				
1 - FRAMELESS GLASS SHOWER DOOR-				
27Jul20	Note:			
MASTER ENSUITE - FRAMELESS GLASS SHOWER DOOR & FRONT WALL AT SEAT - INCLUDES CHROME KNOB & HINGES				
PLUMBING				
1 - 5 FOOT SHOWER WITH SLIDING GLASS CHROME DOORS IN LIEU OF TUB-IN SHARD ENSUITE-				
27Jul20	Note:			
3 - TOE TESTER - ADD TOE TESTER TO ALL SHOWERS				
27Jul20	Note:			
PROMOTIONAL				
1 - LESS CREDIT FROM PURCHASER EXTRA SHEET IN OFFER				
27Jul20	Note:			
EXTRAS AS PER OFFER				
10 FEET CEILING ON MAIN FLOOR.				
Worksheet Note:				
The Vendor agrees that notwithstanding any other term or provision in this Agreement included in the Purchase Price and in addition to those items detailed in Schedule GP to the Agreement of Purchase and Sale, the Purchaser is entitled to a credit of Two				
Worksheet Note:				

This Document is Extremely Time Sensitive - Printed 27 Jul 20 at 15:46

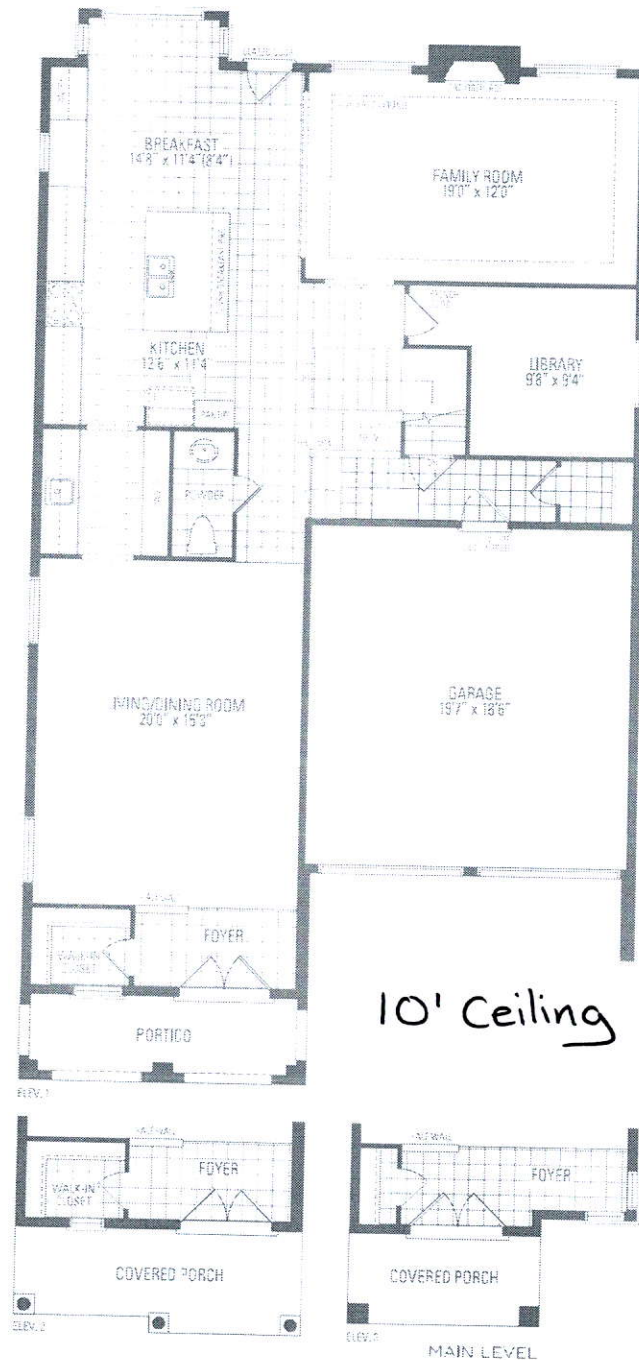


10' Ceiling

8'6" Pour
Walk-up

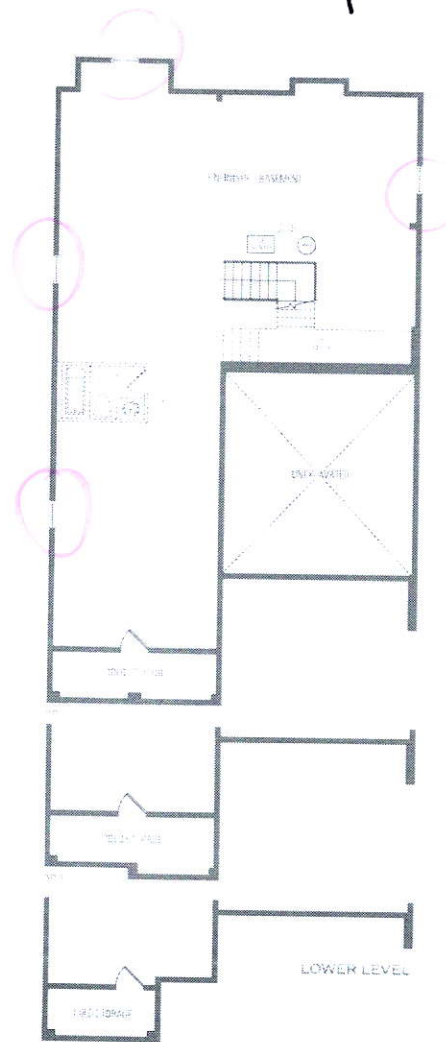

200 AMP

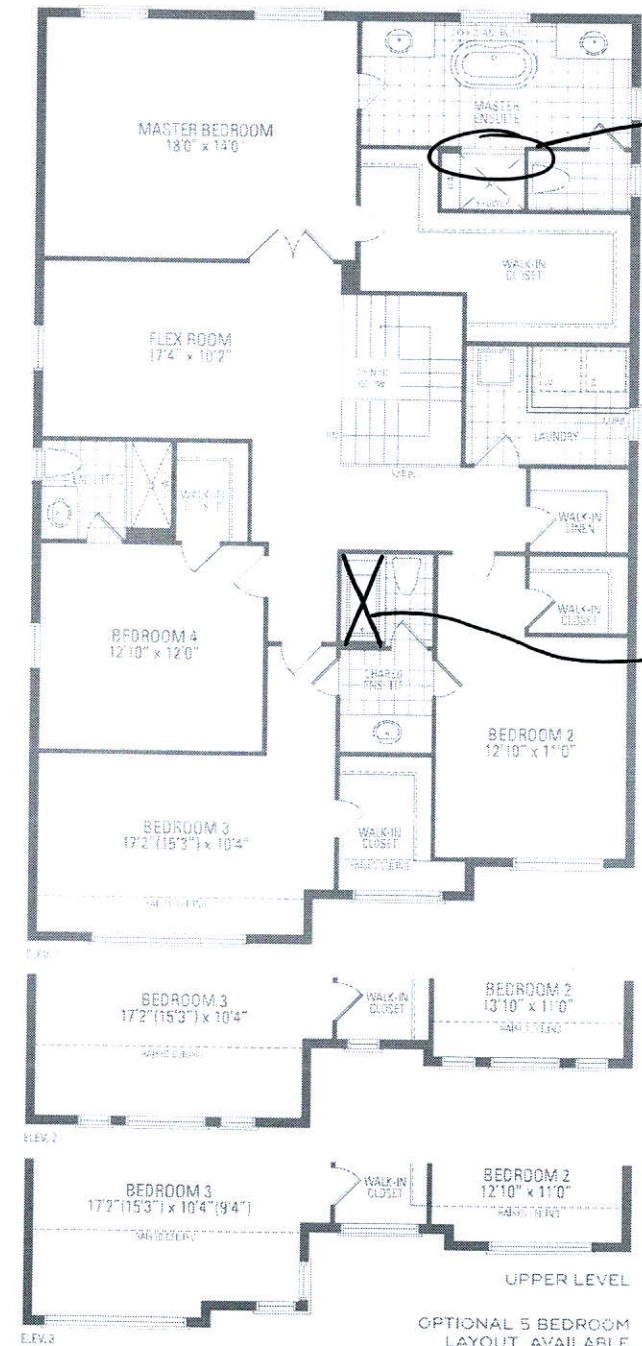

Frameless
Shower Door &
Front Wall at
Seat

shower

MOUNTAINASH SIX ELEV. 1 • 3,409 sq.ft. | ELEV. 2 • 3,403 sq.ft. | ELEV. 3 • 3,368 sq.ft.

Orientation of home may be reversed and purchaser agrees to accept the same. Steps and porches may vary at any exterior entrance ways due to grading variance. Actual usable floor space may vary from the stated floor areas. All renderings are a best effort concept. Dimensions, specifications, and architectural detailing subject to modification. Routine and adjoining model types may vary due to siting. E. & D. E. May 2020