

CONSTRUCTION SUMMARY				JUL 3 1 2020
Mountainview Heights 3 (G) - Russell Gardens Building Ltd.				TEL:
PURCHASERS: Bushra S. A. SYED and Shamsheir Ali SYED				
LOT / PHASE	REG. PLAN #	HOUSE TYPE		
283 / 3	62M-1266	Mountainash Six (4 Bedroom) Elev 3		

CONSTRUCTION

1 - BEDROOM 2/3 SHARED ENSUITE - 5 FOOT SHOWER WITH SLIDING GLASS CHROME DOORS IN LIEU OF TUB	
31Jul20 Note:	
1 - MASTER ENSUITE – FRAMELESS GLASS SHOWER DOOR AND FRONT WALL AT SEAT INCLUDES CHROME KNOB AND HINGES	
31Jul20 Note:	



ELECTRICAL

1 - 200 AMP ELECTRICAL SERVICE	
31Jul20 Note:	


PROMOTIONAL

1 - PARTIAL REDEMPTION OF PROMOTIONAL PACKAGE \$5,365.00 BALANCE (\$6,635.00) FORWARD TO BE USED AT A LATER DATE. ORIGINAL PROMOTIONAL PACKAGE OF \$12,000.00 AS PER SCHEDULE PE DATED 07/14/2020.	
31Jul20 Note:	

This Document is Extremely Time Sensitive - Printed 31 Jul 20 at 9:13

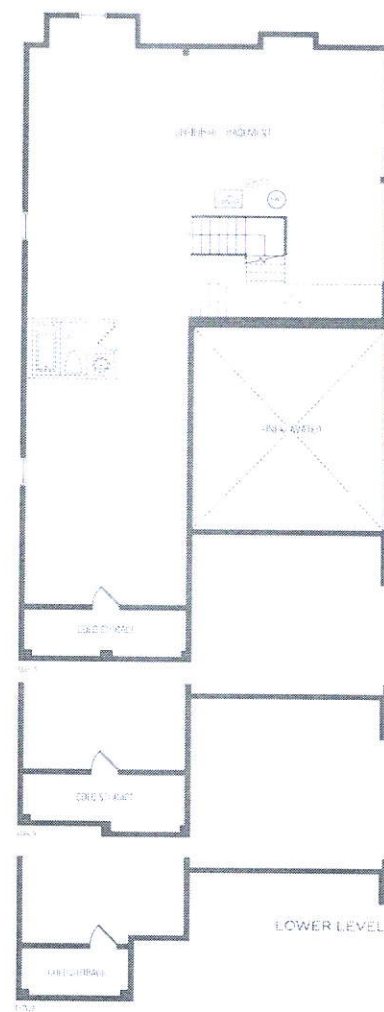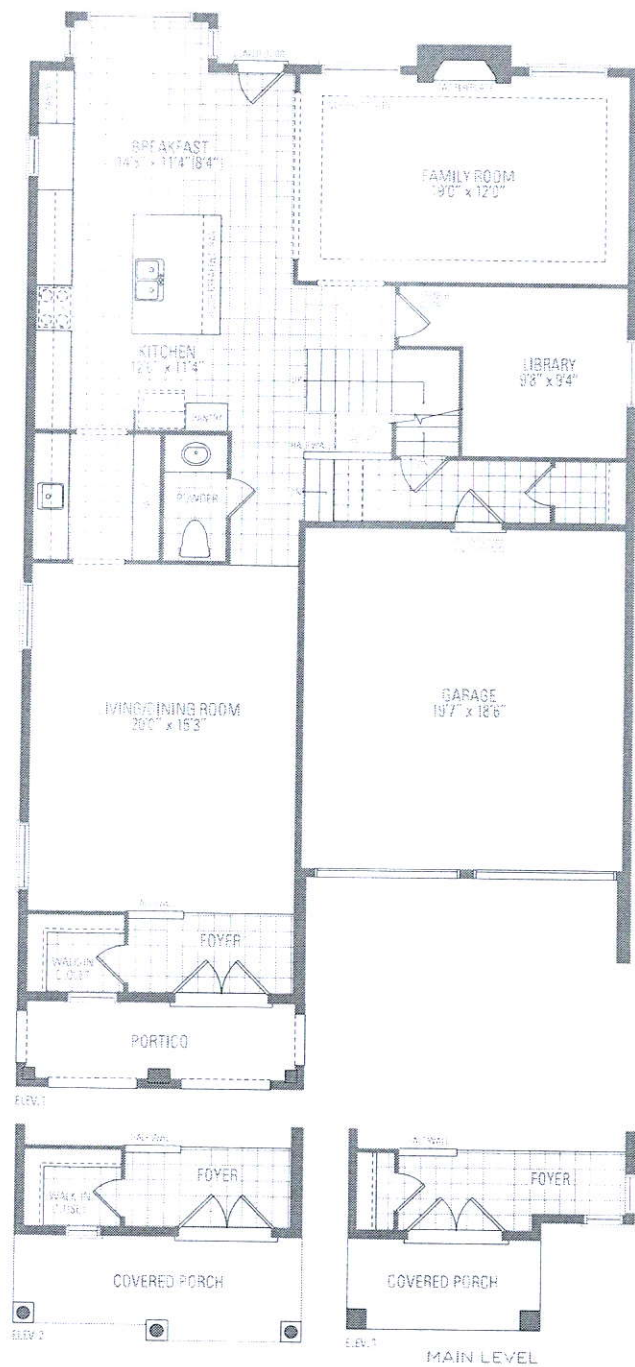

200 AMP

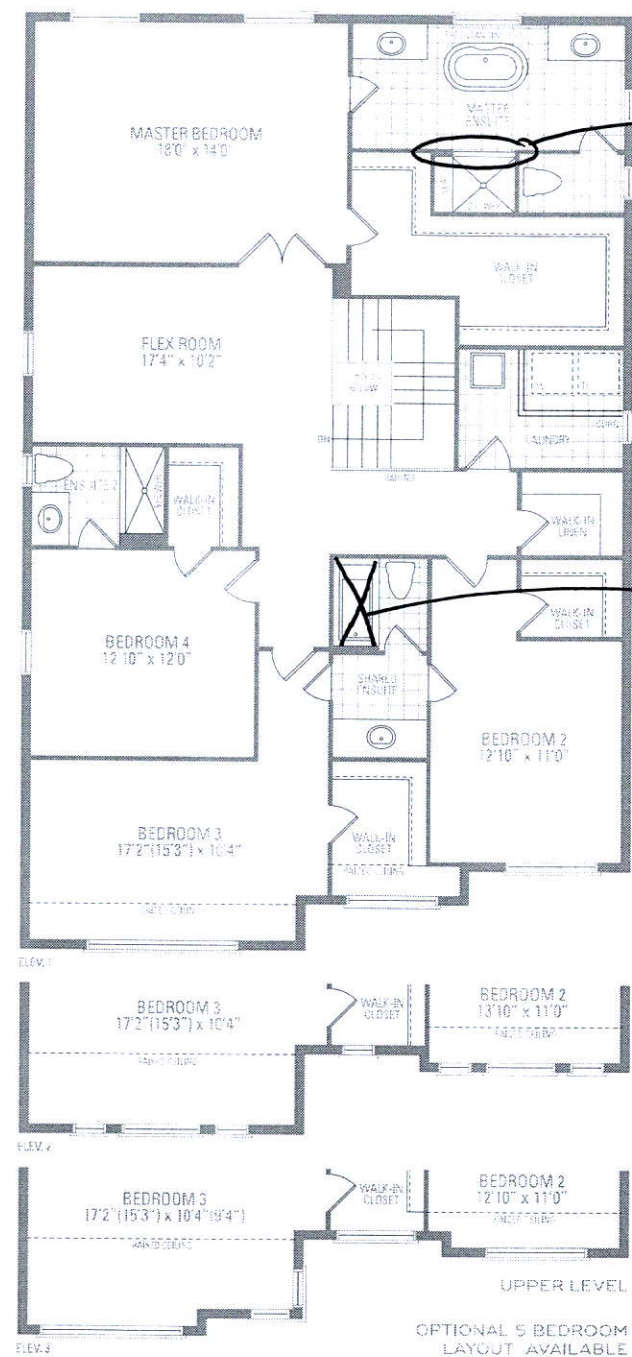

Frameless
Glass shower
Door & Front
Wall @ seat

Shower

Lot 283 Russell Gardens III
MOUNTAINASH SIX

ELEV. 1 • 3,409 sq.ft. | ELEV. 2 • 3,403 sq.ft. | ELEV. 3 • 3,368 sq.ft.

Orientation of home may be reversed and purchaser agrees to accept the same. Steps and porches may vary at any exterior entrance ways due to grading variance. Actual usable floor space may vary from the stated floor areas. All renderings are artist's concept. Dimensions, specifications and architectural detailing subject to modifications. Roofing and adjoining model types may vary due to string. B. & O. E. May 2020