

CONSTRUCTION SUMMARY

Mountainview Heights 3 (G) - Russell Gardens Building Ltd.

PURCHASERS: VANEET PAL KAUR and Ravinder Pal SINGH

TEL:

LOT / PHASE 295 / 3	REG. PLAN # 62M-1266	HOUSE TYPE Mountainash Six (5 Bedroom) Elev 3		
------------------------	-------------------------	--	--	--

CONSTRUCTION

1 - FIRST FLOOR INCREASE CEILING HEIGHT FROM 9 FEET TO 10 FEET 22Jul20 Note: IF CONSTRUCTION PERMITS	
1 - MASTER ENSUITE - FRAMELESS GLASS SHOWER DOOR & FRONT WALL AT SEAT INCLUDES CHROME KNOB & HINGES 22Jul20 Note: IF CONSTRUCTION PERMITS	
4 - ENLARGE BASEMENT WINDOWS (MAY REQUIRE WINDOW WELLS) - WINDOW IS 30 INCHES X 24 INCHES 22Jul20 Note: IF CONSTRUCTION PERMITS	

ELECTRICAL

1 - 200 AMP ELECTRICAL SERVICE 22Jul20 Note:	
---	--

PLUMBING

2 - TOE TESTER - ADD TOE TESTER TO SHOWER - ALL SHOWERS 22Jul20 Note:	
--	--




PROMOTIONAL

1 - LESS CREDIT FROM PURCHASER EXTRA SHEET IN OFFER 22Jul20 Note:	
--	--


EXTRAS AS PER OFFER

The Vendor agrees that notwithstanding any other term or provision in this Agreement included in the Purchase Price and in addition to those items detailed in Schedule GP to the Agreement of Purchase and Sale, the Purchaser is entitled to a credit of Two Worksheet Note:	
---	--

This Document is Extremely Time Sensitive - Printed 22 Jul 20 at 10:38

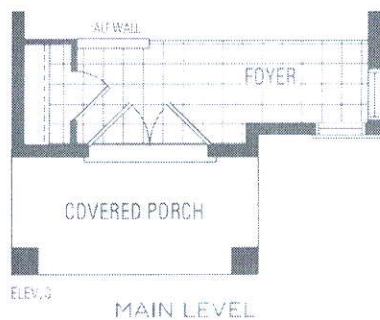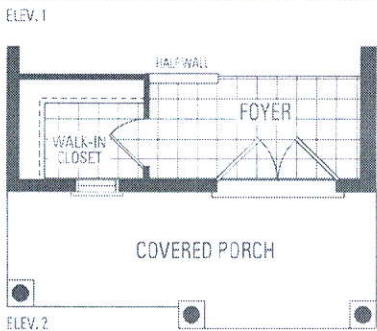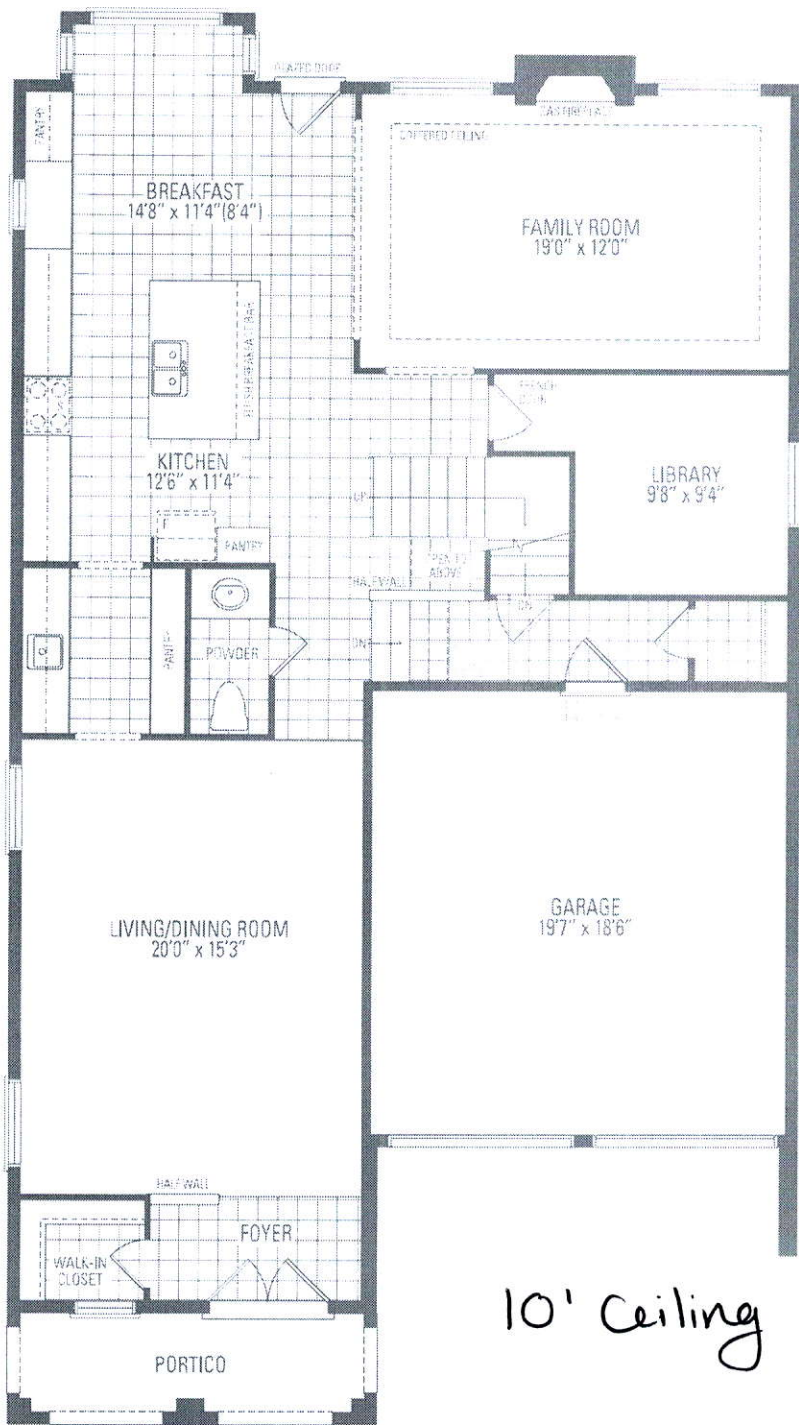

Enlarge Basement Windows

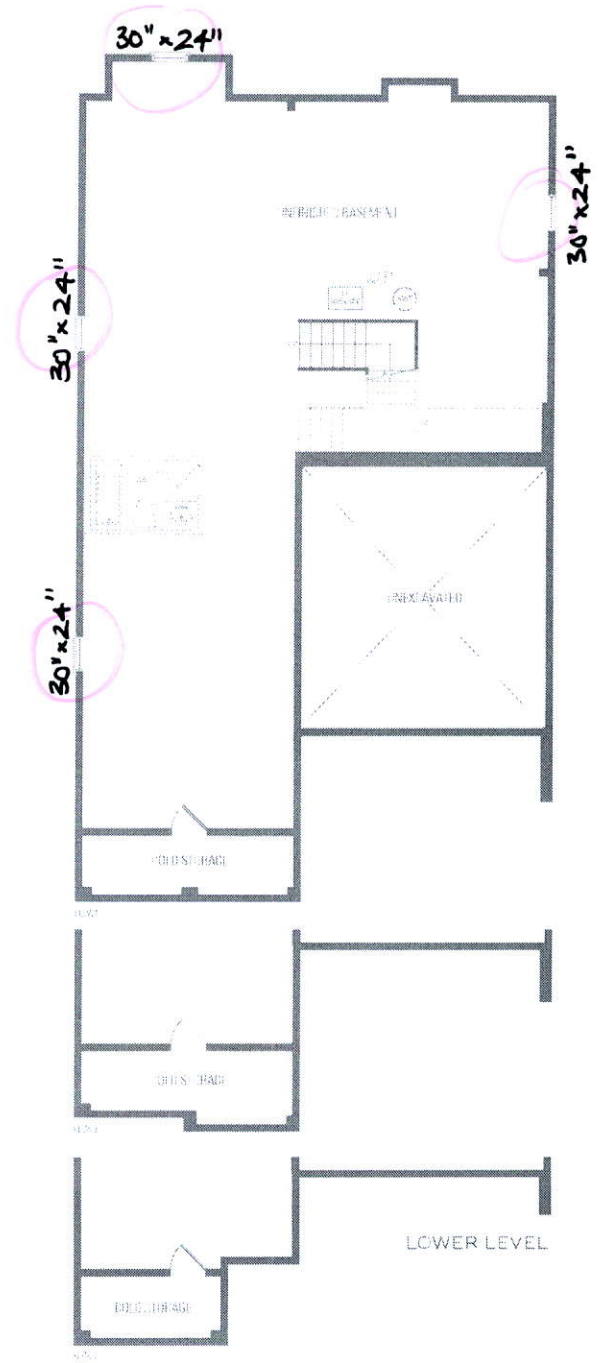

MOUNTAINASH SIX ELEV. 1 • 3,409 sq.ft. | ELEV. 2 • 3,403

Orientation of home may be reversed and purchaser agrees to accept the same. Steps and porches may vary at any exterior entrance with the stated floor areas. All renderings are artist's concept. Dimensions, specifications and architectural detailing subject to modifications. Roof

ELEV. 1 • 3,409 sq.ft. | ELEV. 2 • 3,403 sq.ft. | ELEV. 3 • 3,368 sq.ft.

