

CONSTRUCTION SUMMARY

Mountainview Heights 3 (G) - Russell Gardens Building Ltd.

JUL 27 2020

PURCHASERS: GURINDER BIR SINGH and Ramneet KAUR

TEL:

LOT / PHASE	REG. PLAN #	HOUSE TYPE	
297 / 3	62M-1266	Valleycreek Six Elev 3	

CONSTRUCTION

1 - ADD CLEAR GLASS PANEL DOORS TO LIBRARY/HOME OFFICE AT FOYER AS PER SKETCH 27Jul20 Note:	
1 - SHARED ENSUITE BEDROOM 3/4 - 5 FOOT SHOWER WITH SLIDING GLASS CHROME DOORS IN LIEU OF TUB 27Jul20 Note:	
1 - MASTER ENSUITE - FRAMELESS GLASS SHOWER ENCLOSURE INCLUDES CHROME KNOB & HINGES 27Jul20 Note: IF CONSTRUCTION PERMITS	
4 - ENLARGE BASEMENT WINDOWS (MAY REQUIRE WINDOW WELLS) - WINDOW IS 30 INCHES X 24 INCHES 27Jul20 Note: IF CONSTRUCTION PERMITS	

ELECTRICAL

1 - 200 AMP ELECTRICAL SERVICE 27Jul20 Note:	
--	--




PROMOTIONAL

1 - PARTIAL REDEMPTION OF PROMOTIONAL PACKAGE \$10,305.00 BALANCE (\$1,695.00) FORWARD TO BE USED AT A LATER DATE. ORIGINAL PROMOTIONAL PACKAGE OF \$12,000.00 AS PER SCHEDULE PE DATED 07/07/2020. 27Jul20 Note:	
---	--

EXTRAS AS PER OFFER

The Vendor agrees that notwithstanding any other term or provision in this Agreement included in the Purchase Price and in addition to those items detailed in Schedule GP to the Agreement of Purchase and Sale, the Purchaser is entitled to a credit of Two <i>Worksheets</i> Note:	
---	--

This Document is Extremely Time Sensitive - Printed 27 Jul 20 at 13:29

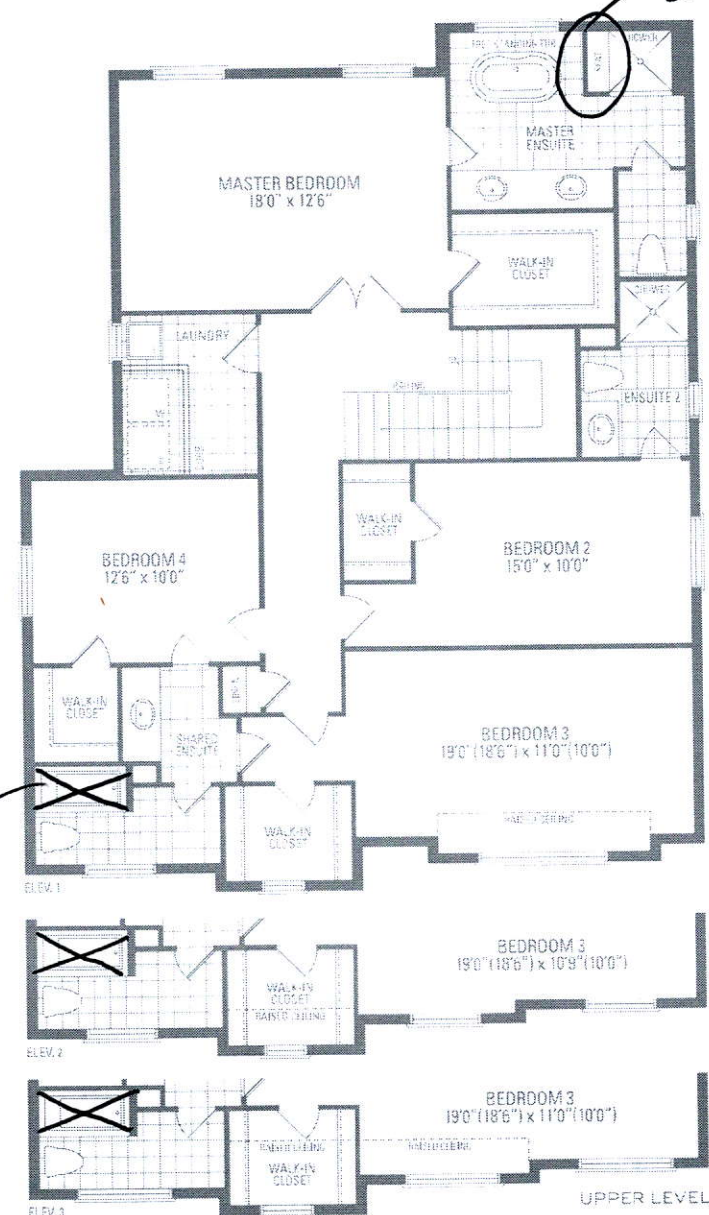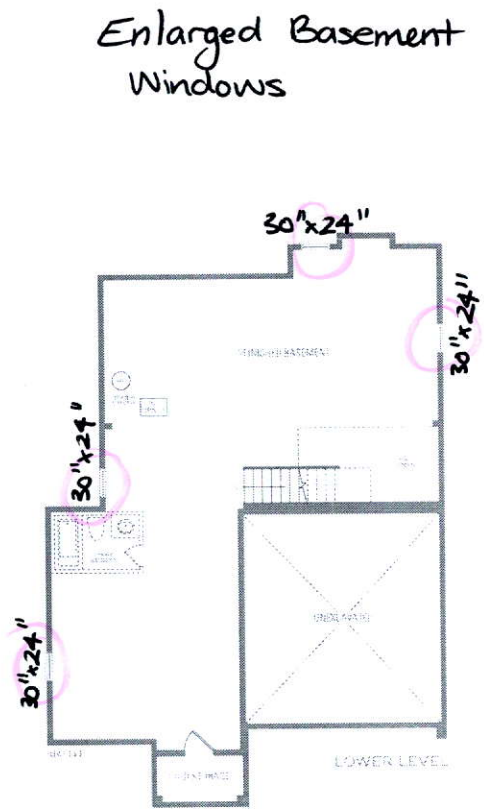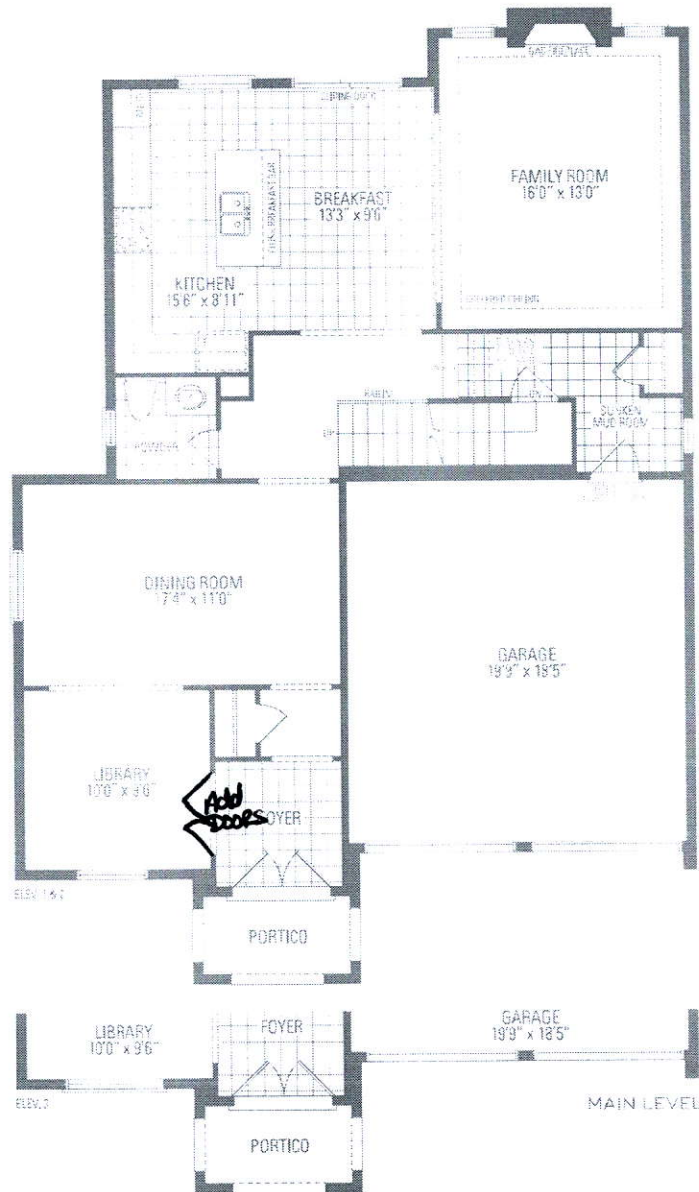

shower

200 AMP

VALLEYCREEK SIX ELEV. 1 • 2,836 sq.ft. | ELEV. 2 + 3 • 2,830 sq.ft.

Orientation of home may be reversed and purchaser agrees to accept the same. Steps and porches may vary at any exterior entrance ways due to grading variance. Actual usable floor space may vary from the stated floor areas. All renderings are artist's concept. Dimensions, specifications and architectural detailing subject to modifications. Roofline and adjoining model types may vary due to siting. E. & O. E. May 2020


LOT 297

RUSSELL GARDENS
PHASE 3
MOUNTAINVIEW HEIGHTS

VALLEYCREEK 6
ELEV. 3

REVISION:

1. CONVERT LIBRARY TO HOME OFFICE, ADD GLASS PANEL DOORS AS PER SKETCH

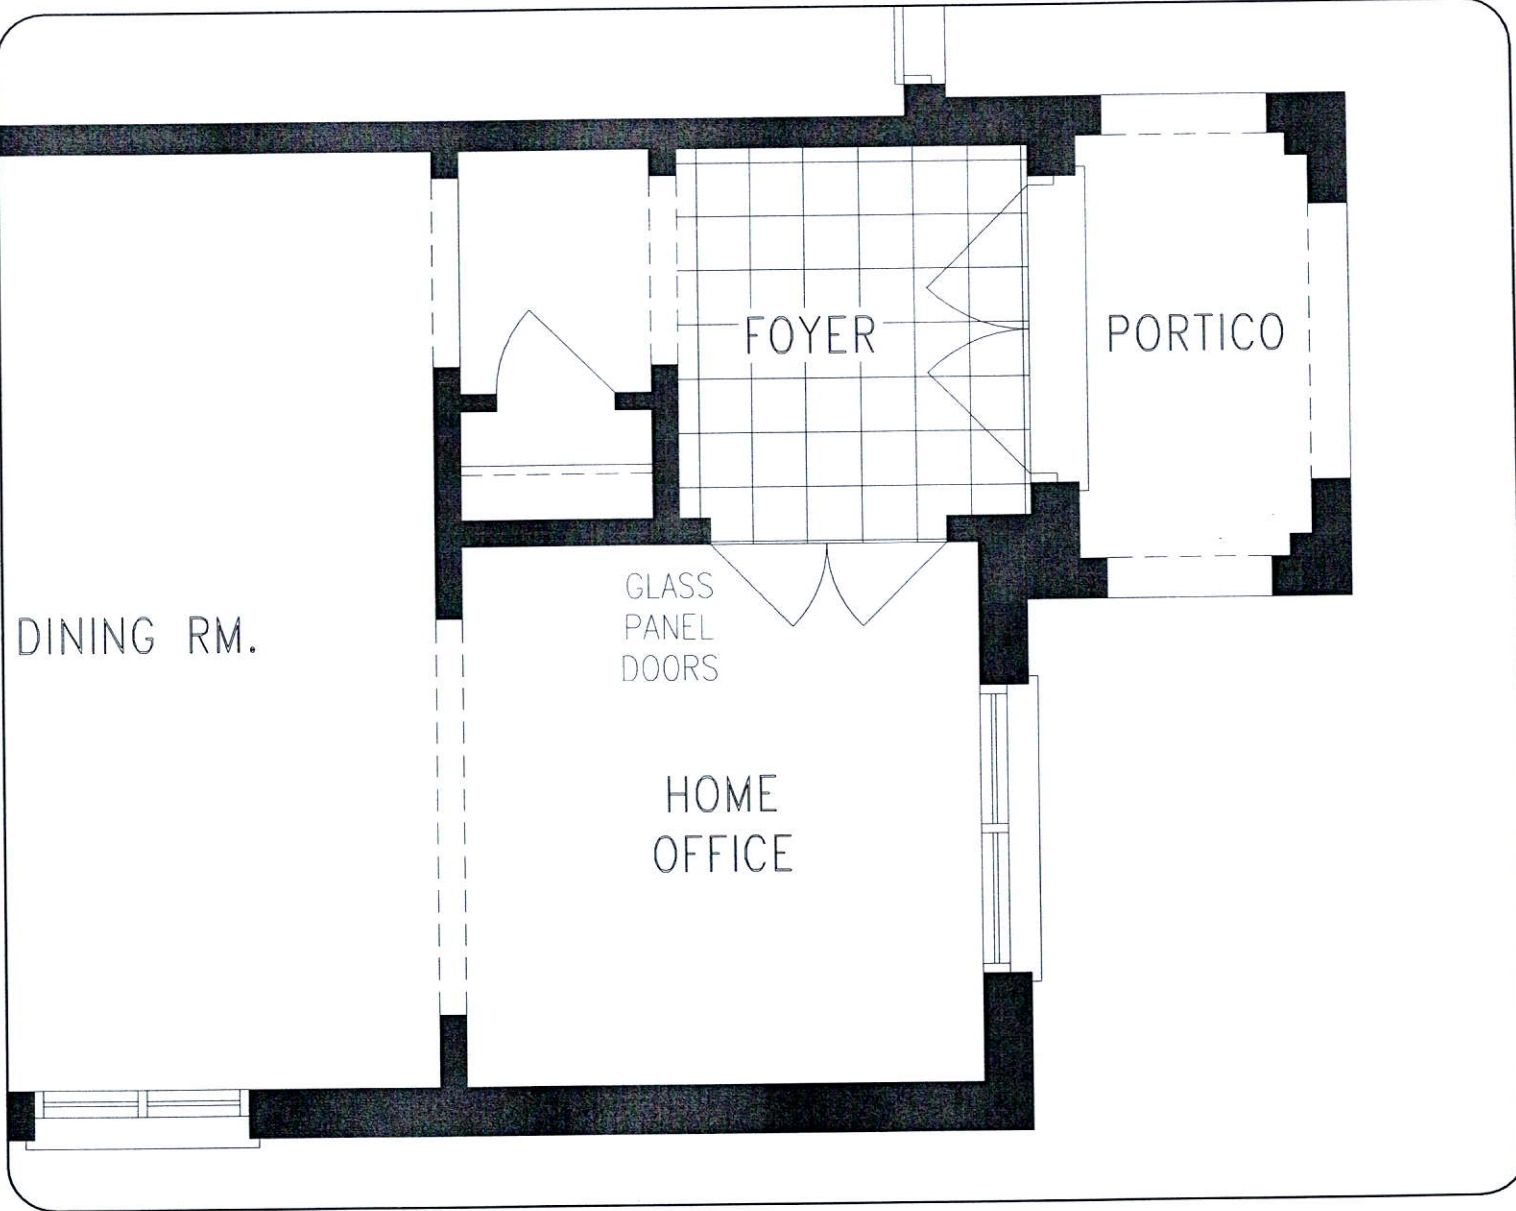

MAIN LEVEL

DISCLAIMERS: SKETCH NOT TO SCALE. DIMENSIONS, SPECIFICATIONS AND ARCHITECTURAL DETAILS SUBJECT TO MODIFICATION BY THE VENDOR. SKETCH IS ONLY FOR THE PURPOSE OF ILLUSTRATING REVISIONS REQUESTED BY THE PURCHASER AND ALL REVISIONS ARE SUBJECT TO VENDOR'S FINAL APPROVAL. ONLY REVISIONS ACCEPTED IN WRITING BY THE PURCHASER AND VENDOR ON A PURCHASER'S EXTRA SHEET WILL BE INCORPORATED INTO THE PLANS FILED WITH THE MUNICIPALITY. E. & O.E.

**REGION
DESIGN
INC.**

SCALE		N.T.S.
BY	PAGE No.	
VG	1 OF 1	

Greenpark™


PURCHASER ALTERATION FORM

LOT 297
RUSSELL GARDENS
PHASE 3
MOUNTAINVIEW HEIGHTS

VALLEYCREEK 6
ELEV. 3

REVISION:

1. CONVERT LIBRARY TO HOME OFFICE, ADD GLASS PANEL DOORS AS PER SKETCH

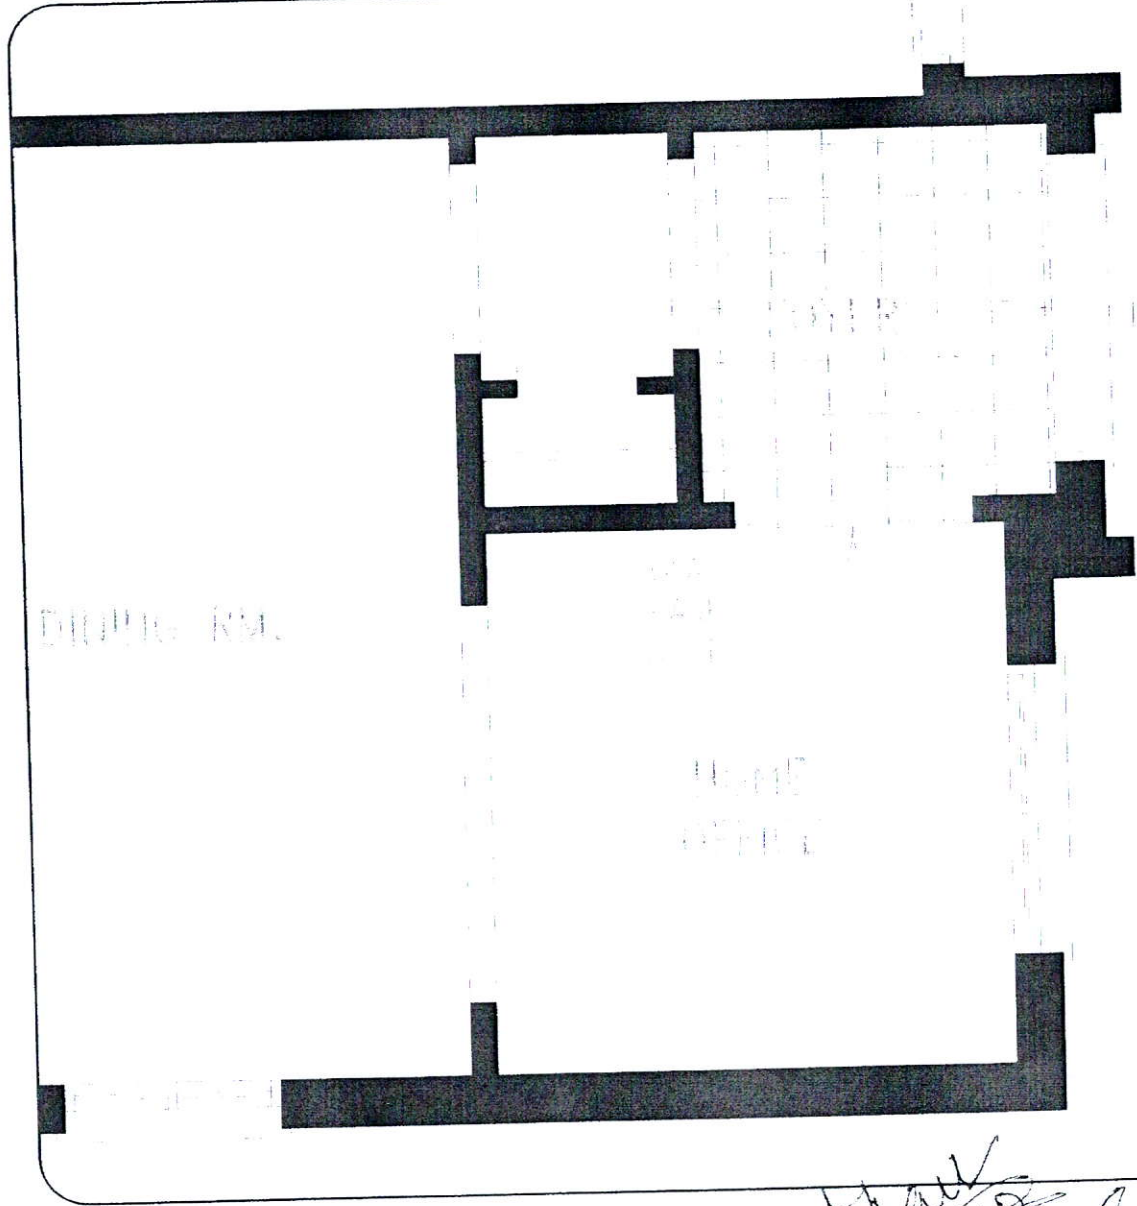

Benett Hall
[Signature]

REGION
DESIGN
INC.