


PURCHASER: Nafisa ARSHAD			CONSTRUCTION SUMMARY		AUG 13 2020	
Mountainview Heights 3 (G) - Russell Gardens Building Ltd.					TEL:	
LOT / PHASE	REG. PLAN #	HOUSE TYPE				
300 / 3	62M-1266	Valleycreek Four Elev 1				
CONSTRUCTION						
1 - MASTER ENSUITE – FRAMELESS GLASS SHOWER ENCLOSURE – INCLUDES CHROME KNOB AND HINGES 12Aug20 Note: IF CONSTRUCTION PERMITS						
ELECTRICAL						
1 - 200 AMP ELECTRICAL SERVICE 12Aug20 Note:						
PROMOTIONAL						
1 - PARTIAL REDEMPTION OF PROMOTIONAL PACKAGE \$4,365.00 BALANCE (\$7,635.00) FORWARD TO BE USED AT A LATER DATE. ORIGINAL PROMOTIONAL PACKAGE OF \$12,000.00 AS PER SCHEDULE PE DATED 07/12/2020. 12Aug20 Note:						


EXTRAS AS PER OFFER

The Vendor agrees that notwithstanding any other term or provision in this Agreement included in the Purchase Price and in addition to those items detailed in Schedule GP to the Agreement of Purchase and Sale, the Purchaser is entitled to a credit of Two Worksheet Note:	
WALK-UP BASEMENT. Worksheet Note:	
3 LARGER BASEMENT WINDOWS. Worksheet Note:	
PURCHASER(S) ACKNOWLEDGES THAT THE PURCHASE PRICE IS INCLUSIVE OF ALL CREDITS AND PROMOTIONAL PACKAGES AVAILABLE AT TIME OF PURCHASE. Worksheet Note:	


This Document is Extremely Time Sensitive - Printed 12 Aug 20 at 16:32

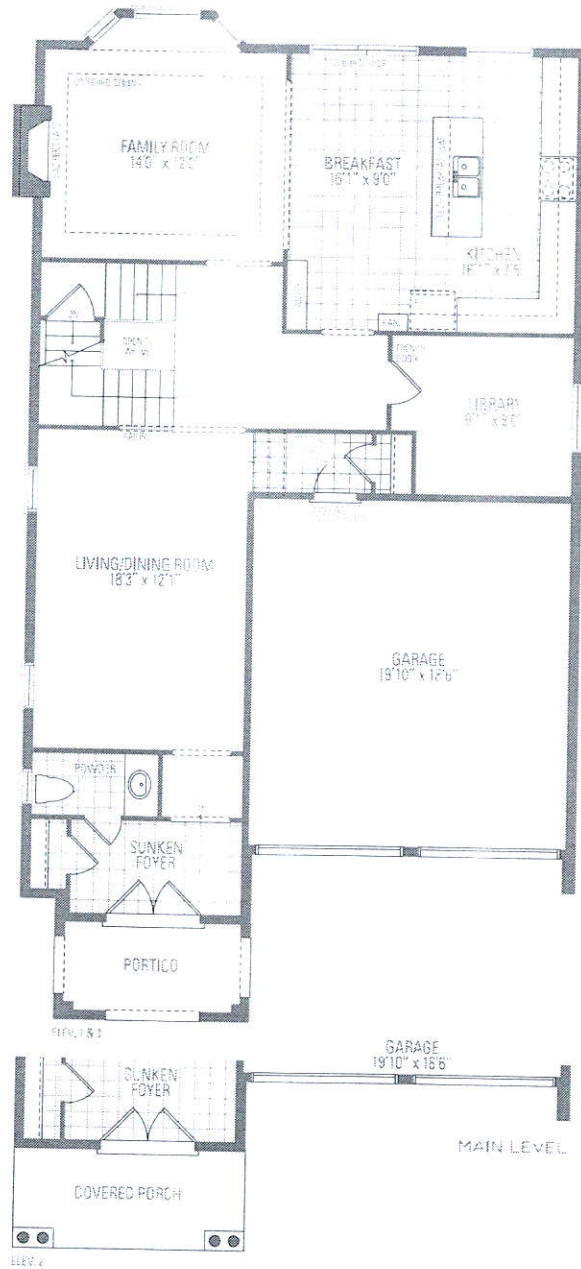

Larger Basement windows
Walk-up

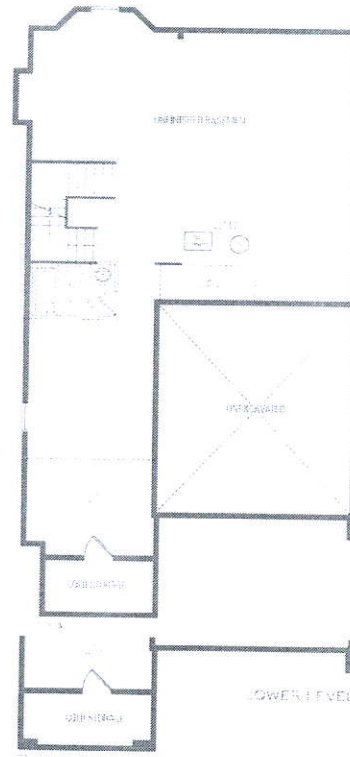

200 AMP

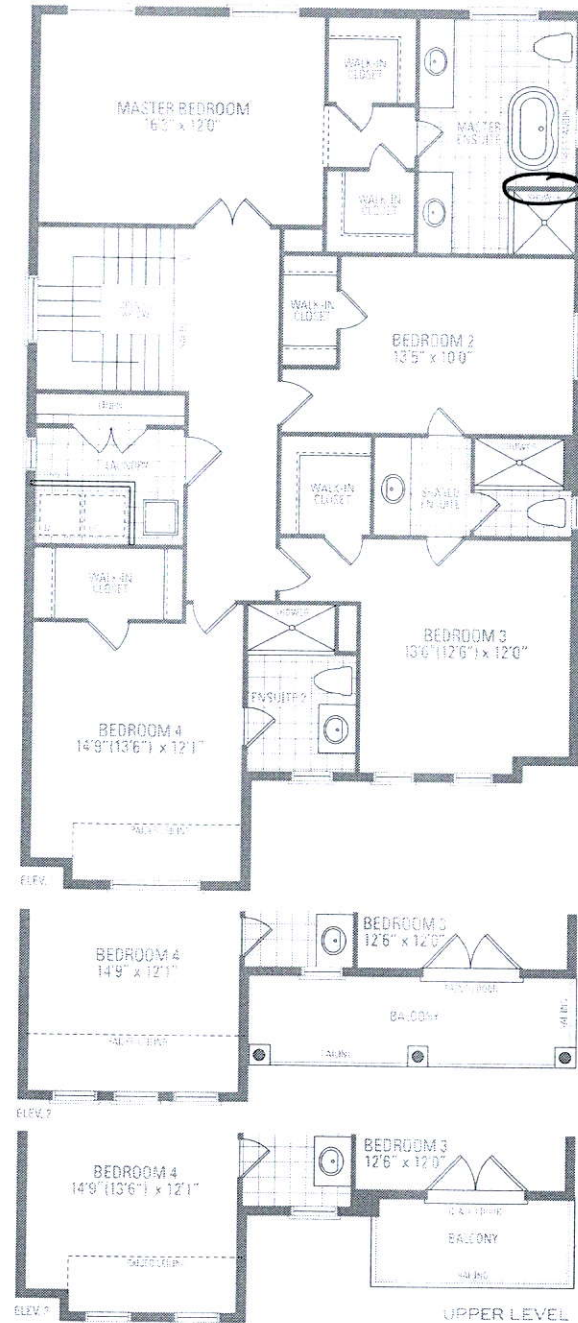

Frameless Glass
shower Enclosure

Lot 300 Russell Gardens III
VALLEYCREEK FOUR

ELEV. 1 • 2,814 sq.ft. | ELEV. 2 • 2,805 sq.ft. | ELEV. 3 • 2,816 sq.ft.

Or location of home may be reversed and purchaser agrees to accept the same. Steps and priorities may vary at any exterior entrance ways due to grading variance. Actual usable floor space may vary from the stated floor areas. All renderings are artist's concept. Dimensions, specifications and architectural detailing subject to modifications. Rookline and adjoining model types may vary due to siting. E. & O. E. May 2020