

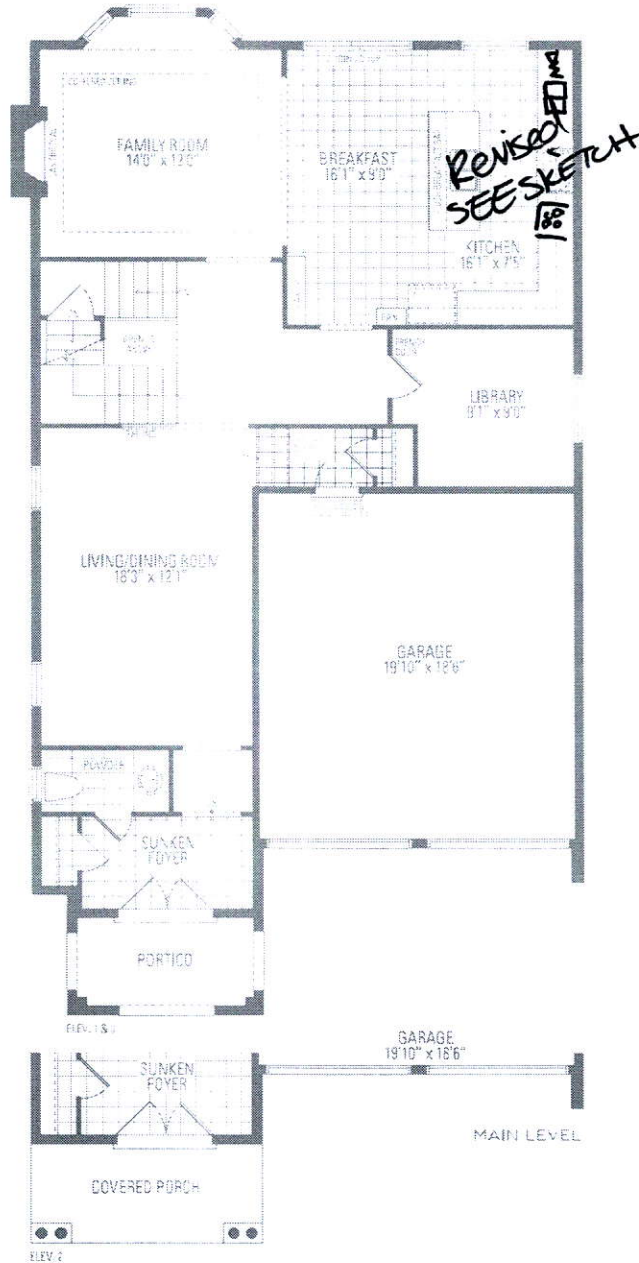


CONSTRUCTION SUMMARY			
PURCHASERS: Pinaben Alpeshkumar PATEL and Alpeshkumar Maheshbhai PATEL		Mountainview Heights 3 (G) - Russell Gardens Building Ltd.	
DATE: JUL 29 2020		TEL:	
LOT / PHASE 302 / 3	REG. PLAN # 62M-1266	HOUSE TYPE Valleycreek Four Elev 3	
CONSTRUCTION			
1 - KITCHEN - RELOCATE SINK & DISHWASHER TO STOVE WALL AS PER SKETCH			
28Jul20 Note:			
3 - ENLARGE BASEMENT WINDOWS (MAY REQUIRE WINDOW WELLS) - WINDOW IS 30 INCHES X 24 INCHES			
28Jul20 Note: IF CONSTRUCTION PERMITS			
ELECTRICAL			
1 - 200 AMP ELECTRICAL SERVICE			
28Jul20 Note:			
PLUMBING			
3 - TOE TESTER - ADD TOE TESTER TO SHOWER - ALL SHOWERS			
28Jul20 Note:			
PROMOTIONAL			
1 - PARTIAL REDEMPTION OF PROMOTIONAL PACKAGE \$3,270.00 BALANCE (\$8,730.00) FORWARD TO BE USED AT A LATER DATE. ORIGINAL PROMOTIONAL PACKAGE OF \$12,000.00 AS PER SCHEDULE PE DATED 07/06/2020.			
28Jul20 Note:			
EXTRAS AS PER OFFER			
The Vendor agrees that notwithstanding any other term or provision in this Agreement included in the Purchase Price and in addition to those items detailed in Schedule GP to the Agreement of Purchase and Sale, the Purchaser is entitled to a credit of Two			
Worksheet Note:			

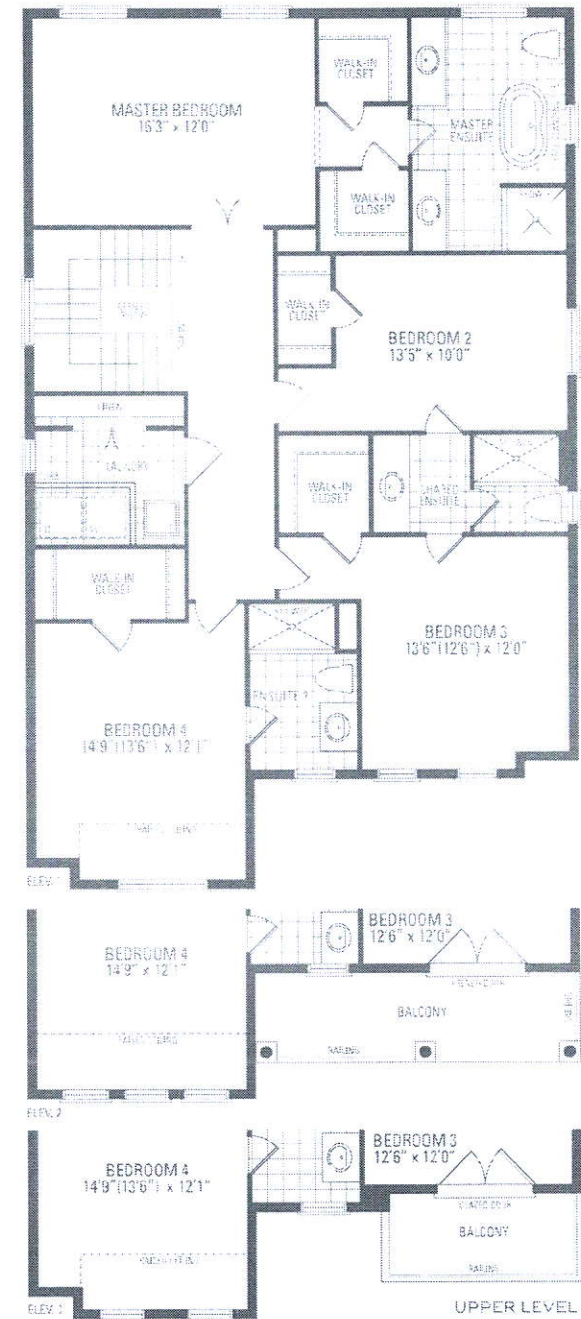

Enlarged Basement
Windows

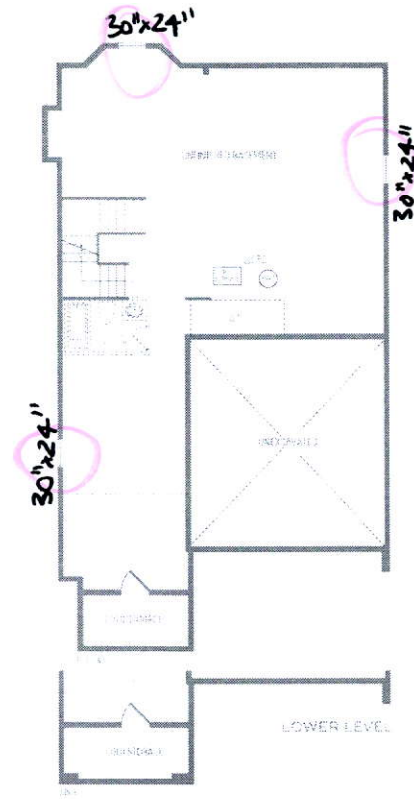

VALLEYCREEK FOUR

ELEV. 1 • 2,814 sq.ft. | ELEV. 2 • 2,805 sq.ft. | ELEV. 3 • 2,816 sq.ft.


Orientation of home may be reversed and purchaser agrees to accept the same. Steps and patches may vary at any exterior entrance ways due to grading variations. Actual usable floor space may vary from the stated floor plans. All renderings are artist's concept. Dimensions, specifications, and architectural detailing subject to modification. Readline and adjoining model types may vary due to siting. E. & D. E. May 2020

LOT 302
RUSSELL GARDENS
PHASE 3
MOUNTAINVIEW HEIGHTS

VALLEYCREEK 4
ELEV. 3

REVISION:

1. ALTERNATE KITCHEN LAYOUT,
RELOCATED SINK, RELOCATE
STOVE AS PER SKETCH

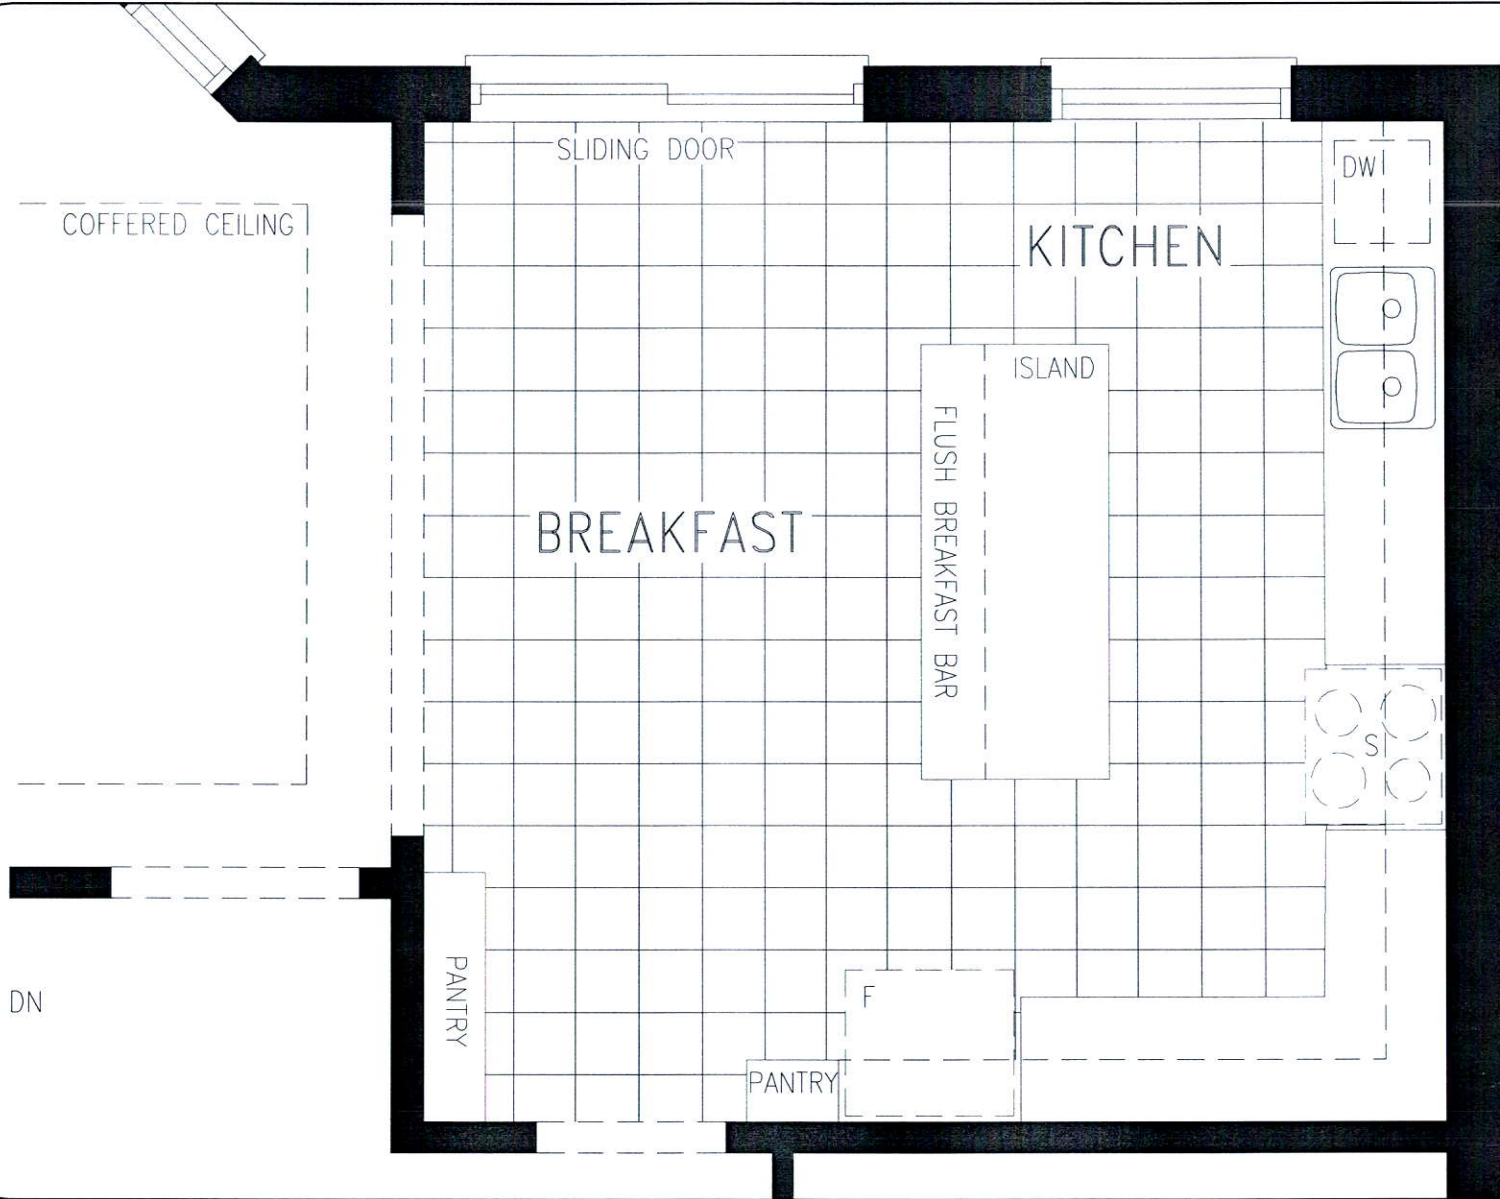


MAIN LEVEL

DISCLAIMERS: SKETCH NOT TO SCALE. DIMENSIONS, SPECIFICATIONS AND ARCHITECTURAL DETAILS SUBJECT TO MODIFICATION BY THE VENDOR. SKETCH IS ONLY FOR THE PURPOSE OF ILLUSTRATING REVISIONS REQUESTED BY THE PURCHASER AND ALL REVISIONS ARE SUBJECT TO VENDOR'S FINAL APPROVAL. ONLY REVISIONS ACCEPTED IN WRITING BY THE PURCHASER AND VENDOR ON A PURCHASER'S EXTRA SHEET WILL BE INCORPORATED INTO THE PLANS FILED WITH THE MUNICIPALITY, E. & O.E.


**REGION
DESIGN
INC.**

SCALE
N.T.S.
BY
VG
PAGE No.
1 OF 1

Greenpark

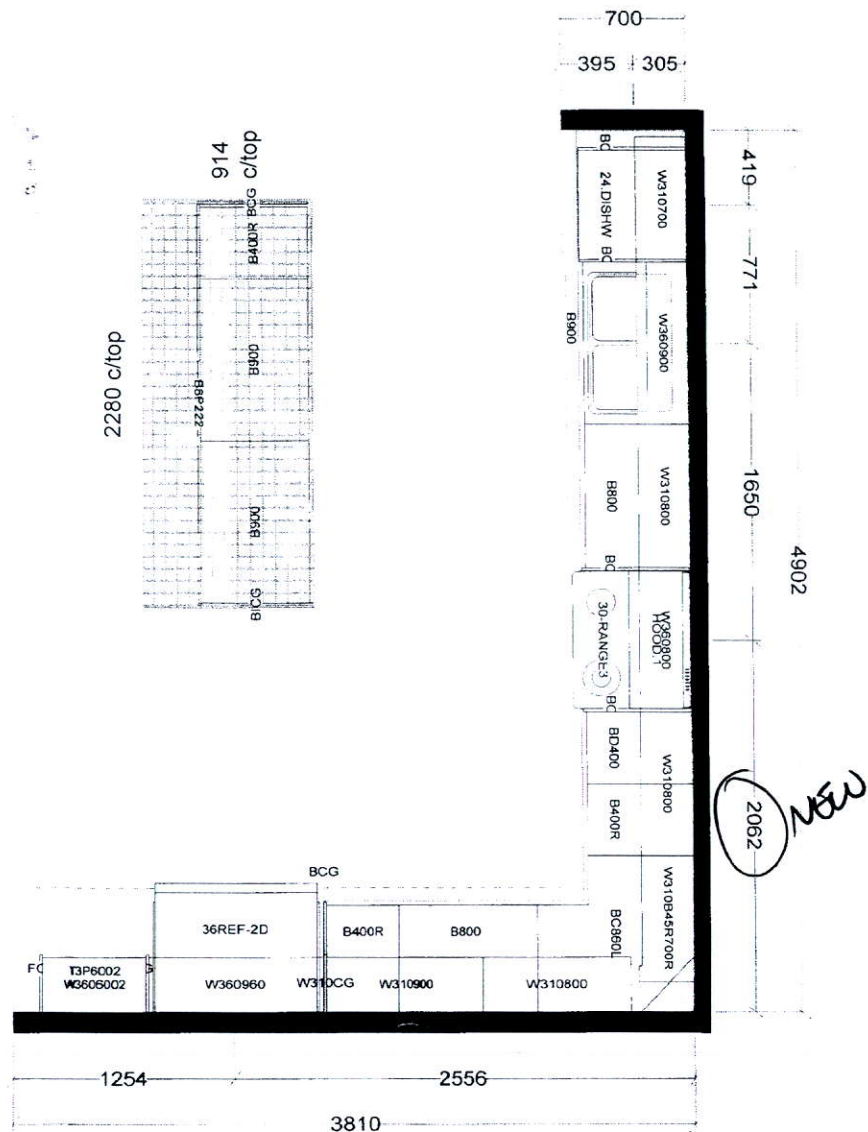

Scale : 1 : 40.0

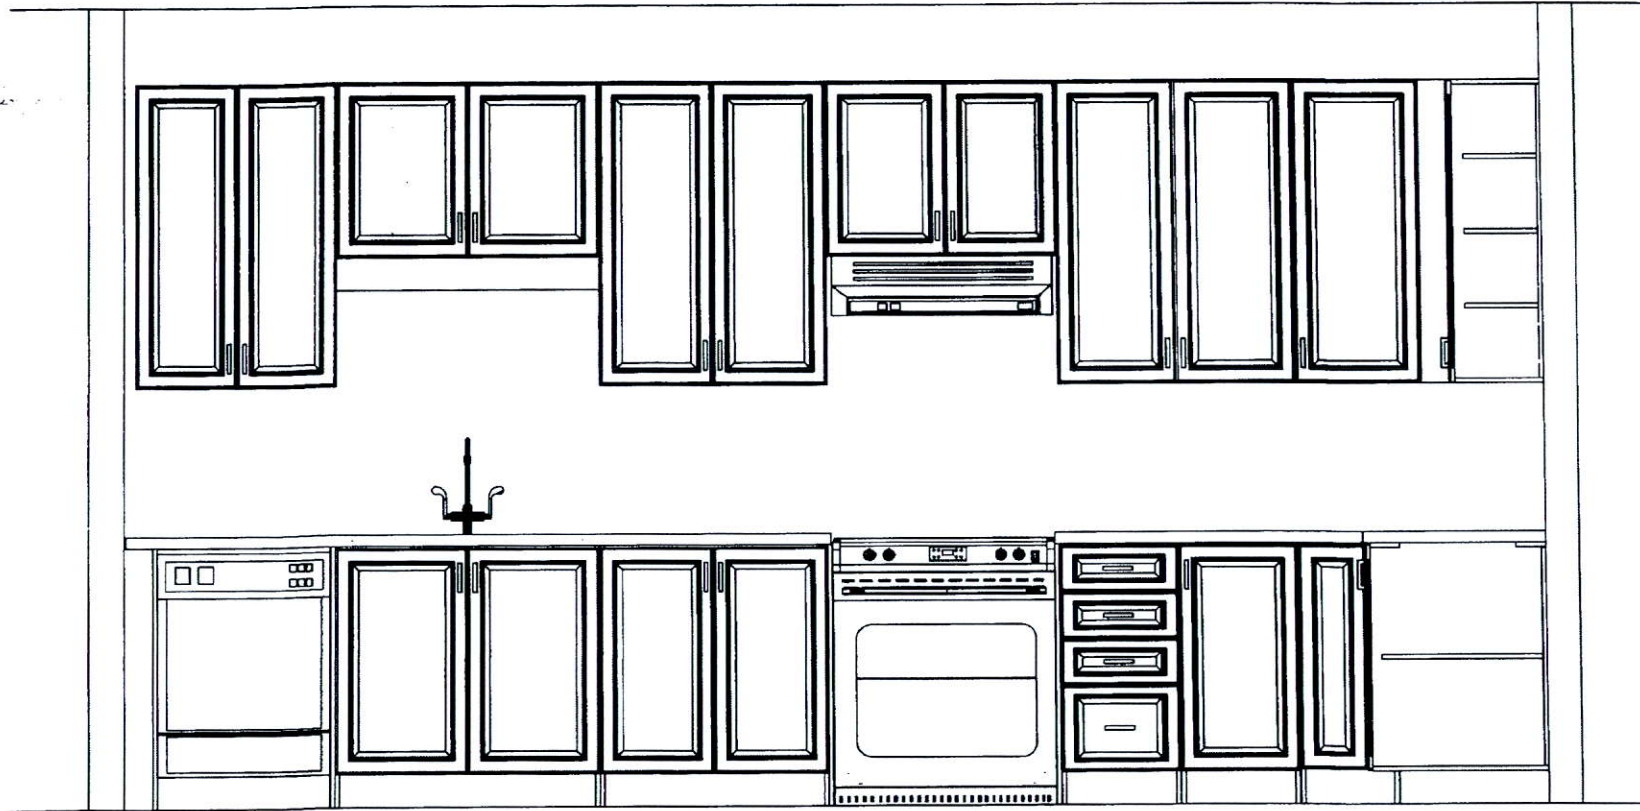

This drawing is the intellectual property of
SELBA INDUSTRIES INC. and is an
artistic
interpretation of the general
appearance of the design. It is
not meant to be an exact rendition.

Selba

Kitchen + Bath Designs

Designed: 7/18/2020
Printed: 7/21/2020

Valleycreek 4

All

Drawing 1 of 1