

CONSTRUCTION SUMMARY

RECEIVED

Mountainview Heights 3 (G) - Russell Gardens Building

DATE: SEP 04 2020

PURCHASERS: Amrinder SINGH and HASHMANJOT KAUR

TEL:

LOT / PHASE	REG. PLAN #	HOUSE TYPE	
310 / 3	62M-1266	Mountainash Six (4 Bedroom) Elev 3	

CONSTRUCTION

1 - KITCHEN - RELOCATE SINK & DISHERWASHER FROM ISLAND TO STOVE WALL AS PER SKETCH 01Sep20 Note: IF CONSTRUCTION PERMITS	NEW	
1 - MASTER ENSUITE - FRAMELESS GLASS SHOWER DOOR & FRONT WALL AT SEAT INCLUDES CHROME KNOB & HINGES 15Jul20 Note: IF CONSTRUCTION PERMITS		
4 - ENLARGE BASEMENT WINDOWS (MAY REQUIRE WINDOW WELLS) - WINDOW IS 30 INCHES X 24 INCHES 15Jul20 Note: IF CONSTRUCTION PERMITS		

ELECTRICAL

1 - 200 AMP ELECTRICAL SERVICE 15Jul20 Note:	
---	--

PLUMBING

2 - TOE TESTER - ADD TOE TESTER TO SHOWER - ALL SHOWERS 15Jul20 Note:	
--	--

PROMOTIONAL

1 - PARTIAL REDEMPTION OF PROMOTIONAL PACKAGE \$500.00 BALANCE (\$5,895.00) FORWARD TO BE USED AT A LATER DATE 01Sep20 Note:	
1 - PARTIAL REDEMPTION OF PROMOTIONAL PACKAGE \$5,605.00 BALANCE (\$6,395.00) FORWARD TO BE USED AT A LATER DATE. ORIGINAL PROMOTIONAL PACKAGE OF \$12,000 AS PER SCHEDULE PE DATED 07/04/2020. 15Jul20 Note:	

EXTRAS AS PER OFFER

The Vendor agrees that notwithstanding any other term or provision in this Agreement included in the Purchase Price and in addition to those items detailed in Schedule GP to the Agreement of Purchase and Sale, the Purchaser is entitled to a credit of Two Worksheet Note:	
---	--

This Document is Extremely Time Sensitive - Printed 1 Sep 20 at 13:45


LOT 310
RUSSELL GARDENS
 PHASE 3
 MOUNTAINVIEW HEIGHTS

MOUNTAINASH 6
ELEV. 3

REVISION:

1. ALTERNATE KITCHEN LAYOUT
 RELOCATE SINK FROM
 ISLAND TO UNDER WINDOW
 AS PER SKETCH

 RELOCATE PANTRY TO
 OTHER SIDE OF COUNTER

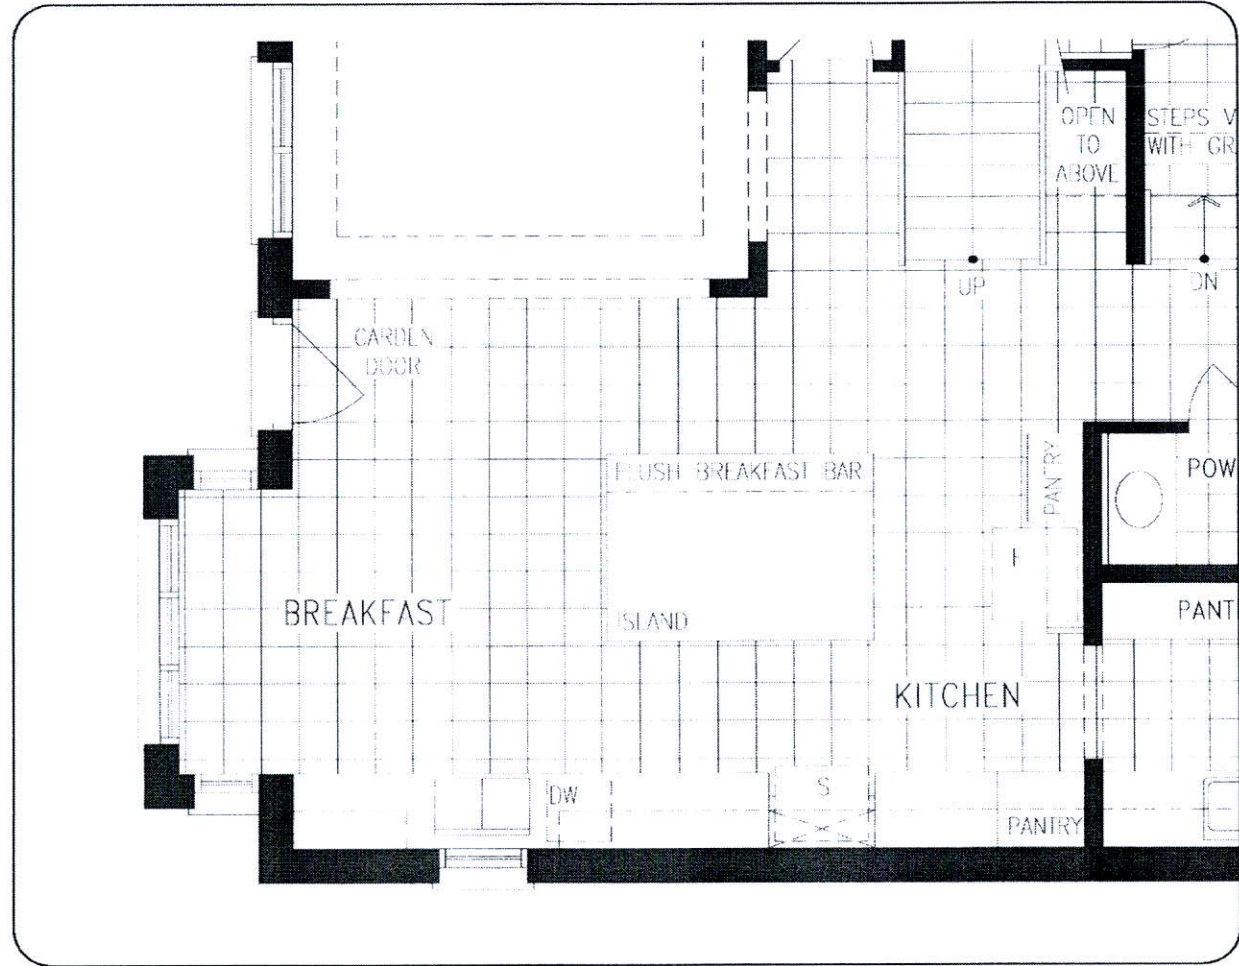

MAIN LEVEL

DISCLAIMERS: SKETCH NOT TO SCALE. DIMENSIONS, SPECIFICATIONS AND ARCHITECTURAL DETAILS SUBJECT TO MODIFICATION BY THE VENDOR. SKETCH IS ONLY FOR THE PURPOSE OF ILLUSTRATING REVISIONS REQUESTED BY THE PURCHASER AND ALL REVISIONS ARE SUBJECT TO VENDOR'S FINAL APPROVAL. ONLY REVISIONS ACCEPTED IN WRITING BY THE PURCHASER AND VENDOR ON A PURCHASER'S EXTRA SHEET WILL BE INCORPORATED INTO THE PLANS FILED WITH THE MUNICIPALITY. E. & O.E.

REGION
 DESIGN
 INC.
 BY
 VG
 SCALE
 N.T.S.
 PAGE NO.
 1 OF 1




Aminder Singh

Hashim Khan

RECEIVED

SEP 04 2020

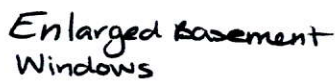[illegible]

- Frameless Glass shower Door + wall at seat

ELEV. 1 • 3,409 sq.ft. | ELEV. 2 • 3,403 sq.ft. | ELEV. 3 • 3,368 sq.ft.

Orientation of home may be reversed and purchaser agrees to accept the same. Steps and porches may vary at any exterior entrance ways due to grading variance. Actual usable floor space may vary from the stated floor areas. All renderings are artist's concept. Dimensions, specifications and architectural detailing subject to modifications. Roofline and adjoining model types may vary due to siting. E. & O. E. May 2020