
Greenpark.

	Mountainview	NSTRUCTION SUMMARY Heights 3 (G) - Russell Gardens Building	Ltd.	TEL:
PURCHASERS: ASHOK K	UMAR BAB PATEL and S	ANGITABEN A PATEL		TED.
LOT / PHASE 317 / 3	REG. PLAN# 62M-1266	HOUSE TYPE Mountainash Five (4 Bedroom) Elev 3		
ELECTRICAL				
1 - 200 AMP ELECTRICAL 11Jan21 Note:	SERVICE			
MIRRORS AND GLASS				
1 - FRAMELESS GLASS SEBATHROOM 11Jan21 Note:	HOWER DOOR & FRONT	WALL AT SEAT - INCLUDES CHROME KNOB &	ι HINGES - MASTER EN	SUTIE
PLUMBING				
2 - TOE TESTER - ADD TO	DE TESTER TO SHOWER	- MASTER ENSUITE & ENSUITE 2 BATHROOMS	8	
PROMOTIONAL			0	
1 - PARTIAL REDEMTION DATE. ORIGINAL PROMO 11Jan21 Note:	OF PROMOTIONAL PACTIONAL PACTIONAL PACKAGE OF S	CKAGE \$3665.00 BALANCE FORWARD (\$8335.00 \$12,000.00 AS PER SCHEDULE PE	O) TO BE USED AT A LA	TER
	F	EXTRAS AS PER OFFER		
(1) The Vendor agrees that addition to those items de Worksheet Note:	at notwithstanding any ot tailed in Schedule GP to	her term or provision in this Agreement included the Agreement of Purchase and Sale, the Purchas	in the Purchase Price an ser is entitled to a credit	d in of
PURCHASER(S) ACKNO PROMOTIONAL PACK. Worksheet Note:	OWLEDGES THAT TH AGES AVAILABLE AT	E PURCHASE PRICE IS INCLUSIVE OF ALL TIME OF PURCHASE.	CREDITS AND	
MAIN LEVEL 10FT CEI	LING			

This Document is Extremely Time Sensitive - Printed 11 Jan 21 at 9:45

RECEIVED JAN 19 2021

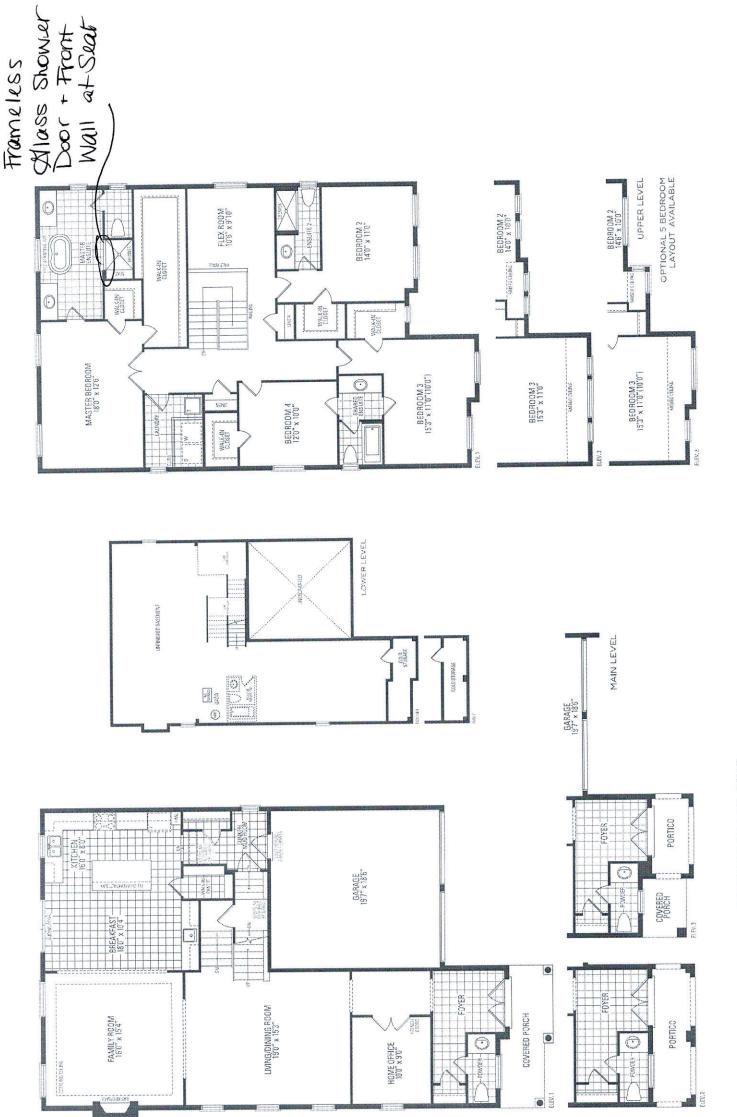

MOUNTAINASH FIVE ELEV. 1 - 3,288 sq.ft. | ELEV. 2 - 3,291 sq.ft. | ELEV. 3 - 3,291 sq.ft. | ELEV. 3 - 3,298 sq.ft.

Orionization of hume may be reversed and purchaser agrees its accept the same. Steps and purches may very at any extention entrance ways due to grading variance. Actual usable flour space may very from the stared floor areas. All renderings are artists concept. Dimensions, specifications and architectural detailing subject to modifications. Rouffine and adjaining model types may very due to siting. E.& D.E. May 2020