



RECEIVED
SEP 22 2020

CONSTRUCTION SUMMARY
Elizabeth Heights - Trinar Hall Homes Inc.

PURCHASER: NIVETHAN NITHYANANTHAN,
TEL:

LOT / PHASE 33 / 1	REG. PLAN # 65M-4671	HOUSE TYPE GLENWAY 7A ELEV 2	
-----------------------	-------------------------	---------------------------------	--

CONSTRUCTION

1 - ADD STONE TO LOWER LEVEL OF FRONT OF HOUSE-SEE SKETCH 14Sep20 Note:	
4 - ENLARGE BASEMENT WINDOWS (MAY REQUIRE WINDOW WELLS) - WINDOW IS 30 INCHES X 24 INCHES 14Sep20 Note:	

EXTRAS AS PER OFFER

The Vendor agrees that notwithstanding any other term or provision in this Agreement included in the Purchase Price and in addition to those items detailed in Schedule GP to the Agreement of Purchase and Sale, the Purchaser is entitled to a credit of Fif Worksheet Note:	
PURCHASER(S) ACKNOWLEDGES THAT THE PURCHASE PRICE IS INCLUSIVE OF ALL CREDITS AND PROMOTIONAL PACKAGES AVAILABLE AT TIME OF PURCHASE. Worksheet Note:	

This Document is Extremely Time Sensitive - Printed 15 Sep 20 at 9:10

LOT 33

TRINAR HALL HOMES INC

GLENWAY 7A

ELEV. 2

REVISION:

1. ADD STONE IN FRONT AS PER SKETCH



PARTIAL RIGHT ELEVATION

FRONT ELEVATION

PARTIAL LEFT ELEVATION

ELEVATIONS

DISCLAIMERS: SKETCH NOT TO SCALE. DIMENSIONS, SPECIFICATIONS AND ARCHITECTURAL DETAILS SUBJECT TO MODIFICATION BY THE VENDOR. SKETCH IS ONLY FOR THE PURPOSE OF ILLUSTRATING REVISIONS REQUESTED BY THE PURCHASER AND ALL REVISIONS ARE SUBJECT TO VENDOR'S FINAL APPROVAL. ONLY REVISIONS ACCEPTED IN WRITING BY THE PURCHASER AND VENDOR ON A PURCHASER'S EXTRA SHEET WILL BE INCORPORATED INTO THE PLANS FILED WITH THE MUNICIPALITY. E. & O.E.

REGION
DESIGN
INC.


SCALE

BY
VG

N.T.S.

PAGE No.
1 OF 1



 **Greenpark**

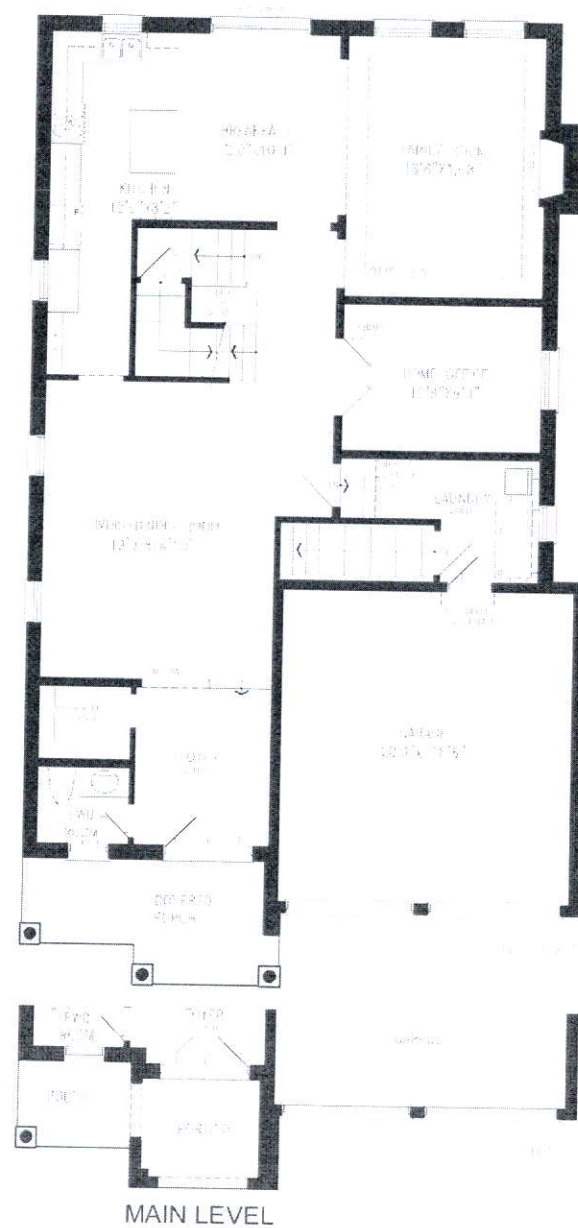

GLENWAY 7A

3,324 SQ.FT.

10 SQ.FT. OF OPEN AREA

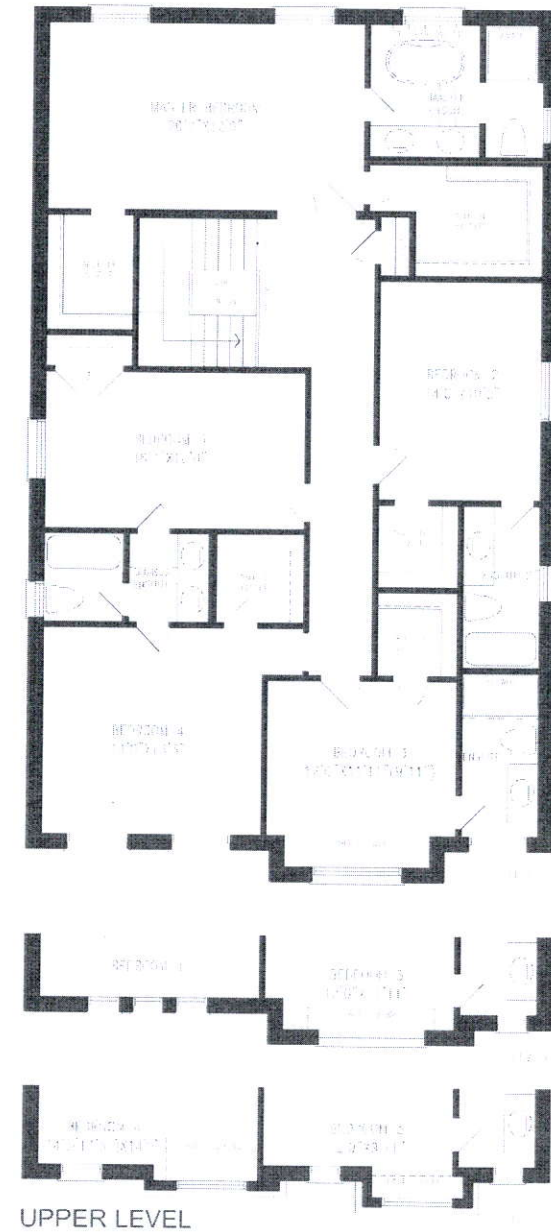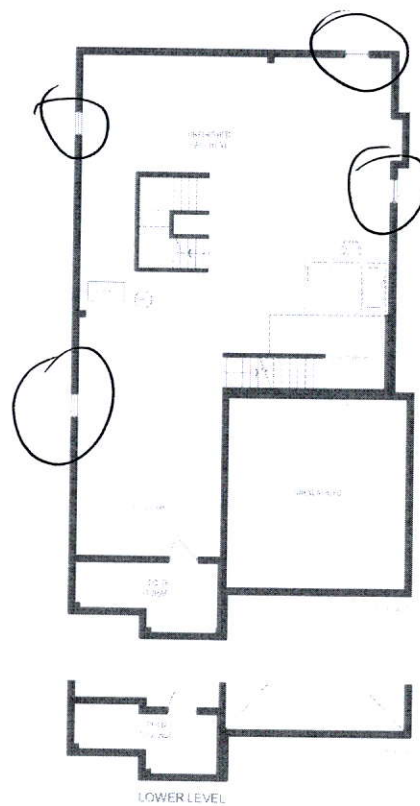

Orientation of home may be reversed and purchaser agrees to accept the same. Steps and porches may vary at any exterior entrance ways due to grading variance. Actual usable floor space may vary from the stated floor areas. All renderings are artist's concept. Dimensions, specifications and architectural detailing subject to modifications. Roofline and adjoining model types may vary due to siting. E. & O. E. February 2020.