

STRIP FOOTINGS - FOR SINGLES & SEMIS UP TO 2 STOREYS

8" OR 10" FOUNDATION WALLS WITH 2"x8" / 2"x10" FLOOR JOISTS
20"x6" CONCRETE STRIP FOOTINGS BELOW FOUNDATION WALLS.
24"x8" CONCRETE STRIP FOOTINGS BELOW PARTY WALLS.

FOUNDATION WALLS WITH ENGINEERED JOISTS OVER 16' SPANS
24"x8" CONCRETE STRIP FOOTINGS BELOW FOUNDATION WALLS.

FOOTINGS ON ENGINEERED FILL

24"x8" CONCRETE STRIP FOOTINGS WITH REINFORCING.
BELOW EXTERIOR WALLS.
30"x8" CONCRETE STRIP FOOTINGS WITH REINFORCING.
BELOW PARTY WALLS.
(REFER TO ENGINEER FILL FOOTING DETAIL)

ASSUME THE LARGER FOOTING SIZE WHEN TWO CONDITIONS APPLY

ASSUMED 120 KPa (18 p.s.i.) SOIL BEARING CAPACITY FOR SINGLES OR 90 KPa FOR ENGINEERED FILL, TO BE VERIFIED ON SITE.

PAD FOOTINGS

120 KPa NATIVE SOIL

F1 = 42"x42"x18" CONCRETE PAD F2 = 48"x48"x20" CONCRETE PAD
F2 = 36"x36"x16" CONCRETE PAD F2 = 40"x40"x16" CONCRETE PAD
F3 = 30"x30"x12" CONCRETE PAD F3 = 34"x34"x14" CONCRETE PAD
F4 = 24"x24"x12" CONCRETE PAD F4 = 28"x28"x12" CONCRETE PAD
F5 = 16"x16"x8" CONCRETE PAD F5 = 18"x18"x8" CONCRETE PAD

90 KPa ENGINEERED FILL SOIL

(REFER TO FLOOR PLAN FOR UNUSUAL SIZE PADS NOT ON CHART.)

VENEER CUT

WHEN VENEER CUT IS GREATER THAN 26", A 10" POURED CONCRETE FOUNDATION WALL IS REQUIRED.

EXPOSED CONCRETE (FLATWORK)

ALL GARAGE SLABS, PORCH SLABS, STAIRS (EXPOSED CONC. FLAT WORK) TO BE 32 MPa. WITH 5-8% AIR ENTRAINMENT.

BRICK VENEER LINTELS (WL)

WL1 = 3-1/2" x 3-1/2" x 1/4" L (90x90x6.0L) + 2-2"x8" SPR. No.2
WL2 = 4" x 3-1/2" x 5/16" L (100x90x8.0L) + 2-2"x8" SPR. No.2
WL3 = 5" x 3-1/2" x 5/16" L (125x90x8.0L) + 2-2"x10" SPR. No.2
WL4 = 6" x 3-1/2" x 3/8" L (150x90x10.0L) + 2-2"x12" SPR. No.2
WL5 = 6" x 4" x 3/8" L (150x100x10.0L) + 2-2"x12" SPR. No.2
WL6 = 5" x 3-1/2" x 5/16" L (125x90x8.0L) + 2-2"x12" SPR. No.2
WL7 = 5" x 3-1/2" x 5/16" L (125x90x8.0L) + 3-2"x12" SPR. No.2
WL8 = 5" x 3-1/2" x 5/16" L (125x90x8.0L) + 3-2"x10" SPR. No.2
WL9 = 6" x 4" x 3/8" L (150x100x10.0L) + 3-2"x10" SPR. No.2

WOOD LINTELS AND BEAMS (WB)

WB1 = 2-2"x8" (2-38x184) SPR. No.2
WB2 = 3-2"x8" (3-38x184) SPR. No.2
WB3 = 2-2"x10" (2-38x235) SPR. No.2
WB4 = 3-2"x10" (3-38x235) SPR. No.2
WB5 = 2-2"x12" (2-38x286) SPR. No.2
WB6 = 3-2"x12" (3-38x286) SPR. No.2
WB7 = 5-2"x12" (5-38x286) SPR. No.2
WB11 = 4-2"x10" (4-38x235) SPR. No.2
WB12 = 4-2"x12" (4-38x286) SPR. No.2

LAMINATED VENEER LUMBER (LVL) BEAMS

LVL1A = 1-1 3/4"x7 1/4" (1-45x184)
LVL1 = 2-1 3/4"x7 1/4" (2-45x184)
LVL2 = 3-1 3/4"x7 1/4" (3-45x184)
LVL3 = 4-1 3/4"x7 1/4" (4-45x184)
LVL4A = 1-1 3/4"x9 1/2" (1-45x240)
LVL4 = 2-1 3/4"x9 1/2" (2-45x240)
LVL5 = 3-1 3/4"x9 1/2" (3-45x240)
LVL5A = 4-1 3/4"x9 1/2" (4-45x240)
LVL6A = 1-1 3/4"x11 7/8" (1-45x300)
LVL6 = 2-1 3/4"x11 7/8" (2-45x300)
LVL7 = 3-1 3/4"x11 7/8" (3-45x300)
LVL8 = 2-1 3/4"x14" (2-45x356)
LVL9 = 3-1 3/4"x14" (3-45x356)

LOOSE STEEL LINTELS (L)

L1 = 3-1/2" x 3-1/2" x 1/4" L (90x90x6.0L)
L2 = 4" x 3-1/2" x 5/16" L (100x90x8.0L)
L3 = 5" x 3-1/2" x 5/16" L (125x90x8.0L)
L4 = 6" x 3-1/2" x 3/8" L (150x90x10.0L)
L5 = 6" x 4" x 3/8" L (150x100x10.0L)
L6 = 7" x 4" x 3/8" L (180x100x10.0L)

DOOR SCHEDULE

NOS.	WIDTH	HEIGHT 8'-9" CEILING	HEIGHT 10' OR MORE CEILING	TYPE
1	2'-10"	6'-8"	8'-0"	INSULATED ENTRANCE DOOR
1a	2'-8"	6'-8"	8'-0"	INSULATED FRONT DOORS
2	2'-8"	6'-8"	8'-0"	WOOD & GLASS DOOR
3	2'-8"	6'-8"	8'-0"	EXTERIOR SLAB DOOR
4	2'-8"	6'-8"	8'-0"	INTERIOR SLAB DOOR
5	2'-6"	6'-8"	8'-0"	INTERIOR SLAB DOOR
6	2'-2"	6'-8"	8'-0"	INTERIOR SLAB DOOR
7	1'-6"	6'-8"	8'-0"	INTERIOR SLAB DOOR

CERAMIC TILE FOR CONVENTIONAL LUMBER (OBC 9.30.6)

SPACE ALL CONVENTIONAL FLOOR JOISTS @ 12" O.C. BELOW ALL CERAMIC TILE AREAS.
PROVIDE 1 ROW BRIDGING FOR SPANS OF 5'0"-7'0", 2 ROWS FOR SPANS GREATER THAN 7'0".

NOTE: ROOF FRAMING

REFER TO ROOF TRUSS SHOP DRAWINGS FOR ALL ROOF FRAMING INFORMATION UNLESS OTHERWISE NOTED.


PLANS NOT DRAWN TO ACTUAL GRADE. REFER TO FINAL APPROVED GRADING PLAN.

NOTE: ENGINEERED FLOOR FRAMING

REFER TO ENGINEERED FLOOR LAYOUTS FOR ALL ENGINEERED FLOOR FRAMING INFORMATION AND DETAILS. UNLESS OTHERWISE NOTED.

TWO STOREY HEIGHT WALL DETAIL


2-2"x6" STUD WALL NAILED TOGETHER AND SPACED @ 12" O.C. FULL HEIGHT, 6" W SOLID BLOCKING @ 4'-0" O.C. VERTICAL AND 7/16" EXT. OSB SHEATHING.

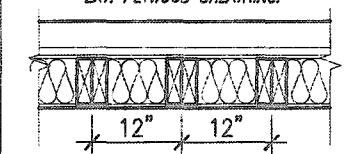

NOTE: MAXIMUM HEIGHT OF WALL FOR THIS DETAIL IS 18'-0" AND MAX. SUPPORTED LENGTH OF TRUSS IS 40'-0".

TWO STOREY HEIGHT WALL DETAIL


2-1 1/2" x 5 1/2" TIMBERSTRAND (LSL) 1.5E STUD WALL GLUED & NAILED TOGETHER AND SPACED MAX. @ 9" O.C. FULL HEIGHT, 6" W SOLID BLOCKING @ 8'-0" O.C. VERTICAL AND 7/16" EXT. OSB SHEATHING.

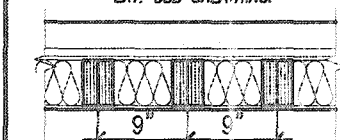

NOTE: MAXIMUM HEIGHT OF WALL FOR THIS DETAIL IS 21'-5" AND MAX. SUPPORTED LENGTH OF TRUSS IS 40'-0".

TWO STOREY HEIGHT WALL DETAIL

2-1 1/2" x 5 1/2" TIMBERSTRAND (LSL) 1.5E STUD WALL GLUED & NAILED TOGETHER AND SPACED MAX. @ 10" O.C. FULL HEIGHT, 6" W SOLID BLOCKING @ 8'-0" O.C. VERTICAL AND 7/16" EXT. OSB SHEATHING.

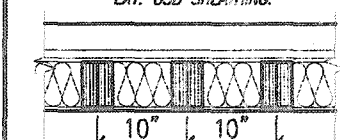

NOTE: MAXIMUM HEIGHT OF WALL FOR THIS DETAIL IS 20'-2" AND MAX. SUPPORTED LENGTH OF TRUSS IS 40'-0".

THE MINIMAL THERMAL PERFORMANCE OF BUILDING ENVELOPE AND EQUIPMENT SHALL CONFORM TO THE FOLLOWING SB-12 COMPLIANCE PACKAGE AS PER OBC SUPPLEMENTARY STANDARD SB-12, SECTION 3.1.1.1.



USE SB-12 COMPLIANCE PACKAGE 'A1':

COMPONENT	A1	Notes:
Ceiling with Attic Space	10.56 (R60)	R20 at inner face of exterior walls
Minimum RSI (R) value		
Ceiling without Attic Space	5.46 (R31)	BATT or SPRAY
Minimum RSI (R) value		
Exposed Floor	5.46 (R31)	BATT or SPRAY
Minimum RSI (R) value		
Walls Above Grade	3.87 (R22)	6" R22 BATT
Minimum RSI (R) value		
Basement Walls	3.52ci (R20ci)	OPTION TO USE R12+R10ci.
Minimum RSI (R) value		
Edge of Below Grade Slab ≤600mm below grade	1.76 (R10)	RIGID INSUL
Minimum RSI (R) value		
Windows & Sliding glass Doors	0.28	
Maximum U-value		
Skylights	0.49	
Maximum U-value		
Space Heating Equipment	96% Min.	NATURAL GAS
Minimum AFUE		
Hot Water Heater	0.8	NATURAL GAS
Minimum EF		
HRV	75%	
Minimum Efficiency		
Drain Water Heat Recovery Unit (DWHR)	Minimum 1 OR Maximum 2 Required. Dependent on number of showers installed. Refer to SB12-3.1.1.12 for information.	

ci- Denotes Continuous Insulation without framing interruption.

UNINSULATED OPENINGS (PER OBC. SB-12.3.1.1(7))

ELEVATION	WALL AREA S.F.	OPENING S.F.	PERCENTAGE
FRONT	809.32 S.F.	147.45 S.F.	18.22 %
LEFT SIDE	1227.56 S.F.	96.17 S.F.	7.83 %
RIGHT SIDE	1170.21 S.F.	28.33 S.F.	2.42 %
REAR	814.55 S.F.	171.99 S.F.	21.11 %
* OPENINGS OMITTED AS PER SB-12 3.1.1.9(4) MAX 19.9 S.F. REFER TO ELEVATION FOR LOCATION			
		0.00 S.F.	
TOTAL SQ. FT.	4021.64 S.F.	443.94 S.F.	11.04 %
TOTAL SQ. M.	373.62 S.M.	41.24 S.M.	11.04 %

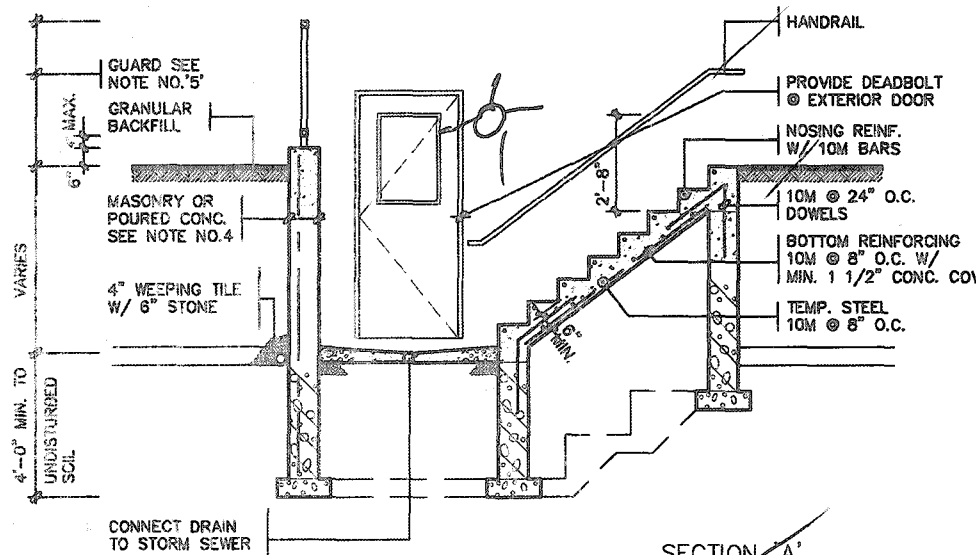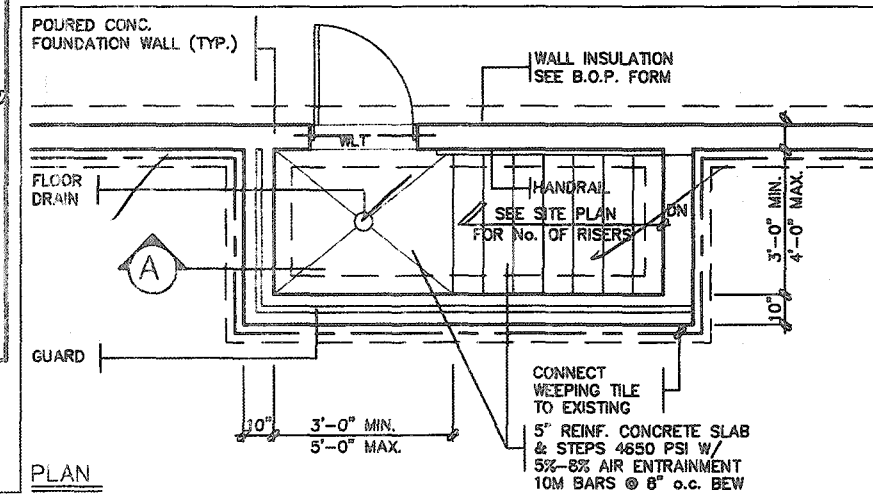

GENERAL NOTES

- FOOTINGS**
16"x8" POURED CONCRETE FOOTING. ALL FOOTINGS SHALL REST ON NATURAL UNDISTURBED SOIL OR COMPACTED ENGINEERED FILL.
- CONCRETE**
MINIMUM COMPRESSIVE STRENGTH OF (28 DAYS) 4650 PSI @ 28 DAYS W/ 5% TO 8% AIR ENTRAINMENT
- EXTERIOR STAIRS**
7 7/8" RISE MAXIMUM 4 7/8" MINIMUM 8 1/4" RUN MINIMUM 14" MAXIMUM 9 1/4" TREAD MINIMUM 14" MAXIMUM
- RETAINING WALL**
10" POURED CONCRETE W/ NO REINFORCING REQUIRED FOR WALL HEIGHTS TO A MAX. OF 4'-7" PROVIDE 15M VERTICAL REINFORCEMENT @ 16" O.C. & 15M HORIZONTAL REINFORCEMENT @ 24" O.C. FOR WALL HEIGHTS TO 7'-0". RETAINING WALL TO RESIST LATERAL DESIGN LOADS AS PER OBC DIVISION B SECTION 4.1.5.16.
- GUARDS**
3'-6" HIGH WHERE DISTANCE FROM GRADE TO BOTTOM OF WALKOUT EXCEEDS 5'-11"; 2'-11" FOR LESSER HEIGHTS. MAXIMUM 4" BETWEEN VERTICAL PICKETS

BASEMENT WALK-UP PLAN, SECTION & NOTES

SCALE: N.T.S.

3409 SF.

AREA CALCULATIONS	FLEV '1'
GROUND FLOOR AREA	1486 SF
SECOND FLOOR AREA	1915 SF
TOTAL FLOOR AREA	3401 SF (315.96 m2)
FIRST FLOOR OPEN AREA	0 SF
SECOND FLOOR OPEN AREA	8 SF
ADD TOTAL OPEN AREAS	+8 SF
ADD FINISHED BSMT AREA	+0 SF
GROSS FLOOR AREA	3409 SF (316.71 m2)
GROUND FLOOR COVERAGE	1493 SF
GARAGE COVERAGE/AREA	393 SF
PORCH COVERAGE/AREA	85 SF
COVERAGE W/ PORCH	1971 SF (183.11 m2)
COVERAGE W/O PORCH	1886 SF (175.22 m2)



STRUDEY INC. FOR STRUCTURE ONLY

It is the builder's complete responsibility to ensure that all plans submitted for approval fully comply with the Architectural Guidelines and all applicable regulations and requirements including zoning provisions and any provisions in the subdivision agreement. The Control Architect is not responsible in any way for examining or approving site (lotting) plans or working drawings with respect to any zoning or building code or permit matter or that any house can be properly built or located on its lot.

This is to certify that these plans comply with the applicable Architectural Design Guidelines approved by the City of HAMILTON

CITY OF HAMILTON Building Division

Permit No. 21-105996

THESE STAMPED DRAWINGS SHALL BE AVAILABLE ON SITE

THE OWNER AND/OR CONTRACTOR SHALL COMPLY WITH THE ONTARIO BUILDING CODE AND ALL OTHER APPLICABLE LAW

These drawings and/or specifications have been reviewed by

FEB 22 2021

DATE

MOUNTAINASH 6-214 COMPLIANCE PACKAGE 'A1'



255 Consumers Rd Suite 120
Toronto ON M2J 1R4
416.630.2255 / 416.630.4782
va3design.com



project name
RUSSELL GARDENS PH. 3 HAMILTON, ONTARIO

MOUNTAINASH 6
13.5m

drawn by
JAN 2020

checked by
3/16" = 1'-0"

scale

19014-MOUNTAINASH-6-214

project no.
19014

drawing no.
A0

All drawings, specifications, related documents and design are the copyright property of VA3 DESIGN. Reproduction of this property in whole or in part is strictly prohibited without VA3 DESIGN's written permission.

Note:


- Gas fire place must be CSA/DLC/CCMC approved and installed in accordance as per local Utilization code.
- All plumbing is subject to field construction by City of Hamilton.

- Garage to be tight-fit and gas proof and weatherstripping door.

3409 SF.



STRUDET INC.
FOR STRUCTURE ONLY

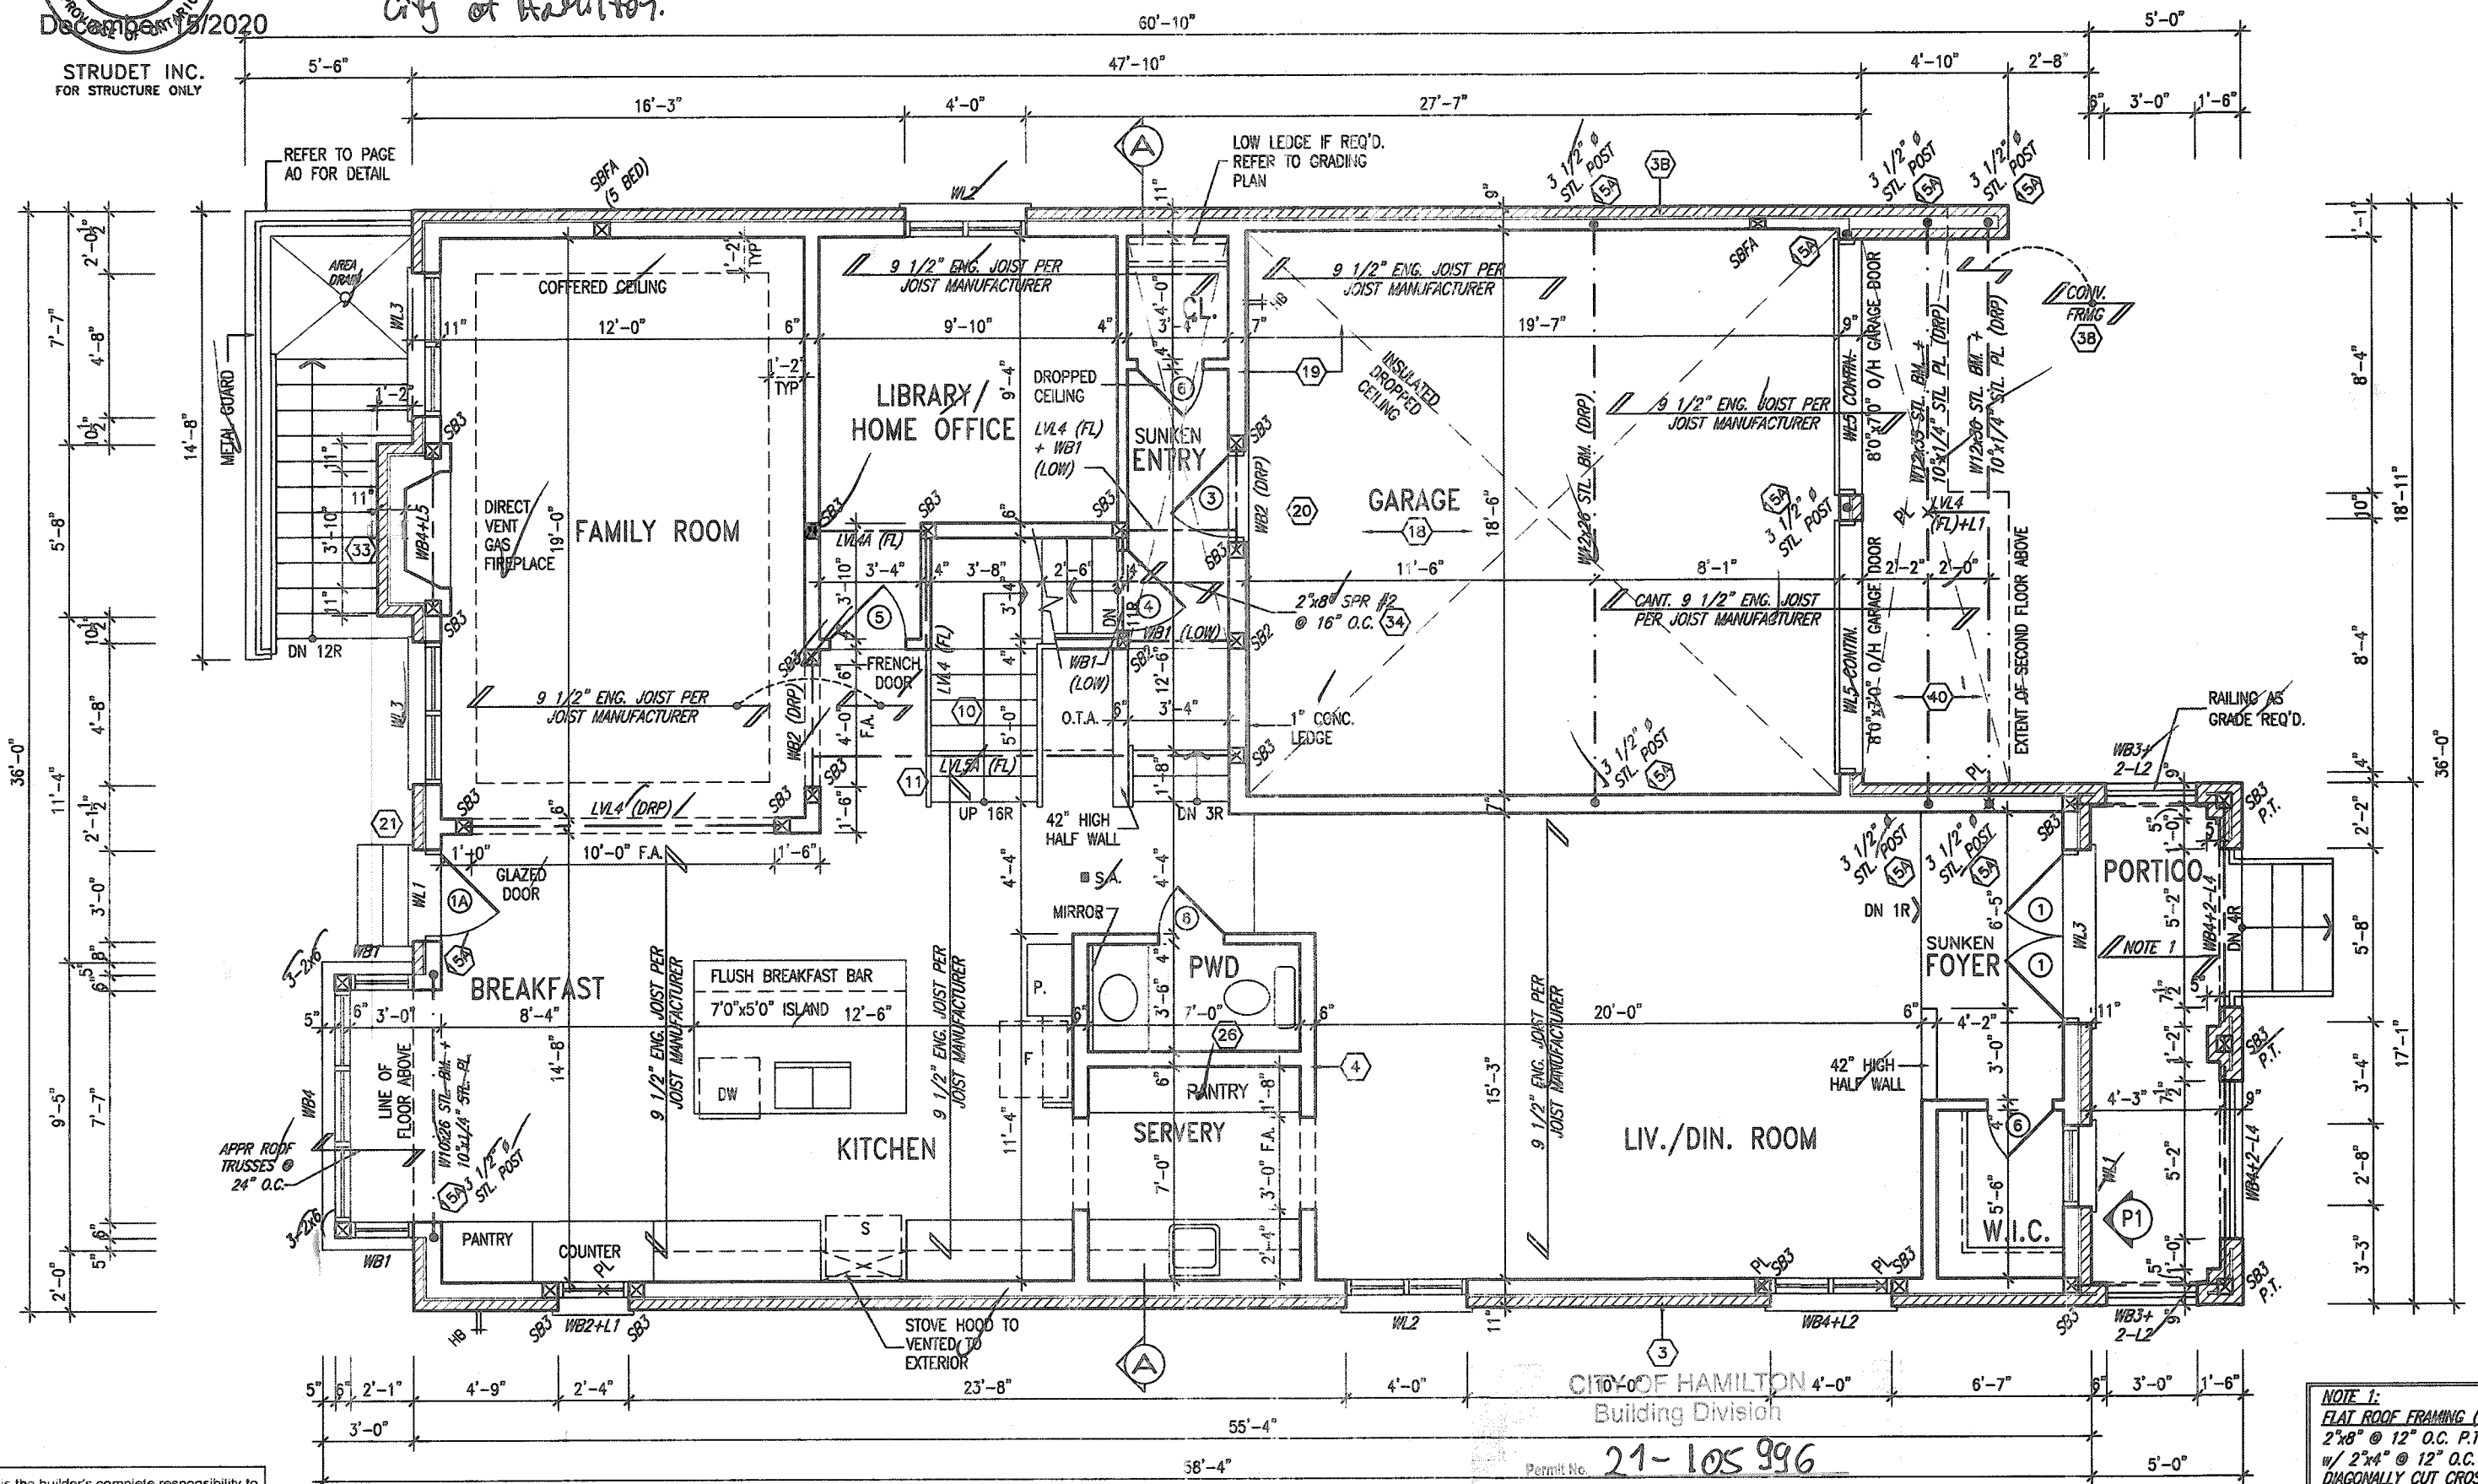

GROUND FLOOR PLAN - ELEV. '1'

It is the builder's complete responsibility to ensure that all plans submitted for approval fully comply with the Architectural Guidelines and all applicable regulations and requirements including zoning provisions and any provisions in the subdivision agreement. The Control Architect is not responsible in any way for examining or approving site (lotting) plans or working drawings with respect to any zoning or building code or permit matter or that any house can be properly built or located on its lot.

This is to certify that these plans comply with the applicable Architectural Design Guidelines approved by the City of Hamilton

JOHN C. WILLIAMS LTD., ARCHITECT
ARCHITECTURAL CONTROL REVIEW
AND APPROVAL

APPROVED BY: [Signature]
DATE: JAN 18, 2021

This stamp certifies compliance with the applicable Design Guidelines only and does not further professional responsibility.

OUTDOOR AIR INTAKE SEPARATION
ALL OUTDOOR AIR INTAKE VENTS TO BE SEPARATED A MINIMUM DISTANCE FROM SOURCES OF CONTAMINATION PER OBC, DIV. B - TABLE 6.2.3.12.
• KITCHEN EXHAUST 3.0m
• DRIVEWAY, PARKING SPACE, ROAD 1.5m
• SOLID FUEL APPLIANCE EXHAUST 3.0m
KIT-EX-1013-2020.dwg

THESE STAMPED DRAWINGS SHALL BE AVAILABLE ON SITE
THE OWNER AND/OR CONTRACTOR SHALL COMPLY WITH THE ONTARIO BUILDING CODE AND ALL OTHER APPLICABLE LAW

These drawings and/or specifications have been reviewed by
FEB 22 2021
CHIEF BUILDING OFFICIAL DATE

MOUNTAINASH 6-214
COMPLIANCE PACKAGE 'A1'

18		9			
17		8			
16		7			
15		6	REVISED REAR BOX BAY PER CLIENT.	DEC. 14/20	WT
14		5	CUSTOM PER PURCHASER REQUEST.	SEP 11/20	GW
13		4	STAIRWAY WIDTH CORRECTED.	AUG. 05/20	GW
12		3	ISSUED FOR PERMIT.	APR 13/20	GW
11		2	UPDATED PER ENG & CLIENT COMMENTS	MAR 24/20	GW
10		1	PRELIMINARY, ISSUED FOR CLIENT REVIEW.	JAN. 28/20	GW
no.	description	date	by	no.	description

The undersigned has reviewed and takes responsibility for this design and has the qualifications and meets the requirements set out in the Ontario Building Code to be a Designer.
qualification information
Richard Vink 2448B
signature
VA3 Design Inc. 4285B
The Designer must verify all dimensions on the job and report any discrepancy to the Designer before proceeding with the work. All drawings and specifications are instruments of service and the property of the Designer which must be returned at the completion of the work. Drawings are not to be copied.

VA3 DESIGN
255 Consumers Rd Suite 120
Toronto ON M2J 1R4
t 416.630.2255 f 416.630.4782
va3design.com

Greenpark.		MOUNTAINASH 6 13.5m	
project name RUSSELL GARDENS PH. 3		municipality HAMILTON, ONTARIO	
date JAN 2020		project no. 19014	
drawn by BD.BIM		drawing no. A2	
checked by 3/16" = 1'-0"		BASEMENT PLAN - ELEV. 1 19014-MOUNTAINASH-6-214	
DATE: 14/01/2021 14:00:00			

All drawings, specifications, related documents and design are the copyright property of VA3 DESIGN. Reproduction of this property in whole or in part is strictly prohibited without VA3 DESIGN's written permission.

GRAB BAR NOTE:
STUD WALL REINFORCEMENT FOR FUTURE
GRAB BARS IN MAIN BATHROOM
REINFORCEMENT OF STUD WALLS SHALL BE INSTALLED
ADJACENT TO WATER CLOSETS AND SHOWER OR
BATHTUB IN MAIN BATHROOM PER CBC, DIV. B-9.5.2.3.
REFER TO FOLLOWING SECTIONS FOR THE FIXTURES
LISTED. WATER CLOSET: 3.8.3.8.(3)(c) & 3.8.3.8.(3)(c).
SHOWER 3.8.3.13.(2)(g). BATHTUB 3.8.3.13.(4)(g).
FREE STANDING BATHTUB EXCLUDED. SEE DETAILS
PROVIDED. GP-NOTE-2020.doc



It is the builder's complete responsibility to ensure that all plans submitted for approval fully comply with the Architectural Guidelines and all applicable regulations and requirements including zoning provisions and any provisions in the subdivision agreement. The Control Architect is not responsible in any way for examining or approving site (lotting) plans or working drawings with respect to any zoning or building code or permit matter or that any house can be properly built or located on its lot.

This is to certify that these plans comply with the applicable Architectural Design Guidelines approved by the City of HAMILTON

JOHN C. WILLIAMS LTD., ARCHITECT
ARCHITECTURAL CONTROL REVIEW
AND APPROVAL

APPROVED BY: [Signature]
DATE: JAN 28, 2021
This stamp certifies compliance with the applicable
Design Guidelines only and bears no further
professional responsibility.

These drawings and/or specifications have been reviewed by

 FEB 22 2022
 FOR CHIEF BUILDING OFFICIAL DATE

MOUNTAINASH 6-214
COMPLIANCE PACKAGE 'A1'

Greenpark.

MOUNTAINASH 6
13.5m

HAMILTON, ONTARIO

project no.
19014

SECOND FLOOR PLAN (5 BDRM) - ELEV. '1'

drawing no.

file name

A3

18			9	.		The undersigned has reviewed and taken responsibility for this design and has the qualifications and meets the requirements set out in the Ontario Building Code to be a Designer.		
17			8	.				
16			7	.		qualification information		
15			6	REVISED REAR BOX BAY PER CLIENT.	DEC. 14/20	WT	Richard Vink	244C
14			5	CUSTOM PER PURCHASER REQUEST.	SEP 11/20	GN	signature	BC
13			4	STAIRWAY WIDTH CORRECTED.	AUG. 05/20	GW	registration information V&S Design Inc.	4265
12			3	ISSUED FOR PERMIT.	APR 13/20	GW		
11			2	UPDATED PER ENG & CLIENT COMMENTS	MAR 24/20	GW		
10			1	PRELIMINARY ISSUED FOR CLIENT REVIEW.	JAN. 28/20	GW		
no	description	date	by	no	description	date	by	

**VA3
DESIGN**
255 Consumers Rd Suite 120
Toronto ON M2J 1R4
t 416.630.2255 f 416.630.478
va3design.com

 Greenpark.		MOUNTAIN 13.5
project name RUSSELL GARDENS PH. 3	municipality HAMILTON, ONTARIO	
date JAN 2020	SECOND FLOOR PLAN (5 BDRM) - ELEV. '1	
drawn by BOJIM	checked by -	scale 3/16" = 1'-0"
		file name 19014-MOUNTAINASH-6-214

All drawings specifications, related documents and design are the copyright property of VA3 DESIGN. Reproduction of this property in whole or in part is strictly prohibited without VA3 DESIGN's written permission.

Diagram illustrating the vertical section of a building structure, showing levels and dimensions:

- TOP OF PLATE
- TOP OF WINDOW: 7'-8"
- FIN. SECOND FLOOR: 9'-11"
- FIN. GROUND FLOOR: 5'-0"
- SUNKEN FOYER (-1R): 5'-0"
- FIN. GRADE: 4'-0" MIN.
- U/S GARAGE FOOTING: 8'-4"
- TOP OF SLAB: 8'-4"

All drawings specifications, related documents and design are the copyright property of VA3 DESIGN. Reproduction of this property in whole or in part is strictly prohibited without VA3 DESIGN's written permission.

