

3189 SF.

STRIP FOOTINGS - FOR SINGLES & SEMIS UP TO 2 STOREYS

8" OR 10" FOUNDATION WALLS WITH 2"x8" / 2"x10" FLOOR JOISTS
 20"x6" CONCRETE STRIP FOOTINGS BELOW FOUNDATION WALLS.
 24"x8" CONCRETE STRIP FOOTINGS BELOW PARTY WALLS.
 FOUNDATION WALLS WITH ENGINEERED JOISTS OVER 16' SPANS
 24"x8" CONCRETE STRIP FOOTINGS BELOW FOUNDATION WALLS.

FOOTINGS ON ENGINEERED FILL

24"x8" CONCRETE STRIP FOOTINGS WITH REINFORCING.
 BELOW EXTERIOR WALLS.
 30"x8" CONCRETE STRIP FOOTINGS WITH REINFORCING.
 BELOW PARTY WALLS.
 (REFER TO ENGINEER FILL FOOTING DETAIL)

ASSUME THE LARGER FOOTING SIZE WHEN TWO CONDITIONS APPLY

ASSUMED 120 KPa (18 p.s.i.) SOIL BEARING CAPACITY FOR SINGLES OR 90 KPa FOR ENGINEERED FILL, TO BE VERIFIED ON SITE.

PAD FOOTINGS

120 KPa, NATIVE SOIL 90 KPa, ENGINEERED FILL SOIL
 F1 = 42"x42"x18" CONCRETE PAD F1 = 48"x48"x20" CONCRETE PAD
 F2 = 36"x36"x16" CONCRETE PAD F2 = 40"x40"x16" CONCRETE PAD
 F3 = 30"x30"x12" CONCRETE PAD F3 = 34"x34"x14" CONCRETE PAD
 F4 = 24"x24"x12" CONCRETE PAD F4 = 28"x28"x12" CONCRETE PAD
 F5 = 16"x16"x8" CONCRETE PAD F5 = 18"x18"x8" CONCRETE PAD
 (REFER TO FLOOR PLAN FOR UNUSUAL SIZE PADS NOT ON CHART.)

VENEER CUT

WHEN VENEER CUT IS GREATER THAN 26", A 10" POURED CONCRETE FOUNDATION WALL IS REQUIRED.

EXPOSED CONCRETE (FLATWORK)

ALL GARAGE SLABS, PORCH SLABS, STAIRS (EXPOSED CONC. FLAT WORK) TO BE 32 MPa. WITH 5-8% AIR ENTRAINMENT.

BRICK VENEER LINTELS (WL)

WL1 = 3-1/2" x 3-1/2" x 1/4" L (90x90x6.0L) + 2-2"x8" SPR. No.2
 WL2 = 4" x 3-1/2" x 5/16" L (100x90x8.0L) + 2-2"x8" SPR. No.2
 WL3 = 5" x 3-1/2" x 5/16" L (125x90x8.0L) + 2-2"x10" SPR. No.2
 WL4 = 6" x 3-1/2" x 3/8" L (150x90x10.0L) + 2-2"x12" SPR. No.2
 WL5 = 6" x 4" x 3/8" L (150x100x10.0L) + 2-2"x12" SPR. No.2
 WL6 = 5" x 3-1/2" x 5/16" L (125x90x8.0L) + 2-2"x12" SPR. No.2
 WL7 = 5" x 3-1/2" x 5/16" L (125x90x8.0L) + 3-2"x12" SPR. No.2
 WL8 = 5" x 3-1/2" x 5/16" L (125x90x8.0L) + 3-2"x10" SPR. No.2
 WL9 = 6" x 4" x 3/8" L (150x100x10.0L) + 3-2"x10" SPR. No.2

WOOD LINTELS AND BEAMS (WB)

WB1 = 2-2"x8" (2-38x184) SPR. No.2
 WB2 = 3-2"x8" (3-38x184) SPR. No.2
 WB3 = 2-2"x10" (2-38x235) SPR. No.2
 WB4 = 3-2"x10" (3-38x235) SPR. No.2
 WB5 = 2-2"x12" (2-38x286) SPR. No.2
 WB6 = 3-2"x12" (3-38x286) SPR. No.2
 WB7 = 5-2"x12" (5-38x286) SPR. No.2
 WB11 = 4-2"x10" (4-38x235) SPR. No.2
 WB12 = 4-2"x12" (4-38x286) SPR. No.2

LAMINATED VENEER LUMBER (LVL) BEAMS

LVL1A = 1-1 3/4"x7 1/4" (1-45x184)
 LVL1 = 2-1 3/4"x7 1/4" (2-45x184)
 LVL2 = 3-1 3/4"x7 1/4" (3-45x184)
 LVL3 = 4-1 3/4"x7 1/4" (4-45x184)
 LVL4A = 1-1 3/4"x9 1/2" (1-45x240)
 LVL4 = 2-1 3/4"x9 1/2" (2-45x240)
 LVL5 = 3-1 3/4"x9 1/2" (3-45x240)
 LVL5A = 4-1 3/4"x9 1/2" (4-45x240)
 LVL6A = 1-1 3/4"x11 7/8" (1-45x300)
 LVL6 = 2-1 3/4"x11 7/8" (2-45x300)
 LVL7 = 3-1 3/4"x11 7/8" (3-45x300)
 LVL8 = 2-1 3/4"x14" (2-45x356)
 LVL9 = 3-1 3/4"x14" (3-45x356)

LOOSE STEEL LINTELS (L)

L1 = 3-1/2" x 3-1/2" x 1/4" L (90x90x6.0L)
 L2 = 4" x 3-1/2" x 5/16" L (100x90x8.0L)
 L3 = 5" x 3-1/2" x 5/16" L (125x90x8.0L)
 L4 = 6" x 3-1/2" x 3/8" L (150x90x10.0L)
 L5 = 6" x 4" x 3/8" L (150x100x10.0L)
 L6 = 7" x 4" x 3/8" L (180x100x10.0L)

DOOR SCHEDULE

NOS.	WIDTH	HEIGHT 8'-9" CEILING	HEIGHT 10" OR MORE CEILING	TYPE
1	2'-10"	6'-8"	8'-0"	INSULATED ENTRANCE DOOR
1a	2'-8"	6'-8"	8'-0"	INSULATED FRONT DOORS
2	2'-8"	6'-8"	8'-0"	WOOD & GLASS DOOR
3	2'-8"	6'-8"	8'-0"	EXTERIOR SLAB DOOR
4	2'-8"	6'-8"	8'-0"	INTERIOR SLAB DOOR
5	2'-6"	6'-8"	8'-0"	INTERIOR SLAB DOOR
6	2'-2"	6'-8"	8'-0"	INTERIOR SLAB DOOR
7	1'-6"	6'-8"	8'-0"	INTERIOR SLAB DOOR

CERAMIC TILE FOR CONVENTIONAL LUMBER (OBC 9.30.6)

SPACE ALL CONVENTIONAL FLOOR JOISTS @ 12" O.C. BELOW ALL CERAMIC TILE AREAS.
 PROVIDE 1 ROW BRIDGING FOR SPANS OF 5'0"-7'0".
 2 ROWS FOR SPANS GREATER THAN 7'0".

NOTE: ROOF FRAMING

REFER TO ROOF TRUSS SHOP DRAWINGS FOR ALL ROOF FRAMING INFORMATION UNLESS OTHERWISE NOTED.


PLANS NOT DRAWN TO ACTUAL GRADE. REFER TO FINAL APPROVED GRADING PLAN.

NOTE: ENGINEERED FLOOR FRAMING

REFER TO ENGINEERED FLOOR LAYOUTS FOR ALL ENGINEERED FLOOR FRAMING INFORMATION AND DETAILS. UNLESS OTHERWISE NOTED.

TWO STOREY HEIGHT WALL DETAIL


2-2"x8" STUD WALL NAILED TOGETHER AND SPACED @ 12" o.c. FULL HEIGHT, c/w SOLID BLOCKING @ 4'-0" o.c. VERTICAL AND 7/16" EXT. PLYWOOD SHEATHING.

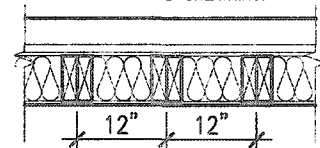

NOTE: MAXIMUM HEIGHT OF WALL FOR THIS DETAIL IS 18'-0" AND MAX. SUPPORTED LENGTH OF TRUSS IS 40'-0".

TWO STOREY HEIGHT WALL DETAIL

2-1 1/2" x 5 1/2" TIMBERSTRAND (LSL) 1.5E STUD WALL GLUED & NAILED TOGETHER AND SPACED MAX. @ 10" o.c. FULL HEIGHT, c/w SOLID BLOCKING @ 8'-0" o.c. VERTICAL AND 7/16" EXT. OSB SHEATHING.

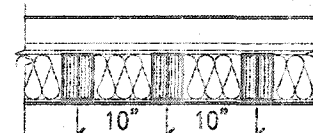

NOTE: MAXIMUM HEIGHT OF WALL FOR THIS DETAIL IS 20'-2" AND MAX. SUPPORTED LENGTH OF TRUSS IS 40'-0".

TWO STOREY HEIGHT WALL DETAIL

2-1 1/2" x 5 1/2" TIMBERSTRAND (LSL) 1.5E STUD WALL GLUED & NAILED TOGETHER AND SPACED MAX. @ 9" o.c. FULL HEIGHT, c/w SOLID BLOCKING @ 8'-0" o.c. VERTICAL AND 7/16" EXT. OSB SHEATHING.



NOTE: MAXIMUM HEIGHT OF WALL FOR THIS DETAIL IS 21'-5" AND MAX. SUPPORTED LENGTH OF TRUSS IS 40'-0".

THE MINIMAL THERMAL PERFORMANCE OF BUILDING ENVELOPE AND EQUIPMENT SHALL CONFORM TO THE FOLLOWING SB-12 COMPLIANCE PACKAGE AS PER OBC SUPPLEMENTARY STANDARD SB-12, SECTION 3.1.1.1.


USE SB-12 COMPLIANCE PACKAGE (A1)

COMPONENT	A1	Notes:
Ceiling with Attic Space	10.56 (R60)	R20 at inner face of exterior walls
Minimum RSI (R) value	5.46 (R31)	BATT or SPRAY
Ceiling without Attic Space	5.46 (R31)	BATT or SPRAY
Minimum RSI (R) value	5.46 (R31)	BATT or SPRAY
Exposed Floor	5.46 (R31)	BATT or SPRAY
Minimum RSI (R) value	3.87 (R22)	6" R22 BATT
Walls Above Grade	3.52ci (R20ci)	OPTION TO USE R12+R10ci.
Basement Walls	1.76 (R10)	RIGID INSUL
Minimum RSI (R) value	0.28	
Edge of Below Grade Slab ≤600mm below grade	0.49	
Minimum RSI (R) value	96% Min.	NATURAL GAS
Windows & Sliding glass Doors	0.8	NATURAL GAS
Maximum U-value	75%	
Skylights		
Maximum U-value		
Space Heating Equipment		
Minimum AFUE		
Hot Water Heater		
Minimum EF		
HRV		
Minimum Efficiency		
Drain Water Heat Recovery Unit (DWHR)		

ci- Denotes Continuous Insulation without framing interruption.

It is the builder's complete responsibility to ensure that all plans submitted for approval fully comply with the Architectural Guidelines and all applicable regulations and requirements including zoning provisions and any provisions in the subdivision agreement. The Control Architect is not responsible in any way for examining or approving site (lotting) plans or working drawings with respect to any zoning or building code or permit matter or that any house can be properly built or located on its lot.

This is to certify that these plans comply with the applicable Architectural Design Guidelines approved by the City of HAMILTON

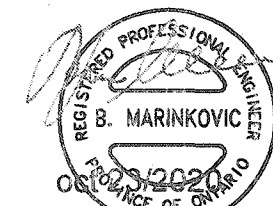

STRUDET INC.
FOR STRUCTURE ONLY

MOUNTAINASH 4-259

COMPLIANCE PACKAGE 'A1'

AREA CALCULATIONS	FLEV '3'
GROUND FLOOR AREA	1398 SF
SECOND FLOOR AREA	1792 SF
TOTAL FLOOR AREA	3190 SF (296.36 m2)
FIRST FLOOR OPEN AREA	0 SF
SECOND FLOOR OPEN AREA	6 SF
ADD TOTAL OPEN AREAS	+6 SF
ADD FINISHED BSMT AREA	+0 SF
GROSS FLOOR AREA	3196 SF (296.92 m2)
GROUND FLOOR COVERAGE	1405 SF
GARAGE COVERAGE/AREA	393 SF
PORCH COVERAGE/AREA	59 SF
COVERAGE W/ PORCH	1857 SF (172.52 m2)
COVERAGE W/O PORCH	1798 SF (167.04 m2)

CITY OF HAMILTON
Building Division

Permit No. **21-107144**

THESE STAMPED DRAWINGS SHALL BE AVAILABLE ON SITE

THE OWNER AND/OR CONTRACTOR SHALL COMPLY WITH THE ONTARIO BUILDING CODE AND ALL OTHER APPLICABLE LAW
 These drawings and/or specifications have been reviewed by

FOR THE BUILDING OFFICIAL
 DATE **MAR 2 2021**

VAS DESIGN

255 Consumers Rd Suite 120
Toronto, ON M2J 1R4
416.630.2255 f 416.630.4782
vasdesign.com

Greenpark

MOUNTAINASH 4
13.5m

project name RUSSELL GARDENS PH. 3	municipality HAMILTON, ON.	project no. 19014
date JAN. 2020	drawn by M.HUR	checked by 3/16" = 1'-0"
GENERAL NOTES & CHARTS		file name 19014-MOUNTAINASH-4-259
drawing no. A0		

All drawings, specifications, related documents and design are the copyright property of VAS DESIGN. Reproduction of this property in whole or in part is strictly prohibited without VAS DESIGN's written permission.

Note:


- Footing/Foundation/Piers must bear on undisturbed soil.
- Separate building permit is required to finish basement space.
- All plumbing is subject to field inspection by City of Hamilton.

3189 SF.

VENUEER CUT
WHEN VENEER CUT IS GREATER
THAN 26", A 10" POURED
CONCRETE FOUNDATION WALL IS
REQUIRED.

WOOD DECK DETAILS
REFER TO STANDARD DETAIL PACKAGE (PAGE 5)
FOR ADDITIONAL WOOD DECK INFORMATION.

PROVIDE SOLID BLOCKINGS
@ 24" O.C. WHERE FLOOR
JOISTS ARE PARALLEL TO
FOUNDATION WALL (TYP.)

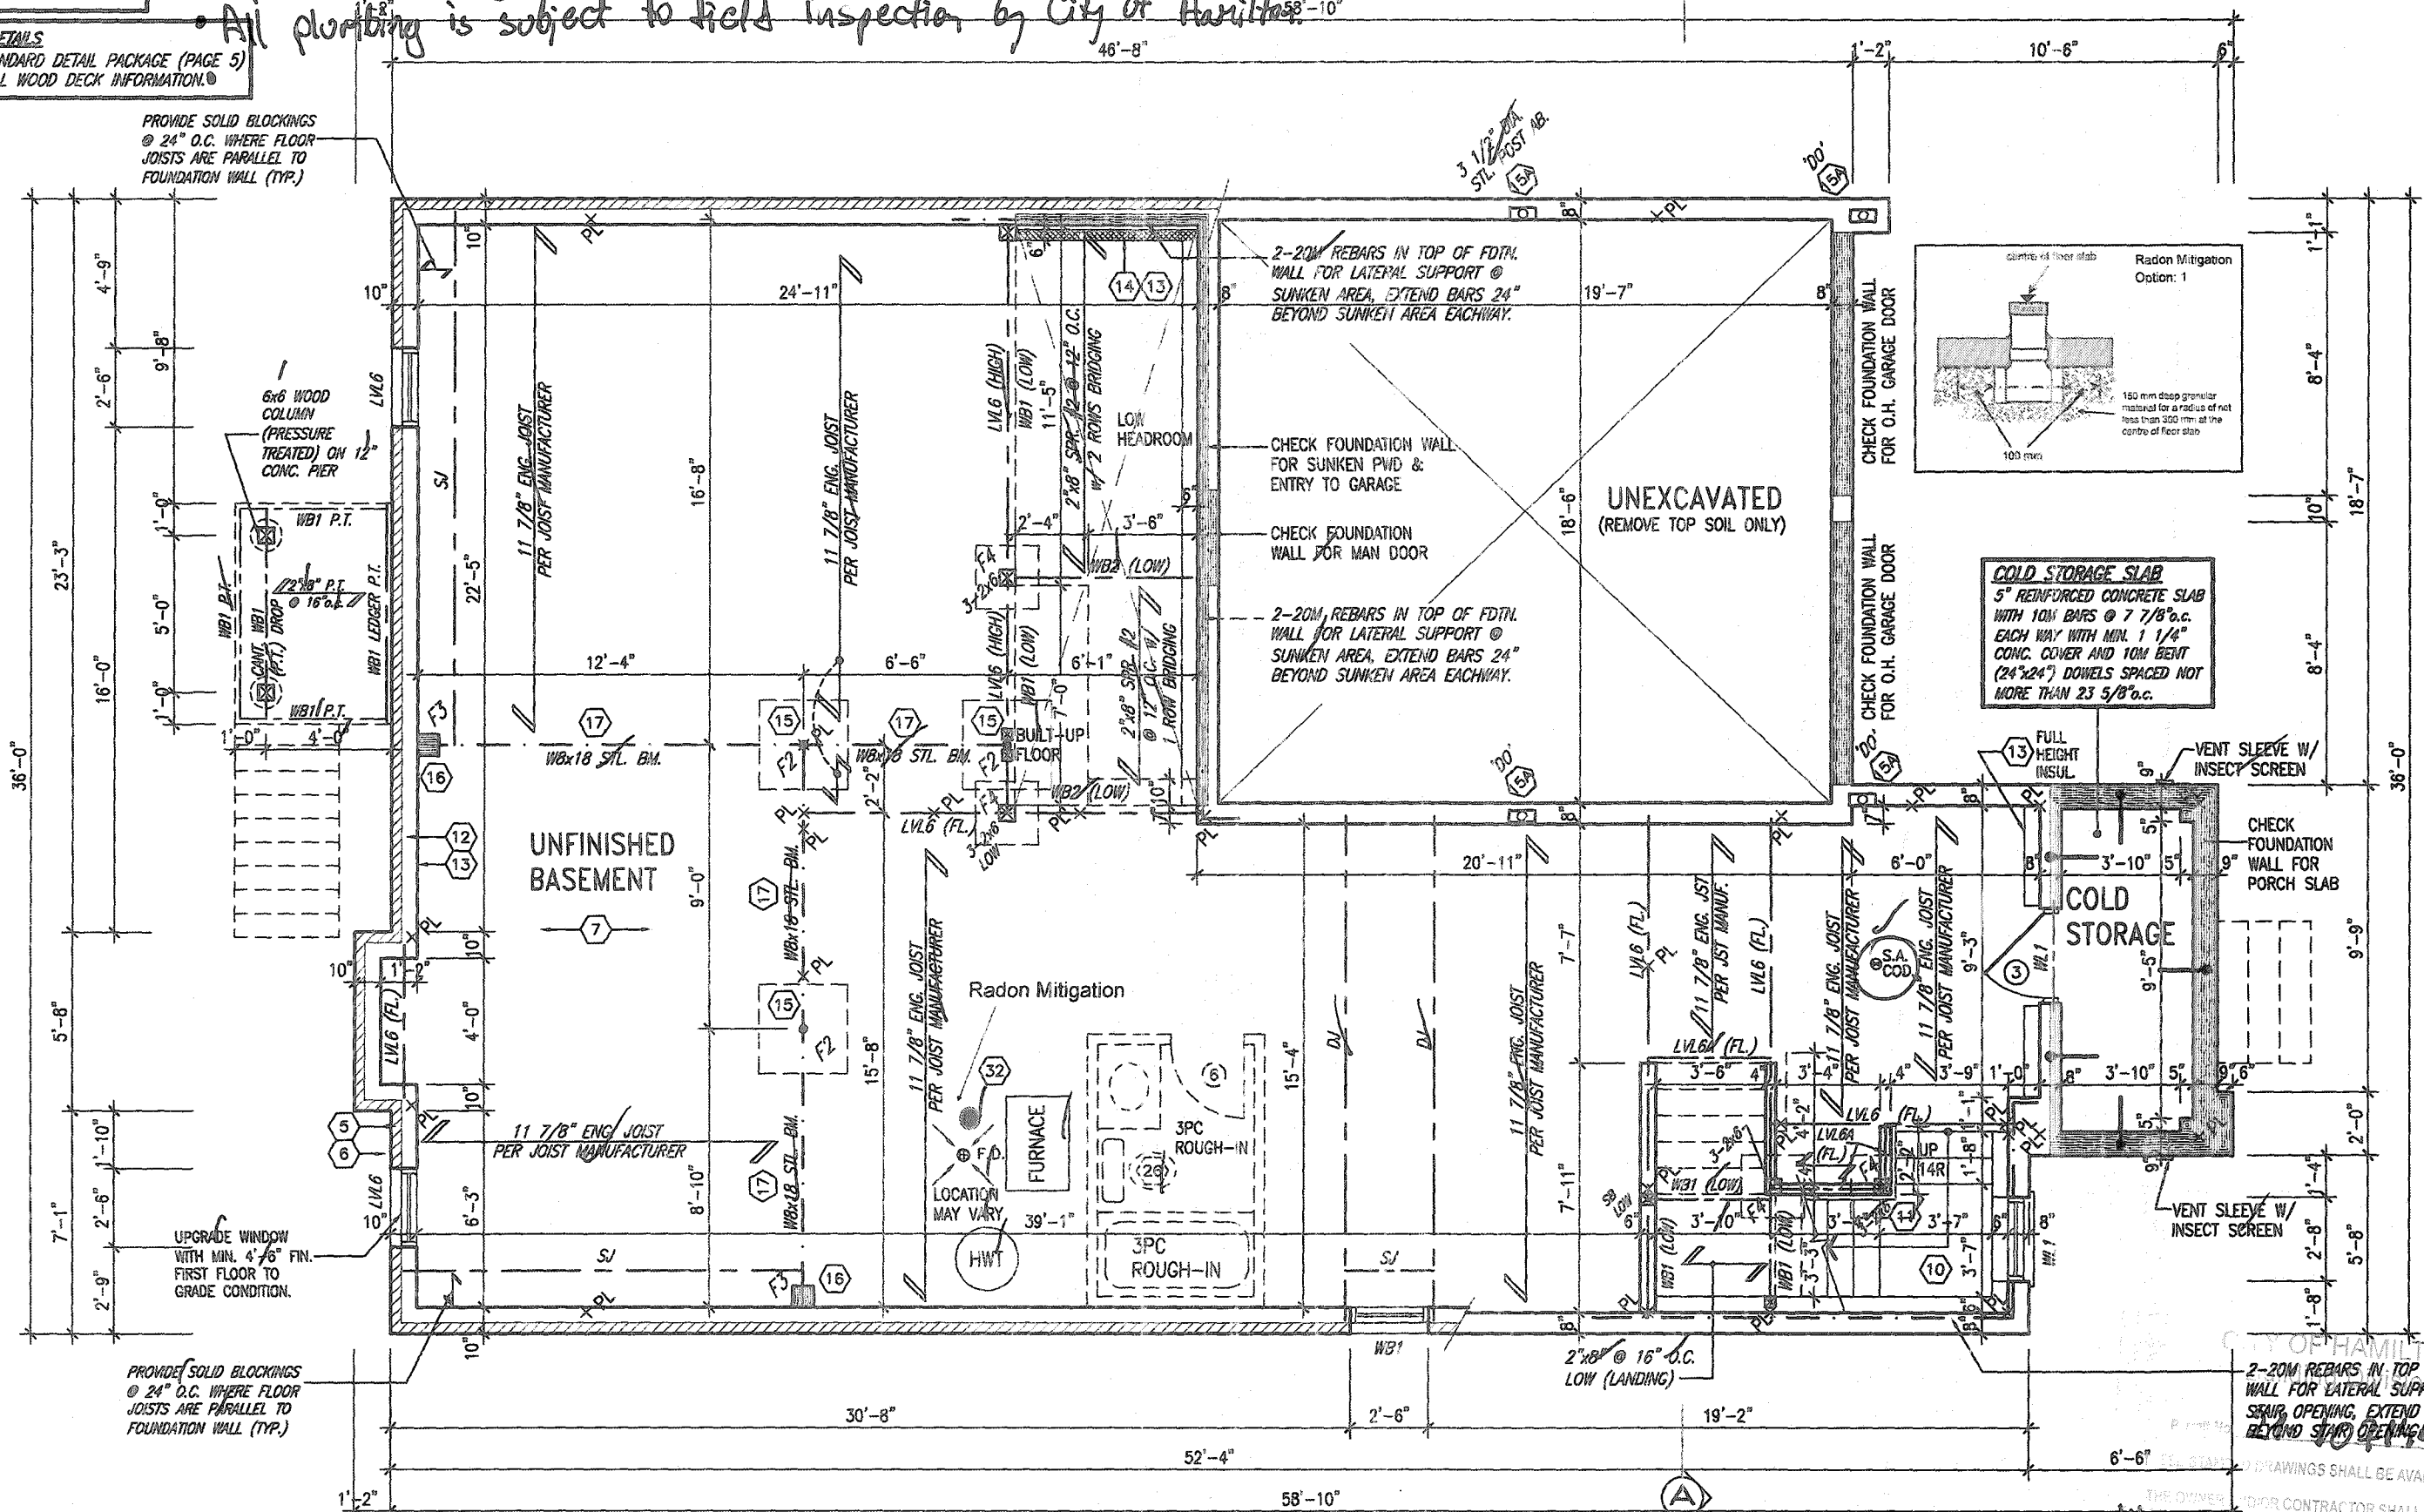

BASEMENT PLAN - ELEV. '3'

MOUNTAINASH 4-259
COMPLIANCE PACKAGE 'A1'

It is the builder's complete responsibility to ensure that all plans submitted for approval fully comply with the Architectural Guidelines and all applicable regulations and requirements including zoning provisions and any provisions in the subdivision agreement. The Control Architect is not responsible in any way for examining or approving site (lotting) plans or working drawings with respect to any zoning or building code or permit matter or that any house can be properly built or located on its lot.

This is to certify that these plans comply with the applicable Architectural Design Guidelines approved by the City of Hamilton.

JOHN G. WILLIAMS LTD. ARCHITECT
ARCHITECTURAL CONTROL REVIEW
AND APPROVAL
APPROVED BY: [Signature]
DATE: JAN 28 2021
This stamp certifies compliance with the applicable Design Guidelines only and does not constitute professional responsibility.

REGISTERED PROFESSIONAL ENGINEER
B. MARINKOVIC
23 2021
OFFICE OF ONTARIO
STRUDET INC.
FOR STRUCTURE ONLY

**BASEMENT INSULATION AT
STAIR/SUNKEN AREAS**
-2" (R10) CONTINUOUS INSULATION
(RIGID OR SPRAY FOAM).
-2"x4" @ 16" o.c. w/ R12 BATT
INSULATION & 1/2" DRYWALL FINISH
-EXTEND EXTERIOR WALL FOOTING TO
SUPPORT 2"x4" WALL WHERE LOAD
BEARING.

**BASEMENT WALL INSULATION
(TYP.) (13)**
-6" (R20) CONTINUOUS BLANKET
INSULATION. INSULATION
UNINTERRUPTED BY FRAMING

18.			9.		
17.			8.		
16.			7.		
15.			6.		
14.			5.		
13.			4.	CUSTOM PER PURCHASER REQUEST.	SEP 25/20 GW
12.			3.	ISSUED FOR PERMIT.	MAR 31/20 GW
11.			2.	UPDATED PER ENG & CLIENT COMMENTS.	MAR 19/20 GW
10.			1.	PRELIMINARY, ISSUED FOR CLIENT REVIEW.	JAN 28/20 CW
no.	description	date	by	no.	description

The undersigned has reviewed and takes responsibility for this design and has the qualifications and meets the requirements set out in the Ontario Building Code to be a Designer.
qualification information
Richard Vink
name
registration information
VA3 Design Inc.
24488
42658
255 Consumers Rd Suite 120
Toronto ON M2J 1R4
416.630.2255 f 416.630.4782
va3design.com

VA3 DESIGN
255 Consumers Rd Suite 120
Toronto ON M2J 1R4
416.630.2255 f 416.630.4782
va3design.com

Greenpark.
project name
RUSSELL GARDENS PH. 3
HAMILTON, ON.
project no.
19014
drawing no.
A1b
date
JAN 2020
checked by
3/16" = 1'-0"
19014-MOUNTAINASH-4-259
FILE NAME
19014-MOUNTAINASH-4-259
DATE
FEB 26 2021

MOUNTAINASH 4
13.5m
project no.
19014
drawing no.
A1b

All drawings, specifications, related documents and design are the copyright property of VA3 DESIGN. Reproduction of this property in whole or in part is strictly prohibited without VA3 DESIGN's written permission.

All drawings specifications, related documents and designs are the copyright property of VA3 DESIGN. Reproduction of this property in whole or in part is strictly prohibited without VA3 DESIGN's written permission.


GB-NOTE-2020.dwg

All drawings specifications, related documents and design are the copyright property of VAS DESIGN. Reproduction of this property in whole or in part is strictly prohibited without VAS DESIGN's written permission.

3189 SF.

Notes:

- Approved CSA/CMC stucco system specs required to be on site prior installation
- Provide roof natural ventilation for every 1/300sq.ft of the insulated roof attic space.

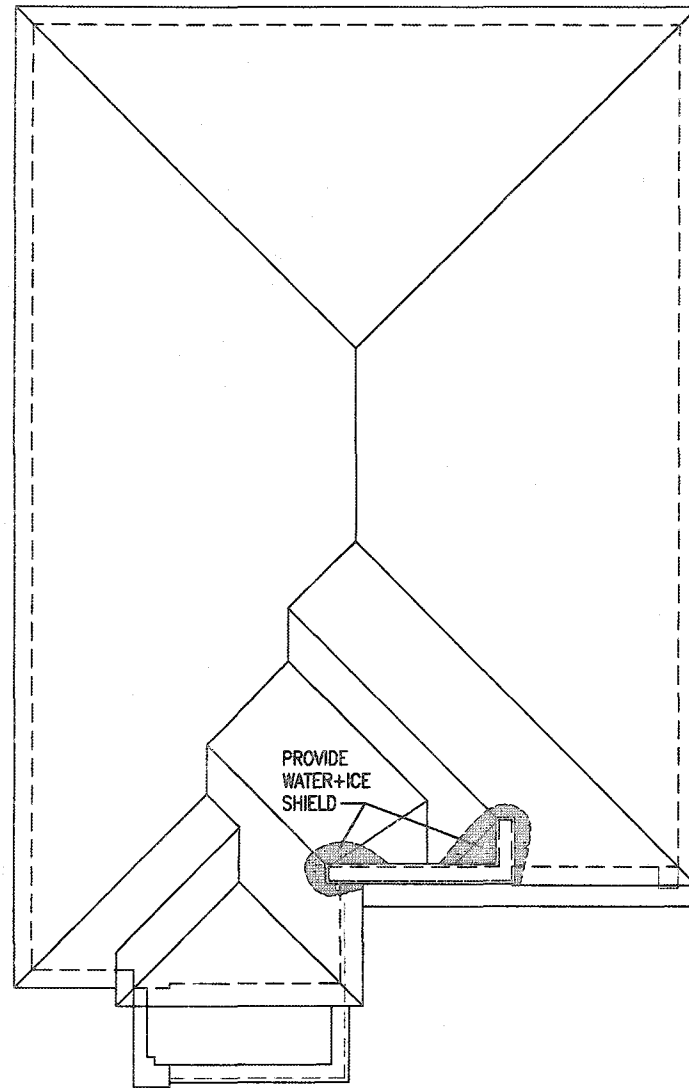

ROOF PLAN - ELEV. '3'



INSIDE PORTICO ELEVATION '3'

It is the builder's complete responsibility to ensure that all plans submitted for approval fully comply with the Architectural Guidelines and all applicable regulations and requirements including zoning provisions and any provisions in the subdivision agreement. The Control Architect is not responsible in any way for examining or approving site (lotting) plans or working drawings with respect to any zoning or building code or permit matter or that any house can be properly built or located on its lot.

This is to certify that these plans comply with the applicable Architectural Design Guidelines approved by the City of Hamilton.

JOHN G. WILLIAMS LTD., ARCHITECT
ARCHITECTURAL DESIGN REVIEW
AND APPROVAL
APPROVED BY: [Signature]
DATE: JAN 28, 2021
This stamp certifies compliance with the applicable Design Guidelines only and does not further professional responsibility.

PORCH STEPS (TYP.)
PRECAST CONCRETE STEPS
w/ MASONRY INSERTS WHERE
GRADE REQUIRES.

18			9		
17			8		
16			7		
15			6		
14			5		
13			4	CUSTOM PER PURCHASER REQUEST.	SEP 25/20 GW
12			3	ISSUED FOR PERMIT.	MAR 31/20 GW
11			2	UPDATED PER ENG & CLIENT COMMENTS.	MAR 19/20 GW
10			1	PRELIMINARY, ISSUED FOR CLIENT REVIEW.	JAN 28/20 GW
no	description	date	by	no, description	date by

The undersigned has reviewed and taken responsibility for this design and has the qualifications and meets the requirements set out in the Ontario Building Code to be a Designer.
Qualification Information
Richard Vink
signature
24488
BCO
42658
Name registration information
V3 Design Inc.
Contractor must verify all dimensions on the job and report any discrepancy to the Designer before proceeding with the work. All drawings and specifications are instruments of service and the property of the Designer which must be returned at the completion of the work. Drawings are not to be used.

V3 DESIGN
255 Consumers Rd Suite 120
Toronto ON M2J 1R4
416.630.2255 f 416.630.4782
v3design.com

Greenpark.
project name
RUSSELL GARDENS PH. 3
drawn by
JAN. 2020
checked by
scale
3/16" = 1'-0"
19014-MOUNTAINASH-4-259
CITY OF HAMILTON
HAMILTON, ON.
drawing no.
A4b

MOUNTAINASH 4
13.5m
project no.
19014
drawing no.
A4b



FRONT ELEVATION - ELEV. '3'

Permit No. 21-107144

THESE STAMPED DRAWINGS SHALL BE AVAILABLE ON SITE AT ALL TIMES.

THE OWNER AND/OR CONTRACTOR SHALL COMPLY WITH THE BUILDING CODE AND ALL OTHER APPLICABLE LAW.

These drawings and specifications have been reviewed by

DATE FEB 26 2021

CHIEF BUILDING OFFICIAL

DATE

2021

2021

All drawings specifications, related documents and design are the copyright property of VAS DESIGN. Reproduction of this property in whole or in part is strictly prohibited without VAS DESIGN's written permission.

All drawings specifications, related documents and design are the copyright property of VA3 DESIGN. Reproduction of this property in whole or in part is strictly prohibited without VA3 DESIGN's written permission.