


THIS LOT GRADING PLAN HAS BEEN REVIEWED BY METROPOLITAN CONSULTING INC. FOR CONFORMANCE WITH THE APPROVED SUBDIVISION GRADING DESIGN. THE PROPOSED GRADES ON THIS PLAN ARE IN GENERAL CONFORMITY WITH THE APPROVED GRADING PLAN AS IT RELATES TO THIS LOT AND ADJACENT LOTS. WHERE THE BASEMENT FLOOR OR OTHER FOUNDATION ELEVATIONS ARE PROPOSED AT A DIFFERENT ELEVATION THAN THAT SHOWN ON THE APPROVED SUBDIVISION PLANS THE SEWER LATERALS HAVE BEEN REVIEWED AND WE ARE SATISFIED THAT THE MINIMUM GRADES FOR THESE LATERALS CAN BE MAINTAINED IN ACCORDANCE WITH THE REQUIREMENTS OF THE O.B.C. AND CITY DESIGN CRITERIA. NOTE: THIS CERTIFICATION DOES NOT REPLACE THE BUILDER'S RESPONSIBILITY TO EXPOSE THE SEWER LATERALS AND CONFIRM ELEVATIONS PRIOR TO EXCAVATING FOR THE FOUNDATION. BY USE OF THIS PLAN THE BUILDER AGREES THAT THEY SHALL BE RESPONSIBLE FOR IMMEDIATELY REPORTING TO METROPOLITAN CONSULTING ANY DISCREPANCY OR VARIATION BETWEEN THE LATERAL INFORMATION AND GRADES DEPICTED ON THIS PLAN AND THE CONDITIONS FOUND IN THE FIELD.

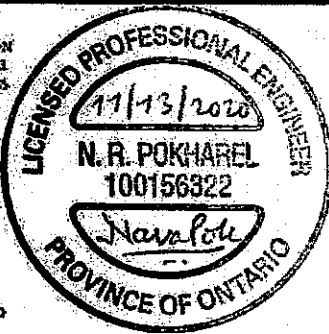

It is the builder's complete responsibility to ensure that all plans submitted for approval fully comply with the Architectural Guidelines and all applicable regulations and requirements including zoning provisions and any provisions in the subdivision agreement. The Control Architect is not responsible in any way for examining or approving site (lotting) plans or working drawings with respect to any zoning or building code or permit matter or that any house can be properly built or located on its lot.


This is to certify that these plans comply with the applicable Architectural Design Guidelines approved by the City of Hamilton.

JOHN G. WILLIAMS LTD., ARCHITECT
ARCHITECTURAL CONTROL REVIEW
AND APPROVAL

APPROVED BY:

DATE: DEC 07, 2020

This stamp certifies compliance with the applicable Design Guidelines only and bears no further professional responsibility.

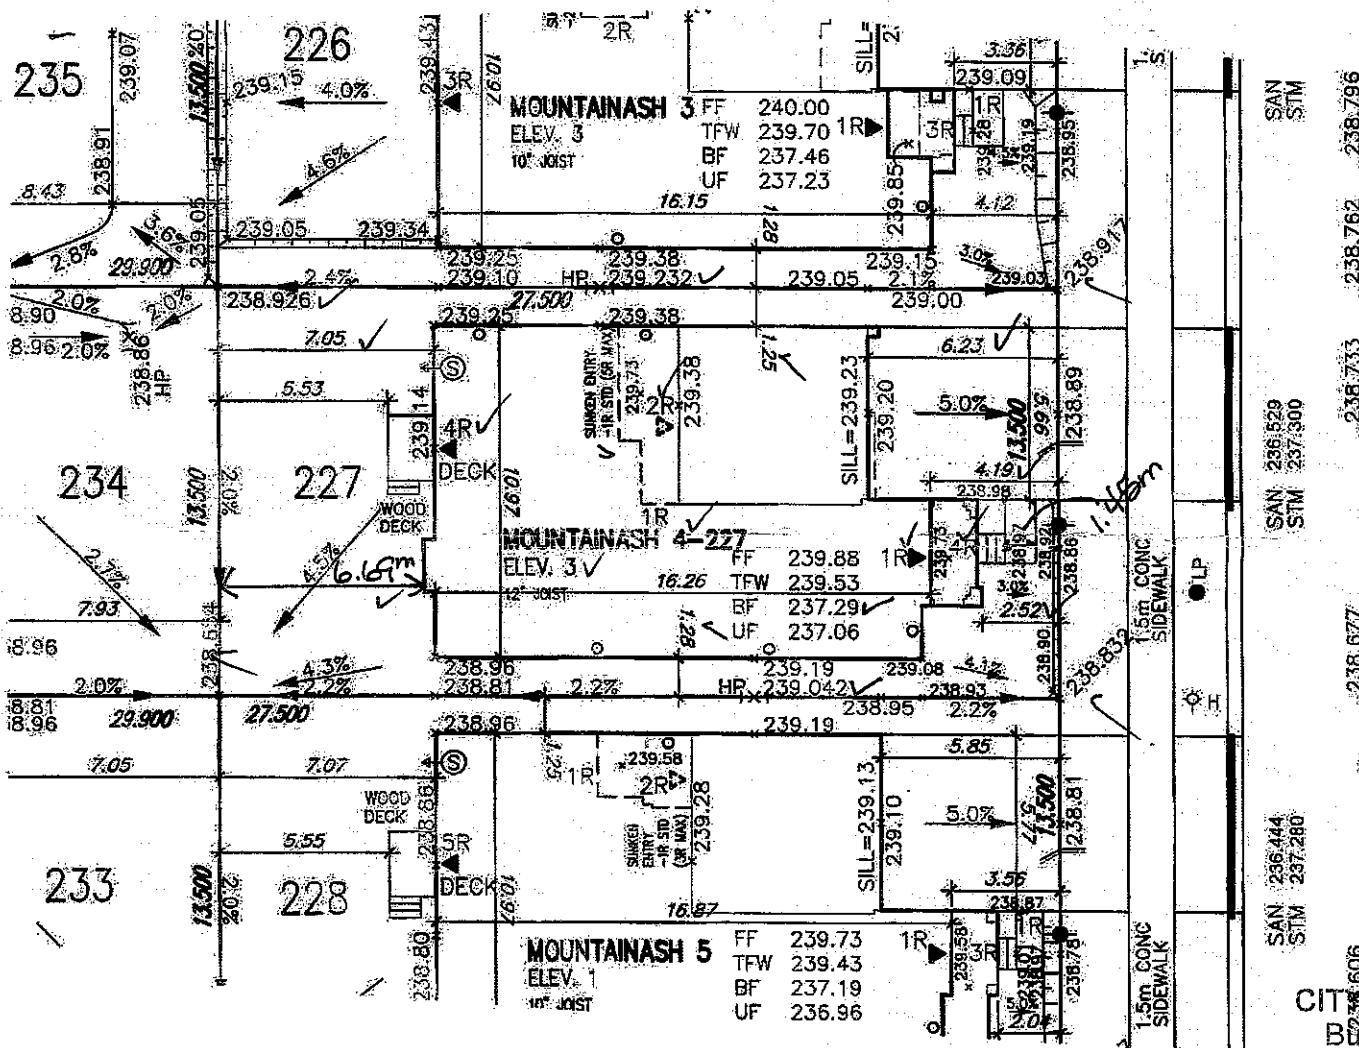

CITY OF HAMILTON
Building Division

Permit No. 21-105985

THESE STAMPED DRAWINGS SHALL BE AVAILABLE ON SITE

THE OWNER AND/OR CONTRACTOR SHALL COMPLY WITH THE ONTARIO BUILDING CODE AND ALL OTHER APPLICABLE LAW

These drawings and/or specifications have been reviewed by

FOR CHIEF BUILDING OFFICIAL DATE FEB. 23/21

Grading Notes:

It shall be the responsibility of the builder to have all grades and services verified and checked before construction by an approved grading engineer. These grades and the placement of storm and sanitary services off the street are to meet the requirements of the municipality having jurisdiction.

VA3 Design Inc. is to be notified promptly of any discrepancies at least 1 (one) week prior to excavation commences in order that the building can be re-sited. Failure to observe these conditions may require expensive remedial action that will not be the responsibility of or cost to VA3 Design Inc. Foundation wall shall be poured to a minimum of 6" above approved grades.

Finished grade lines as indicated on the house prototype are for reference only and do not necessarily depict finish grading conditions of any particular lot.

These drawings are to be read in conjunction with municipal approved site engineering drawings prepared by Metropolitan Consulting Inc.

LOT 227		
LOT NO.	LOT WIDTH (M) (± 0.00m)	LOT AREA (M²)
227	13.50	371.25

NOTE: SUMP PUMP REQUIRED. SUMP PUMPS CONNECTED TO STORM SEWER ARE REQUIRED AS PER THE APPROVED SITE ENGINEERING DRAWINGS. REFER TO DRAWINGS PREPARED BY METROPOLITAN CONSULTING INC. SHEET W14017-N12.

NOTE: REFER TO LANDSCAPE DRAWINGS FOR ALL FENCING TYPES, HEIGHTS AND LOCATIONS. CONTRACTOR TO VERIFY PRIOR TO INSTALLATION.

- PROPOSED VALVE - UP: LIGHT POLE - WATER SERVICE - DOUBLE ST/SAN. CONNECTION - SINGLE ST/SAN. CONNECTION - CATCH BASIN - CABLE TELEVISION PEDESTAL - BELL PEDESTAL	- HYDRANT - TRANSFORMER	- FINISHED FLOOR ELEVATION - FINISHED MAIN LEVEL ELEVATION - UNDERSIDE FOOTING ELEVATION - FIN. BASEMENT FLOOR SLAB - TOP OF FOUNDATION WALL - UNDERSIDE FOOTING AT REAR - UNDERSIDE FOOTING AT FRONT - UNDERSIDE FOOTING AT SIDE - W.O.B. WALK OUT DECK - W.O.B. WALK OUT BASEMENT - REV. REVERSE PLAN	- STREET SIGN - MAIL BOX - RETAINING WALL - CHAIN LINK FENCE (SEE LANDSCAPE PLAN) - ACQUSSION FENCE (SEE LANDSCAPE PLAN) - WOOD SCREEN FENCE (SEE LANDSCAPE PLAN) - HYDRO SERVICE LATERAL - GAS METER - EMERGENCY (3:1 SLOPE, UNLESS OTHERWISE NOTED)	- PROVIDE 3/4" DIA. CLEAR STONE IN THIS AREA - THIS LOT CONTAINS ENGINEERED FILL - AC: AIR CONDITIONER REQUIRED - RAIN WATER DOWNSPOUT LOCATION (DISCHARGE ONTO SPLASHPAD) - SIDE WINDOW LOCATION - OPT. DOOR LOCATION - EXTERIOR DOOR LOCATION - REDUCE SIDE YARD
---	---	---	---	--

9. The undersigned has retained and taken responsibility for this design and has the qualifications and meets the requirements set out in the Ontario Building Code to be a Designer.	10. Signature:	11. Name: Richard Vink	12. Registration Number: 21488	13. Firm Name: VA3 DESIGN	14. Firm Address: 255 Consumers Rd Suite 120, Toronto, ON M2J 1R4	15. Firm Phone: 416.630.2255 F 416.630.4782	16. Firm Website: va3design.com	17. Project Name: RUSSELL GARDENS PHASE 3	18. Municipality: HAMILTON	19. Lot/Block No.: 227	20. Registered Plan No.: 62M-1266	21. Project No.: 19014	22. Drawing No.: 1
1. ISSUED FOR PERMIT	2. OCT 02/20	3. GW	4. DATE	5. BY	6. DESCRIPTION	7. DATE	8. BY	9. CHECKED BY	10. SCALE	11. DATE	12. DATE	13. DATE	14. DATE

All design specifications, related documents and design are the copyright property of VA3 DESIGN. Reproduction of this property in whole or in part is strictly prohibited without VA3 DESIGN's written permission.