


This stamp certifies compliance with the applicable Design Guidelines only and bears no further professional responsibility.

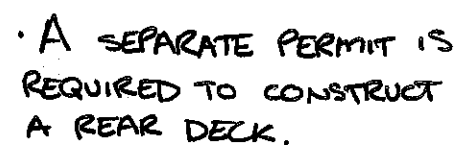

These drawings and/or specifications have been reviewed by

W. J. 3/09/21

FOR CHIEF BUILDING OFFICIAL DATE

		lot/block no. 283
		registered plan no. 62M-1266
year		project no. 19014
W		
SITING/GRADING		drawing no. 1
file name 0014-RG3-SITE-LAYOUTS		
Call: 1-877-800-1000 or 10-00 AM		

All diamond specifications, weight, diamonds and stones are the property of MVS DESIGN. Resale of the property is strict and is not to be sold without MVS DESIGN's written permission.